

# JENSEN WATER IMPROVEMENTS

ASbuilts

CARMAN'S Construction

Keri Cam

Drawings Are An Accurate depiction of  
built conditions.

## SHEET INDEX

| SHEET NAME                        | SHEET # |
|-----------------------------------|---------|
| COVER SHEET                       | 1       |
| GENERAL NOTES                     | 2       |
| JENSEN STREET WATER               | 3       |
| JENSEN STREET WATER               | 4       |
| MARION STREET WATER               | 5       |
| MARION STREET WATER               | 6       |
| FLORENCE & HILLCREST STREET WATER | 7       |
| DETAILS                           | 8       |
| DETAILS                           | 9       |

**BID SET**  
**APRIL 20, 2014**



**City of Arlington Officials**


PUBLIC WORKS DIRECTOR  
**JAMES X. KELLY, P.E.**

MAYOR  
**BARBARA TOLBERT**

COUNCIL MEMBERS  
**JESICA STICKLES**  
**CHRIS RAEZER**  
**DEBORA NELSON**  
**RANDY TENDERING**  
**MARILYN OERTLE**  
**RICHARD BUTNER**  
**JAN SCHUETTE**



VICINITY MAP  
N.T.S.

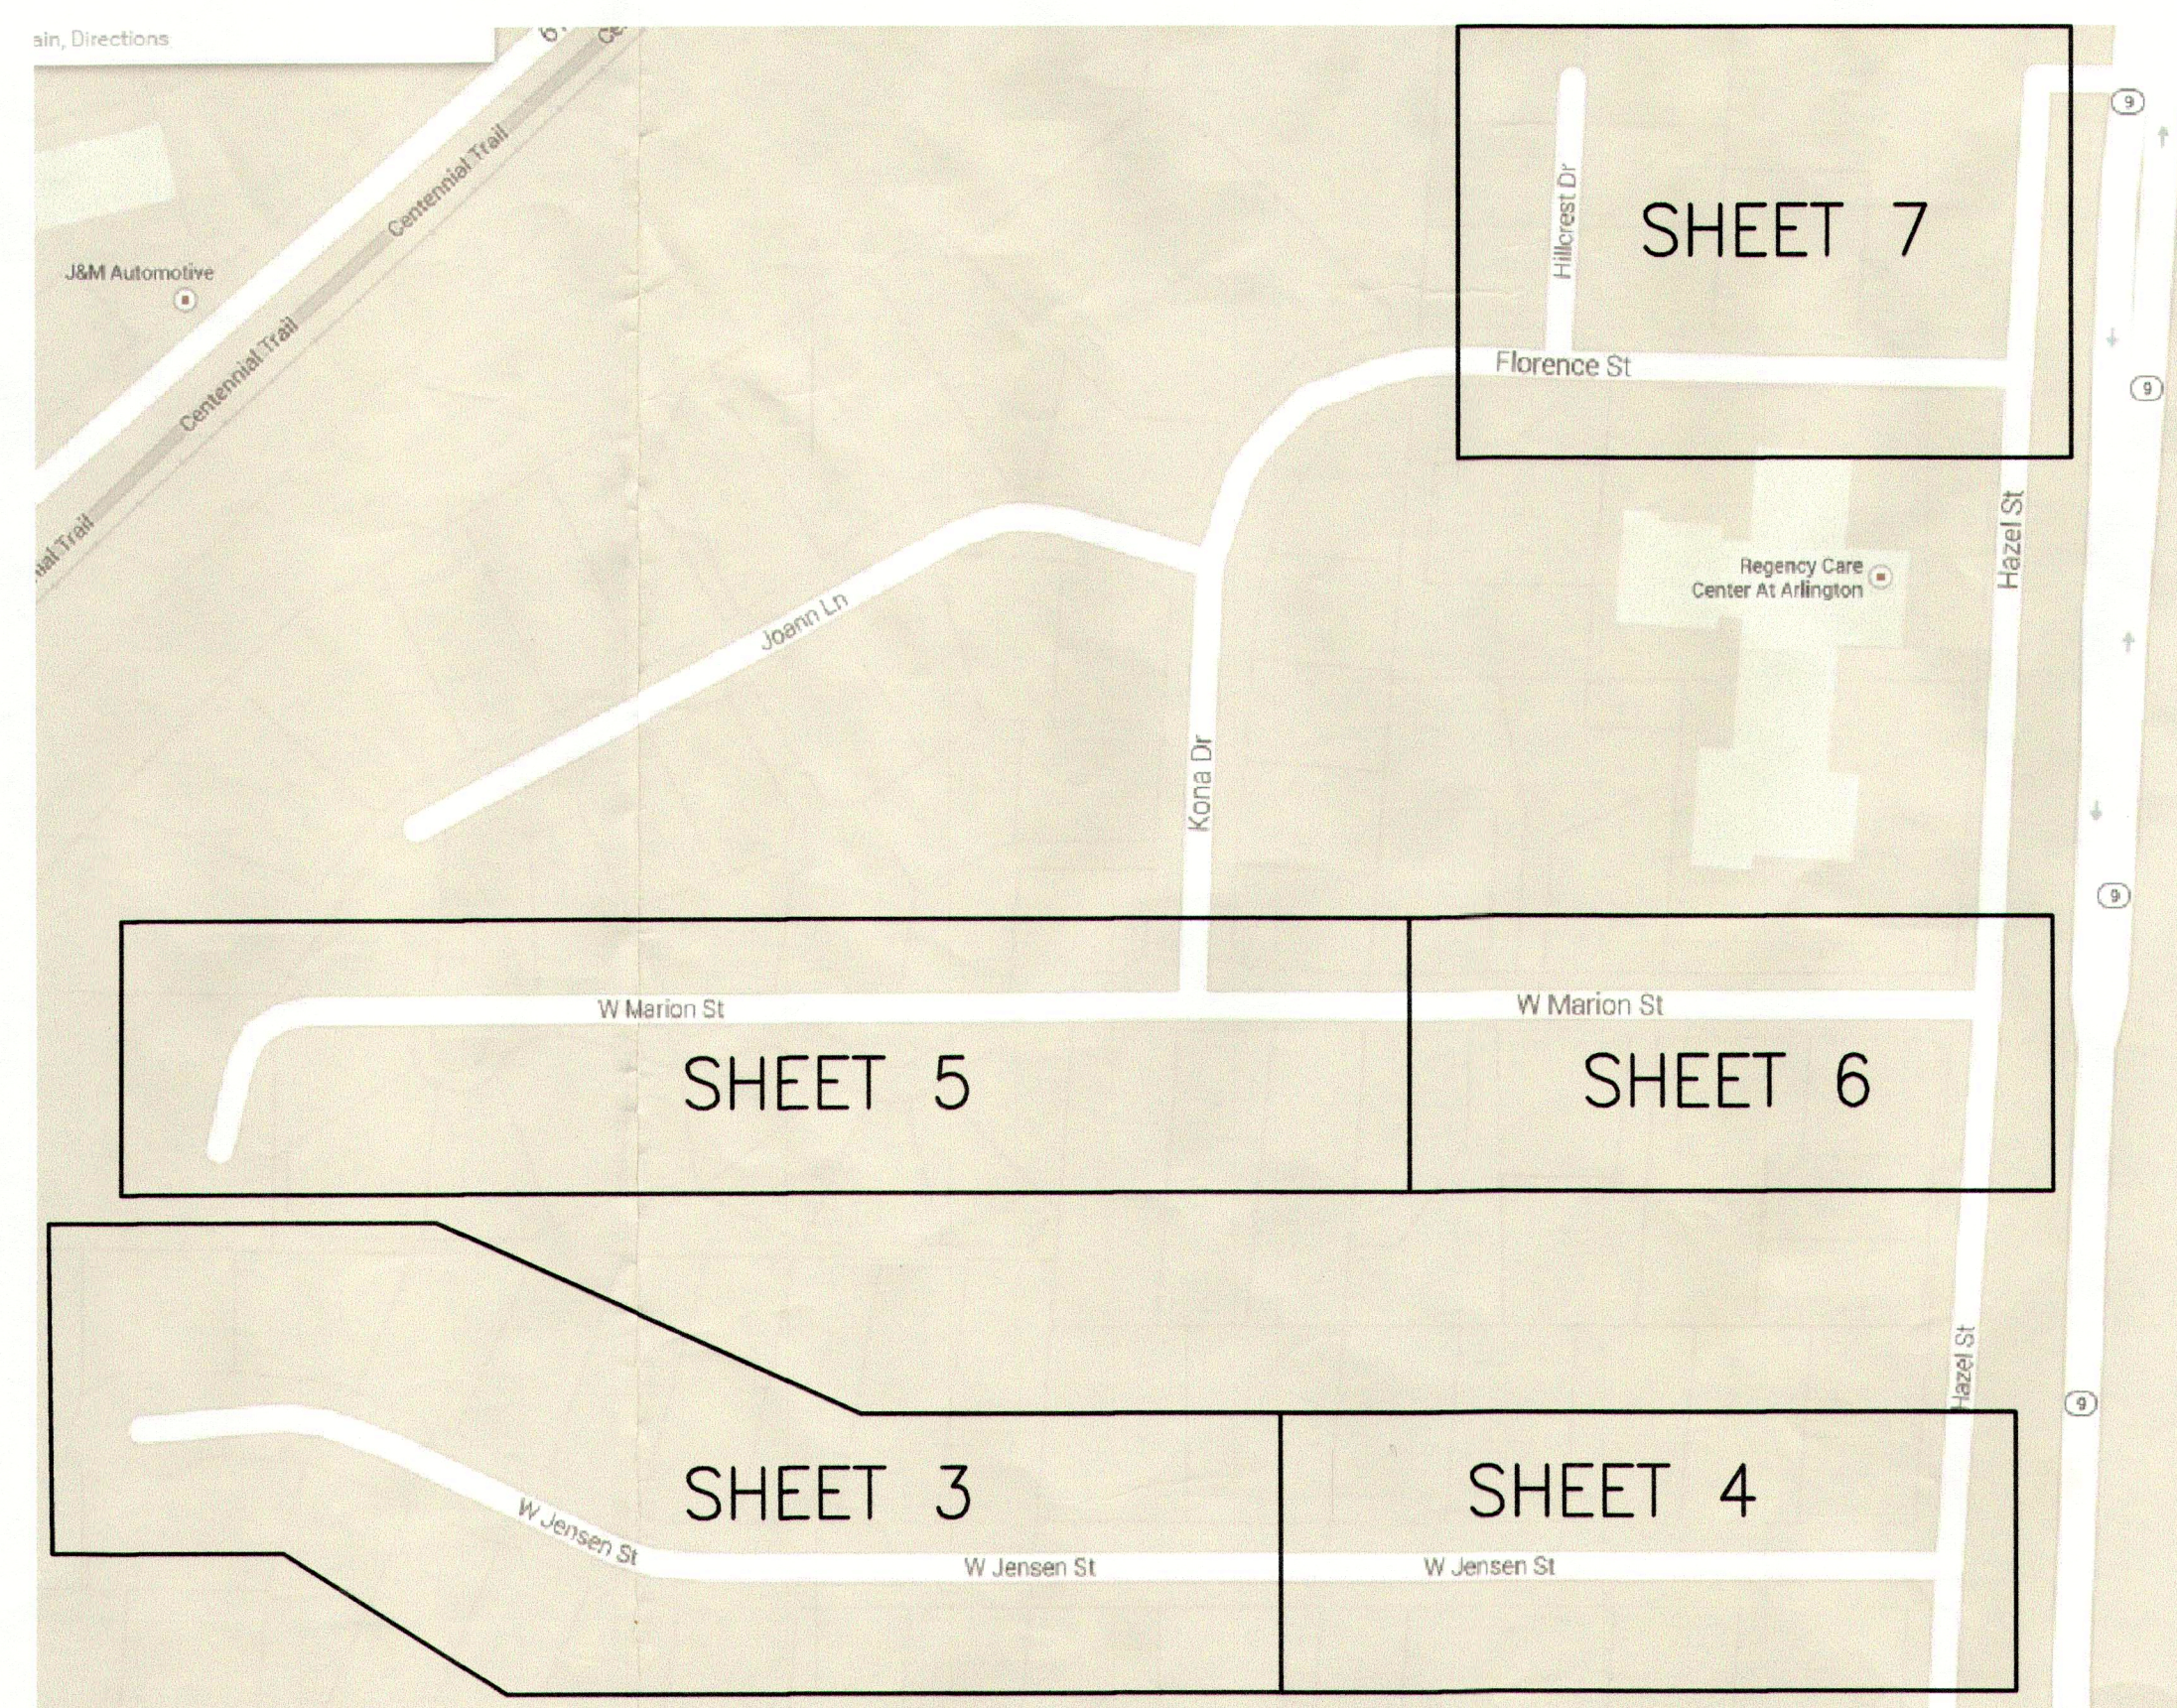

KEY MAP  
N.T.S.



241 239 237 235 233

REMOVE FHA

FH ASSEMBLY PER COA STD PLAN W-010 WITH CONC PAD PER W-020

5/8" METER PER COA STD DETAIL W-040, TYP

1" conduit

Direct bury

All 18" to 24" deep

2" conduit

JENSEN STREET

22.5" BEND (RJ) THRUST BLOCK

Gas 26" deep

10 LF 6" DI W

(E) 4" AC

Gas 35" deep

197 LF 6" DI W

36" deep stone

Gas 25" deep

22.5" BEND (RJ) THRUST BLOCK

Telephone poles

6x6 TEE (FL) 2-6" GV (FLxRJ) THRUST BLOCK



WATER SERVICE CORP MOVED TO EAST OF 22.5" BEND

MATCHLINE U1

MATCHLINE U2

240 238 236 234 232

### 22.5 Bend 33' of Cover

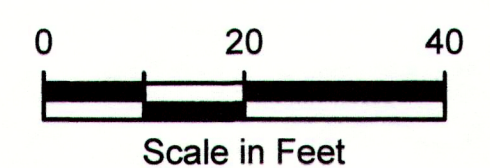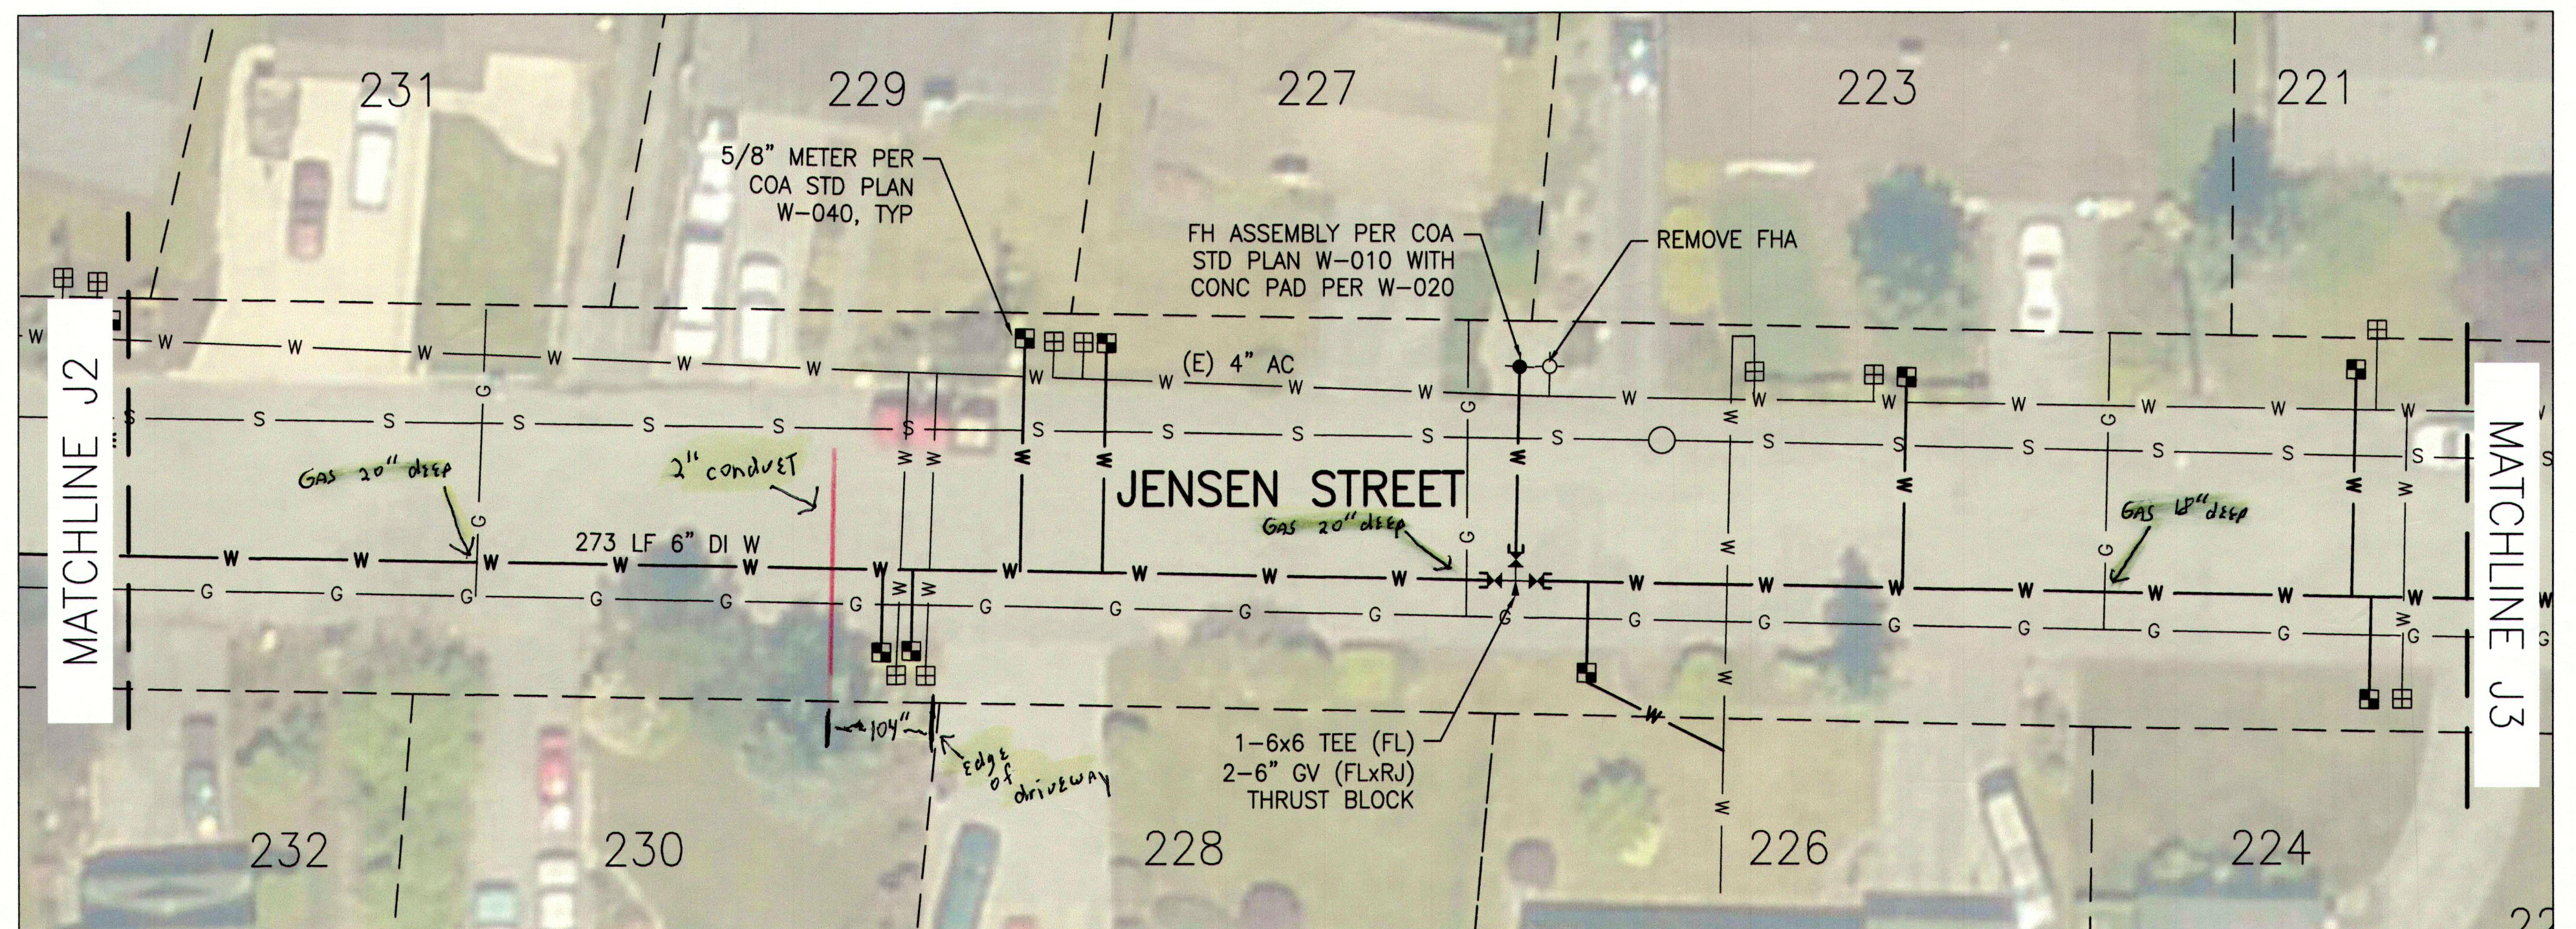

APPROVED FOR CONSTRUCTION

*James X. Kelly*

JAMES X. KELLY, PE  
PUBLIC WORKS DIRECTOR

04.20-2015

DATE APPROVED:



PROJECT NO. P02.383

WATER PLAN  
JENSEN STREET

SHEET  
3  
OF  
8  
SHEETS







