


SEWER PROFILE - 79TH DRIVE N.E.

SCALE: 1" = 50' HORIZONTAL
1" = 5' VERTICAL



HIGA-BURKHOLDER ASSOCIATES, LLC
LAND USE PLANNING / CIVIL ENGINEERING
1721 Hewitt Avenue Suite 401 Everett, WA 98201
phone (425)252-2826 fax (425)252-9551

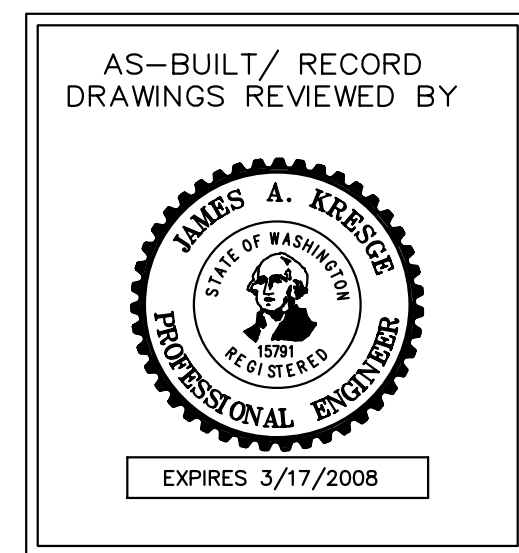

CITY OF ARLINGTON
THIS SHEET HAS BEEN APPROVED PER THE CONDITIONS ON SHEET 1
BY: _____ CITY ENGINEER
DATE: ____ / ____ / ____

CALL 48 HOURS BEFORE YOU DIG 1-800-424-5555

DATE	REVISIONS	BY
6/16/03	REVISED PER CITY REVIEW	LDR
9/26/03	REVISED PER CITY REVIEW	LDR
8/05/04	AS-BUILT	PCM, JMH
10/07/04	AS-BUILT REV. PER CITY REVIEW	PCM
07/28/06	AS-BUILT REV. PER CITY REVIEW	RLM
09/27/06	AS-BUILT REV. PER CITY REVIEW	RLM
10/11/06	AS-BUILT MYLAR	RLM

PLAN DATE: 10/04/02
DESIGNED BY: TDP, BOM
DRAWN BY: TDP, PCM, LDR
PLAN CHECK BY: BOM
1ST SUBMITTAL: 10/10/02
2ND SUBMITTAL: 06/26/03
3RD SUBMITTAL: 09/26/03

WATER AND SEWER PLANS
MAGNOLIA ESTATES
SEWER PROFILE

JOB NO.
1618
4
6

XREF: NONE