

**SEWAGE PUMP STATION SECT. (A)**  
SCALE: 3/4" = 1'-0"

DSGN	R.F. FARRELL	NO.	DATE	REVISION	BY	APVD
DR	T.N. THOMAS					
CHK	D.L. DAWSON					
APVD	S. DEHN					

9-1-87 RECORD DRAWING



**SEWAGE EJECTOR PACKAGE SYSTEM DETAIL (2)**  
1/2" = 1'-0" C-5

**RECORD DRAWINGS**  
Revisions Drawn by \_\_\_\_\_ Date \_\_\_\_\_

THESE RECORD DRAWINGS HAVE BEEN PREPARED, IN PART, ON THE BASIS OF INFORMATION COMPILED BY OTHERS. THEY ARE NOT INTENDED TO REPRESENT IN DETAIL THE EXACT LOCATION, TYPE OF COMPONENT NOR MANNER OF CONSTRUCTION. THE ENGINEER WILL NOT BE RESPONSIBLE FOR ANY ERRORS OR OMISSIONS WHICH HAVE BEEN INCORPORATED INTO THE RECORD DRAWINGS.

**CIVIL PUMP STATION PLANS AND DETAILS**

SHEET **C-3**  
DWG NO. 6 OF 49  
DATE JULY, 1986  
PROJ NO. S20923.C1

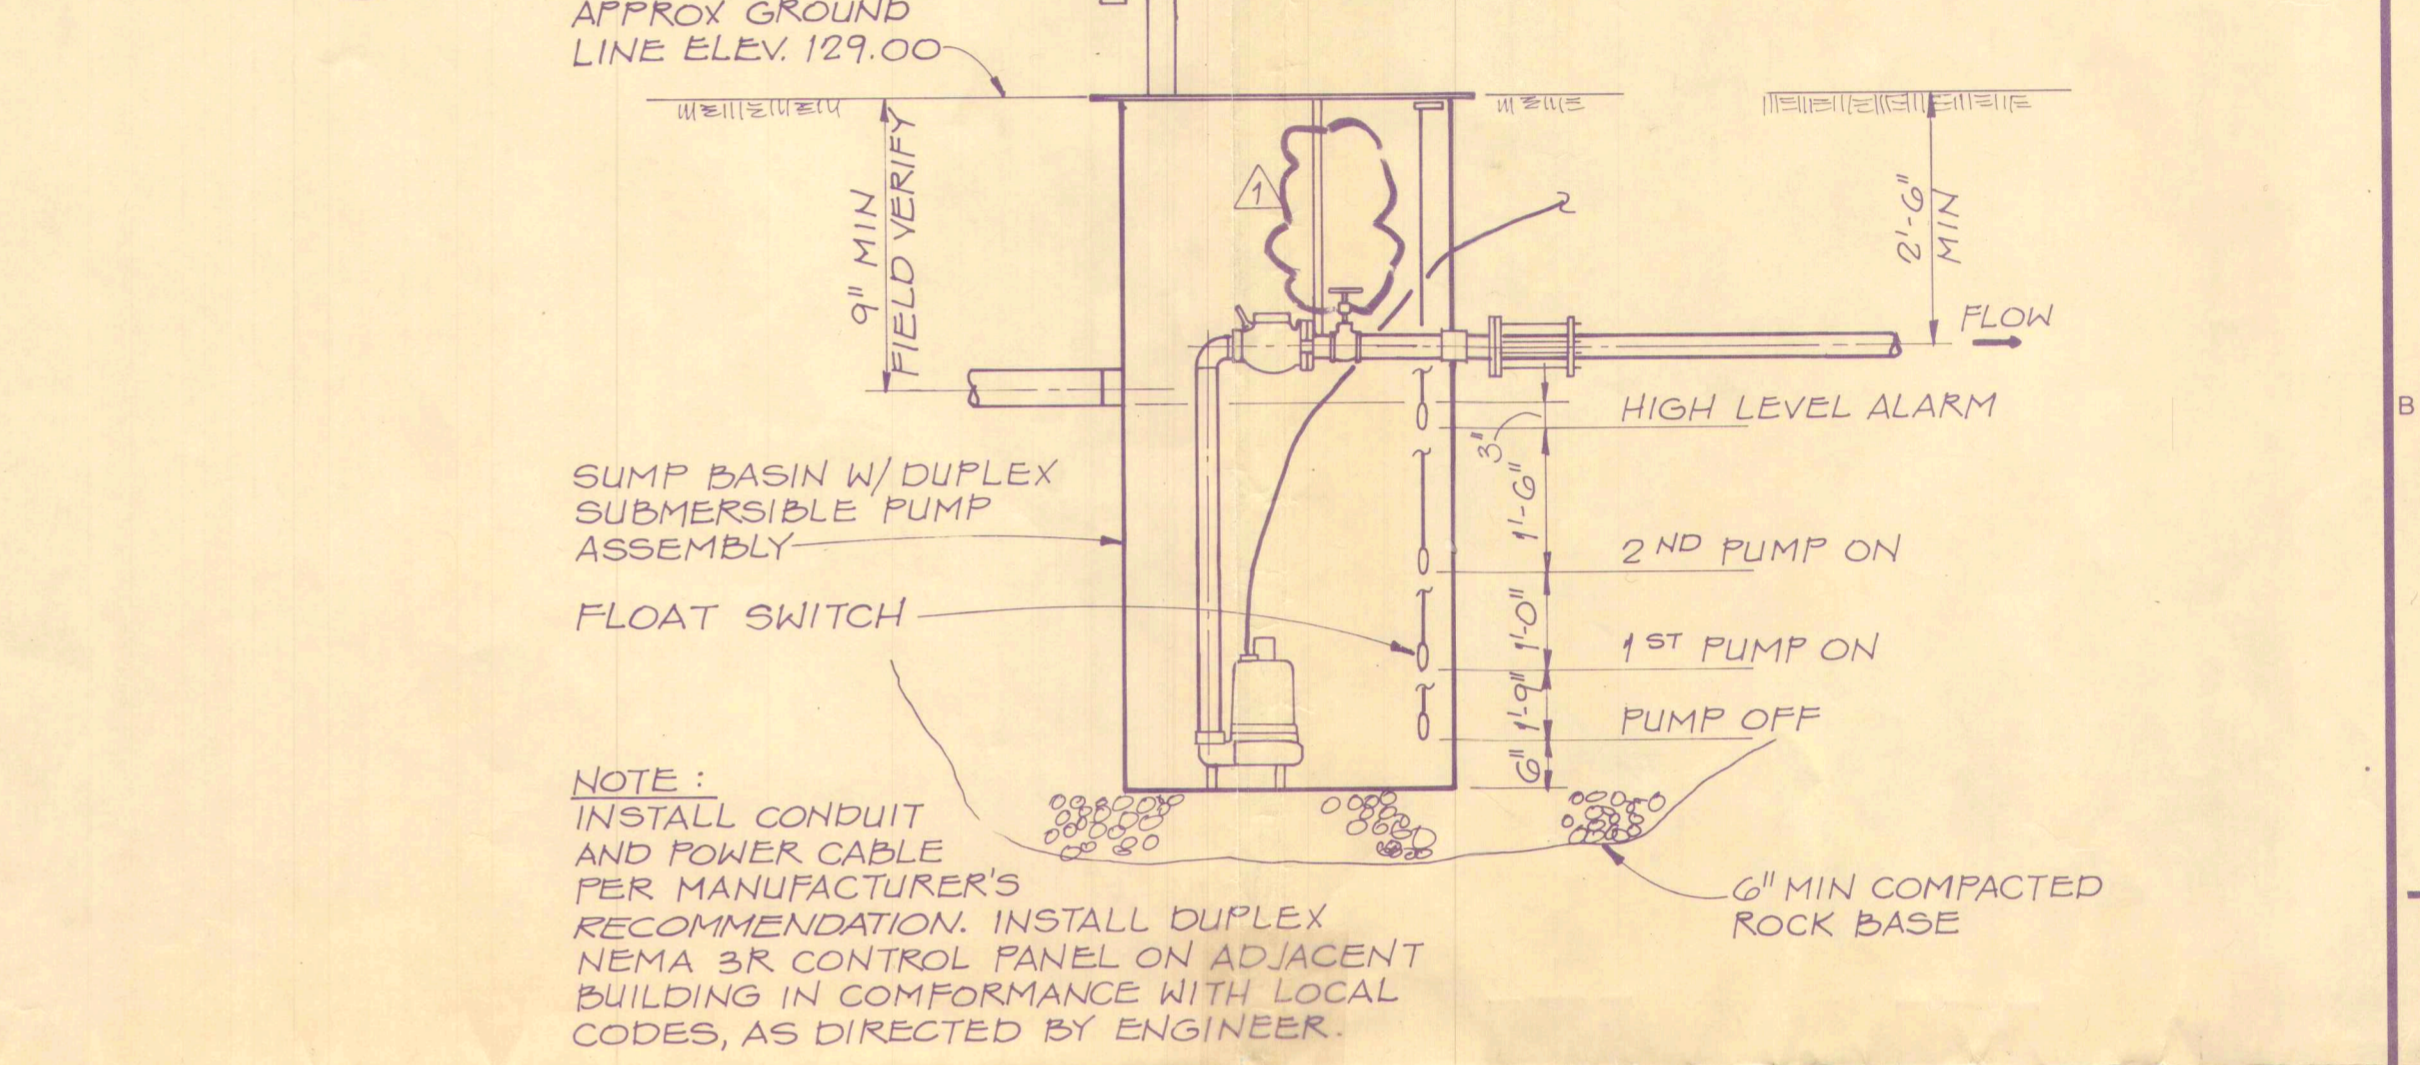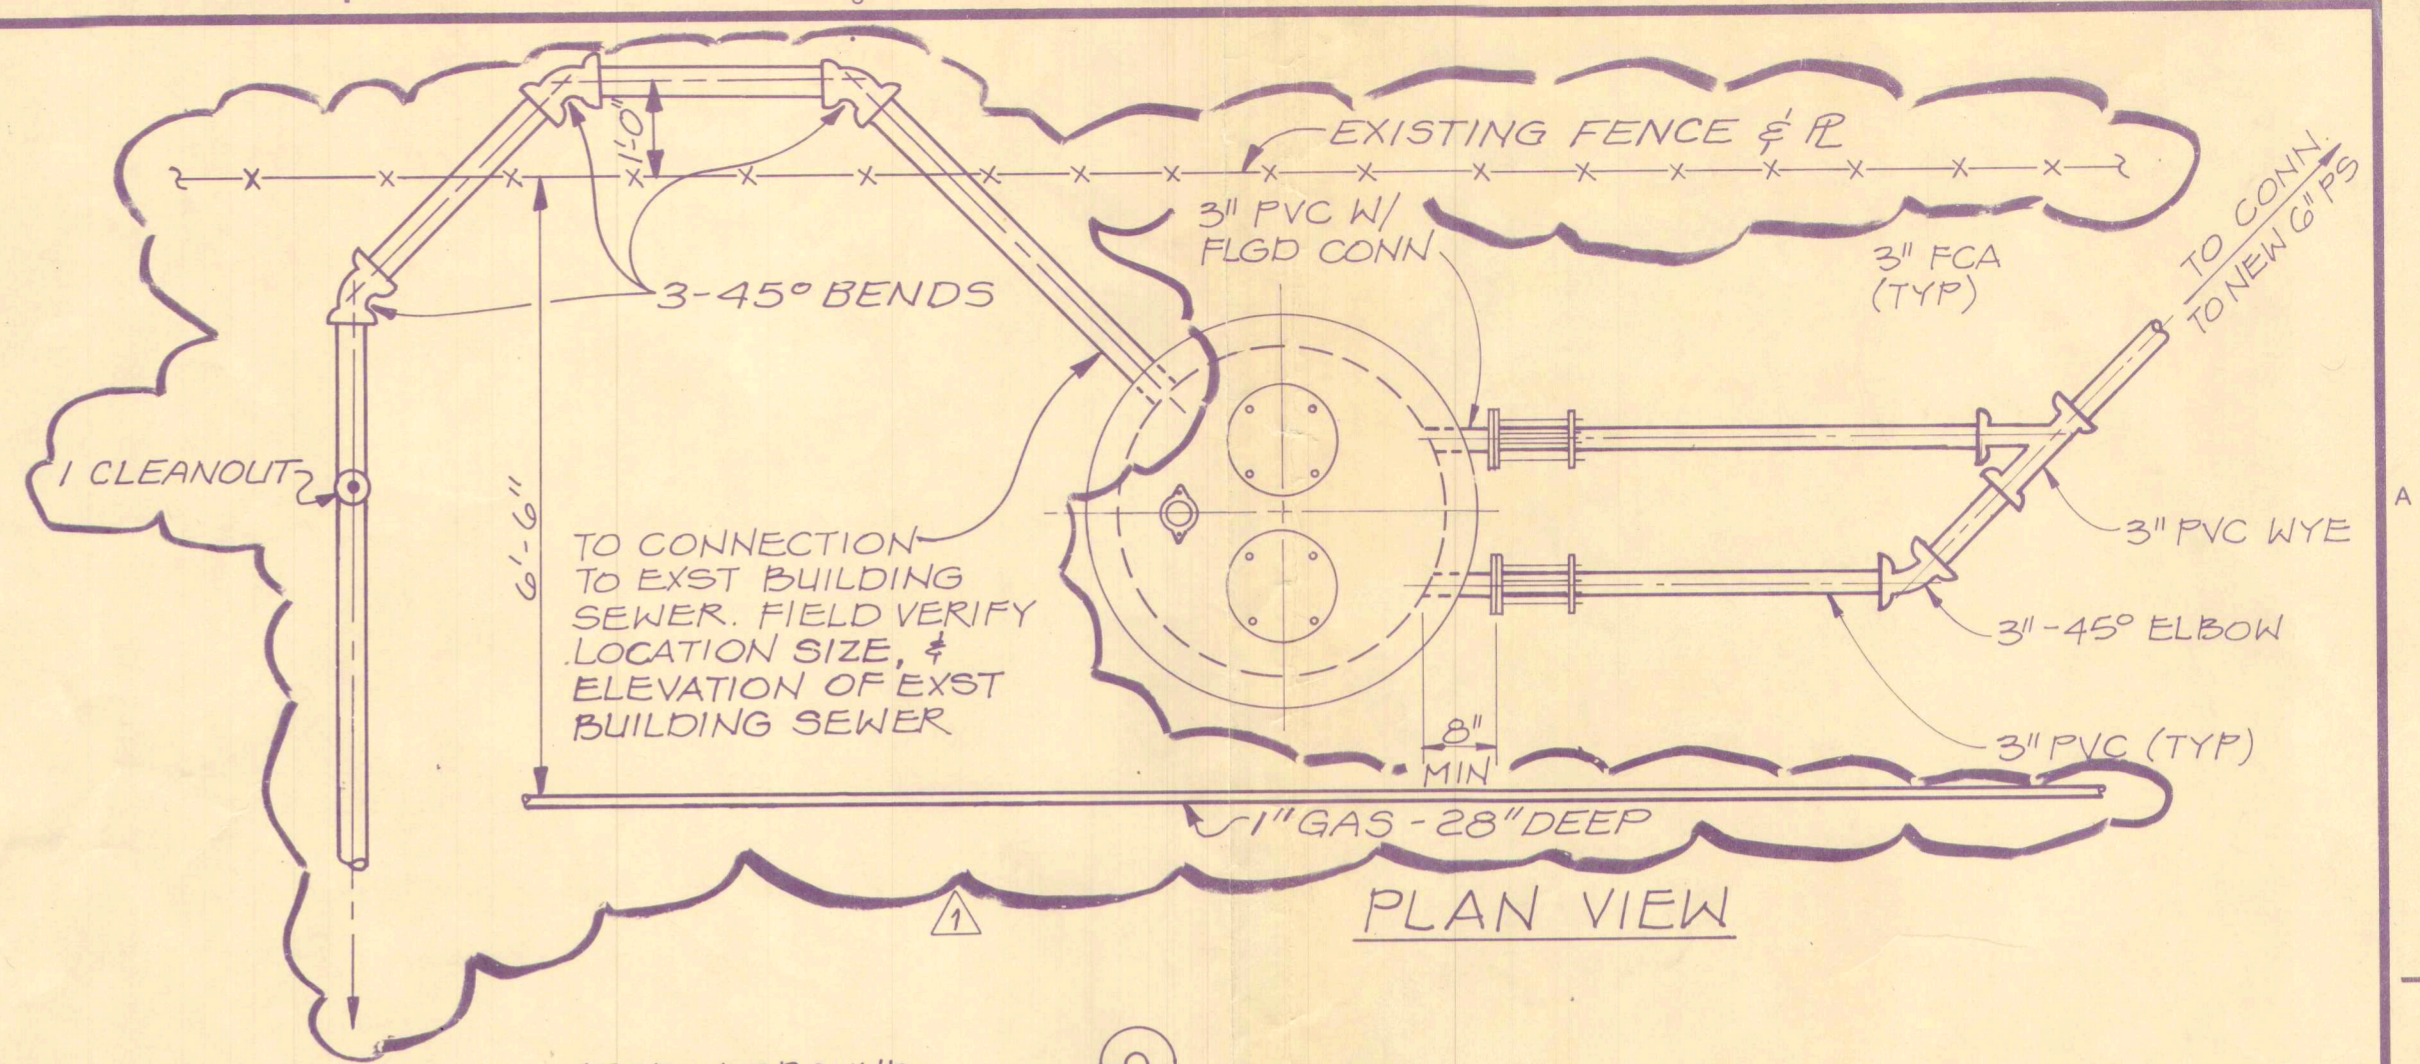

**SEWAGE EJECTOR PACKAGE SYSTEM DETAIL (2)**  
1/2" = 1'-0" C-5



**SEWAGE EJECTOR PACKAGE SYSTEM DETAIL (2)**  
1/2" = 1'-0" C-5

DSGN	R.F. FARRELL	NO.	DATE	REVISION	BY	APVD
DR	T.N. THOMAS					
CHK	D.L. DAWSON					
APVD	S. DEHN					

9-1-87 RECORD DRAWING

**SEWAGE EJECTOR PACKAGE SYSTEM DETAIL (2)**  
1/2" = 1'-0" C-5

**RECORD DRAWINGS**  
Revisions Drawn by \_\_\_\_\_ Date \_\_\_\_\_

THESE RECORD DRAWINGS HAVE BEEN PREPARED, IN PART, ON THE BASIS OF INFORMATION COMPILED BY OTHERS. THEY ARE NOT INTENDED TO REPRESENT IN DETAIL THE EXACT LOCATION, TYPE OF COMPONENT NOR MANNER OF CONSTRUCTION. THE ENGINEER WILL NOT BE RESPONSIBLE FOR ANY ERRORS OR OMISSIONS WHICH HAVE BEEN INCORPORATED INTO THE RECORD DRAWINGS.

**CIVIL PUMP STATION PLANS AND DETAILS**

SHEET **C-3**  
DWG NO. 6 OF 49  
DATE JULY, 1986  
PROJ NO. S20923.C1