


PLAN
SCALE: 1/2" = 1'-0"

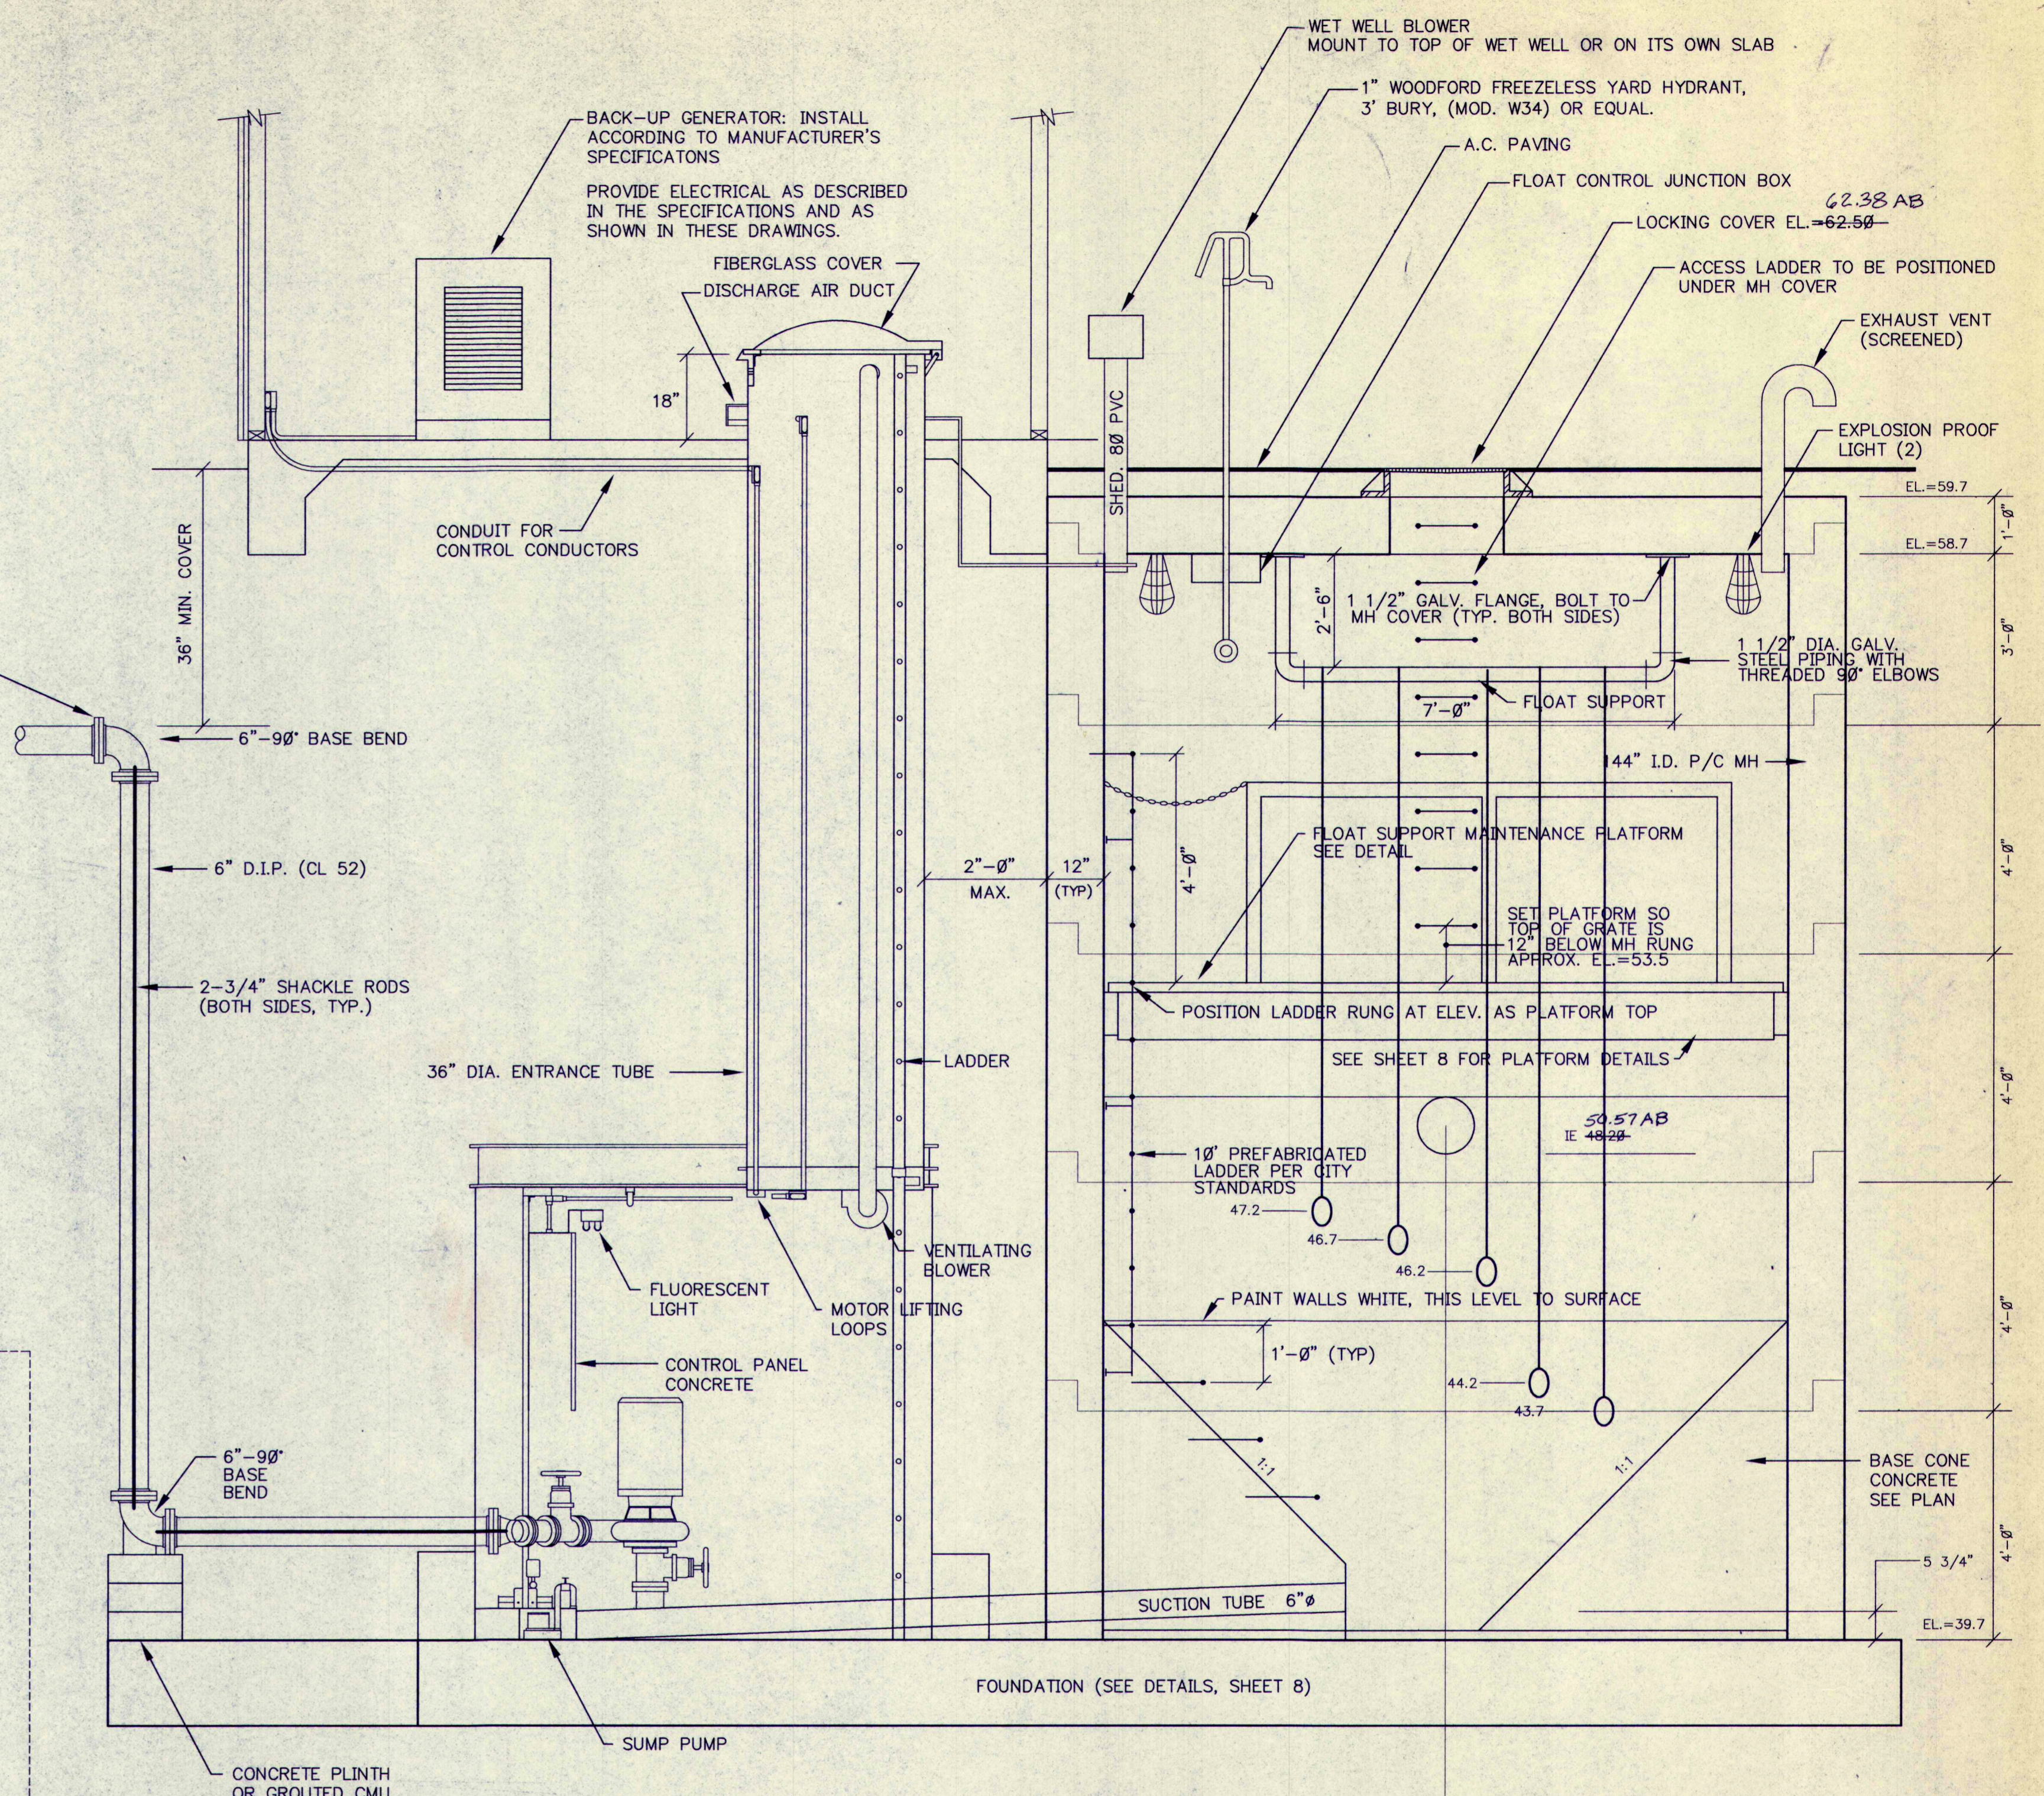


SECTION
SCALE: 1/2" = 1'-0"

NOTES:
A COMPLETE SET OF PUMP STATION STANDARDS AND SPECIFICATIONS ARE AVAILABLE FROM THE WASTEWATER DEPARTMENT.
CONTACT BRUCE SCHLAGEL AT 435-3811.

AS BUILT
AS INDICATED BY "AB"

SW 1/4, SE 1/4, SEC 10, TWP 31N, RGE 5E, W.M.

NO.	REVISION	DATE
1	PER CITY REVIEW 1/15/97	1/30/97
2	PER CITY REVIEW 2/10/97	2/19/97

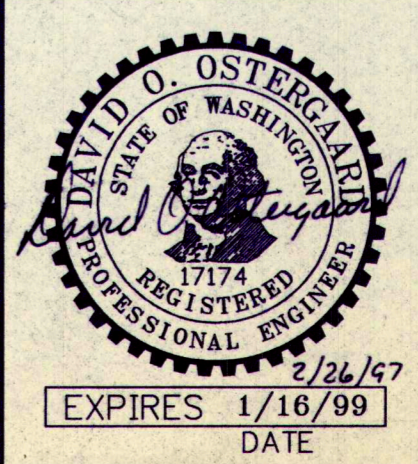

OSTERGAARD • ROBINSON
& ASSOC. INC. CONSULTING ENGINEERS
3630 COLBY AVE. EVERETT, WA 98201
(206) 259-8445 BELLEVUE: (206) 827-5854

Designed DO/ME
Drawn ME
Submitted
Approved

CITY OF ARLINGTON
APPROVED
By: _____ DATE _____

BUENA VISTA HEIGHTS
LIFT STATION
PLAN + SECTION
CITY OF ARLINGTON WASHINGTON

Sheet 8 of 10
Job No. 92115

RIVERCREST ESTATES