

222

AS BUILT

SR 9

**SR 531 1/2ND ST NE & EAGLEFIELD DR
INTERSECTION IMPROVEMENT & PAVING**

Washington State Department of Transportation
Olympia, Washington 98504

Scale: Horiz. 1 inch =	feet	Vert. 1 inch =	feet
MP	to MP	Constructed Length	miles(s)
Contract No.	F.A. No.	Contractor	
Work Begun	Work Completed		
Project Engineer	Region Administrator		
Approved	Date		

Secretary of Transportation

222

INDEX

INDEX (CONTINUED)

SHEET NO.	PLAN REFERENCE NO.	TITLE
		VOLUME 1
1	I1	INDEX - VOLUME 1
2	VM1	VICINITY MAP
3 - 7	SQ1 - SQ5	SUMMARY OF QUANTITIES
8	RC1	CONTRACT RECLAMATION
9 - 15	RS1 - RS7	ROADWAY SECTIONS
16 - 20	CP1 - CP5	CONSTRUCTION PHASING PLAN
21 - 28	AL1 - AL8	ALIGNMENT / RIGHT OF WAY
29	QTSP1	QUANTITY TABULATION - SITE PREPARATION
30 - 37	SP1 - SP8	SITE PREPARATION PLAN
38 - 41	RP1 - RP4	ROADWAY PROFILE
42 - 43	QTEC1 - QTEC2	QUANTITY TABULATION - TEMPORARY EROSION CONTROL
44 - 51	TESC1 - TESC8	TEMPORARY EROSION CONTROL PLAN
52 - 53	TECD1 - TECD2	TEMPORARY EROSION CONTROL DETAIL
54 - 61	ECP1 - ECP8	ENVIRONMENTAL COMPLIANCE PLAN
62 - 67	DSN1 - DSN6	STRUCTURE NOTES - DRAINAGE
68 - 73	D1 - D6	DRAINAGE PLAN
74 - 82	DP1 - DP9	DRAINAGE PROFILE
83 - 88	DD1 - DD6	DRAINAGE DETAILS
89 - 90	UTSN1 - UTSN2	STRUCTURE NOTES - UTILITIES
91 - 97	UT1 - UT7	UTILITY PLAN
98 - 100	UP1 - UP3	UTILITY PROFILE
101 - 104	UD1 - UD4	UTILITY DETAILS
105 - 111	PL1 - PL7	PLANTING PLAN
112 - 114	PLD1 - PLD3	PLANTING DETAILS

SHEET NO.	PLAN REFERENCE NO.	TITLE
		VOLUME 2
115	I2	INDEX - VOLUME 2
116 - 121	QTPV1 - QTPV6	QUANTITY TABULATION - PAVING
122 - 123	TPP1 - TPP2	TEMPORARY PAVING PLAN
124 - 131	P1 - P8	PAVING PLAN
132 - 149	PD1 - PD18	PAVING DETAIL
150 - 154	QTPM1 - QTPM5	QUANTITY TABULATION - PAVEMENT MARKING
155 - 156	TPM1 - TPM2	TEMPORARY PAVEMENT MARKING PLAN
157 - 164	PM1 - PM8	PAVEMENT MARKING PLAN
165 - 166	TIL1 - TIL2	TEMPORARY ILLUMINATION PLAN
167 - 168	IL1 - IL2	ILLUMINATION PLAN
169 - 181	TTS1 - TTS13	TEMPORARY TRAFFIC SIGNAL PLAN
182 - 184	TSD1 - TSD3	TEMPORARY TRAFFIC SIGNAL DETAILS
185 - 186	LR1 - LR2	LOOP REPLACEMENT PLAN
187 - 191	SS1 - SS5	SIGN SPECIFICATIONS
192 - 197	S1 - S6	SIGNING PLAN
198	TSR1	TEMPORARY SIGNING RELOCATION PLAN
199 - 226	TC1 - TC28	TRAFFIC CONTROL PLAN
227	TCP1	TEMPORARY TRAFFIC CONTROL PAVING
228	PTC1	PEDESTRIAN TRAFFIC CONTROL PLAN
229 - 230	DTP1 - DTP2	DETOUR PLAN

PLAN REFERENCE NO.
SHEET OF SHEETS

NOTE: ALL SHEET REFERENCES, FIRST NOS. OF STRUCTURE CODE DESIGNATIONS AND MATCH LINE SHEET REFERENCES, ETC., THROUGHOUT THE PLANS, REFER TO THE ENTRY IN THE PLAN REFERENCE NUMBER BOX.

FILE NAME	I:\Projects\XL3325_SR9_SR531_172nd_St_NE_In\CAD\IPS&ESheets\XL3325_INDEX_VICINITY_MAP.dgn			REGION NO.	STATE	FED.AID PROJ.NO.	Washington State Department of Transportation	SR 9	Plot 2
TIME	12:54:34 PM			10	WASH			SR 531/172ND ST NE & EAGLEFIELD DR	PLAN REF NO
DATE	9/19/2011			JOB NUMBER				11	
PLOTTED BY	solwolk			CONTRACT NO.				SHEET	
DESIGNED BY	M.GUNN							1	
ENTERED BY	K.SOLWOLD							OF	
CHECKED BY	J.KORESKE							230	
PROJ. ENGR.	S.SPAHR							SHEETS	
REGIONAL ADM.	L.ENG								
	REVISION	DATE	BY					INDEX - VOLUME 1	

T. 31N. R. 5E. W.M.

END PROJECT
SR 9 MP 27.07
STA. A 863+77.00

NOTES:
1. FOR DETOUR ROUTES SEE SHEET DTP1 AND DTP2

PIT SITE
ACCESS ROAD

PIT SITE
NO. PS-D-245
SEE DETAIL ON RC1

INTERSECTION
STA. A 857+90.35

END EXCEPTION
SR9 MP 26.83
STA. A 851+45.00

BEGIN EXCEPTION
SR 9 MP 26.30
STA. A 823+21.00

BEGIN CONSTRUCTION
SR 531 MP 9.73
STA. B 10+53.80

END CONSTRUCTION
172ND ST NE
STA. B 24+02.00

INTERSECTION
A 810+01.20 =
B 18+76.95

BEGIN PROJECT
SR 9 MP 25.75
STA. A 794+50.00

FOR "AS CONSTRUCTED"
PLANS ONLY

T 32 N
T 31 N

R 5 E
R 6 E

ARLINGTON

ARLINGTON
MUNICIPAL
AIRPORT

ARLINGTON
MARYSVILLE

0 2500 5000
SCALE IN FEET

FILE NAME	I:\Projects\XL3325 SR9 SR531 172nd St NE Int\CADIPS&ESheets\XL3325 INDEX VICINITY MAP.dgn			REGION NO.	STATE	FED.AID PROJ.NO.	Washington State Department of Transportation	SR 9 SR 531/172ND ST NE & EAGLEFIELD DR INTERSECTION IMPROVEMENT & PAVING VICINITY MAP	Plot 1
TIME	3:42:48 PM			10	WASH				VM1
DATE	9/22/2011			JOB NUMBER	10A042				SHEET 2 OF 230 SHEETS
PLOTTED BY	gunnm			CONTRACT NO.					
DESIGNED BY	M.GUNN			LOCATION NO.					
ENTERED BY	K.SOLWOLD								
CHECKED BY	J.KORESKI								
PROJ. ENGR.	S.SPAHR								
REGIONAL ADM.	L. ENG								
REVISION		DATE	BY						

SUMMARY OF QUANTITIES

DOT_RGG900

10/26/2011

ITEM NO	TOTAL QUANTITY	SUB-TOTAL * SECTION I-07.2(1) OF STANDARD SPECS	SUB-TOTAL ** SECTION I-07.2(2) OF STANDARD SPECS	STD. ITEM NO.	UNIT	ITEM	GROUP 1	GROUP 2	GROUP 3	GROUP 4	GROUP 5	GROUP 6	GROUP 7	GROUP 8	GROUP 9	GROUP 10	GROUP 11						
							SR 9 (A 794+50 TO A 796+68)	SR 9 (A 796+68 TO A 823+21)	SR 531 (B 10+54 TO B 15+50)	172ND ST (B 21+80 TO B 23+04)	172ND ST (B 23+04 TO B 24+02)	UT01495 W/ ARLINGTON (B 10+54 - B 15+50)	UT01495 W/ ARLINGTON (B 15+50 - B 21+80)	UT01495 W/ ARLINGTON (B 21+80 - B 23+04)	WSDOT PIT SITE PS-D-245	SR 9 MP 26.83 TO MP 27.07	THIRD PARTY DAMAGES						
PREPARATION																							
1	LUMP SUM	LUMP SUM	LUMP SUM	0001	L.S.	MOBILIZATION	L.S.	L.S.	L.S.	L.S.					L.S.	L.S.							
2	LUMP SUM	LUMP SUM			L.S.	MOBILIZATION FOR AGREEMENT 01495						L.S.	L.S.	L.S.									
3	6.34	6.24	0.10	0025	ACRE	CLEARING AND GRUBBING	0.10	4.44	1.05	0.40	0.35												
4	0.04	0.04			ACRE	CLEARING AND GRUBBING FOR AGREEMENT 01495						0.01	0.02	0.01									
5	LUMP SUM	LUMP SUM		0050	L.S.	REMOVAL OF STRUCTURE AND OBSTRUCTION		L.S.	L.S.												L.S.		
6	7560.00	7560.00		0120	S.Y.	REMOVING ASPHALT CONC. PAVEMENT		6,640.00	190.00												730.00		
7	15540.00	15540.00		0187	L.F.	REMOVING PAINT LINE		13,170.00	1,940.00	110.00	110.00										210.00		
8	3580.00	3580.00		0190	L.F.	REMOVING PLASTIC LINE															3,580.00		
9	20.00	20.00		0200	EACH	REMOVING PLASTIC TRAFFIC MARKING		8.00													12.00		
10	990.00	990.00		0203	S.F.	REMOVING PAINTED CROSSWALK LINE		990.00															
11	740.00	740.00		0204	S.F.	REMOVING PLASTIC CROSSWALK LINE															740.00		
12	2330.00	2330.00		0230	L.F.	REMOVING WIRE FENCE		1,920.00	290.00	60.00	60.00												
13	13.00	13.00			EACH	REMOVING CATCH BASIN		10.00	2.00	1.00													
14	1560.00	1560.00			L.F.	REMOVING STORM SEWER PIPE		1,560.00															
15	LUMP SUM	LUMP SUM			L.S.	REMOVING TEMPORARY PAVING AREAS		L.S.															
16	LUMP SUM	LUMP SUM			L.S.	REMOVAL OF EXISTING WATER MAIN FOR AGREEMENT 01495						L.S.	L.S.	L.S.									
GRADING																							
17	18450.00	18360.00	90.00	0310	C.Y.	ROADWAY EXCAVATION INCL. HAUL	90.00	15,670.00	1,260.00	620.00	550.00										260.00		
18	740.00	740.00		0350	C.Y.	UNSUITABLE FOUNDATION EXCAVATION INCL. HAUL		610.00	130.00														
19	14150.00	14070.00	80.00	0408	TON	SELECT BORROW INCL. HAUL	80.00	12,480.00	1,550.00	20.00	20.00												
20	122.00	122.00		0440	TON	SAND DRAINAGE BLANKET		122.00															
21	5550.00	5500.00	50.00	0470	C.Y.	EMBANKMENT COMPACTION	50.00	5,190.00	310.00														
22	5286.00	5286.00			S.F.	GEOSYNTHETIC CLAY LINER		5,286.00															
DRAINAGE																							
23	3.00	3.00		1046	EACH	CONCRETE INLET		3.00															
24	1.00	1.00		1054	EACH	GRATE INLET TYPE 2		1.00															
25	1.00	1.00		1058	EACH	DROP INLET TYPE 1		1.00															
26	3000.00	3000.00		1086	TON	QUARRY SPALLS		2,090.00	910.00														
27	74.00	74.00		1160	L.F.	UNDERDRAIN PIPE 6 IN. DIAM.		74.00															
28	173.00	173.00		1180	L.F.	SCHEDULE A CULV. PIPE 12 IN. DIAM.		84.00	89.00														
STORM SEWER																							
29	1.00	1.00		3090	EACH	CATCH BASIN TYPE 2 54 IN. DIAM. WITH FLOW RESTRICTOR		1.00															
30	25.00	25.00		3091	EACH	CATCH BASIN TYPE 1		20.00	4.00	1.00													
31	7.00	7.00		3105	EACH	CATCH BASIN TYPE 2 48 IN. DIAM.		4.00	3.00														
32	3679.00	3679.00		3151	L.F.	TESTING STORM SEWER PIPE		2,764.00	848.00	34.00	33.00												
33	3579.00	3579.00		3541	L.F.	SCHEDULE A STORM SEWER PIPE 12 IN. DIAM.		2,664.00	848.00	34.00	33.00												
34	100.00	100.00		3542	L.F.	SCHEDULE A STORM SEWER PIPE 18 IN. DIAM.		100.00															
35	1.00	1.00			EACH	CONICAL OVERFLOW RACK		1.00															
36	LUMP SUM	LUMP SUM			L.S.	DETENTION VAULT			L.S.														
SANITARY SEWER																							
37	888.00	888.00			L.F.	TESTING SEWER PIPE FOR AGREEMENT 01495						372.00	516.00										
38	888.00	888.00			L.F.	PVC SANITARY SEWER PIPE 12 IN. DIAM. FOR AGRMNT 01495						372.00	516.00										
39	5.00	5.00			EACH	MANHOLE JOINT SEALING FOR AGREEMENT 01495								5.00									

**Preliminary Quantities Only
See Final Record Book 1
for Actual Quantities**

**FOR "AS CONSTRUCTED
PLAN"**

GROUP NUMBER	SR	CONTROL SECTION	TAX SCHEDULE	FUND PARTICIPANTS
1	009	313200	**	STATE AZ
2	009	313202	*	STATE AZ
3	531	312901	*	STATE AZ
4	000	3100CT	*	STATE AZ
5	000	3100CY	*	STATE AZ
6	531	312901	*	CITY OF ARLINGTON
7	009	313202	*	CITY OF ARLINGTON
8	000	3100CT	*	CITY OF ARLINGTON

GROUP NUMBER	SR	CONTROL SECTION	TAX SCHEDULE	FUND PARTICIPANTS
9	000	31SL00	**	STATE AZ
10	009	313202	*	STATE AA
11	009	313202	*	STATE AZ

10/25/11	REVISED ITEM 73	L.S.	REGION	STATE	FEDERAL AID PROJECT NO.			
10/25/11	REV QTY'S NO 18, 26, 34, 86, 87, 89, 95, 98, 106, 107, 187	JL	10	WA				
10/26/11	ADDED ITEM 195	JL						
DATE	REVISION	BY						

Washington State
Department of Transportation

SR 9
SR531 / 172ND ST NE & EAGLEFIELD DR
INTERSECTION IMPROVEMENT & PAVING

SQ1
SHEET
3
OF
230
SHEETS

SUMMARY OF QUANTITIES

SUMMARY OF QUANTITIES

DOT_RGG900

10/26/2011

ITEM NO	TOTAL QUANTITY	SUB-TOTAL * SECTION I-07.2(1) OF STANDARD SPECS	SUB-TOTAL ** SECTION I-07.2(2) OF STANDARD SPECS	STD. ITEM NO.	UNIT	ITEM	GROUP 1	GROUP 2	GROUP 3	GROUP 4	GROUP 5	GROUP 6	GROUP 7	GROUP 8	GROUP 9	GROUP 10	GROUP 11
							SR 9 (A 796+50 TO A 796+68)	SR 9 (A 796+68 TO A 823+21)	SR 531 (B 10+54 TO B 15+50)	172ND ST (B 21+80 TO B 23+04)	172ND ST (B 23+04 TO B 24+02)	UT01495 W/ ARLINGTON (B 10+54 - B 15+50)	UT01495 W/ ARLINGTON (B 15+50 - B 21+80)	UT01495 W/ ARLINGTON (B 21+80 - B 23+04)	WSDOT PIT SITE PS-D-245	SR 9 MP 26.83 TO MP 27.07	THIRD PARTY DAMAGES
75	5630.00	5530.00	100.00	6373	L.F.	SILT FENCE	100.00	2,530.00	240.00							2,760.00	
76	100000.00	100000.00		6490	DOL	EROSION/WATER POLLUTION CONTROL		100,000.00									
77	5000.00	5000.00			DOL	EROSION/WATER POLLUTION CONTROL FOR AGREEMENT 01495						5,000.00					
78	2.08	1.83	0.25	6414	ACRE	SEEDING, FERTILIZING, AND MULCHING		1.83						0.25			
79	0.24	0.24			ACRE	SEEDING, FERTILIZING AND MULCHING FOR AGREEMENT 01495							0.24				
80	1462.00	1362.00	100.00		L.F.	MEDIA FILTER DRAIN TYPE 1	100.00	1,362.00									
81	1509.00	1509.00			L.F.	MEDIA FILTER DRAIN TYPE 2		1,509.00									
82	480.00	480.00		6405	C.Y.	TOPSOIL TYPE A		480.00									
83	2642.00	2642.00		6552	EACH	PSIPE WESTERN SWORD FERN, 6 IN. SPREAD, NO. 1 CONT.		2,351.00	291.00								
84	471.00	451.00	20.00	6552	EACH	PSIPE WESTERN REDCEDAR, 18 IN. HT., NO. 2 CONT.	20.00	378.00	14.00	89.00							
85	4.00	4.00		6552	EACH	PSIPE WESTERN REDCEDAR, 6 FT. HT., B&B		4.00									
86	170.00	170.00		6552	EACH	PSIPE WESTERN CRABAPPLE, 12 IN. HT., NO. 1 CONT.		151.00	19.00								
87	695.00	695.00		6552	EACH	PSIPE VINE MAPLE, 12 IN. HT., NO. 1 CONT.		620.00	27.00	48.00							
88	106.00	106.00		6552	EACH	PSIPE SNOWBERRY, 10 IN. HT., NO. 1 CONT.			106.00								
89	307.00	307.00		6552	EACH	PSIPE THIMBLEBERRY, 12 IN. HT., NO. 1 CONT.		273.00	34.00								
90	172.00	172.00		6552	EACH	PSIPE SCOUER WILLOW, 15 IN. HT., NO. 1 CONT.		154.00	18.00								
91	544.00	494.00	50.00	6552	EACH	PSIPE SLOUGH SEDGE, BARE ROOD OR PLUG	50.00	494.00									
92	1520.00	1397.00	123.00	6552	EACH	PSIPE SALMONBERRY, 12 IN. HT., NO. 1 CONT.	123.00	1,263.00	134.00								
93	10550.00	10550.00		6552	EACH	PSIPE SALAL, 6 IN. SPREAD, NO. 1 CONT.		9,671.00	81.00	798.00							
94	382.00	317.00	65.00	6552	EACH	PSIPE RED-OISER DOGWOOD, 12 IN. HT., NO. 1 CONT.	65.00	227.00	90.00								
95	737.00	642.00	95.00	6552	EACH	PSIPE RED ELDERBERRY, 12 IN. HT., NO. 1 CONT.	95.00	550.00	86.00								
96	91.00	91.00		6552	EACH	PSIPE SNOWDRIFT CRABAPPLE, 2 IN. CAL., B&B		77.00	14.00								
97	160.00	160.00		6552	EACH	PSIPE NOOTKA ROSE, 12 IN. HT., NO. 1 CONT.			160.00								
98	1285.00	1190.00	95.00	6552	EACH	PSIPE INDIAN PLUM, 12 IN. HT., NO. 1 CONT.	95.00	1,075.00	115.00								
99	88.00	88.00		6552	EACH	PSIPE DOUGLAS SPIRAEA, 12 IN. HT., NO. 1 CONT.			88.00								
100	4.00	4.00		6552	EACH	PSIPE WESTERN HEMLOCK, 6 FT. HT., B&B		4.00									
101	13.00	13.00		6552	EACH	PSIPE CASCARA, 12 IN. HT., NO. 1 CONT.		13.00									
102	93.00	73.00	20.00	6552	EACH	PSIPE BITTER CHERRY, 12 IN. HT., NO. 1 CONT.	20.00	51.00	22.00								
103	110.00	110.00		6552	EACH	PSIPE BEAKED HAZELNUT, 12 IN. HT., NO. 1 CONT.		101.00	9.00								
104	45000.00	45000.00		6606	DOL	PLANT ESTABLISHMENT - SECOND YEAR		45,000.00									
105	40000.00	40000.00		6608	DOL	PLANT ESTABLISHMENT - THIRD YEAR		40,000.00									
106	1685.00	1665.00	20.00	6530	C.Y.	SOIL AMENDMENT	20.00	1,652.00	13.00								
107	1422.00	1358.00	64.00	6580	C.Y.	BARK OR WOOD CHIP MULCH	64.00	1,358.00									
108	6300.00	6200.00	100.00	6630	L.F.	HIGH VISIBILITY FENCE	100.00	3,200.00	240.00						2,760.00		
109	LUMP SUM	LUMP SUM			L.S.	CHITOSAN-ENHANCED SAND FILTRATION SYSTEM		L.S.									
110	250.00	250.00			hour	OPERATION OF CHITOSAN ENHANCED SAND FILTRATION SYSTEM		250.00									
111	LUMP SUM	LUMP SUM			L.S.	STORMWATER CHEMICAL TREATMENT PLAN		L.S.									
112	4.00	4.00			EACH	TEMPORARY ROADWAY CROSSING		4.00									
TRAFFIC																	
113	976.00	976.00		6700	L.F.	CEMENT CONC. TRAFFIC CURB AND GUTTER		160.00	509.00	57.00	57.00					193.00	
114	48.00	48.00		6701	L.F.	CEMENT CONC. TRAFFIC CURB			48.00								
115	333.00	333.00			L.F.	MOUNTABLE CURB & GUTTER 2 IN.		333.00									
116	3978.00	3978.00			L.F.	MOUNTABLE CURB & GUTTER 4 IN.		3,429.00	324.00	225.00							
117	263.00	263.00			L.F.	CENTRAL ISLAND CURB & GUTTER		263.00									
118	404.00	404.00		6707	L.F.	CEMENT CONC. PEDESTRIAN CURB		236.00	48.00						120.00		
119	306.00	306.00		6727	L.F.	EXTRUDED CURB		193.00	113.00								
120	3778.00	3778.00		6781	L.F.	TEMPORARY CONC. BARRIER		3,778.00									
121	6.00	6.00		7440	EACH	TEMPORARY IMPACT ATTENUATOR		6.00									

**Preliminary Quantities Only
See Final Record Book 1
for Actual Quantities**

**FOR AS CONSTRUCTION
PLANS ONLY**

GROUP NUMBER	SR	CONTROL SECTION	TAX SCHEDULE	FUND PARTICIPANTS
1	009	313200	**	STATE AZ
2	009	313202	*	STATE AZ
3	531	312901	*	STATE AZ
4	000	3100CT	*	STATE AZ
5	000	3100CY	*	STATE AZ
6	531	312901	*	CITY OF ARLINGTON
7	009	313202	*	CITY OF ARLINGTON
8	000	3100CT	*	CITY OF ARLINGTON

GROUP NUMBER	SR	CONTROL SECTION	TAX SCHEDULE	FUND PARTICIPANTS
9	000	31SL00	**	STATE AZ
10	009	313202	*	STATE AA
11	009	313202	*	STATE AZ

10/25/11 REVISED ITEM 73	LS	REGION	STATE	FEDERAL AID PROJECT. NO.	Washington State Department of Transportation	SR 9 SR531 / 172ND ST NE & EAGLEFIELD DR INTERSECTION IMPROVEMENT & PAVING	SQ3 SHEET 5 OF 230 SHEETS
10/25/11 REV QTY'S NO. 18, 26, 84, 86, 87, 89, 95, 98, 106, 107, 187	JL	10	WA				
10/26/11 ADDED ITEM 195	JL						
DATE	REVISION	BY		008222	SUMMARY OF QUANTITIES		

SUMMARY OF QUANTITIES

DOT_RGG900

10/26/2011

ITEM NO	TOTAL QUANTITY	SUB-TOTAL * SECTION I-07.2(1) OF STANDARD SPECS	SUB-TOTAL ** SECTION I-07.2(2) OF STANDARD SPECS	STD. ITEM NO.	UNIT	ITEM	GROUP 1	GROUP 2	GROUP 3	GROUP 4	GROUP 5	GROUP 6	GROUP 7	GROUP 8	GROUP 9	GROUP 10	GROUP 11							
							SR 9 (A 794+50 TO A 796+68)	SR 9 (A 796+68 TO A 823+21)	SR 531 (B 10+54 TO B 15+50)	172ND ST (B 21+80 TO B 23+04)	172ND ST (B 23+04 TO B 24+02)	UT01495 W/ ARLINGTON (B 10+54 - B 15+50)	UT01495 W/ ARLINGTON (B 15+50 - B 21+80)	UT01495 W/ ARLINGTON (B 21+80 - B 23+04)	WSDOT PIT SITE PS-D-245	SR 9 MP 26.83 TO MP 27.07	THIRD PARTY DAMAGES							
169	103.00	103.00		7059	S.Y.	CEMENT CONC. DRIVEWAY ENTRANCE TYPE 1 MOD A			103.00															
170	66.00	66.00		7059	S.Y.	CEMENT CONC. DRIVEWAY ENTRANCE TYPE 1 MOD B			66.00															
171	8.00	8.00		7058	EACH	CEMENT CONC. CURB RAMP TYPE A		8.00																
172	7.00	7.00		7058	EACH	CEMENT CONC. CURB RAMP TYPE B			7.00															
173	4.00	4.00		7058	EACH	CEMENT CONC. CURB RAMP TYPE C			4.00															
174	2.00	2.00		7058	EACH	CEMENT CONC. CURB RAMP TYPE PERPENDICULAR											2.00							
175	3.00	3.00		7058	EACH	CEMENT CONC. CURB RAMP TYPE PARALLEL											3.00							
176	160.00	160.00		7054	S.F.	DETECTABLE WARNING SURFACE		160.00																
177	5050.00	4970.00	80.00	7111	L.F.	WIRE FENCE TYPE 2	80.00	4,970.00																
178	1.00	1.00		9605	EACH	CONNECTION TO DRAINAGE STRUCTURE			1.00															
179	5.00	5.00		7364	EACH	MANHOLE 60 IN. DIAM. TYPE 1 FOR AGREEMENT 01495							5.00											
180	16.00	16.00		7372	L.F.	MANHOLE ADDITIONAL HEIGHT 60 IN. DIAM. TYPE 1 - 01495							16.00											
181	1.00	1.00		7043	EACH	ADJUST JUNCTION BOX																		
182	10000.00	10000.00		7480	DOL	ROADSIDE CLEANUP		10,000.00																
183	LUMP SUM	LUMP SUM		7490	L.S.	TRIMMING AND CLEANUP		L.S.																
184	5.00	5.00		7725	DOL	REIMBURSEMENT FOR THIRD PARTY DAMAGE																		
185	-1.00	-1.00		7728	DOL	MINOR CHANGE		-1.00																
186	LUMP SUM	LUMP SUM		7736	L.S.	SPCC PLAN		L.S.																
187	2480.00	2480.00		7530	S.Y.	CONSTRUCTION GEOTEXTILE FOR SEPARATION		1,650.00	850.00															
188	70.00	70.00		7550	S.Y.	CONSTRUCTION GEOTEXTILE FOR UNDERGROUND DRAINAGE		70.00																
189	1.00	1.00		7562	EACH	MAILBOX SUPPORT TYPE 1		1.00																
190	2.00	2.00		7562	EACH	MAILBOX SUPPORT TYPE 2			2.00															
191	1277.00	1277.00			S.F.	REINFORCED GRASS SHOULDER		432.00	845.00															
192	1270.00	1270.00			S.Y.	GEOMEMBRANE		670.00	600.00															
193	LUMP SUM	LUMP SUM			L.S.	TEMPORARY DEWATERING SYSTEM		L.S.																
194	LUMP SUM	LUMP SUM			L.S.	TEMPORARY DEWATERING SYSTEM FOR AGREEMENT 01495																		
195	8110.00	8110.00			C.Y.	BANK RUN GRAVEL FOR TRENCH BACKFILL FOR AGMT 01495		1,477.00	6,650.00	18.00														
196	LUMP SUM	LUMP SUM			L.S.	CO1 CURE BOX																		
197					L.F.	CO4 DUCTILE IRON SEWER PIPE 12 IN. DIAM.																		
198	LUMP SUM	LUMP SUM			L.S.	CO7 SELECT BORROW INCL. HAUL																		
199					L.F.	CO9 ADJ. DEPTH TO 2" CONC. CURB & GUTTER																		
200					L.F.	CO9 ADJ. DEPTH TO 4" CONC. CURB & GUTTER																		
201					L.F.	CO16 WIRE FENCE TYPE 1																		
202	LUMP SUM	LUMP SUM			L.S.	CO11 CRIP SAVING INCENTIVE																		

Preliminary Quantities Only
See Final Record Book 1
for Actual Quantities

FOR "AS CONSTRUCTED
PLANS" ONLY

GROUP LEGEND:


GROUP NUMBER	SR	CONTROL SECTION	TAX SCHEDULE	FUND PARTICIPANTS
1	009	313200	**	STATE AZ
2	009	313202	*	STATE AZ
3	531	312901	*	STATE AZ
4	000	3100CT	*	STATE AZ
5	000	3100CY	*	STATE AZ
6	531	312901	*	CITY OF ARLINGTON
7	009	313202	*	CITY OF ARLINGTON
8	000	3100CT	*	CITY OF ARLINGTON

GROUP NUMBER	SR	CONTROL SECTION	TAX SCHEDULE	FUND PARTICIPANTS
9	000	313L00	**	STATE AZ
10	009	313202	*	STATE AA
11	009	313202	*	STATE AZ

10/25/11 REVISED ITEM 73	LS	REGION	STATE	FEDERAL AID PROJECT. NO.		
10/25/11 REV. QTY'S NO. 18, 26, 84, 86, 87, 89, 95, 98, 106, 107, 187	JL	10	WA		Washington State Department of Transportation	SR 9 SR531 / 172ND ST NE & EAGLEFIELD DR INTERSECTION IMPROVEMENT & PAVING
10/26/11 ADDED ITEM 195	JL					SQ5
						SHEET 7 OF 230 SHEETS
DATE				REVISION	BY	SUMMARY OF QUANTITIES
					008222	

- LEGEND**
- 1 PLANING BITUMINOUS PAVEMENT
 - 2 HMA CL. 1/2 IN. PG 64-22
 - 3 CRUSHED SURFACING BASE COURSE
 - 4 SELECT BORROW INCL. HAUL
 - 5 ROADWAY EXCAVATION INCL. HAUL
 - 6 EMBANKMENT COMPACTION
 - 7 PIGMENTED SPLITTER ISLAND
 - 8 MOUNTABLE CURB & GUTTER 4 IN.
 - 9 CEMENT CONC. PAVEMENT
 - 10 CEMENT CONC. TRAFFIC CURB AND GUTTER
 - 11 CEMENT CONC. SIDEWALK
 - 12 MOUNTABLE CURB & GUTTER 2 IN.
 - 13 CENTRAL ISLAND CURB & GUTTER
 - 14 TEXTURED AND PIGMENTED CEMENT CONCRETE PAVEMENT
 - 15 QUARRY SPALLS
 - 16 UNSUITABLE FOUNDATION EXCAVATION INCL. HAUL
 - 17 CONSTRUCTION GEOTEXTILE FOR SEPARATION
 - 18 REMOVING ASPHALT CONC. PAVEMENT

* FINAL CUT/FILL SHALL MATCH BACK SLOPE CATCH POINT OF TEMP DITCH. SLOPE SHALL NOT BE STEEPER THAN 4:1. REFER TO TPP1-TPP2.
 ** REFER TO PD9 FOR ADDITIONAL SIDEWALK DETAILS.

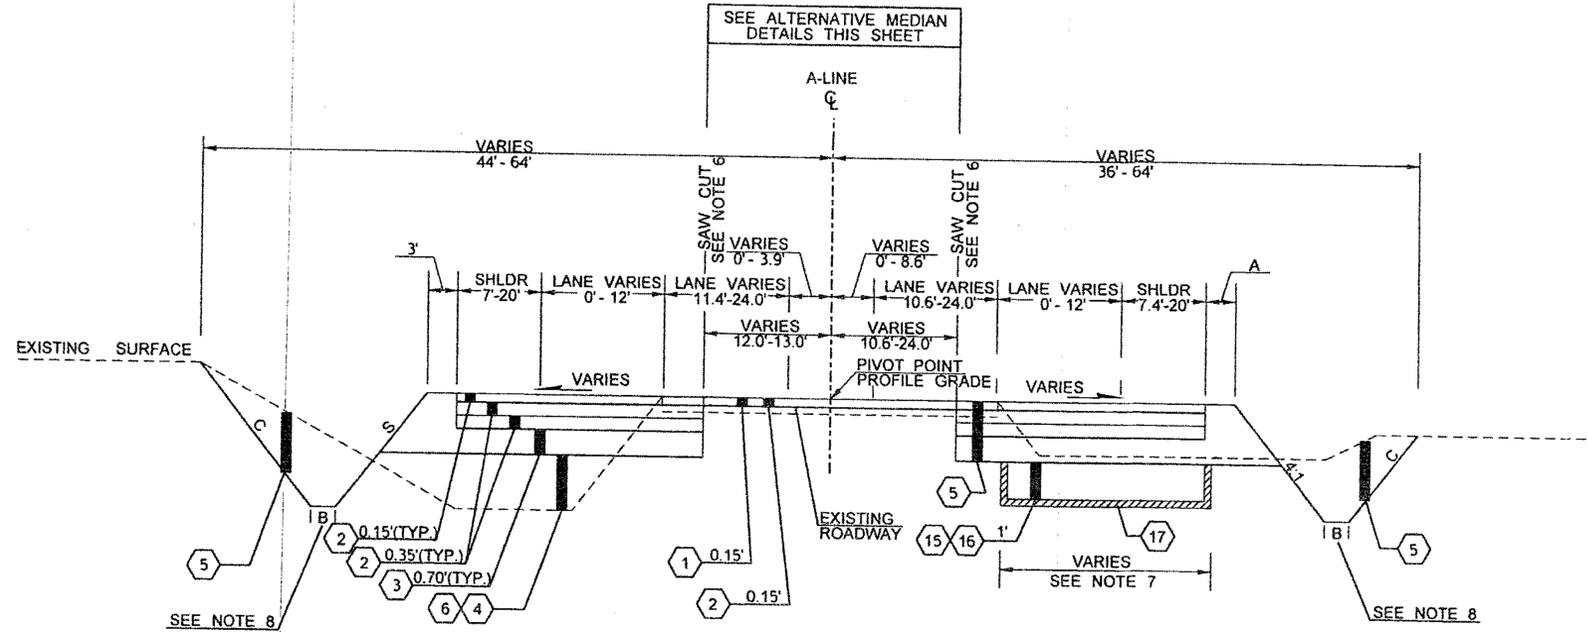

ROADWAY SECTION A


A 795+77.7 TO A 805+34.3
 A 814+66.6 TO A 819+58.1

CUT AND FILL TABLE (LT)	S	B	C	CUT/FILL
A 795+77.7 TO A 802+96.3	4:1	NA	NA	FILL
A 802+96.3 TO A 805+34.3	*	NA	NA	FILL
A 814+66.6 TO A 819+58.1	4:1	1.0'	4:1	CUT

CUT AND FILL TABLE (RT)	A	B	C	CUT/FILL
A 795+77.7 TO A 798+28.0	3.0'	NA	NA	FILL
A 798+28.0 TO A 805+34.3	3.0'	1.0'	3:1	CUT
A 814+66.6 TO A 815+40.0	1.0'	1.0'	3:1	CUT
A 815+40.0 TO A 817+10.0	1.0'	NA	NA	FILL
A 817+10.0 TO A 819+58.1	1.0'	1.0'	3:1	CUT


GENERAL NOTES:

1. ALL DEPTH SHOWN ARE FINAL COMPACTED DEPTHS AND SHALL CONFORM TO SECTIONS 2-03.3(14)C, 4-04.3(4) AND 5-04.3(9)
2. REFER TO PAVING PLANS FOR VARIABLE PAVING WIDTHS.
3. REFER TO ROADWAY PROFILES FOR SUPERELEVATION INFO.
4. REFER TO PAVING DETAIL SHEETS FOR ROUNDABOUT CURB INFO.
5. REFER TO DRAINAGE DETAIL, SHEET DD1, FOR MEDIA FILTER DRAIN LOCATIONS AND DIMENSIONS.
6. SAWCUT LINES SHALL BE ON THE EXISTING EDGE OF TRAVELED WAY ON SR9 AND 1' INSIDE EDGE OF PAVEMENT ON SR531/172ND. REFER TO PAVING PLANS FOR STATION LIMITS.
7. REFER TO ALIGNMENT/RIGHT OF WAY PLANS FOR UNSUITABLE FOUNDATION EXCAVATION LIMITS.
8. REFER TO DRAINAGE PROFILES FOR DITCH ELEVATIONS.
9. REFER TO SITE PREPARATION PLANS FOR PAVEMENT REMOVAL LIMITS.

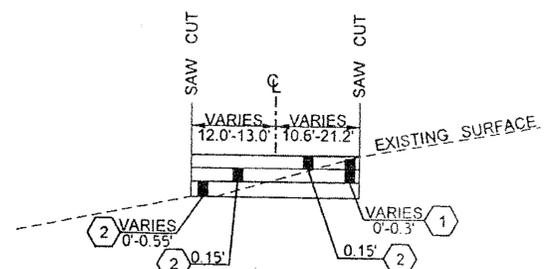

ALTERNATIVE MEDIAN A1

A 800+77.0 TO A 805+34.3
 A 815+85.0 TO A 819+58.0

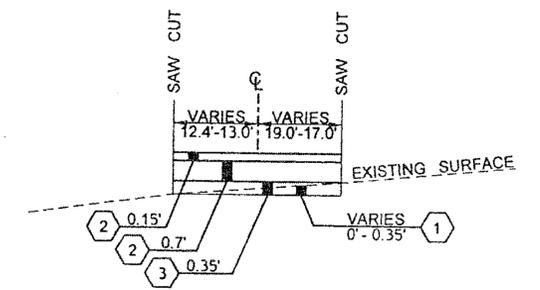

ALTERNATIVE MEDIAN A2

A 814+66.5 TO A 815+85.0

FOR "AS CONSTRUCTED" PLANS ONLY



N.T.S.

FILE NAME: I:\Projects\XL3325 SR9 SR531 172nd St NE Int\CAD\PS&ESheets\XL3325_PS_RS.dgn		REGION NO. 10 STATE WASH		FED.AID PROJ.NO.				SR 9		Plot 1
TIME: 12:44:13 PM	DATE: 9/28/2011	JOB NUMBER 10A042		LOCATION NO.				SR 531/172ND ST NE & EAGLEFIELD DR		
PLOTTED BY: gunnm	DESIGNED BY: M.GUNN	CONTRACT NO.		DATE: 9/28/11		INTERSECTION IMPROVEMENT & PAVING		SHEET 9 OF 230 SHEETS		
ENTERED BY: K.SOLWOLD	CHECKED BY: J.KORESKE	REVISION		DATE		ROADWAY SECTIONS				
PROJ. ENGR: S.SPAHR	REGIONAL ADM: LENG	DATE		BY						


LEGEND

- 1 PLANING BITUMINOUS PAVEMENT
- 2 HMA CL. 1/2 IN. PG 64-22
- 3 CRUSHED SURFACING BASE COURSE
- 4 SELECT BORROW INCL. HAUL
- 5 ROADWAY EXCAVATION INCL. HAUL
- 6 EMBANKMENT COMPACTION
- 7 PIGMENTED SPLITTER ISLAND
- 8 MOUNTABLE CURB & GUTTER 4 IN.
- 9 CEMENT CONC. PAVEMENT
- 10 CEMENT CONC. TRAFFIC CURB AND GUTTER
- 11 CEMENT CONC. SIDEWALK
- 12 MOUNTABLE CURB & GUTTER 2 IN.
- 13 CENTRAL ISLAND CURB & GUTTER
- 14 TEXTURED AND PIGMENTED CEMENT CONCRETE PAVEMENT
- 15 QUARRY SPALLS
- 16 UNSUITABLE FOUNDATION EXCAVATION INCL. HAUL
- 17 CONSTRUCTION GEOTEXTILE FOR SEPARATION
- 18 REMOVING ASPHALT CONC. PAVEMENT

* FINAL CUT/FILL SHALL MATCH BACK SLOPE
CATCH POINT OF TEMP DITCH. SLOPE SHALL
NOT BE STEEPER THAN 4:1. REFER TO TPP1-TPP2.
** REFER TO PD9 FOR ADDITIONAL SIDEWALK DETAILS.

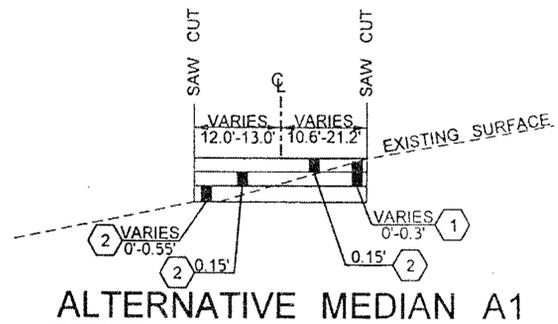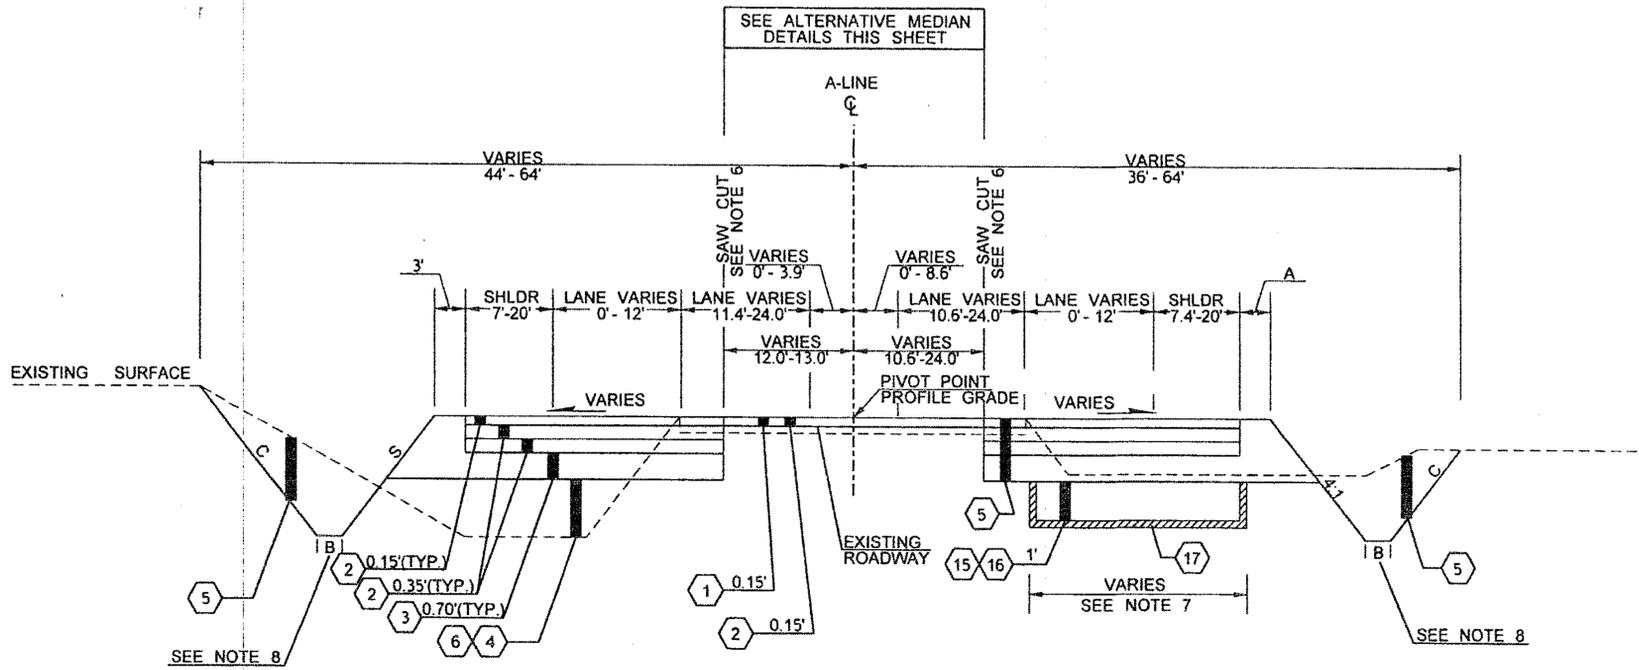

A 800+77.0 TO A 805+34.3
A 815+85.0 TO A 819+58.0

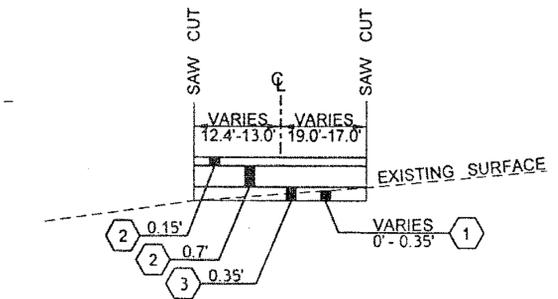

ALTERNATIVE MEDIAN A2

A 814+66.5 TO A 815+85.0

ROADWAY SECTION A

A 795+77.7 TO A 805+34.3
A 814+66.6 TO A 819+58.1

CUT AND FILL TABLE (LT)	S	B	C	CUT/FILL
A 795+77.7 TO A 802+96.3	4:1	NA	NA	FILL
A 802+96.3 TO A 805+34.3	*	NA	NA	FILL
A 814+66.6 TO A 819+58.1	4:1	1.0'	4:1	CUT

CUT AND FILL TABLE (RT)	A	B	C	CUT/FILL
A 795+77.7 TO A 798+28.0	3.0'	NA	NA	FILL
A 798+28.0 TO A 805+34.3	3.0'	1.0'	3:1	CUT
A 814+66.6 TO A 815+40.0	1.0'	1.0'	3:1	CUT
A 815+40.0 TO A 817+10.0	1.0'	NA	NA	FILL
A 817+10.0 TO A 819+58.1	1.0'	1.0'	3:1	CUT

GENERAL NOTES:


1. ALL DEPTH SHOWN ARE FINAL COMPACTED DEPTHS AND SHALL CONFORM TO SECTIONS 2-03.3(14)C, 4-04.3(4) AND 5-04.3(9)
2. REFER TO PAVING PLANS FOR VARIABLE PAVING WIDTHS.
3. REFER TO ROADWAY PROFILES FOR SUPERELEVATION INFO.
4. REFER TO PAVING DETAIL SHEETS FOR ROUNDABOUT CURB INFO.
5. REFER TO DRAINAGE DETAIL, SHEET DD1, FOR MEDIA FILTER DRAIN LOCATIONS AND DIMENSIONS.
6. SAWCUT LINES SHALL BE ON THE EXISTING EDGE OF TRAVELED WAY ON SR9 AND 1' INSIDE EDGE OF PAVEMENT ON SR531/172ND. REFER TO PAVING PLANS FOR STATION LIMITS.
7. REFER TO ALIGNMENT/RIGHT OF WAY PLANS FOR UNSUITABLE FOUNDATION EXCAVATION LIMITS.
8. REFER TO DRAINAGE PROFILES FOR DITCH ELEVATIONS.
9. REFER TO SITE PREPARATION PLANS FOR PAVEMENT REMOVAL LIMITS

N.T.S.

FOR 'AS CONSTRUCTED
PLANS' ONLY


FILE NAME I:\Projects\XL3325 SR9 SR531 172nd St NE Int\CAD\PS&ESheets\XL3325 PS_RS.dgn	TIME 12:44:13 PM	DATE 9/28/2011	PLOTTED BY gunnm	DESIGNED BY M.GUNN	ENTERED BY K.SOLWOLD	CHECKED BY J.KORESKI	PROJ. ENGR. S.SPAHR	REGIONAL ADM. L.ENG	REVISION	DATE	BY	REGION NO. 10	STATE WASH	FED.AID PROJ.NO.	JOB NUMBER 10A042	CONTRACT NO.	LOCATION NO.	DATE 9/28/11	DATE	Washington State Department of Transportation	SR 9 SR 531/172ND ST NE & EAGLEFIELD DR INTERSECTION IMPROVEMENT & PAVING	Plot 1 PLAN REF NO RS1	SHEET 9 OF 230 SHEETS
---	---------------------	-------------------	---------------------	-----------------------	-------------------------	-------------------------	------------------------	------------------------	----------	------	----	------------------	---------------	------------------	----------------------	--------------	--------------	-----------------	------	--	---	------------------------------	-----------------------------------

- LEGEND**
- 1 PLANING BITUMINOUS PAVEMENT
 - 2 HMA CL. 1/2 IN. PG 64-22
 - 3 CRUSHED SURFACING BASE COURSE
 - 4 SELECT BORROW INCL. HAUL
 - 5 ROADWAY EXCAVATION INCL. HAUL
 - 6 EMBANKMENT COMPACTION
 - 7 PIGMENTED SPLITTER ISLAND
 - 8 MOUNTABLE CURB & GUTTER 4 IN.
 - 9 CEMENT CONC. PAVEMENT
 - 10 CEMENT CONC. TRAFFIC CURB AND GUTTER
 - 11 CEMENT CONC. SIDEWALK
 - 12 MOUNTABLE CURB & GUTTER 2 IN.
 - 13 CENTRAL ISLAND CURB & GUTTER
 - 14 TEXTURED AND PIGMENTED CEMENT CONCRETE PAVEMENT
 - 15 QUARRY SPALLS
 - 16 UNSUITABLE FOUNDATION EXCAVATION INCL. HAUL
 - 17 CONSTRUCTION GEOTEXTILE FOR SEPARATION
 - 18 REMOVING ASPHALT CONC. PAVEMENT

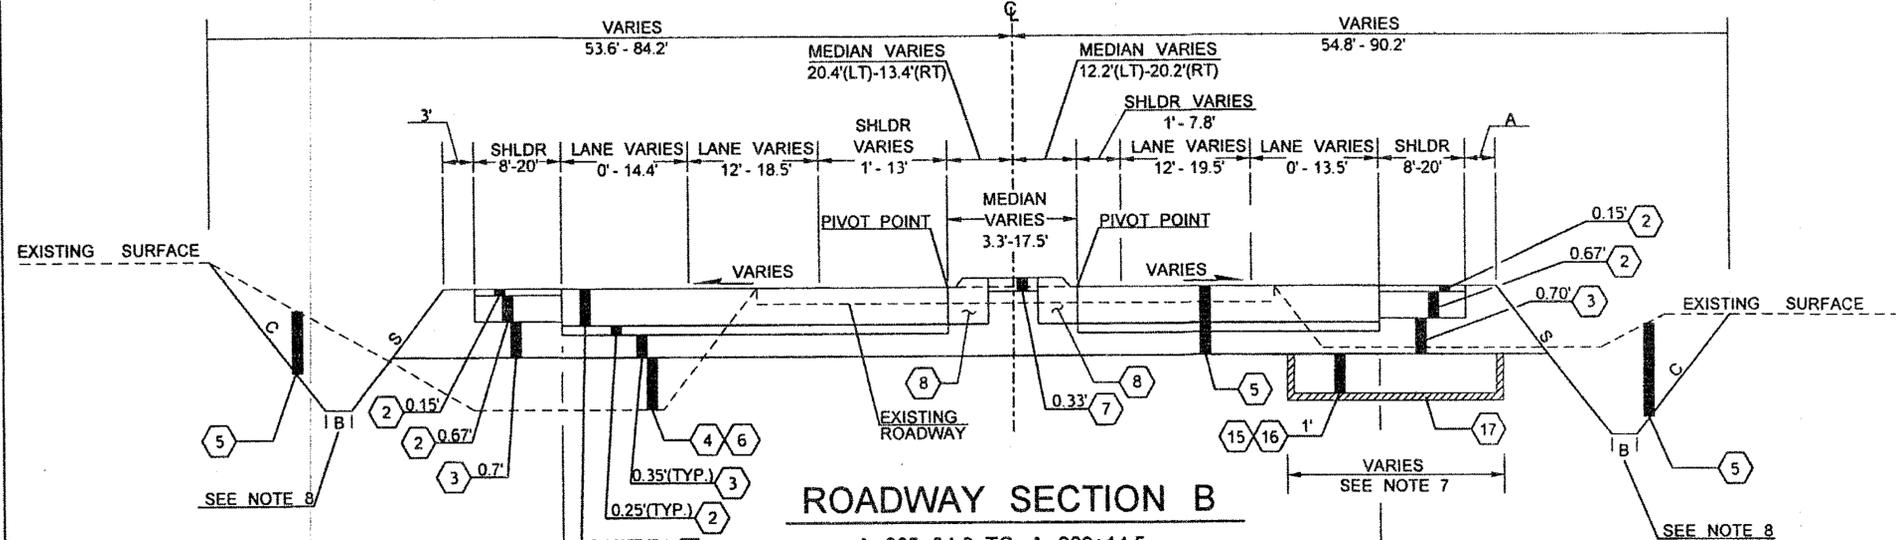


ROADWAY SECTION B

A 805+34.3 TO A 809+14.5
 A 810+87.8 TO A 814+66.6
 B 17+05.0 TO B 17+90.5

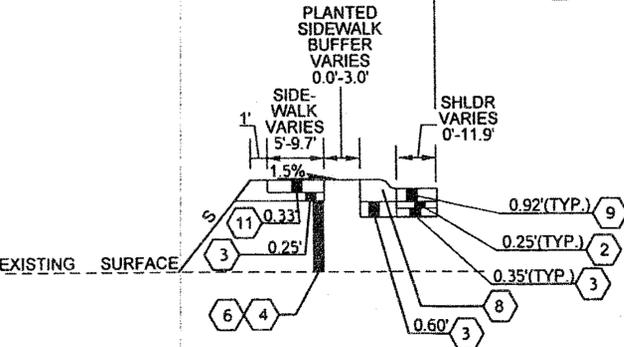

ALTERNATIVE SHOULDER B1

A 808+26.0 TO A 809+14.5
 A 810+87.8 TO A 811+84.0
 B 17+05.0 TO B 17+90.5 **

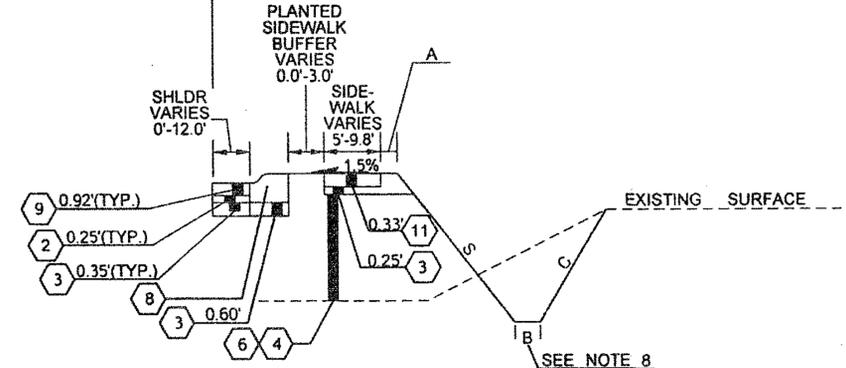

ALTERNATIVE SHOULDER B2

A 808+23.0 TO A 809+14.5
 A 810+87.8 TO A 811+86.0
 B 17+05.0 TO B 17+90.5 **

CUT AND FILL TABLE (LT)	S	B	C	CUT/FILL
A 805+34.3 TO A 807+06.0	4:1	NA	NA	FILL
A 807+06.0 TO A 808+26.0	4:1	1.0'	*	CUT
A 808+26.0 TO A 809+14.5	*	NA	NA	FILL
A 810+87.8 TO A 813+45.0	4:1	NA	NA	FILL
A 813+45.0 TO A 814+66.6	4:1	1.0'	3:1	CUT
B 17+05.0 TO B 17+90.5	4:1	NA	NA	FILL

CUT AND FILL TABLE (RT)	S	A	B	C	CUT/FILL
A 805+34.3 TO A 809+14.5	4:1	3.0'	1.0'	3:1	CUT
A 810+87.8 TO A 811+44.0	18.6:1 TO 6:1	1.0'	1.0'	2:1	CUT
A 811+44.0 TO A 813+20.0	6:1	1.0'	1.0'	3:1	CUT
A 813+20.0 TO A 814+66.6	4:1	1.0'	1.0'	3:1	CUT
B 17+05.0 TO B 17+90.5	*	1.0'	NA	NA	FILL

- GENERAL NOTES:**
- ALL DEPTH SHOWN ARE FINAL COMPACTED DEPTHS AND SHALL CONFORM TO SECTIONS 2-03.3(14)C, 4-04.3(4) AND 5-04.3(9)
 - REFER TO PAVING PLANS FOR VARIABLE PAVING WIDTHS.
 - REFER TO ROADWAY PROFILES FOR SUPERELEVATION INFO.
 - REFER TO PAVING DETAIL SHEETS FOR ROUNDABOUT CURB INFO.
 - REFER TO DRAINAGE DETAIL SHEET DD1, FOR MEDIA FILTER DRAIN LOCATIONS AND DIMENSIONS.
 - SAWCUT LINES SHALL BE ON THE EXISTING EDGE OF TRAVELED WAY ON SR9 AND 1' INSIDE EDGE OF PAVEMENT ON SR531/172ND. REFER TO PAVING PLANS FOR STATION LIMITS.
 - REFER TO ALIGNMENT/RIGHT OF WAY PLANS FOR UNSUITABLE FOUNDATION EXCAVATION LIMITS.
 - REFER TO DRAINAGE PROFILES FOR DITCH ELEVATIONS.
 - REFER TO SITE PREPARATION PLANS FOR PAVEMENT REMOVAL LIMITS

N.T.S.

FOR "AS CONSTRUCTED PLANS" ONLY

FILE NAME	I:\Projects\XL3325 SR9 SR531 172nd St NE Int\CAD\PS&ESheets\XL3325 PS RS.dgn			REGION NO.	STATE	FED.AID PROJ.NO.			SR 9 SR 531/172ND ST NE & EAGLEFIELD DR INTERSECTION IMPROVEMENT & PAVING ROADWAY SECTIONS	Plot 2
TIME	12:44:16 PM			10	WASH					PLAN REF NO
DATE	9/28/2011			JOB NUMBER	10A042	LOCATION NO.			SHEET 10 OF 230 SHEETS	
PLOTTED BY	gunnm			CONTRACT NO.						
DESIGNED BY	M.GUNN									
ENTERED BY	K.SOLWOLD									
CHECKED BY	J.KORESKI									
PROJ. ENGR.	S.SPAHR									
REGIONAL ADM.	L.ENG			REVISION	DATE	BY				


LEGEND

- 1 PLANING BITUMINOUS PAVEMENT
- 2 HMA CL. 1/2 IN. PG 64-22
- 3 CRUSHED SURFACING BASE COURSE
- 4 SELECT BORROW INCL. HAUL
- 5 ROADWAY EXCAVATION INCL. HAUL
- 6 EMBANKMENT COMPACTION
- 7 PIGMENTED SPLITTER ISLAND
- 8 MOUNTABLE CURB & GUTTER 4 IN.
- 9 CEMENT CONC. PAVEMENT
- 10 CEMENT CONC. TRAFFIC CURB AND GUTTER
- 11 CEMENT CONC. SIDEWALK
- 12 MOUNTABLE CURB & GUTTER 2 IN.
- 13 CENTRAL ISLAND CURB & GUTTER
- 14 TEXTURED AND PIGMENTED CEMENT CONCRETE PAVEMENT
- 15 QUARRY SPALLS
- 16 UNSUITABLE FOUNDATION EXCAVATION INCL. HAUL
- 17 CONSTRUCTION GEOTEXTILE FOR SEPARATION
- 18 REMOVING ASPHALT CONC. PAVEMENT

* FINAL CUT/FILL SHALL MATCH BACK SLOPE CATCH POINT OF TEMP DITCH. SLOPE SHALL NOT BE STEEPER THAN 4:1. REFER TO TPP1-TPP2.
 ** REFER TO PD9 FOR ADDITIONAL SIDEWALK DETAILS.

ALTERNATIVE MEDIAN C1


B 12+91.0 TO B 15+78.3

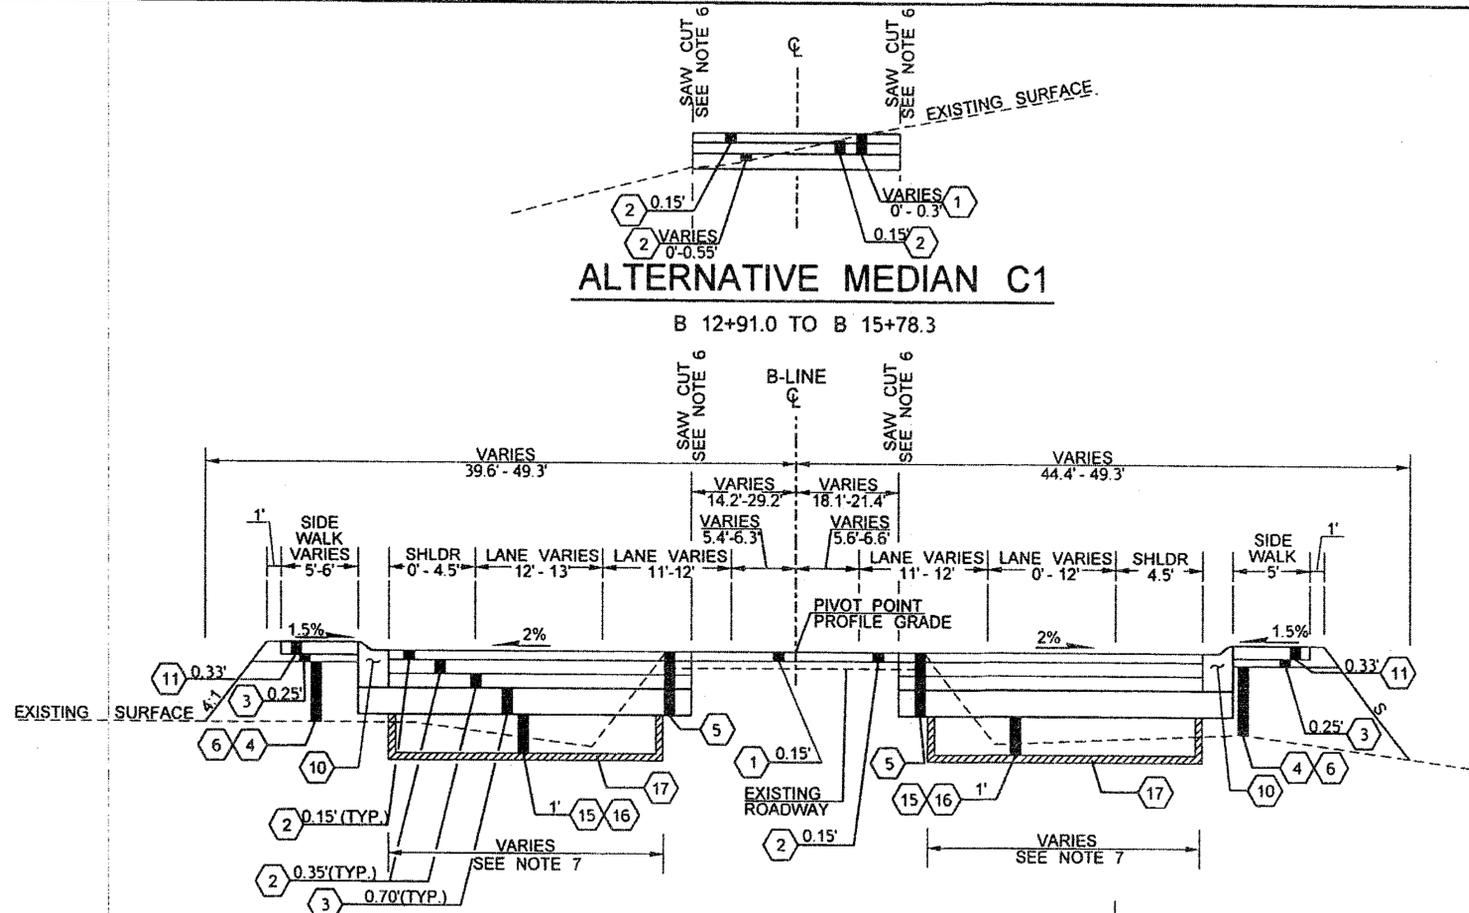

ROADWAY SECTION C


B 11+47.3 TO B 15+78.3 **

CUT AND FILL TABLE (RT)		
STATION	S	CUT/FILL
B 12+44.7 TO B 14+30.0	4:1	FILL
B 14+30.0 TO B 15+78.3	*	FILL

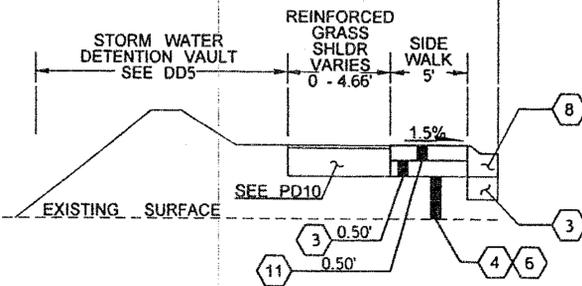

ALTERNATIVE SHOULDER C1

B 13+97.5 TO B 15+78.3 **

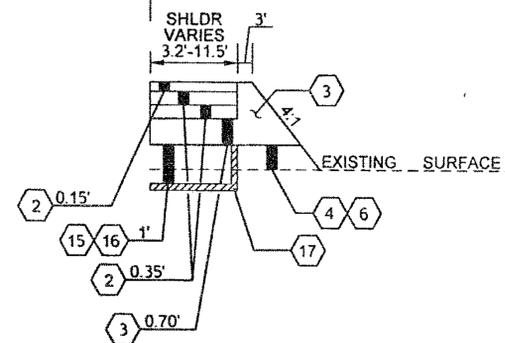

ALTERNATIVE SHOULDER C2

B 11+47.3 TO B 12+44.7

FOR "AS CONSTRUCTED PLANS" ONLY


GENERAL NOTES:

1. ALL DEPTH SHOWN ARE FINAL COMPACTED DEPTHS AND SHALL CONFORM TO SECTIONS 2-03.3(14)C, 4-04.3(4) AND 5-04.3(9)
2. REFER TO PAVING PLANS FOR VARIABLE PAVING WIDTHS.
3. REFER TO ROADWAY PROFILES FOR SUPERELEVATION INFO.
4. REFER TO PAVING DETAIL SHEETS FOR ROUNDABOUT CURB INFO.
5. REFER TO DRAINAGE DETAIL, SHEET DD1, FOR MEDIA FILTER DRAIN LOCATIONS AND DIMENSIONS.
6. SAWCUT LINES SHALL BE ON THE EXISTING EDGE OF TRAVELED WAY ON SR9 AND 1' INSIDE EDGE OF PAVEMENT ON SR531/172ND. REFER TO PAVING PLANS FOR STATION LIMITS.
7. REFER TO ALIGNMENT/RIGHT OF WAY PLANS FOR UNSUITABLE FOUNDATION EXCAVATION LIMITS.
8. REFER TO DRAINAGE PROFILES FOR DITCH ELEVATIONS.
9. REFER TO SITE PREPARATION PLANS FOR PAVEMENT REMOVAL LIMITS

N.T.S.

FILE NAME	I:\Projects\X13325_SR9_SR531_172nd St NE Int\CAD\PS&ESheets\X13325_PS_RS.dgn		
TIME	12:44:18 PM		
DATE	9/28/2011		
PLOTTED BY	gunnm		
DESIGNED BY	M.GUNN		
ENTERED BY	K.SOLWOLD		
CHECKED BY	J.KORESKI		
PROJ. ENGR.	S.SPAHR		
REGIONAL ADM.	L.ENG		
REVISION	DATE	BY	

REGION NO.	STATE	FED.AID PROJ.NO.
10	WASH	
JOB NUMBER	10A042	
CONTRACT NO.	LOCATION NO.	

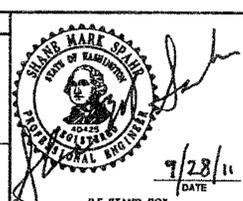


DATE	DATE
9/28/11	




SR 9	Plot 3
SR 531/172ND ST NE & EAGLEFIELD DR	PLAN REF NO
INTERSECTION IMPROVEMENT & PAVING	RS3
ROADWAY SECTIONS	SHEET
	11
	OF
	230
	SHEETS

LEGEND	
1	PLANING BITUMINOUS PAVEMENT
2	HMA CL. 1/2 IN. PG 64-22
3	CRUSHED SURFACING BASE COURSE
4	SELECT BORROW INCL. HAUL
5	ROADWAY EXCAVATION INCL. HAUL
6	EMBANKMENT COMPACTION
7	PIGMENTED SPLITTER ISLAND
8	MOUNTABLE CURB & GUTTER 4 IN.
9	CEMENT CONC. PAVEMENT
10	CEMENT CONC. TRAFFIC CURB AND GUTTER
11	CEMENT CONC. SIDEWALK
12	MOUNTABLE CURB & GUTTER 2 IN.
13	CENTRAL ISLAND CURB & GUTTER
14	TEXTURED AND PIGMENTED CEMENT CONCRETE PAVEMENT
15	QUARRY SPALLS
16	UNSUITABLE FOUNDATION EXCAVATION INCL. HAUL
17	CONSTRUCTION GEOTEXTILE FOR SEPARATION
18	REMOVING ASPHALT CONC. PAVEMENT

* FINAL CUT/FILL SHALL MATCH BACK SLOPE CATCH POINT OF TEMP DITCH. SLOPE SHALL NOT BE STEEPER THAN 4:1. REFER TO TPP1-TPP2.
 ** REFER TO PDS FOR ADDITIONAL SIDEWALK DETAILS.

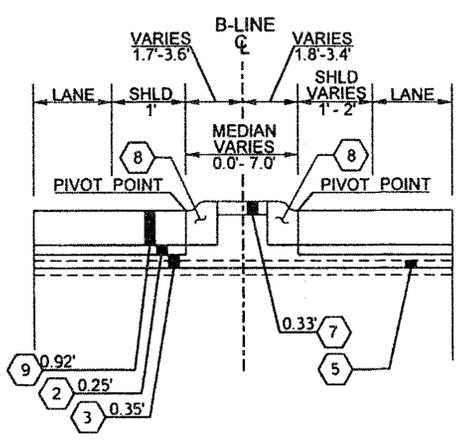

ALTERNATIVE MEDIAN D1
 B 16+07.8 TO B 17+05.0

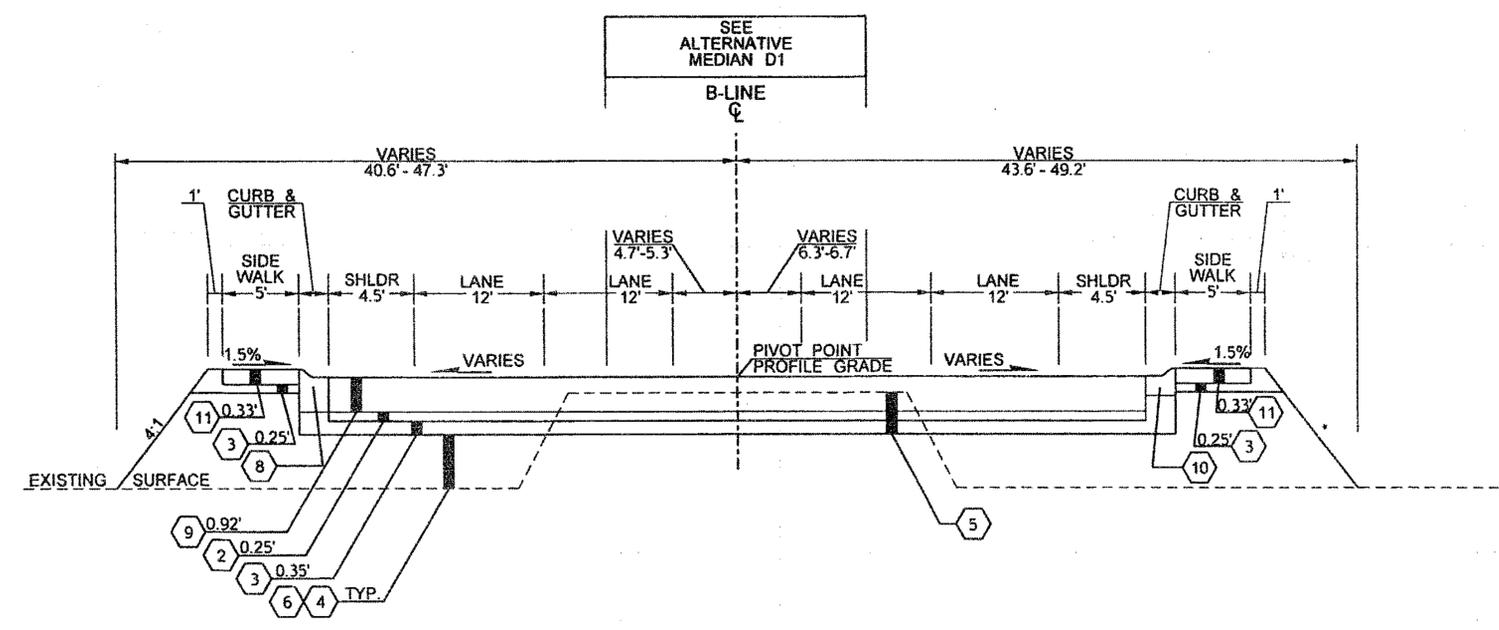

ROADWAY SECTION D
 B 15+78.3 TO B 17+05.0

N.T.S.

- GENERAL NOTES:
- ALL DEPTH SHOWN ARE FINAL COMPACTED DEPTHS AND SHALL CONFORM TO SECTIONS 2-03.3(14)C, 4-04.3(4) AND 5-04.3(9)
 - REFER TO PAVING PLANS FOR VARIABLE PAVING WIDTHS.
 - REFER TO ROADWAY PROFILES FOR SUPERELEVATION INFO.
 - REFER TO PAVING DETAIL SHEETS FOR ROUNDABOUT CURB INFO.
 - REFER TO DRAINAGE DETAIL, SHEET DD1, FOR MEDIA FILTER DRAIN LOCATIONS AND DIMENSIONS.
 - SAWCUT LINES SHALL BE ON THE EXISTING EDGE OF TRAVELED WAY ON SR9 AND 1' INSIDE EDGE OF PAVEMENT ON SR531/172ND. REFER TO PAVING PLANS FOR STATION LIMITS.
 - REFER TO ALIGNMENT/RIGHT OF WAY PLANS FOR UNSUITABLE FOUNDATION EXCAVATION LIMITS.
 - REFER TO DRAINAGE PROFILES FOR DITCH ELEVATIONS.
 - REFER TO SITE PREPARATION PLANS FOR PAVEMENT REMOVAL LIMITS

FOR "AS CONSTRUCTED PLANS" ONLY


FILE NAME: I:\Projects\XL3325 SR9 SR531 172nd St NE Int\CAD\PS&ESheets\XL3325_PS_RS.dgn		REGION NO. STATE		FED.AID PROJ.NO.				SR 9		Plot 4
TIME: 12:44:21 PM	DATE: 9/28/2011	10	WASH					SR 531/172ND ST NE & EAGLEFIELD DR INTERSECTION IMPROVEMENT & PAVING		PLAN REF NO: RS4
PLOTTED BY: gunnm	DESIGNED BY: M.GUNN	JOB NUMBER: 10A042		LOCATION NO.			ROADWAY SECTIONS		SHEET 12 OF 230 SHEETS	
ENTERED BY: K.SOLWOLD	CHECKED BY: J.KORESKI	CONTRACT NO.								
PROJ. ENGR: S.SPAHR	REGIONAL ADM: LENG	REVISION	DATE	BY						

LEGEND

- 1 PLANING BITUMINOUS PAVEMENT
- 2 HMA CL. 1/2 IN. PG 64-22
- 3 CRUSHED SURFACING BASE COURSE
- 4 SELECT BORROW INCL. HAUL
- 5 ROADWAY EXCAVATION INCL. HAUL
- 6 EMBANKMENT COMPACTION
- 7 PIGMENTED SPLITTER ISLAND
- 8 MOUNTABLE CURB & GUTTER 4 IN.
- 9 CEMENT CONC. PAVEMENT
- 10 CEMENT CONC. TRAFFIC CURB AND GUTTER
- 11 CEMENT CONC. SIDEWALK
- 12 MOUNTABLE CURB & GUTTER 2 IN.
- 13 CENTRAL ISLAND CURB & GUTTER
- 14 TEXTURED AND FIGMENTED CEMENT CONCRETE PAVEMENT
- 15 QUARRY SPALLS
- 16 UNSUITABLE FOUNDATION EXCAVATION INCL. HAUL
- 17 CONSTRUCTION GEOTEXTILE FOR SEPARATION
- 18 REMOVING ASPHALT CONC. PAVEMENT


* FINAL CUT/FILL SHALL MATCH BACK SLOPE CATCH POINT OF TEMP DITCH. SLOPE SHALL NOT BE STEEPER THAN 4:1. REFER TO TPP1-TPP2.
 ** REFER TO PD9 FOR ADDITIONAL SIDEWALK DETAILS.

STATION (LT)	S	A
B 19+64.2 TO B 20+01.5	23.6:1 - 24:1	1'
B 20+01.5 TO B 20+13.6	24:1 - 4:1	1'
B 20+13.6 TO B 20+47.9	4:1	8.66'-1'
B 20+47.9 TO B 21+49.6	4:1	1'

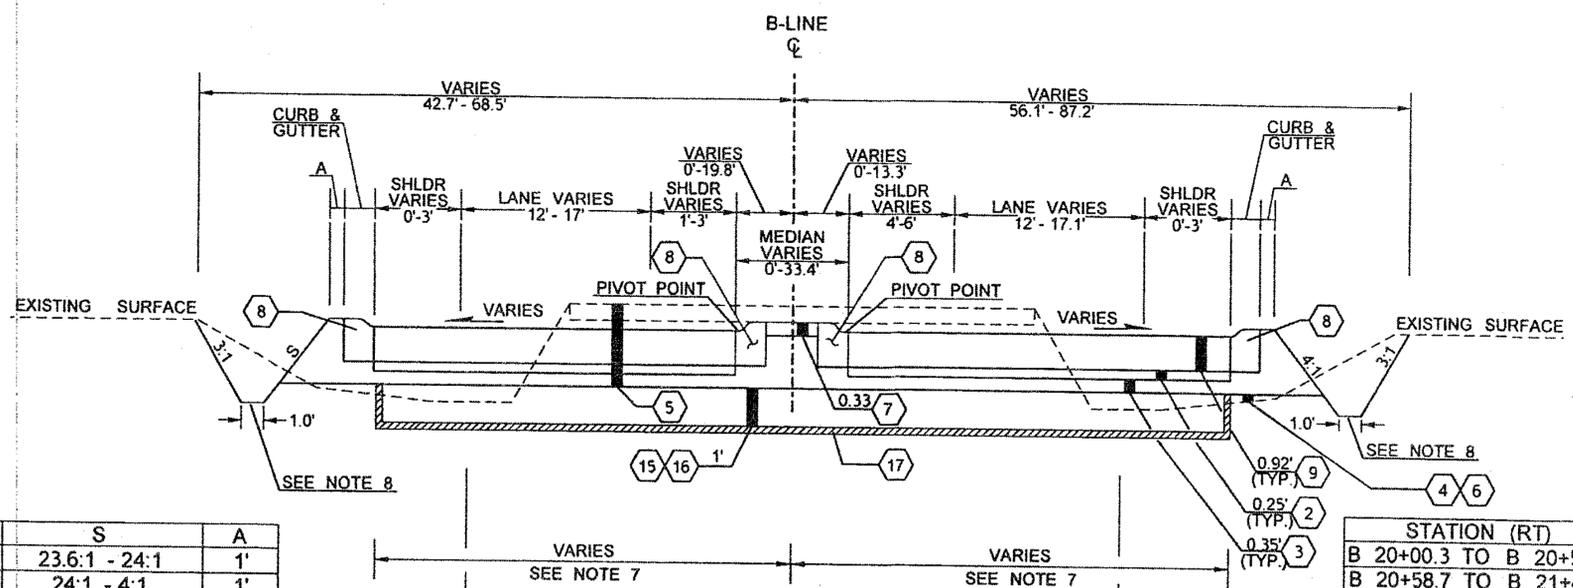


ROADWAY SECTION E

B 19+64.2 TO B 21+49.6

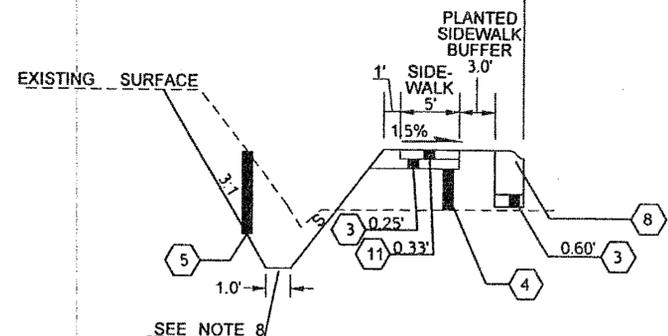

ALTERNATIVE SHOULDER E1

B 19+64.2 TO B 20+03.1

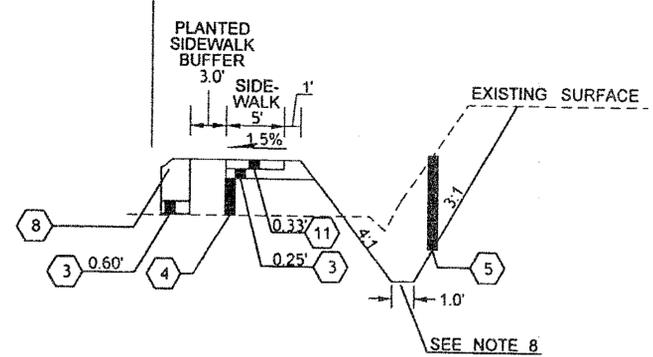

ALTERNATIVE SHOULDER E2

B 19+64.2 TO B 20+00.3

GENERAL NOTES:


1. ALL DEPTH SHOWN ARE FINAL COMPACTED DEPTHS AND SHALL CONFORM TO SECTIONS 2-03.3(14)C, 4-04.3(4) AND 5-04.3(9)
2. REFER TO PAVING PLANS FOR VARIABLE PAVING WIDTHS.
3. REFER TO ROADWAY PROFILES FOR SUPERELEVATION INFO.
4. REFER TO PAVING DETAIL SHEETS FOR ROUNDABOUT CURB INFO.
5. REFER TO DRAINAGE DETAIL, SHEET DD1, FOR MEDIA FILTER DRAIN LOCATIONS AND DIMENSIONS.
6. SAWCUT LINES SHALL BE ON THE EXISTING EDGE OF TRAVELED WAY ON SR9 AND 1' INSIDE EDGE OF PAVEMENT ON SR531/172ND. REFER TO PAVING PLANS FOR STATION LIMITS.
7. REFER TO ALIGNMENT/RIGHT OF WAY PLANS FOR UNSUITABLE FOUNDATION EXCAVATION LIMITS.
8. REFER TO DRAINAGE PROFILES FOR DITCH ELEVATIONS.
9. REFER TO SITE PREPARATION PLANS FOR PAVEMENT REMOVAL LIMITS

FOR "AS CONSTRUCTED PLANS" ONLY


N.T.S.

FILE NAME: I:\Projects\XL3325 SR9 SR531 172nd St NE Int\CAD\PS&ESheets\XL3325 PS RS.dgn		REGION NO. 10	STATE WASH	FED.AID PROJ.NO.			SR 9 SR 531/172ND ST NE & EAGLEFIELD DR INTERSECTION IMPROVEMENT & PAVING	Plot 5
TIME: 12:44:23 PM	DATE: 9/28/2011	JOB NUMBER: 10A042	CONTRACT NO.	LOCATION NO.				SHEET 13 OF 230 SHEETS
PLOTTED BY: gunnm	DESIGNED BY: M.GUNN	CHECKED BY: J.KORESKE	PROJ. ENGR: S.SPAHR	REGIONAL ADM: LENG	REVISION	DATE	BY	ROADWAY SECTIONS

LEGEND	
1	PLANING BITUMINOUS PAVEMENT
2	HMA CL. 1/2 IN. PG 64-22
3	CRUSHED SURFACING BASE COURSE
4	SELECT BORROW INCL. HAUL
5	ROADWAY EXCAVATION INCL. HAUL
6	EMBANKMENT COMPACTION
7	PIGMENTED SPLITTER ISLAND
8	MOUNTABLE CURB & GUTTER 4 IN.
9	CEMENT CONC. PAVEMENT
10	CEMENT CONC. TRAFFIC CURB AND GUTTER
11	CEMENT CONC. SIDEWALK
12	MOUNTABLE CURB & GUTTER 2 IN.
13	CENTRAL ISLAND CURB & GUTTER
14	TEXTURED AND PIGMENTED CEMENT CONCRETE PAVEMENT
15	QUARRY SPALLS
16	UNSUITABLE FOUNDATION EXCAVATION INCL. HAUL
17	CONSTRUCTION GEOTEXTILE FOR SEPARATION
18	REMOVING ASPHALT CONC. PAVEMENT

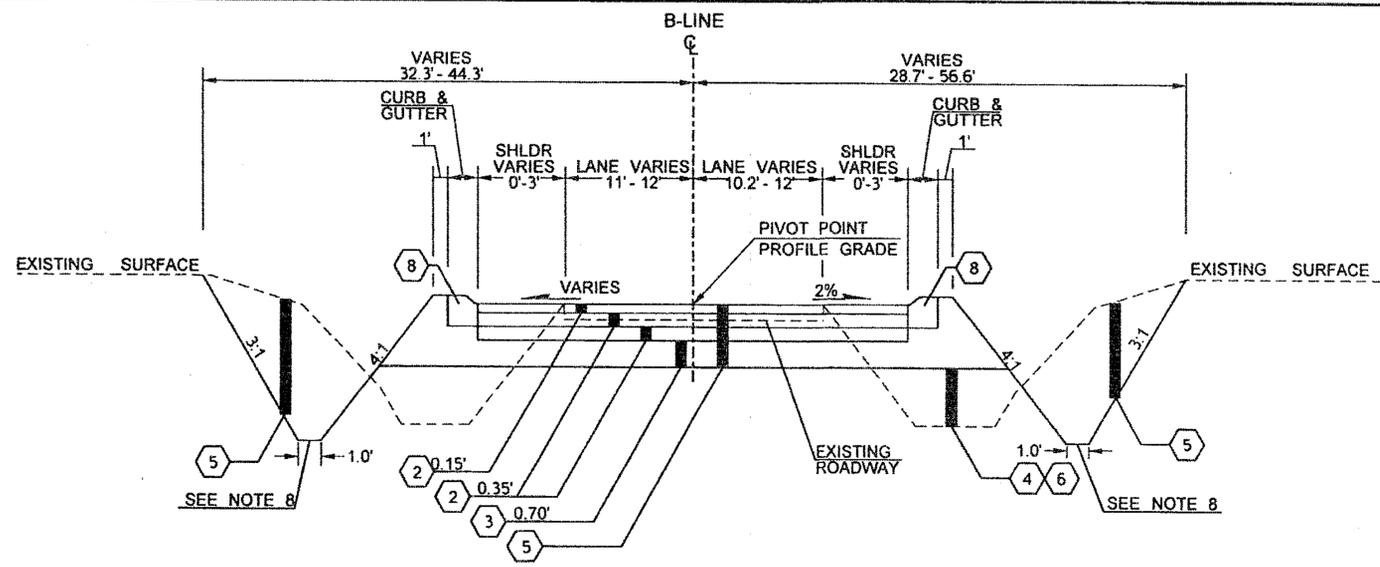

ROADWAY SECTION F
B 21+49.6 TO B 24+02.1

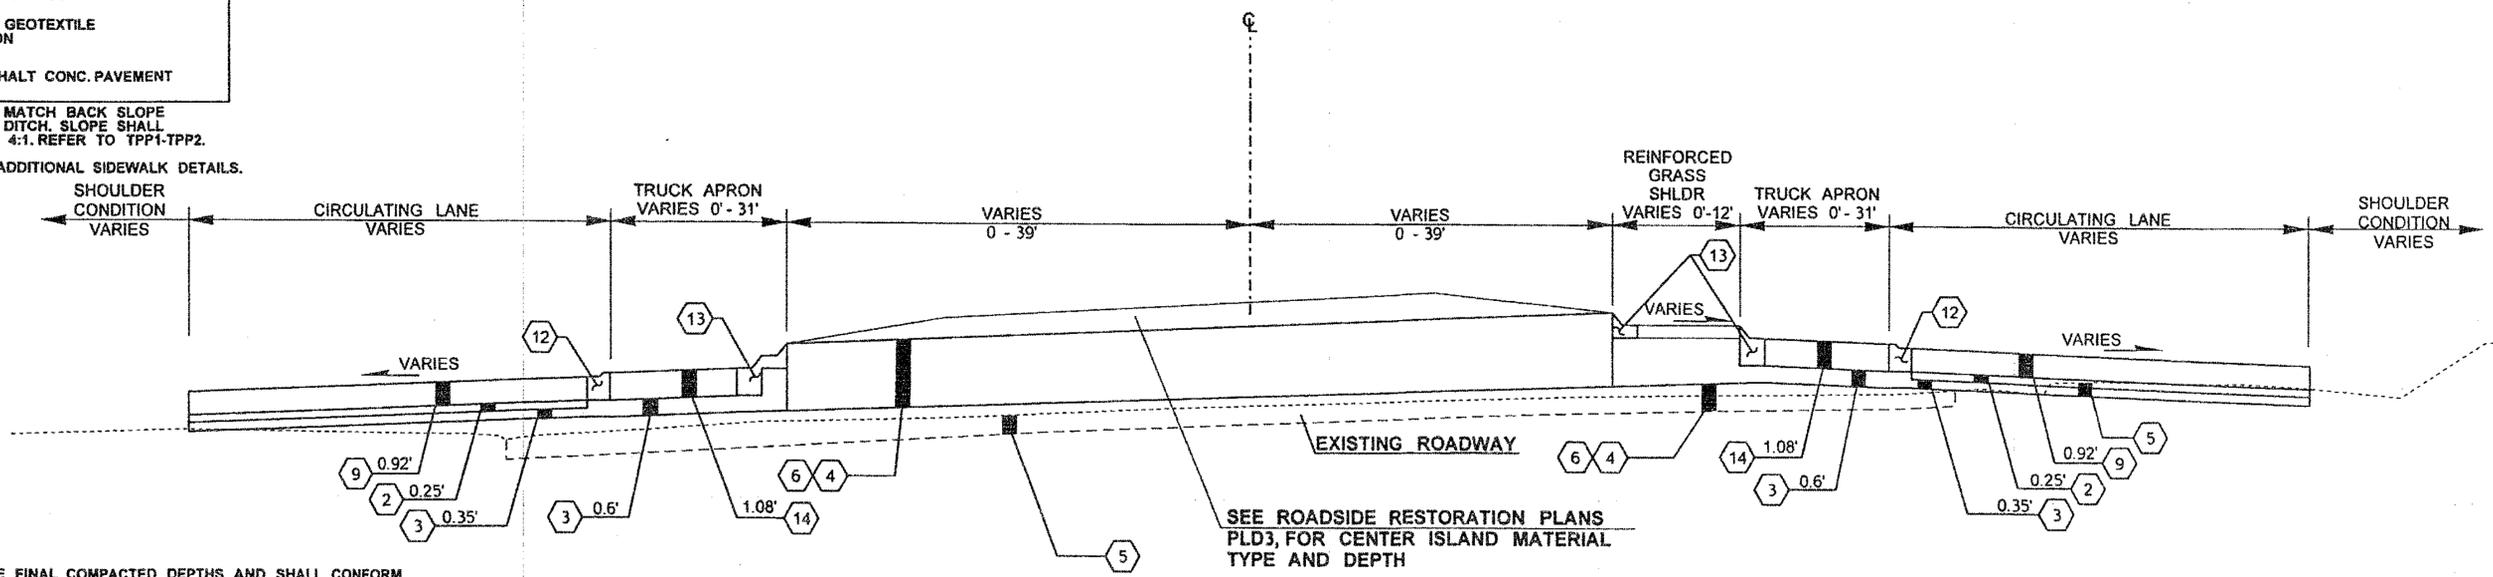

ROUNDBABOUT SECTION G

A 809+14.5 TO A 810+87.8
B 17+90.5 TO B 19+64.2

N.T.S.

* FINAL CUT/FILL SHALL MATCH BACK SLOPE CATCH POINT OF TEMP DITCH. SLOPE SHALL NOT BE STEEPER THAN 4:1. REFER TO TYP1-TYP2.

** REFER TO PD9 FOR ADDITIONAL SIDEWALK DETAILS.

GENERAL NOTES:

- ALL DEPTH SHOWN ARE FINAL COMPACTED DEPTHS AND SHALL CONFORM TO SECTIONS 2-03.3(14)C, 4-04.3(4) AND 5-04.3(9)
- REFER TO PAVING PLANS FOR VARIABLE PAVING WIDTHS.
- REFER TO ROADWAY PROFILES FOR SUPERELEVATION INFO.
- REFER TO PAVING DETAIL SHEETS FOR ROUNDABOUT CURB INFO.
- REFER TO DRAINAGE DETAIL, SHEET DD1, FOR MEDIA FILTER DRAIN LOCATIONS AND DIMENSIONS.
- SAWCUT LINES SHALL BE ON THE EXISTING EDGE OF TRAVELED WAY ON SR9 AND 1' INSIDE EDGE OF PAVEMENT ON SR531/172ND. REFER TO PAVING PLANS FOR STATION LIMITS.
- REFER TO ALIGNMENT/RIGHT OF WAY PLANS FOR UNSUITABLE FOUNDATION EXCAVATION LIMITS.
- REFER TO DRAINAGE PROFILES FOR DITCH ELEVATIONS.
- REFER TO SITE PREPARATION PLANS FOR PAVEMENT REMOVAL LIMITS


FOR "AS CONSTRUCTED" PLANS ONLY

FILE NAME	I:\Projects\XL3325 SR9 SR531 172nd St NE Int\CADIPS&ESheets\XL3325_PS_RS.dgn	REGION NO.	10	STATE	WASH	FED.AID PROJ.NO.				SR 9 SR 531/172ND ST NE & EAGLEFIELD DR INTERSECTION IMPROVEMENT & PAVING ROADWAY SECTIONS	Plot 6	
TIME	12:44:25 PM	JOB NUMBER	10A042	CONTRACT NO.		LOCATION NO.					PLAN REF NO	RS6
DATE	9/28/2011	DESIGNED BY	M.GUNN	PROJ. ENGR.	S.SPAHR	REGIONAL ADM.	L.ENG				SHEET 14 OF 230 SHEETS	


LEGEND

- 1 PLANING BITUMINOUS PAVEMENT
- 2 HMA CL. 1/4 IN. PG 64-22
- 3 CRUSHED SURFACING BASE COURSE
- 4 SELECT BORROW INCL. HAUL
- 5 ROADWAY EXCAVATION INCL. HAUL
- 6 EMBANKMENT COMPACTION
- 7 PIGMENTED SPLITTER ISLAND
- 8 MOUNTABLE CURB & GUTTER 4 IN.
- 9 CEMENT CONC. PAVEMENT
- 10 CEMENT CONC. TRAFFIC CURB AND GUTTER
- 11 CEMENT CONC. SIDEWALK
- 12 MOUNTABLE CURB & GUTTER 2 IN.
- 13 CENTRAL ISLAND CURB & GUTTER
- 14 TEXTURED AND PIGMENTED CEMENT CONCRETE PAVEMENT
- 15 QUARRY SPALLS
- 16 UNSUITABLE FOUNDATION EXCAVATION INCL. HAUL
- 17 CONSTRUCTION GEOTEXTILE FOR SEPARATION
- 18 REMOVING ASPHALT CONC. PAVEMENT

* FINAL CUT/FILL SHALL MATCH BACK SLOPE CATCH POINT OF TEMP DITCH. SLOPE SHALL NOT BE STEEPER THAN 4:1. REFER TO TPP1-TPP2.
 ** REFER TO PD9 FOR ADDITIONAL SIDEWALK DETAILS.

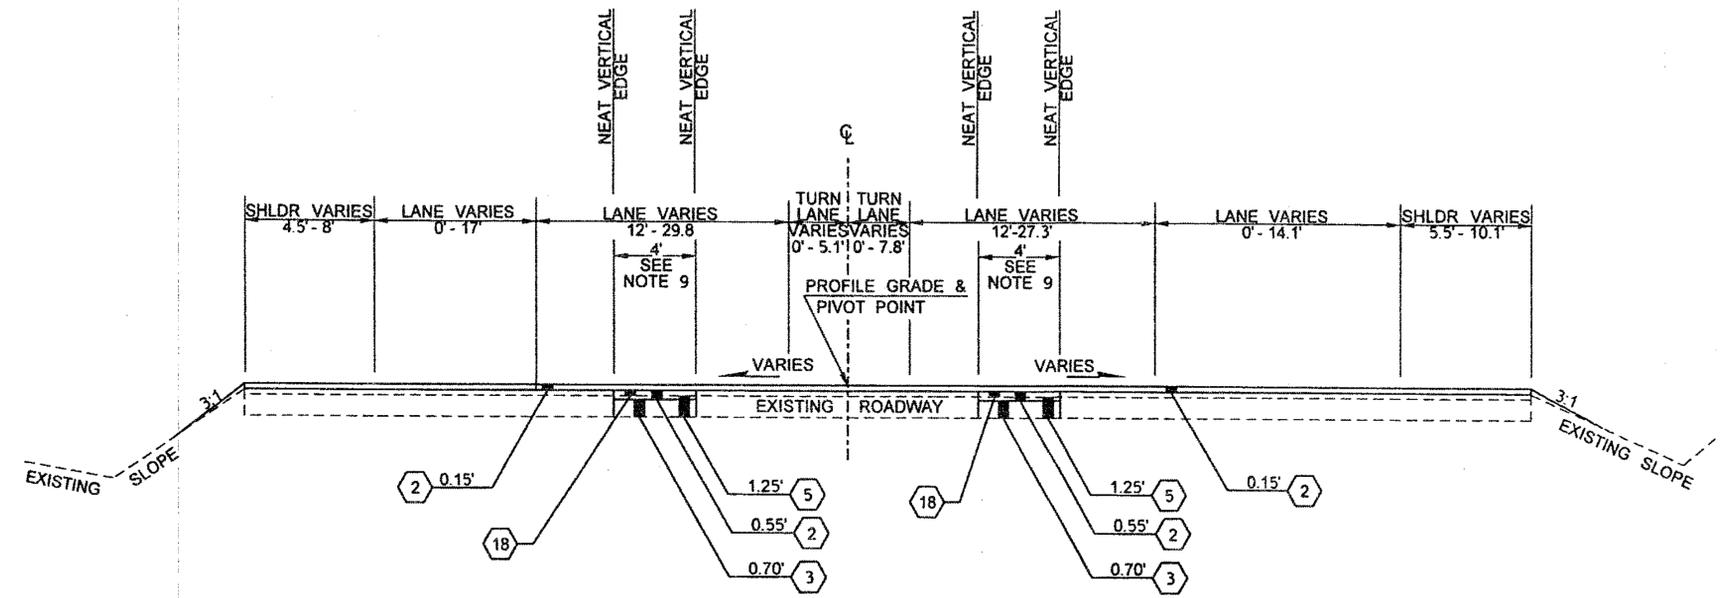

ROADWAY SECTION H
 A 851+45.6 TO A 857+16.3
 A 858+73.9 TO A 863+77.1

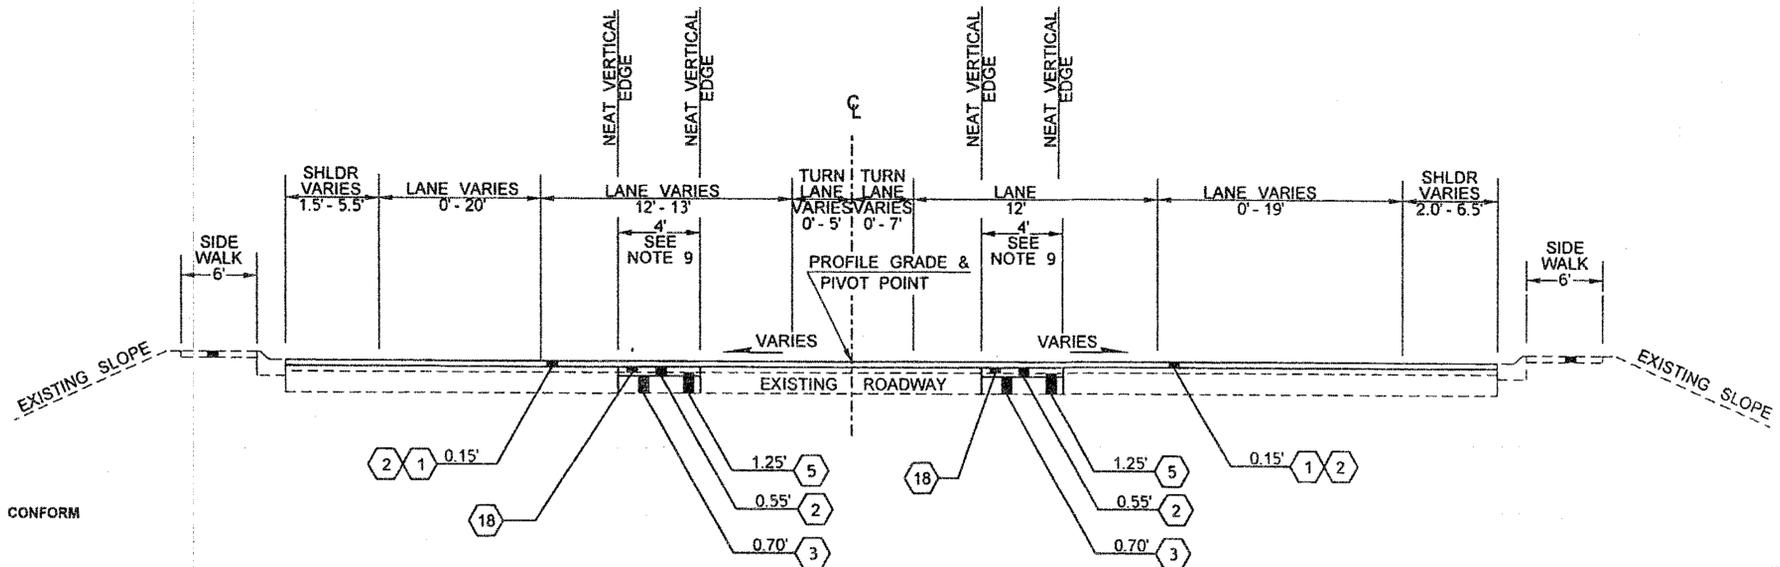


ROADWAY SECTION I
 A 857+16.3 TO A 858+73.9

- GENERAL NOTES:**
1. ALL DEPTH SHOWN ARE FINAL COMPACTED DEPTHS AND SHALL CONFORM TO SECTIONS 2-03.3(14)C, 4-04.3(4) AND 5-04.3(9)
 2. REFER TO PAVING PLANS FOR VARIABLE PAVING WIDTHS.
 3. REFER TO ROADWAY PROFILES FOR SUPERELEVATION INFO.
 4. REFER TO PAVING DETAIL SHEETS FOR ROUNDABOUT CURB INFO.
 5. REFER TO DRAINAGE DETAIL, SHEET DD1, FOR MEDIA FILTER DRAIN LOCATIONS AND DIMENSIONS.
 6. SAWCUT LINES SHALL BE ON THE EXISTING EDGE OF TRAVELED WAY ON SR9 AND 1' INSIDE EDGE OF PAVEMENT ON SR531/172ND. REFER TO PAVING PLANS FOR STATION LIMITS.
 7. REFER TO ALIGNMENT/RIGHT OF WAY PLANS FOR UNSUITABLE FOUNDATION EXCAVATION LIMITS.
 8. REFER TO DRAINAGE PROFILES FOR DITCH ELEVATIONS.
 9. REFER TO SITE PREPARATION PLANS FOR PAVEMENT REMOVAL LIMITS

FOR "AS CONSTRUCTED PLANS" ONLY

N.T.S.

FILE NAME: I:\Projects\XL3325 SR9 SR531 172nd St_NE_Int\CAD\PS&ESheets\XL3325_PS_RS.dgn		REGION NO. 10	STATE WASH	FED.AID PROJ.NO.			SR 9 SR 531/172ND ST NE & EAGLEFIELD DR INTERSECTION IMPROVEMENT & PAVING	Plot 7	
TIME: 12:44:28 PM	DATE: 9/28/2011	JOB NUMBER: 10A042	CONTRACT NO.	LOCATION NO.				PLANNING REF NO: RS7	
PLOTTED BY: gunnm	DESIGNED BY: M.GUNN	ENTERED BY: K.SOLWOLD	CHECKED BY: J.KORESKE	PROJ. ENGR: S.SPAHR	REGIONAL ADM: LENG	REVISION	DATE	BY	SHEET 15 OF 230 SHEETS

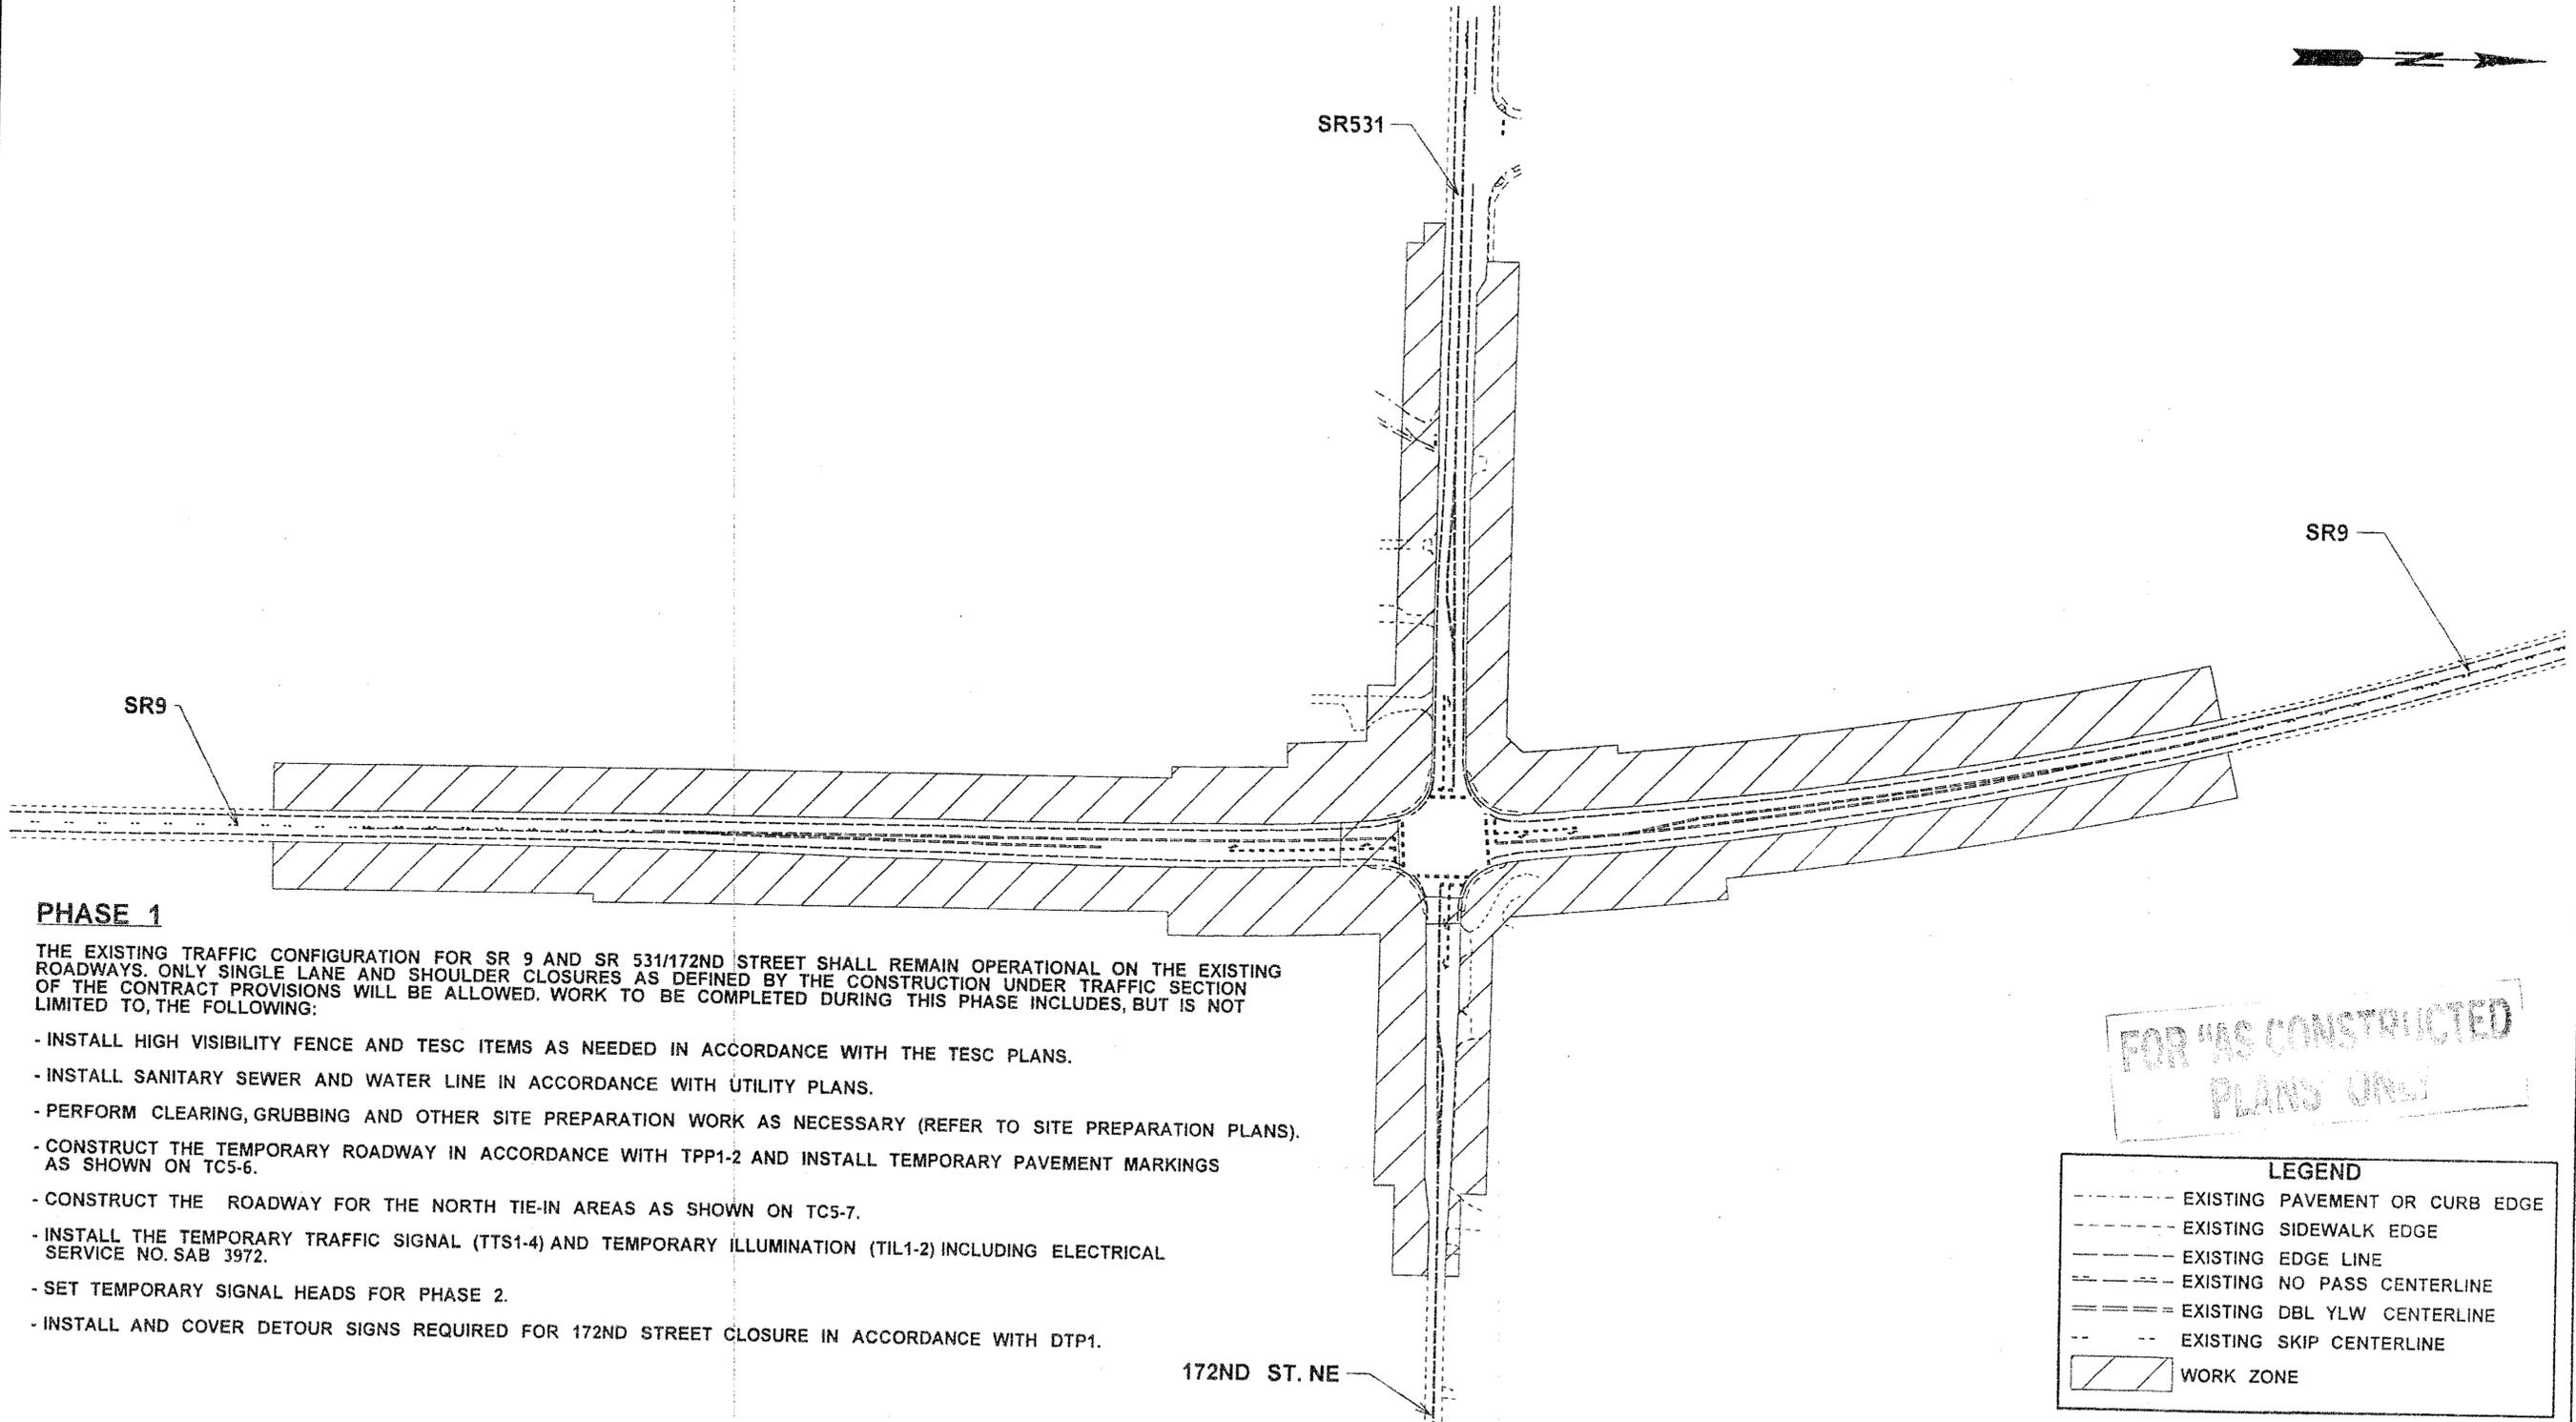

PHASE 1


THE EXISTING TRAFFIC CONFIGURATION FOR SR 9 AND SR 531/172ND STREET SHALL REMAIN OPERATIONAL ON THE EXISTING ROADWAYS. ONLY SINGLE LANE AND SHOULDER CLOSURES AS DEFINED BY THE CONSTRUCTION UNDER TRAFFIC SECTION OF THE CONTRACT PROVISIONS WILL BE ALLOWED. WORK TO BE COMPLETED DURING THIS PHASE INCLUDES, BUT IS NOT LIMITED TO, THE FOLLOWING:

- INSTALL HIGH VISIBILITY FENCE AND TESC ITEMS AS NEEDED IN ACCORDANCE WITH THE TESC PLANS.
- INSTALL SANITARY SEWER AND WATER LINE IN ACCORDANCE WITH UTILITY PLANS.
- PERFORM CLEARING, GRUBBING AND OTHER SITE PREPARATION WORK AS NECESSARY (REFER TO SITE PREPARATION PLANS).
- CONSTRUCT THE TEMPORARY ROADWAY IN ACCORDANCE WITH TPP1-2 AND INSTALL TEMPORARY PAVEMENT MARKINGS AS SHOWN ON TC5-6.
- CONSTRUCT THE ROADWAY FOR THE NORTH TIE-IN AREAS AS SHOWN ON TC5-7.
- INSTALL THE TEMPORARY TRAFFIC SIGNAL (TTS1-4) AND TEMPORARY ILLUMINATION (TIL1-2) INCLUDING ELECTRICAL SERVICE NO. SAB 3972.
- SET TEMPORARY SIGNAL HEADS FOR PHASE 2.
- INSTALL AND COVER DETOUR SIGNS REQUIRED FOR 172ND STREET CLOSURE IN ACCORDANCE WITH DTP1.

FOR 'AS CONSTRUCTED
PLANS ONLY


LEGEND

-----	EXISTING PAVEMENT OR CURB EDGE
-----	EXISTING SIDEWALK EDGE
-----	EXISTING EDGE LINE
-----	EXISTING NO PASS CENTERLINE
=====	EXISTING DBL YLW CENTERLINE
- - - - -	EXISTING SKIP CENTERLINE
	WORK ZONE

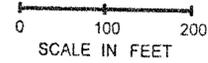

PHASE 1

FILE NAME: I:\Projects\XL3325 SR9 SR531 172nd St NE Int\CAD\PS&ESheets\XL3325 PS PHASING.dgn		REGION NO. STATE		FED.AID PROJ.NO.		 Washington State Department of Transportation		SR 9		Plot 1
TIME: 1:48:44 PM	DATE: 9/22/2011	10	WASH					SR 531/172ND ST NE & EAGLEFIELD DR	PLAN REF NO	
PLOTTED BY: lamaymp		JOB NUMBER				INTERSECTION IMPROVEMENT & PAVING	CP1	SHEET		
DESIGNED BY: M. LAMAY		10A042		LOCATION NO.		CONSTRUCTION PHASING PLAN		16		
ENTERED BY: M. MCREYNOLDS		CONTRACT NO.						230		
CHECKED BY: J. KORESKI								SHEETS		
PROJ. ENGR: S. SPAHR								230		
REGIONAL ADM: L. ENG								SHEETS		
REVISION		DATE	BY	P.E. STAMP BOX		DATE				

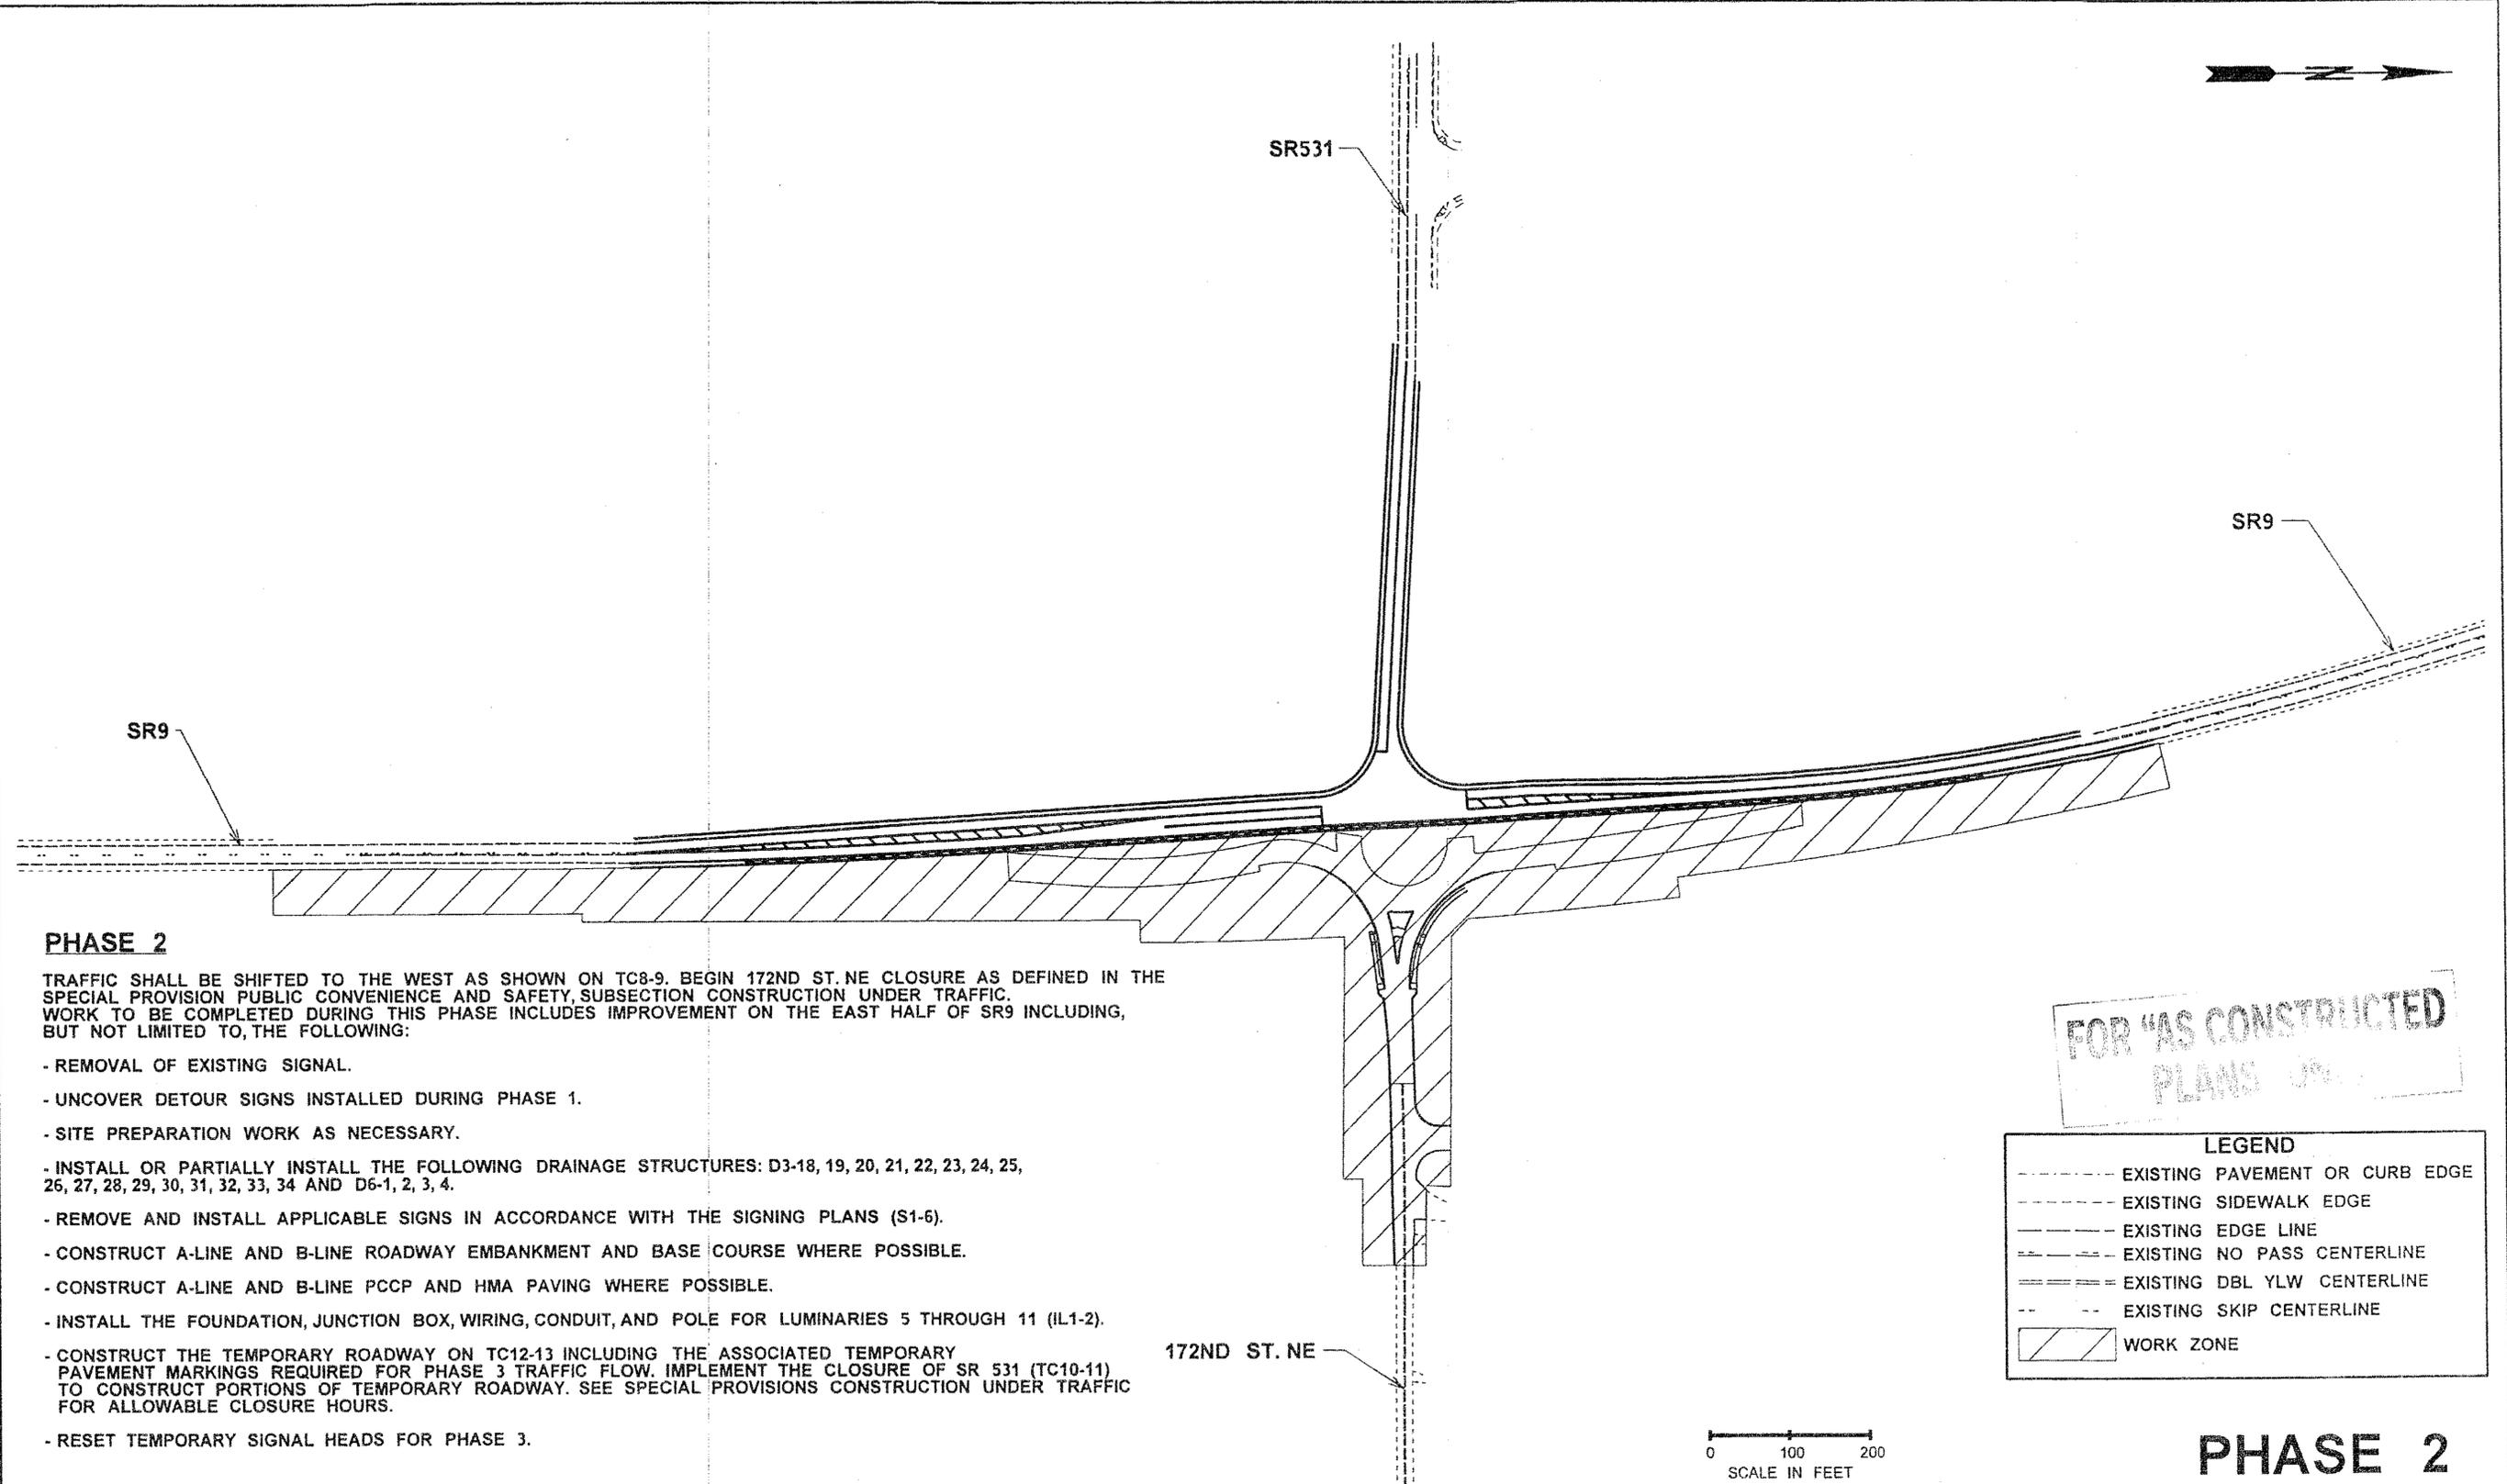

PHASE 2


TRAFFIC SHALL BE SHIFTED TO THE WEST AS SHOWN ON TC8-9. BEGIN 172ND ST. NE CLOSURE AS DEFINED IN THE SPECIAL PROVISION PUBLIC CONVENIENCE AND SAFETY, SUBSECTION CONSTRUCTION UNDER TRAFFIC. WORK TO BE COMPLETED DURING THIS PHASE INCLUDES IMPROVEMENT ON THE EAST HALF OF SR9 INCLUDING, BUT NOT LIMITED TO, THE FOLLOWING:

- REMOVAL OF EXISTING SIGNAL.
- UNCOVER DETOUR SIGNS INSTALLED DURING PHASE 1.
- SITE PREPARATION WORK AS NECESSARY.
- INSTALL OR PARTIALLY INSTALL THE FOLLOWING DRAINAGE STRUCTURES: D3-18, 19, 20, 21, 22, 23, 24, 25, 26, 27, 28, 29, 30, 31, 32, 33, 34 AND D6-1, 2, 3, 4.
- REMOVE AND INSTALL APPLICABLE SIGNS IN ACCORDANCE WITH THE SIGNING PLANS (S1-6).
- CONSTRUCT A-LINE AND B-LINE ROADWAY EMBANKMENT AND BASE COURSE WHERE POSSIBLE.
- CONSTRUCT A-LINE AND B-LINE PCCP AND HMA PAVING WHERE POSSIBLE.
- INSTALL THE FOUNDATION, JUNCTION BOX, WIRING, CONDUIT, AND POLE FOR LUMINARIES 5 THROUGH 11 (IL1-2).
- CONSTRUCT THE TEMPORARY ROADWAY ON TC12-13 INCLUDING THE ASSOCIATED TEMPORARY PAVEMENT MARKINGS REQUIRED FOR PHASE 3 TRAFFIC FLOW. IMPLEMENT THE CLOSURE OF SR 531 (TC10-11) TO CONSTRUCT PORTIONS OF TEMPORARY ROADWAY. SEE SPECIAL PROVISIONS CONSTRUCTION UNDER TRAFFIC FOR ALLOWABLE CLOSURE HOURS.
- RESET TEMPORARY SIGNAL HEADS FOR PHASE 3.



FOR "AS CONSTRUCTED" PLANS ONLY

LEGEND	
-----	EXISTING PAVEMENT OR CURB EDGE
-----	EXISTING SIDEWALK EDGE
-----	EXISTING EDGE LINE
-----	EXISTING NO PASS CENTERLINE
-----	EXISTING DBL YLW CENTERLINE
-----	EXISTING SKIP CENTERLINE
	WORK ZONE

PHASE 2

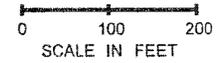

FILE NAME I:\Projects\XL3325_SR9_SR531_172nd_St_NE_Int\CADIPS&ESheets\XL3325_PS_PHASING.dgn				REGION NO. STATE		FED.AID PROJ.NO.		Washington State Department of Transportation		SR 9 SR 531/172ND ST NE & EAGLEFIELD DR INTERSECTION IMPROVEMENT & PAVING CONSTRUCTION PHASING PLAN		Plot 2 PLAN REF NO CP2
TIME	7:02:34 AM			10	WASH					SHEET 17 OF 230 SHEETS		
DATE	9/21/2011			JOB NUMBER	10A042							
PLOTTED BY	lamaymp			CONTRACT NO.		LOCATION NO.						
DESIGNED BY	M. LAMAY											
ENTERED BY	M. MCREYNOLDS											
CHECKED BY	J. KORESKI											
PROJ. ENGR.	S. SPAHR											
REGIONAL ADM.	L. ENG	REVISION	DATE	BY								

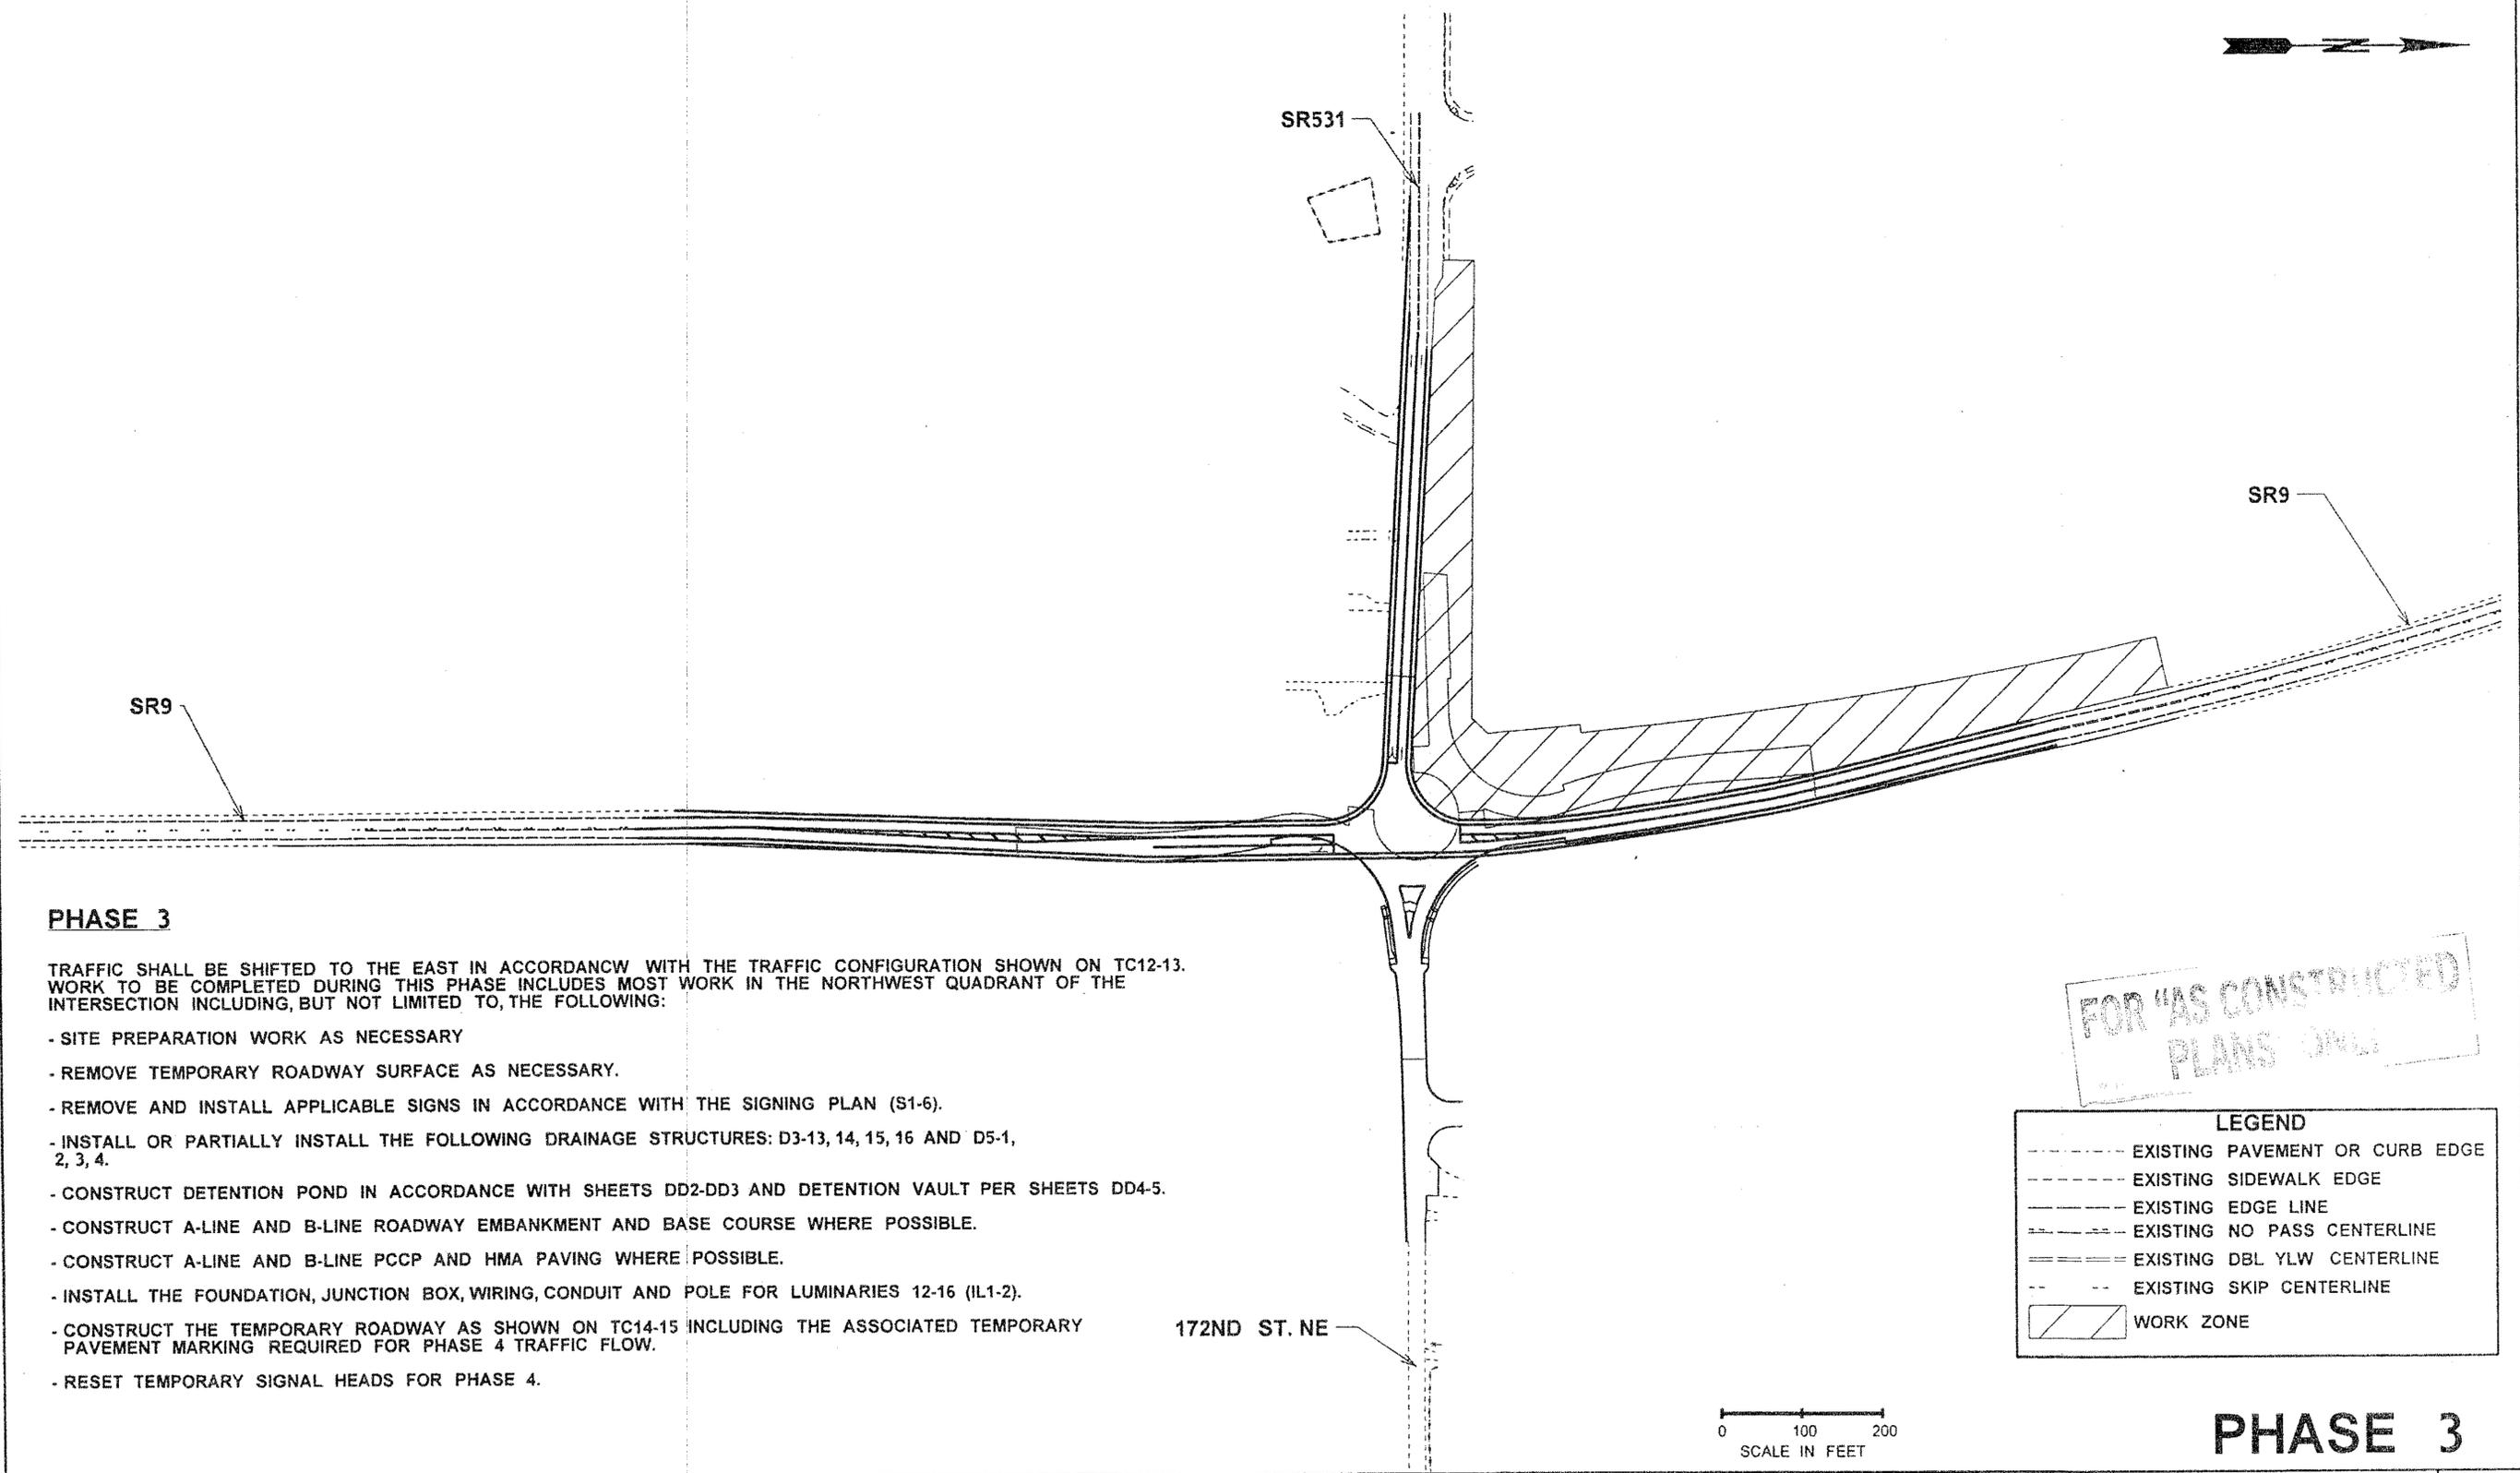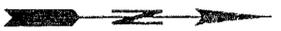

PHASE 3


TRAFFIC SHALL BE SHIFTED TO THE EAST IN ACCORDANCE WITH THE TRAFFIC CONFIGURATION SHOWN ON TC12-13. WORK TO BE COMPLETED DURING THIS PHASE INCLUDES MOST WORK IN THE NORTHWEST QUADRANT OF THE INTERSECTION INCLUDING, BUT NOT LIMITED TO, THE FOLLOWING:

- SITE PREPARATION WORK AS NECESSARY
- REMOVE TEMPORARY ROADWAY SURFACE AS NECESSARY.
- REMOVE AND INSTALL APPLICABLE SIGNS IN ACCORDANCE WITH THE SIGNING PLAN (S1-6).
- INSTALL OR PARTIALLY INSTALL THE FOLLOWING DRAINAGE STRUCTURES: D3-13, 14, 15, 16 AND D5-1, 2, 3, 4.
- CONSTRUCT DETENTION POND IN ACCORDANCE WITH SHEETS DD2-DD3 AND DETENTION VAULT PER SHEETS DD4-5.
- CONSTRUCT A-LINE AND B-LINE ROADWAY EMBANKMENT AND BASE COURSE WHERE POSSIBLE.
- CONSTRUCT A-LINE AND B-LINE PCCP AND HMA PAVING WHERE POSSIBLE.
- INSTALL THE FOUNDATION, JUNCTION BOX, WIRING, CONDUIT AND POLE FOR LUMINARIES 12-16 (IL1-2).
- CONSTRUCT THE TEMPORARY ROADWAY AS SHOWN ON TC14-15 INCLUDING THE ASSOCIATED TEMPORARY PAVEMENT MARKING REQUIRED FOR PHASE 4 TRAFFIC FLOW.
- RESET TEMPORARY SIGNAL HEADS FOR PHASE 4.


FOR "AS CONSTRUCTED"
PLANS ONLY

LEGEND	
-----	EXISTING PAVEMENT OR CURB EDGE
-----	EXISTING SIDEWALK EDGE
-----	EXISTING EDGE LINE
-----	EXISTING NO PASS CENTERLINE
=====	EXISTING DBL YLW CENTERLINE
-----	EXISTING SKIP CENTERLINE
	WORK ZONE

PHASE 3

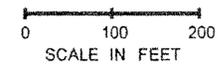

FILE NAME: I:\Projects\XL3325 SR9 SR531 172nd St NE Int\CAD\IPS&ESheets\XL3325_PS\PHASING.dgn				REGION NO.: 10		STATE: WASH		FED.AID PROJ.NO.		 Washington State Department of Transportation		SR 9		Plot 3	
TIME: 8:51:58 AM				JOB NUMBER: 10A042		CONTRACT NO.		LOCATION NO.				SR 531/172ND ST NE & EAGLEFIELD DR		INTERSECTION IMPROVEMENT & PAVING	
DATE: 9/19/2011				CONTRACT NO.:		CONTRACT NO.:		CONTRACT NO.:		 Washington State Department of Transportation		CONSTRUCTION PHASING PLAN		SHEET 18 OF 230 SHEETS	
PLOTTED BY: gunnm				DATE:		DATE:		DATE:				 Washington State Department of Transportation		CONSTRUCTION PHASING PLAN	
DESIGNED BY: M. LAMAY				P.E. STAMP BOX:		P.E. STAMP BOX:		P.E. STAMP BOX:		 Washington State Department of Transportation					
ENTERED BY: M. MCREYNOLDS				DATE:		DATE:		DATE:				 Washington State Department of Transportation		CONSTRUCTION PHASING PLAN	
CHECKED BY: J. KORESKI				DATE:		DATE:		DATE:		 Washington State Department of Transportation					
PROJ. ENGR.: S. SPAHR				DATE:		DATE:		DATE:				 Washington State Department of Transportation		CONSTRUCTION PHASING PLAN	
REGIONAL ADM.: L. ENG				DATE:		DATE:		DATE:		 Washington State Department of Transportation					
REVISION:				DATE:		DATE:		DATE:				 Washington State Department of Transportation		CONSTRUCTION PHASING PLAN	
BY:				DATE:		DATE:		DATE:		 Washington State Department of Transportation					

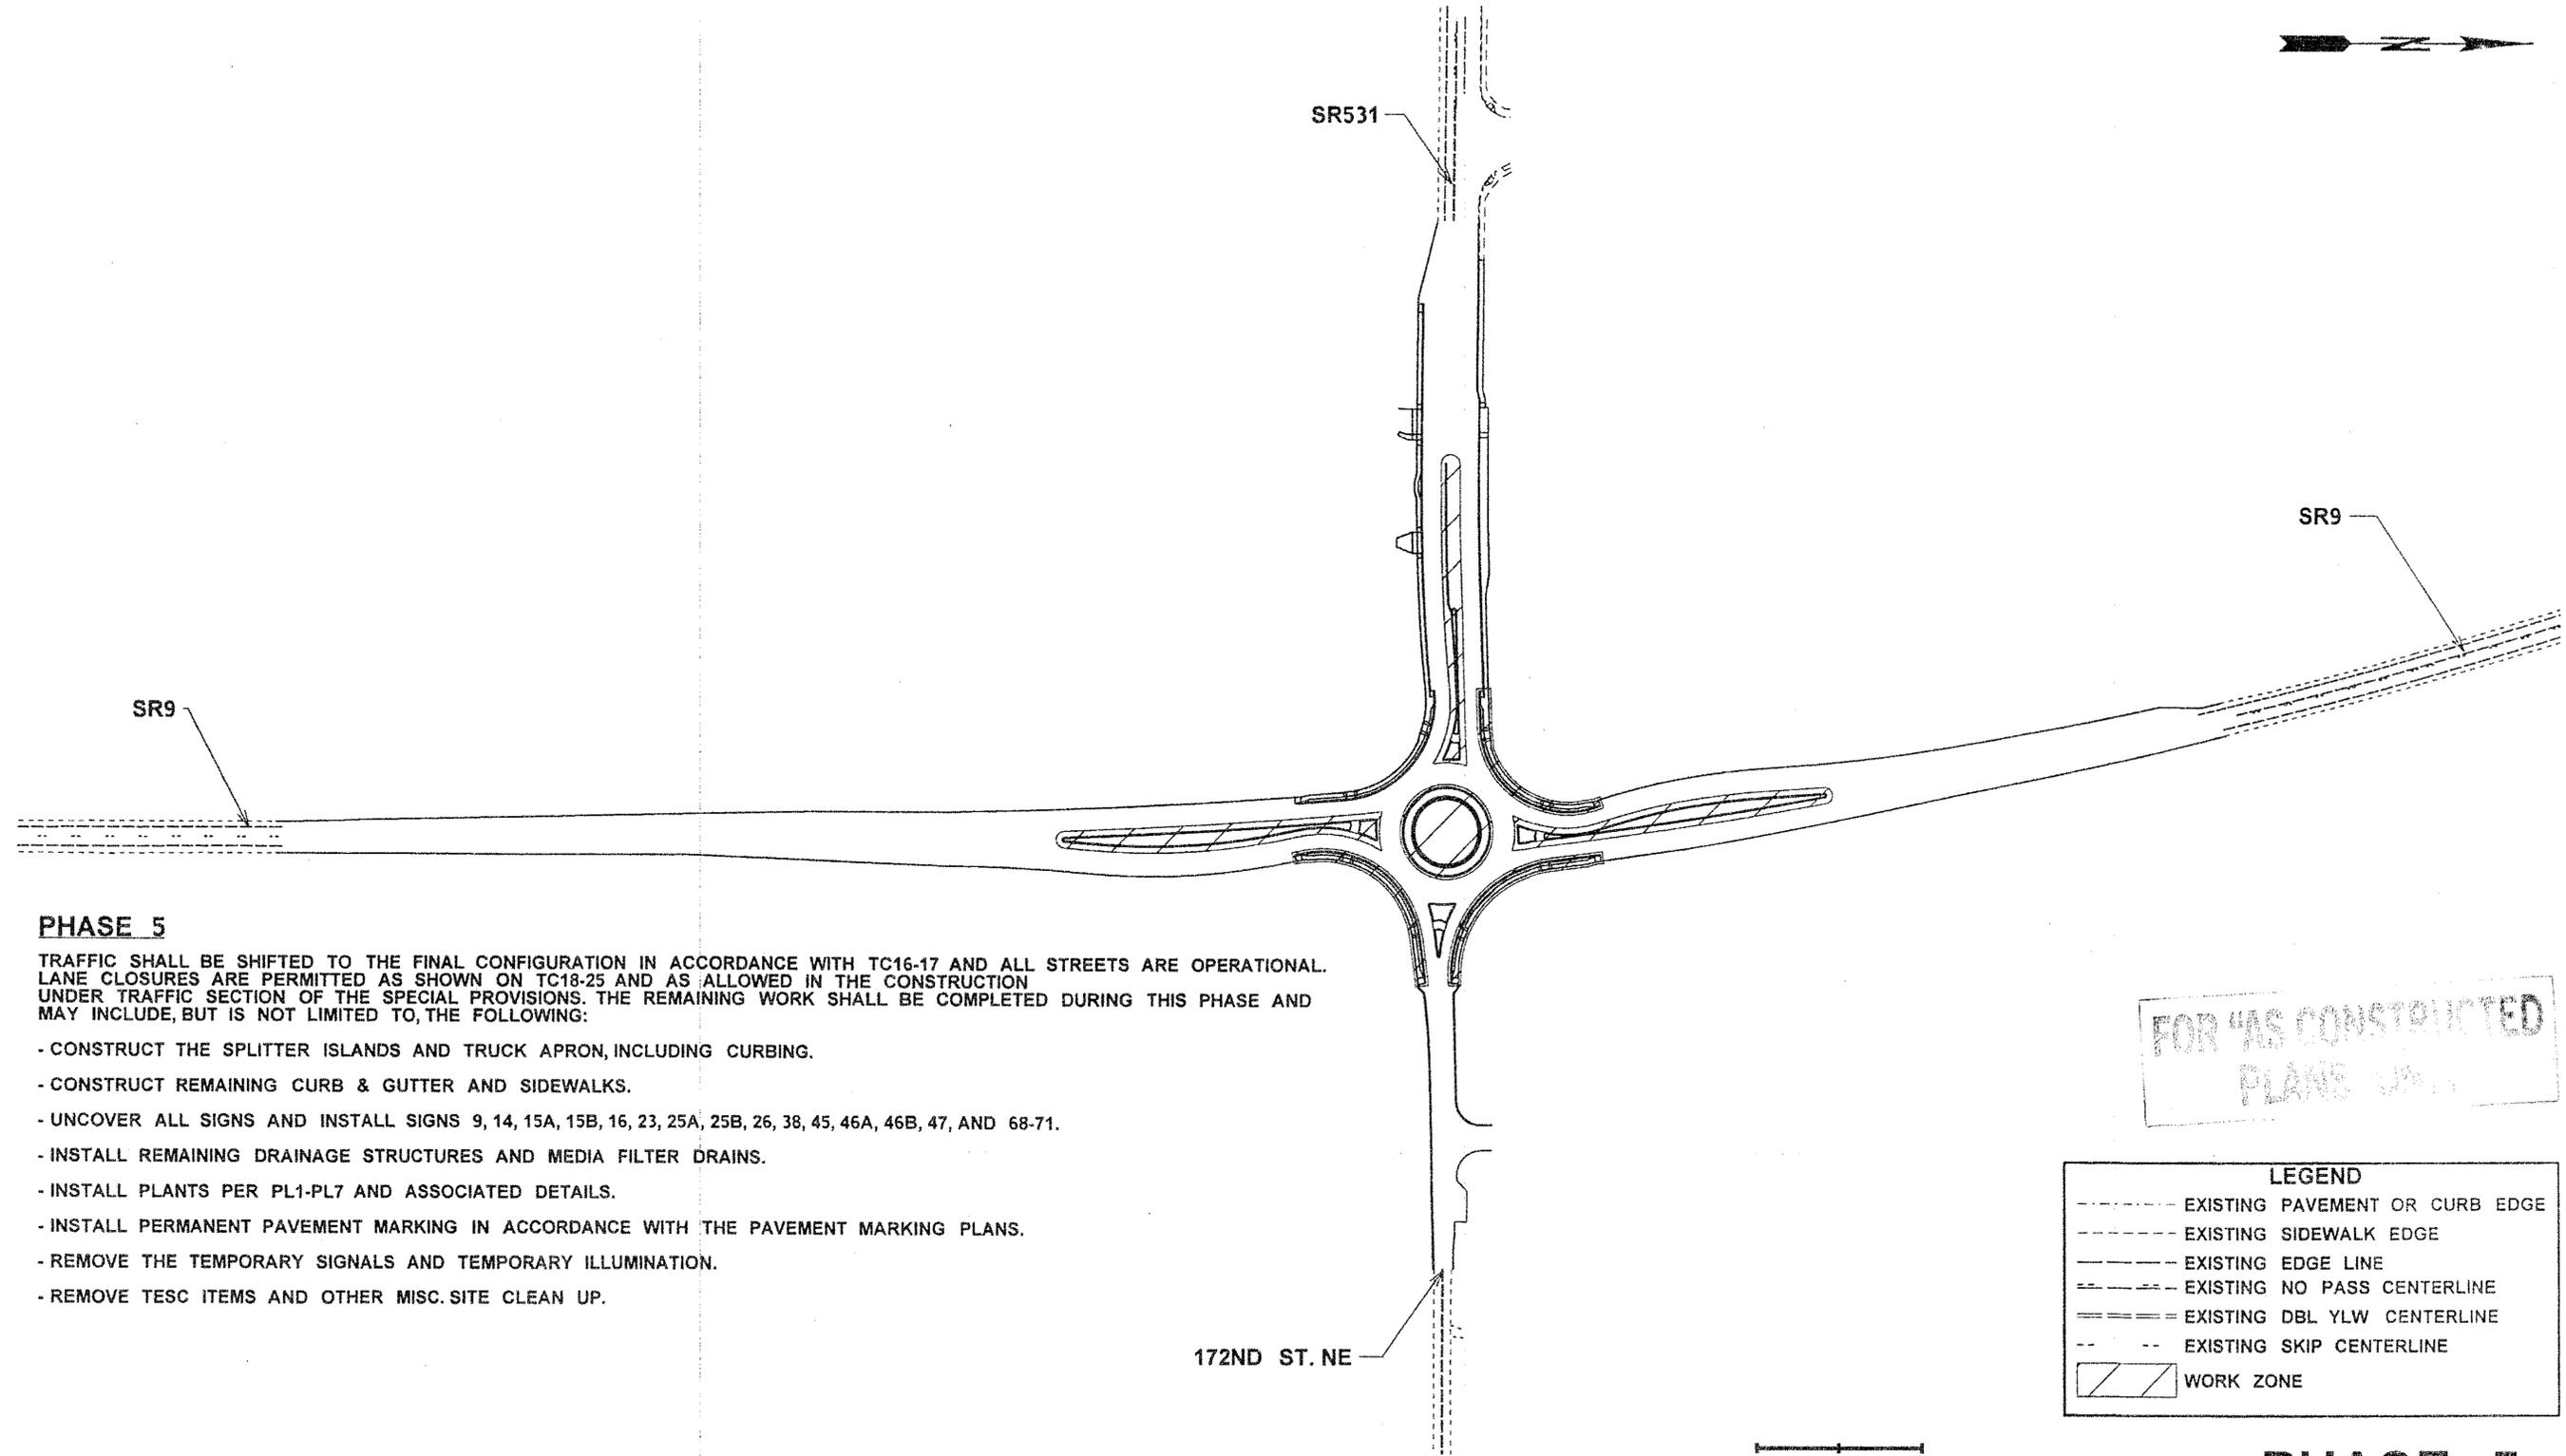


PHASE 5

TRAFFIC SHALL BE SHIFTED TO THE FINAL CONFIGURATION IN ACCORDANCE WITH TC16-17 AND ALL STREETS ARE OPERATIONAL. LANE CLOSURES ARE PERMITTED AS SHOWN ON TC18-25 AND AS ALLOWED IN THE CONSTRUCTION UNDER TRAFFIC SECTION OF THE SPECIAL PROVISIONS. THE REMAINING WORK SHALL BE COMPLETED DURING THIS PHASE AND MAY INCLUDE, BUT IS NOT LIMITED TO, THE FOLLOWING:

- CONSTRUCT THE SPLITTER ISLANDS AND TRUCK APRON, INCLUDING CURBING.
- CONSTRUCT REMAINING CURB & GUTTER AND SIDEWALKS.
- UNCOVER ALL SIGNS AND INSTALL SIGNS 9, 14, 15A, 15B, 16, 23, 25A, 25B, 26, 38, 45, 46A, 46B, 47, AND 68-71.
- INSTALL REMAINING DRAINAGE STRUCTURES AND MEDIA FILTER DRAINS.
- INSTALL PLANTS PER PL1-PL7 AND ASSOCIATED DETAILS.
- INSTALL PERMANENT PAVEMENT MARKING IN ACCORDANCE WITH THE PAVEMENT MARKING PLANS.
- REMOVE THE TEMPORARY SIGNALS AND TEMPORARY ILLUMINATION.
- REMOVE TESC ITEMS AND OTHER MISC. SITE CLEAN UP.

FOR "AS CONSTRUCTED"
PLANS ONLY

LEGEND	
-----	EXISTING PAVEMENT OR CURB EDGE
-----	EXISTING SIDEWALK EDGE
-----	EXISTING EDGE LINE
-----	EXISTING NO PASS CENTERLINE
=====	EXISTING DBL YLW CENTERLINE
----	EXISTING SKIP CENTERLINE
	WORK ZONE

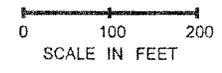


PHASE 5

FILE NAME I:\Projects\XL3325_SR9_SR531_172nd St_NE_Int\CAD\PS&ESheets\XL3325_PS_PHASING.dgn		REGION NO. 10		STATE WASH	FED.AID PROJ.NO.	Washington State Department of Transportation	SR 9	Plot 5
TIME 6:58:30 AM	DATE 9/21/2011	JOB NUMBER 10A042		CONTRACT NO.	LOCATION NO.		SR 531/172ND ST NE & EAGLEFIELD DR	PLAN REF NO CP5
PLOTTED BY lamaymp	DESIGNED BY M. LAMAY	ENTERED BY M. MCREYNOLDS	CHECKED BY J. KORESKI	PROJ. ENGR. S. SPAHR	REGIONAL ADM. L. ENG	INTERSECTION IMPROVEMENT & PAVING CONSTRUCTION PHASING PLAN	SHEET 20 OF 230 SHEETS	
REVISION	DATE	BY	P.E. STAMP BOX DATE		P.E. STAMP BOX DATE			

LEGEND

- EXISTING EDGE LINE
- - - - - EXISTING EDGE OF PAVEMENT
- - - - - EXISTING EDGE OF SHOULDER
- - - - - EXISTING CURB
- - - - - UNSUITABLE FOUNDATION EXCAVATION LIMITS
- - - - - CUT LINE
- - - - - FILL LINE
- ⊙ PROPERTY CORNER
- △ SURVEY CONTROL POINT
- - - - - CORPORATE LIMITS
- - - - - SIXTEENTH SECTION LINE
- - - - - SECTION LINE
- - - - - WSDOT R/W
- ////// WSDOT LIMITED ACCESS
- 30 29
31 32 SECTION CORNER FOUND
- SURVEY MONUMENT

T. 31N. R. 5E. W.M.

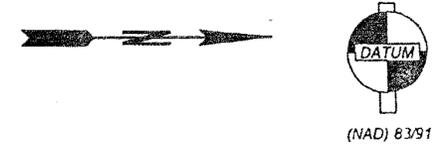


(NAD) 8391

LOCATION/SHEET	UNSUITABLE FOUNDATION EXCAVATION INCL. HAUL (CY)	QUARRY SPALLS (TON)*	GEOTEXTILE FABRIC FOR SEPARATION (SY)*
AREA 1 (AL2&3)	360	700	1080
AREA 2 (AL3&6)	252	477	750
AREA 3 (AL5)	83	158	250
AREA 4 (AL5)	45	86	140
TOTALS	740	1421	2220

*REFER TO STRUCTURE NOTES-DRAINAGE AND QUANTITY TABULATION-TEMPORARY EROSION CONTROL SHEETS FOR ADDITIONAL QUANTITIES.

BEGIN PROJECT
SR 9
MP 25.75
STA A 794+50.00=
SR9 (ROW) 794+17.02 (0.0' RT)

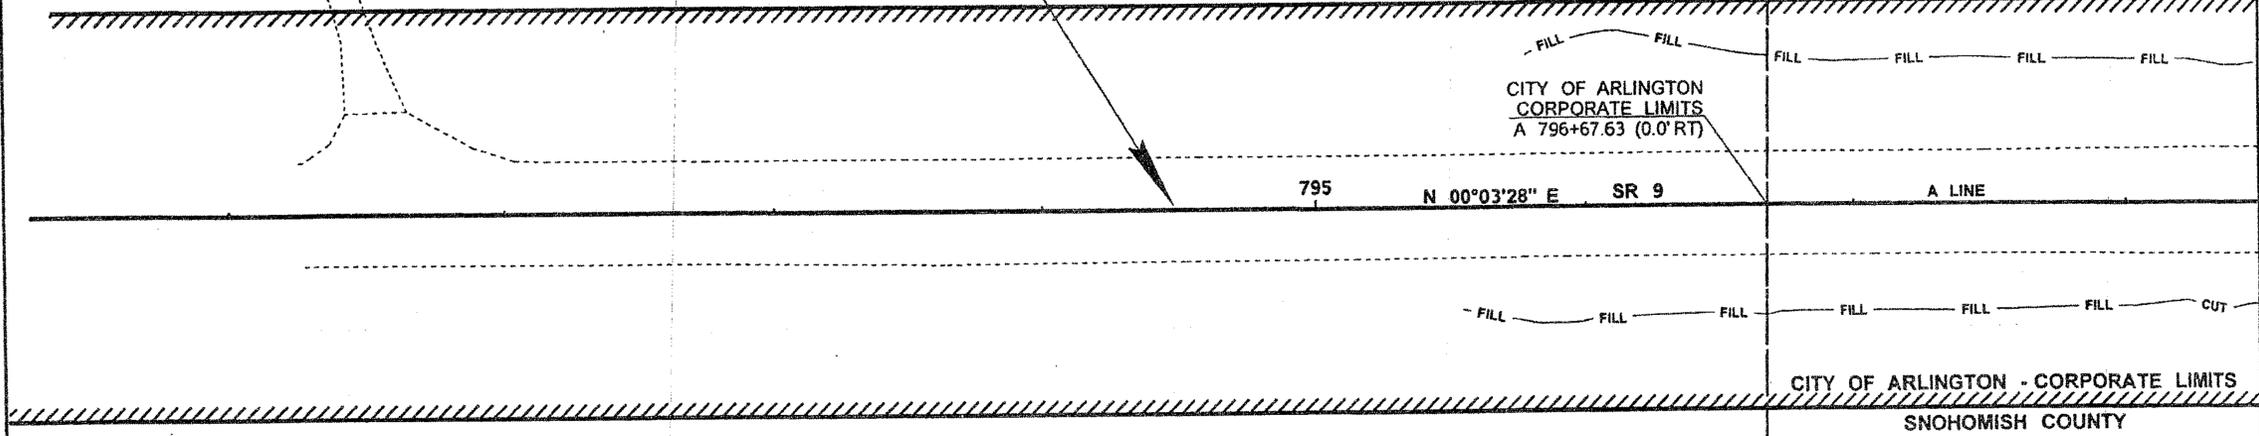


GENERAL NOTES:

1. IN ACCORDANCE WITH RCW 58.09-130, ANY MONUMENT OR CORNER NOT SCHEDULED FOR REMOVAL, ABANDONMENT, OR ADJUSTMENT THAT IS DISTURBED BY THE CONTRACTORS SHALL BE REPLACED AT NO COST TO THE CONTRACTING AGENCY.
2. A UTILITY EASEMENT HAS BEEN ACQUIRED BY THE CITY OF ARLINGTON AND RIGHTS HAVE BEEN ASSIGNED TO WSDOT FOR THE CONSTRUCTION OF SANITARY SEWER FACILITIES.
3. FOR ABANDONING OR ADJUSTING MONUMENT CASE AND COVERS AND PROPERTY CORNERS SEE SPECIAL PROVISION ABANDON OR ADJUST MONUMENT CASE AND COVERS AND PROPERTY CORNERS.

CONSTRUCTION NOTES:

- 1 TO BE PROTECTED
- 2 TO BE ABANDONED
- 3 TO BE ADJUSTED
- 4 TO BE INSTALLED BY OTHERS AND PROTECTED

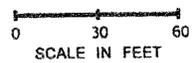

FOR "AS CONSTRUCTED PLANS" ONLY

FILE NAME	I:\Projects\XL3325 SR9 SR531 172nd St NE Int\CAD\PS&ESheets\XL3325 PS AL RW.dgn	REGION NO.	10	STATE	WASH	FED.AID PROJ.NO.		<p>Washington State Department of Transportation</p>	SR 9 SR 531/172ND ST NE & EAGLEFIELD DR INTERSECTION IMPROVEMENT & PAVING ALIGNMENT/RIGHT OF WAY	Plot 1
TIME	11:16:49 AM	AD1 - REVISED QUANTITIES	10/25/2011	SMS						PLAN REF NO
DATE	10/26/2011									SHEET
PLOTTED BY	lamaymp									21
DESIGNED BY	M. GUNN									OF
ENTERED BY	K.SOLWOLD									230
CHECKED BY	J. KORESKI									SHEETS
PROJ. ENGR.	S.SPAHR									
REGIONAL ADM.	L. ENG	REVISION	DATE	BY						

LEGEND

- EXISTING EDGE LINE
- - - EXISTING EDGE OF PAVEMENT
- - - EXISTING EDGE OF SHOULDER
- - - EXISTING CURB
- - - UNSUITABLE FOUNDATION EXCAVATION LIMITS
- CUT --- CUT LINE
- FILL --- FILL LINE
- ⊙ PROPERTY CORNER
- △ SURVEY CONTROL POINT
- - - CORPORATE LIMITS
- - - SIXTEENTH SECTION LINE
- - - SECTION LINE
- - - WSDOT RAW
- ////// WSDOT LIMITED ACCESS
- 30 | 29
31 | 32 SECTION CORNER FOUND
- SURVEY MONUMENT


T. 31N. R. 5E. W.M.



(NAD) 83/91

NW 1/4 NW 1/4
SEC. 25

NE 1/4 NW 1/4
SEC. 25

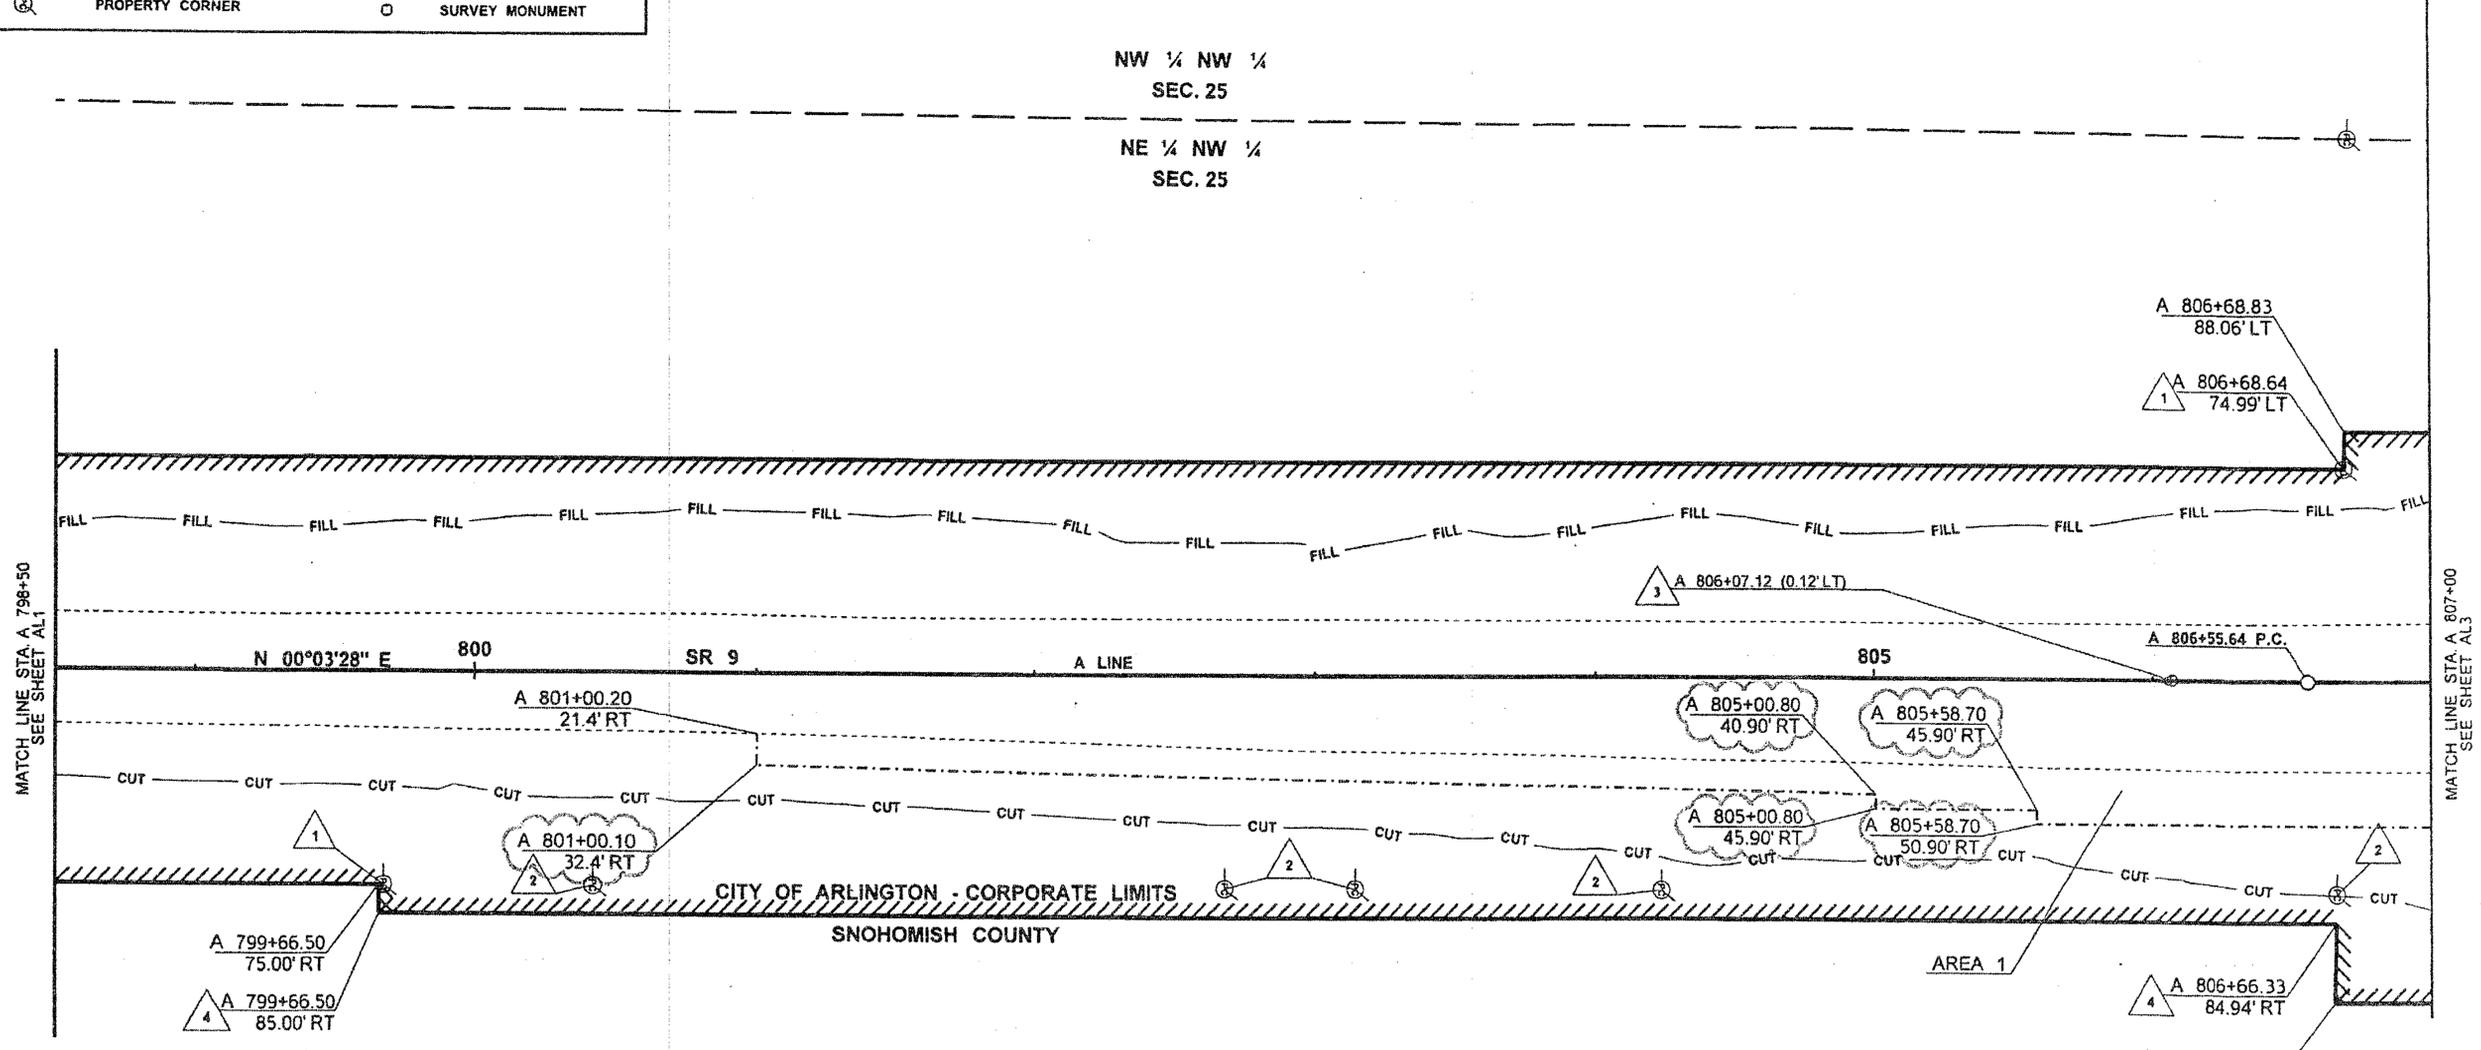


GENERAL NOTES:

1. IN ACCORDANCE WITH RCW 58.09-130, ANY MONUMENT OR CORNER NOT SCHEDULED FOR REMOVAL, ABANDONMENT, OR ADJUSTMENT THAT IS DISTURBED BY THE CONTRACTORS SHALL BE REPLACED AT NO COST TO THE CONTRACTING AGENCY.
2. A UTILITY EASEMENT HAS BEEN ACQUIRED BY THE CITY OF ARLINGTON AND RIGHTS HAVE BEEN ASSIGNED TO WSDOT FOR THE CONSTRUCTION OF SANITARY SEWER FACILITIES.
3. FOR ABANDONING OR ADJUSTING MONUMENT CASE AND COVERS AND PROPERTY CORNERS SEE SPECIAL PROVISION ABANDON OR ADJUST MONUMENT CASE AND COVERS AND PROPERTY CORNERS.

CONSTRUCTION NOTES:

- △ 1 TO BE PROTECTED
- △ 2 TO BE ABANDONED
- △ 3 TO BE ADJUSTED
- △ 4 TO BE INSTALLED BY OTHERS AND PROTECTED

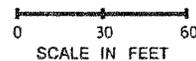

FOR HAS CONSTRUCTED
PLAN

CURVE DATA					
P.I. STATION	DELTA	RADIUS	TANGENT	LENGTH	S
A 815+27.63	17° 18' 21.00"	5730.00'	871.99'	1731.71'	N/A

FILE NAME: I:\Projects\XL3325_SR9_SR531_172nd St NE Int\CAD\PS&ESheets\XL3325_PS_AL_RW.dgn		TIME: 11:16:50 AM		DATE: 10/26/2011		PLOTTED BY: lamaymp		DESIGNED BY: M. GUNN		ENTERED BY: K. SOLWOLD		CHECKED BY: J. KORESKI		PROJ. ENGR: S. SPAHR		REGIONAL ADM: L. ENG	
AD1 - REVISED EXCAVATION LIMITS		10/25/2011		SMS		REGION NO. 10		STATE WASH		FED. AID PROJ. NO.		JOB NUMBER 10A042		CONTRACT NO.		LOCATION NO.	
REVISION		DATE		BY		P.E. STAMP BOX		DATE 10/26/11		P.E. STAMP BOX		DATE		Washington State Department of Transportation		SR 9 SR 531/172ND ST NE & EAGLEFIELD DR INTERSECTION IMPROVEMENT & PAVING	
														ALIGNMENT/RIGHT OF WAY		Plot 2 PLAN REF NO AL2 SHEET 22 OF 230 SHEETS	

T. 31N. R. 5E. W.M.


CURVE DATA					
P.I. STATION	DELTA	RADIUS	TANGENT	LENGTH	S
B 17+29.90	7° 58' 50.21"	250.00'	17.44'	34.82'	N/A
B 19+84.86	7° 14' 55.71"	420.00'	26.60'	53.14'	N/A
A 815+27.63	17° 18' 21.00"	5730.00'	871.99'	1731.71'	N/A

GENERAL NOTES:

1. IN ACCORDANCE WITH RCW 58.09-130, ANY MONUMENT OR CORNER NOT SCHEDULED FOR REMOVAL, ABANDONMENT, OR ADJUSTMENT THAT IS DISTURBED BY THE CONTRACTORS SHALL BE REPLACED AT NO COST TO THE CONTRACTING AGENCY.
2. A UTILITY EASEMENT HAS BEEN ACQUIRED BY THE CITY OF ARLINGTON AND RIGHTS HAVE BEEN ASSIGNED TO WSDOT FOR THE CONSTRUCTION OF SANITARY SEWER FACILITIES.
3. FOR ABANDONING OR ADJUSTING MONUMENT CASE AND COVERS AND PROPERTY CORNERS SEE SPECIAL PROVISION ABANDON OR ADJUST MONUMENT CASE AND COVERS AND PROPERTY CORNERS.




(NAD) 83/91

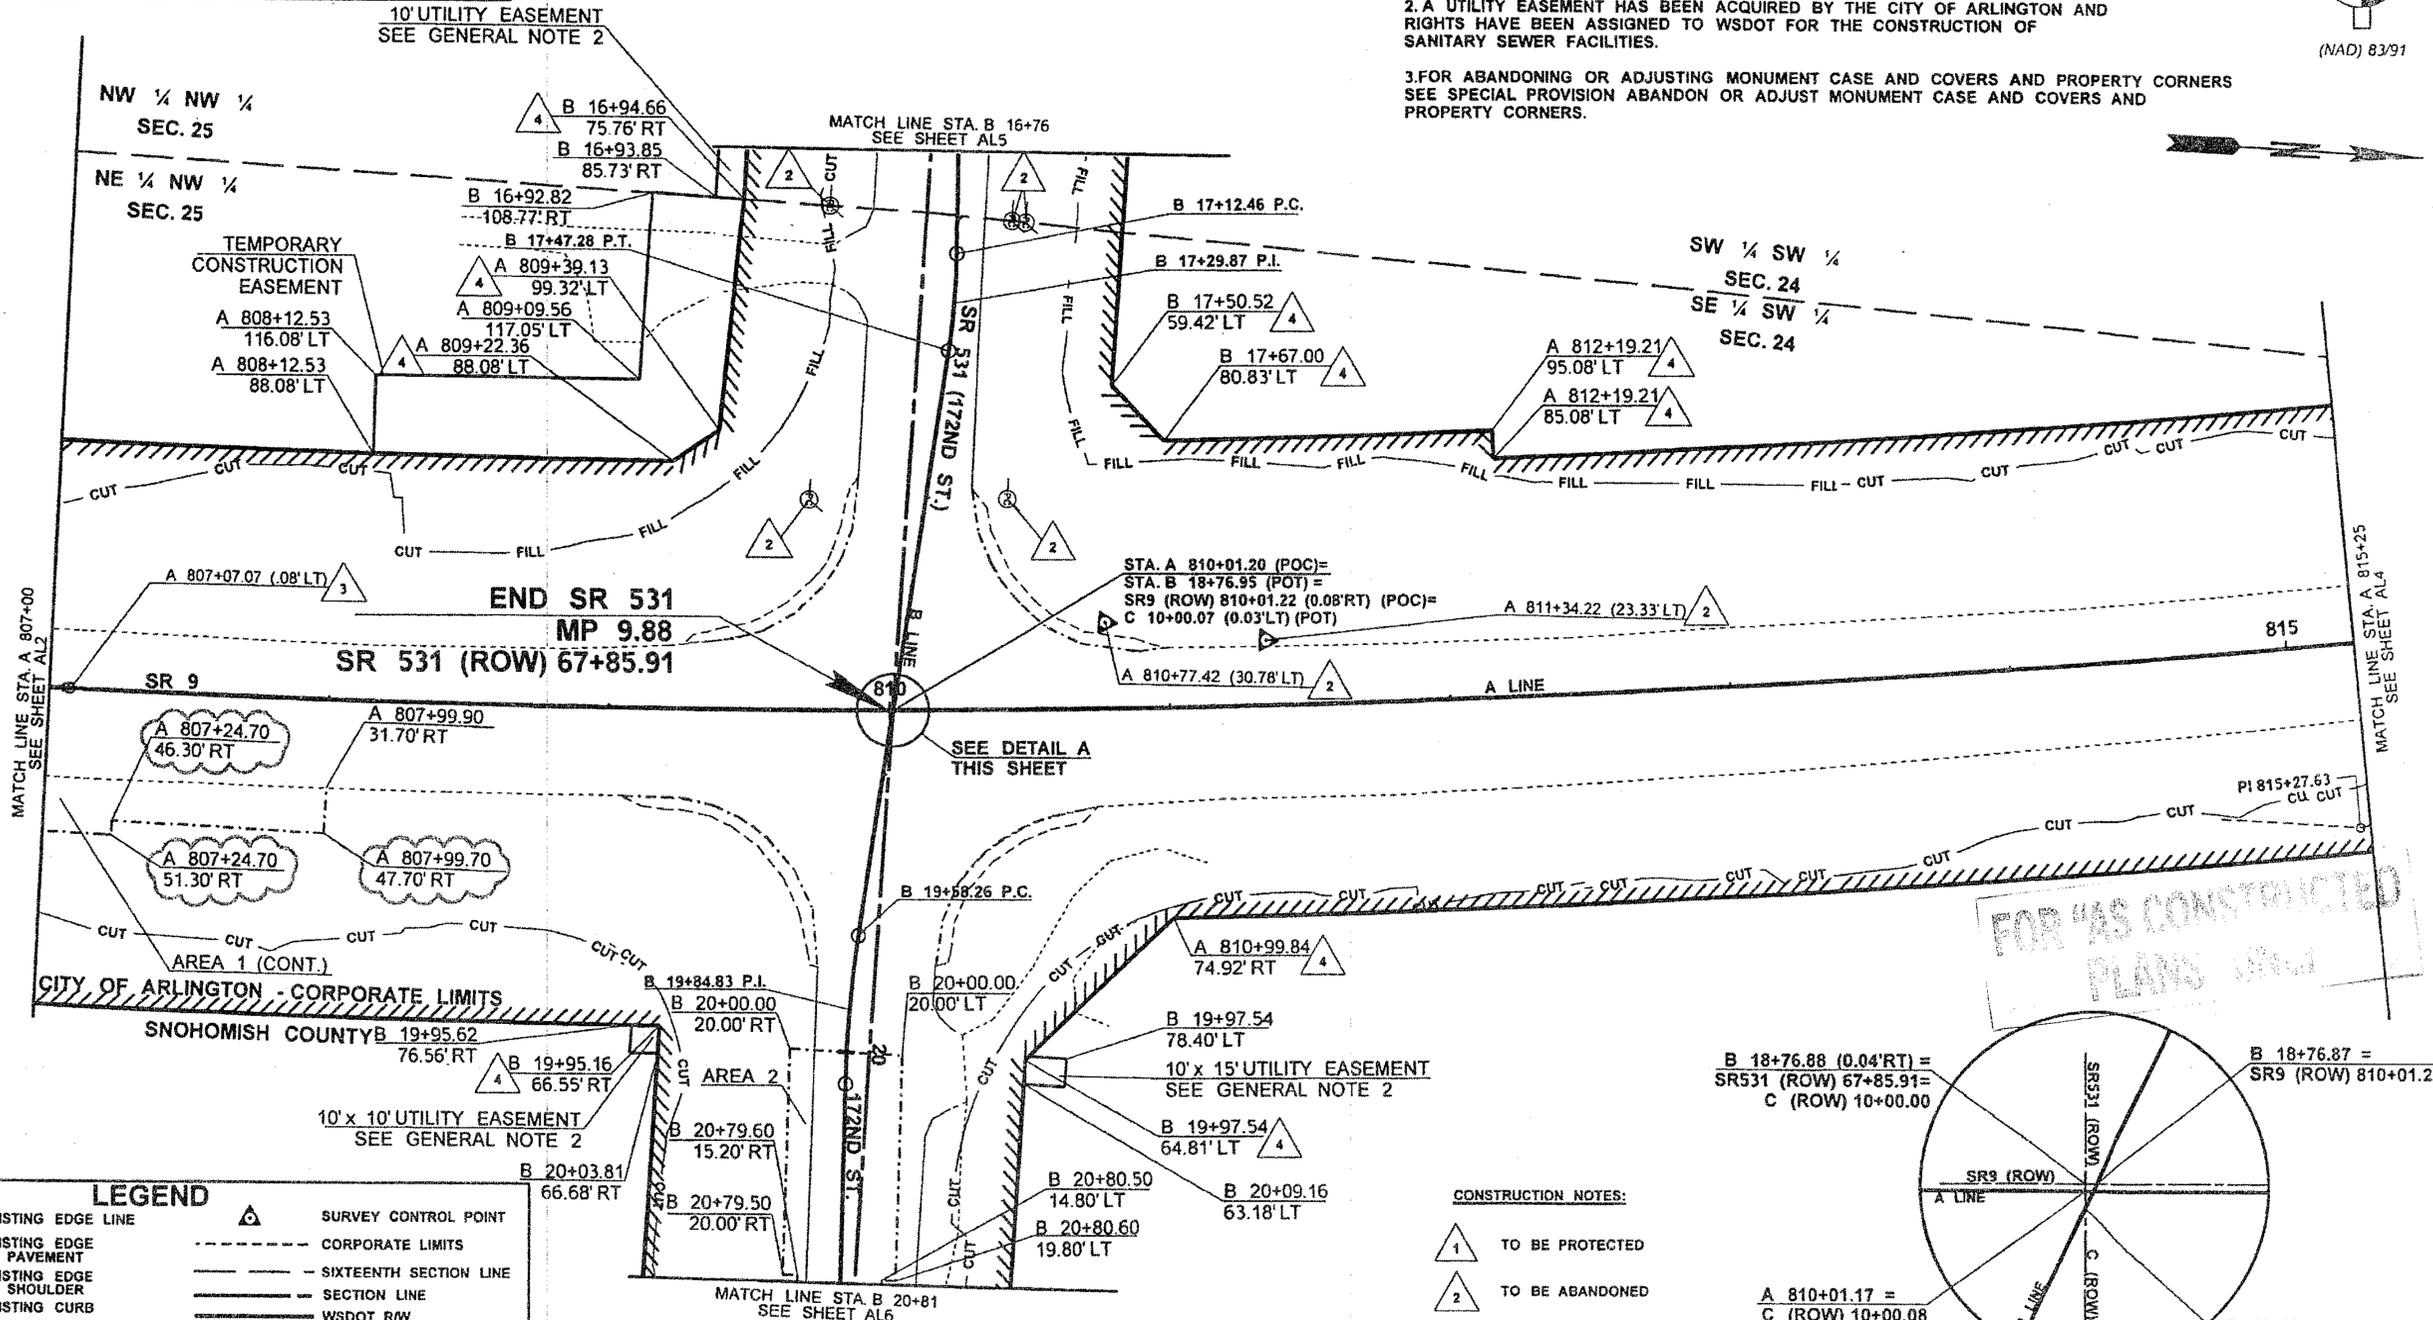

FOR "AS CONSTRUCTED" PLANS ONLY

B 18+76.88 (0.04' RT) = SR531 (ROW) 67+85.91 = C (ROW) 10+00.00


B 18+76.87 = SR9 (ROW) 810+01.23

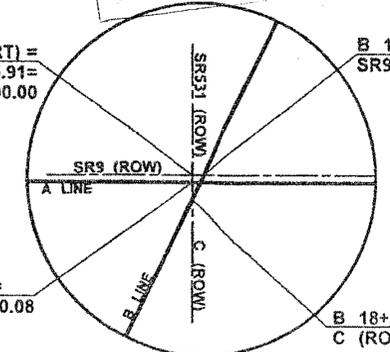

LEGEND

--- EXISTING EDGE LINE	▲ SURVEY CONTROL POINT
- - - EXISTING EDGE OF PAVEMENT	- - - CORPORATE LIMITS
- - - EXISTING EDGE OF SHOULDER	- - - SIXTEENTH SECTION LINE
- - - EXISTING CURB	- - - SECTION LINE
- - - UNSUITABLE FOUNDATION EXCAVATION LIMITS	- - - WSDOT R/W
- CUT -	- - - WSDOT LIMITED ACCESS
- FILL -	30 29 SECTION CORNER FOUND
○ PROPERTY CORNER	31 32 SURVEY MONUMENT

- CONSTRUCTION NOTES:**
- 1 TO BE PROTECTED
 - 2 TO BE ABANDONED
 - 3 TO BE ADJUSTED
 - 4 TO BE INSTALLED BY OTHERS AND PROTECTED

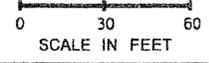

FILE NAME	I:\Projects\XL3325_SR9_SR531_172nd St NE Int\CAD\PS&ESheets\XL3325_PS_AL_RW.dgn			REGION NO.	STATE	FED.AID PROJ.NO.			SR 9 SR 531/172ND ST NE & EAGLEFIELD DR INTERSECTION IMPROVEMENT & PAVING ALIGNMENT/RIGHT OF WAY	Plot 3 PLAN REF NO AL3 SHEET 23 OF 230 SHEETS
TIME	11:16:52 AM	AD1 - REVISED EXCAVATION LIMITS	10/25/2011	10	WASH					
DATE	10/26/2011									
PLOTTED BY	lamaymp									
DESIGNED BY	M. GUNN									
ENTERED BY	K.SOLWOLD									
CHECKED BY	J. KORESKI									
PROJ. ENGR.	S.SPAHR									
REGIONAL ADM.	L. ENG	REVISION	DATE	BY						


T. 31N. R. 5E. W.M.



(NAD) 8391

LEGEND	
--- EXISTING EDGE LINE	△ SURVEY CONTROL POINT
--- EXISTING EDGE OF PAVEMENT	--- CORPORATE LIMITS
--- EXISTING EDGE OF SHOULDER	--- SIXTEENTH SECTION LINE
--- EXISTING CURB	--- SECTION LINE
--- UNSUITABLE FOUNDATION EXCAVATION LIMITS	--- WSDOT R/W
- CUT --- CUT LINE	/// WSDOT LIMITED ACCESS
- FILL --- FILL LINE	30 29 31 32 SECTION CORNER FOUND
○ PROPERTY CORNER	○ SURVEY MONUMENT


CURVE DATA					
P.I. STATION	DELTA	RADIUS	TANGENT	LENGTH	S
A 815+27.63	17° 18' 21.00"	5730.00'	871.99'	1731.71'	N/A

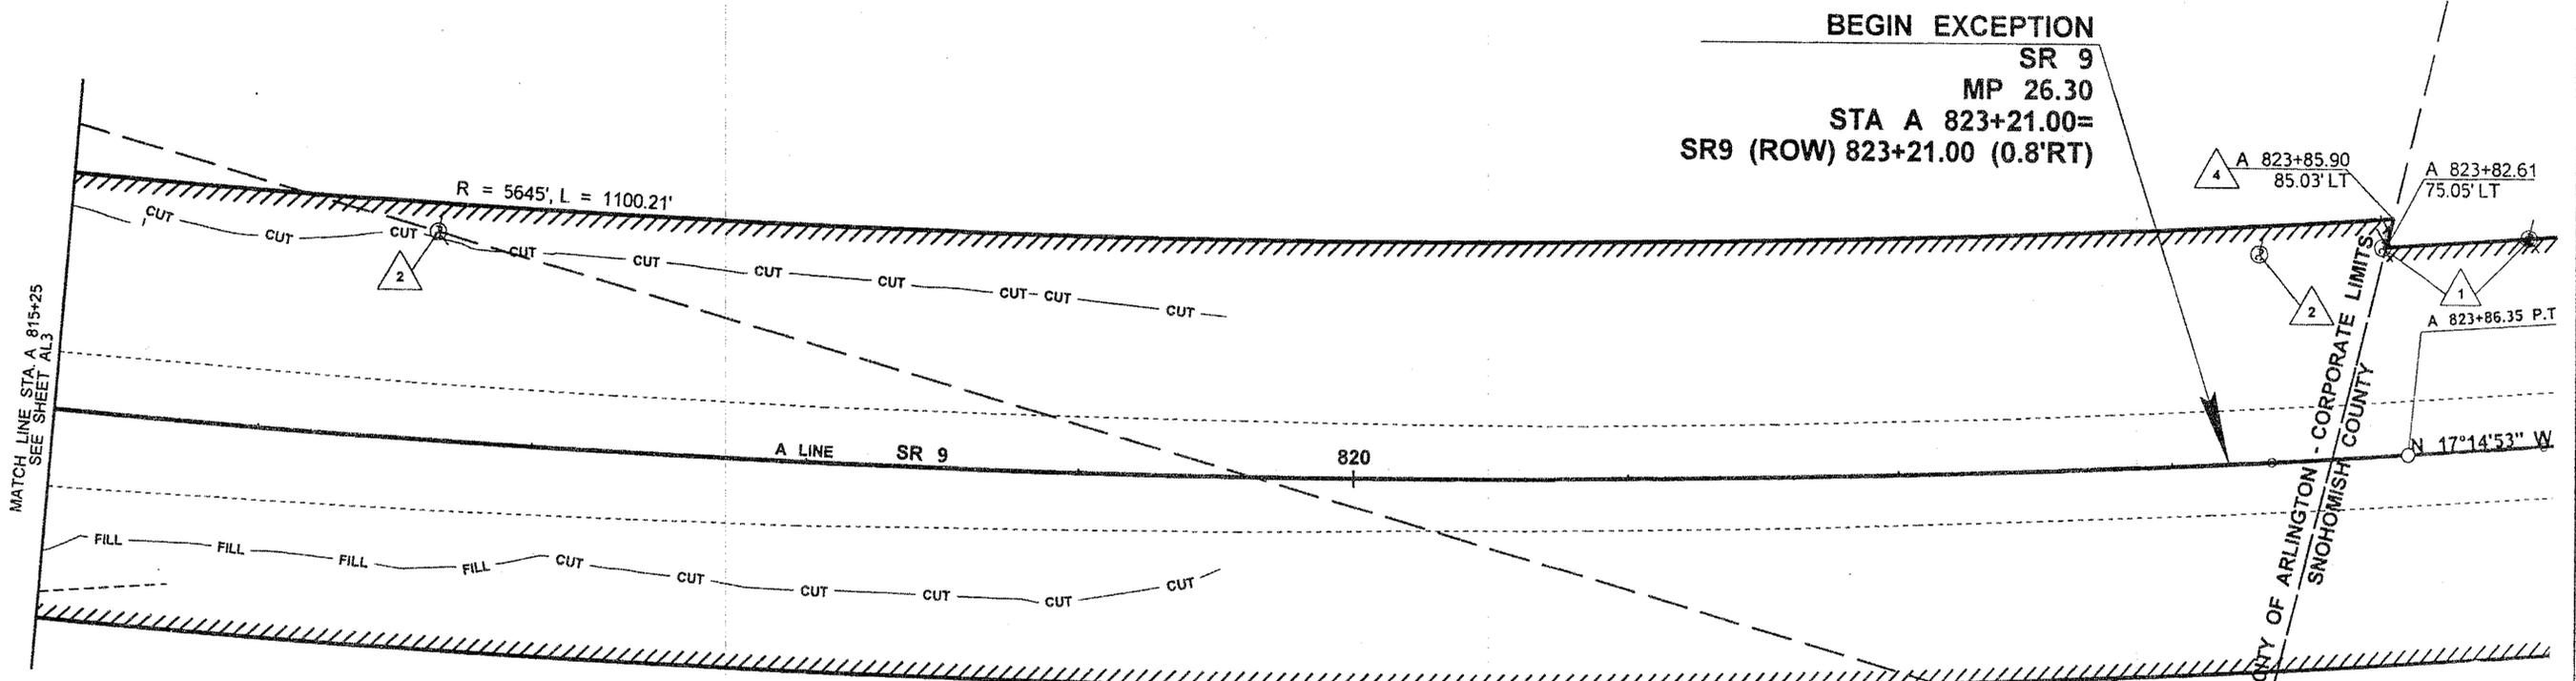

GENERAL NOTES:

- IN ACCORDANCE WITH RCW 58.09-130, ANY MONUMENT OR CORNER NOT SCHEDULED FOR REMOVAL, ABANDONMENT, OR ADJUSTMENT THAT IS DISTURBED BY THE CONTRACTORS SHALL BE REPLACED AT NO COST TO THE CONTRACTING AGENCY.
- A UTILITY EASEMENT HAS BEEN ACQUIRED BY THE CITY OF ARLINGTON AND RIGHTS HAVE BEEN ASSIGNED TO WSDOT FOR THE CONSTRUCTION OF SANITARY SEWER FACILITIES.
- FOR ABANDONING OR ADJUSTING MONUMENT CASE AND COVERS AND PROPERTY CORNERS SEE SPECIAL PROVISION ABANDON OR ADJUST MONUMENT CASE AND COVERS AND PROPERTY CORNERS.

- CONSTRUCTION NOTES:**
- △ 1 TO BE PROTECTED
 - △ 2 TO BE ABANDONED
 - △ 3 TO BE ADJUSTED
 - △ 4 TO BE INSTALLED BY OTHERS AND PROTECTED

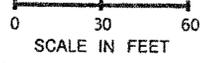

FOR "AS CONSTRUCTED" PLANS ONLY

FILE NAME: I:\Projects\XL3325 SR9_SR531 172nd St NE Int\CAD\PS&ESheets\XL3325_PS_AL_RW.dgn	REGION NO. 10	STATE WASH	FED.AID PROJ.NO.			SR 9 SR 531/172ND ST NE & EAGLEFIELD DR INTERSECTION IMPROVEMENT & PAVING ALIGNMENT/RIGHT OF WAY	Plot 4
TIME: 10:21:01 AM	JOB NUMBER: 10A042	CONTRACT NO.	LOCATION NO.				PLAN REF NO: AL4
DATE: 9/22/2011	REVISION	DATE	BY	DATE: 9/22/11	DATE	SHEET 24 OF 230 SHEETS	
PLOTTED BY: lamaymp							
DESIGNED BY: M. GUNN							
ENTERED BY: K. SOLWOLD							
CHECKED BY: J. KORESKE							
PROJ. ENGR.: S. SPAHR							
REGIONAL ADM.: L. ENG							


T. 31N. R. 5E. W.M.

CURVE DATA					
P.I. STATION	DELTA	RADIUS	TANGENT	LENGTH	S
B 15+07.14	3° 11' 20.98"	3222.00'	89.69'	179.34'	N/A



(NAD) 83/91

BEGIN CONSTRUCTION
 SR 531
 MP 9.73
 STA B 10+53.8 =
 SR531 (ROW) 59+09.79 (1.31'RT)

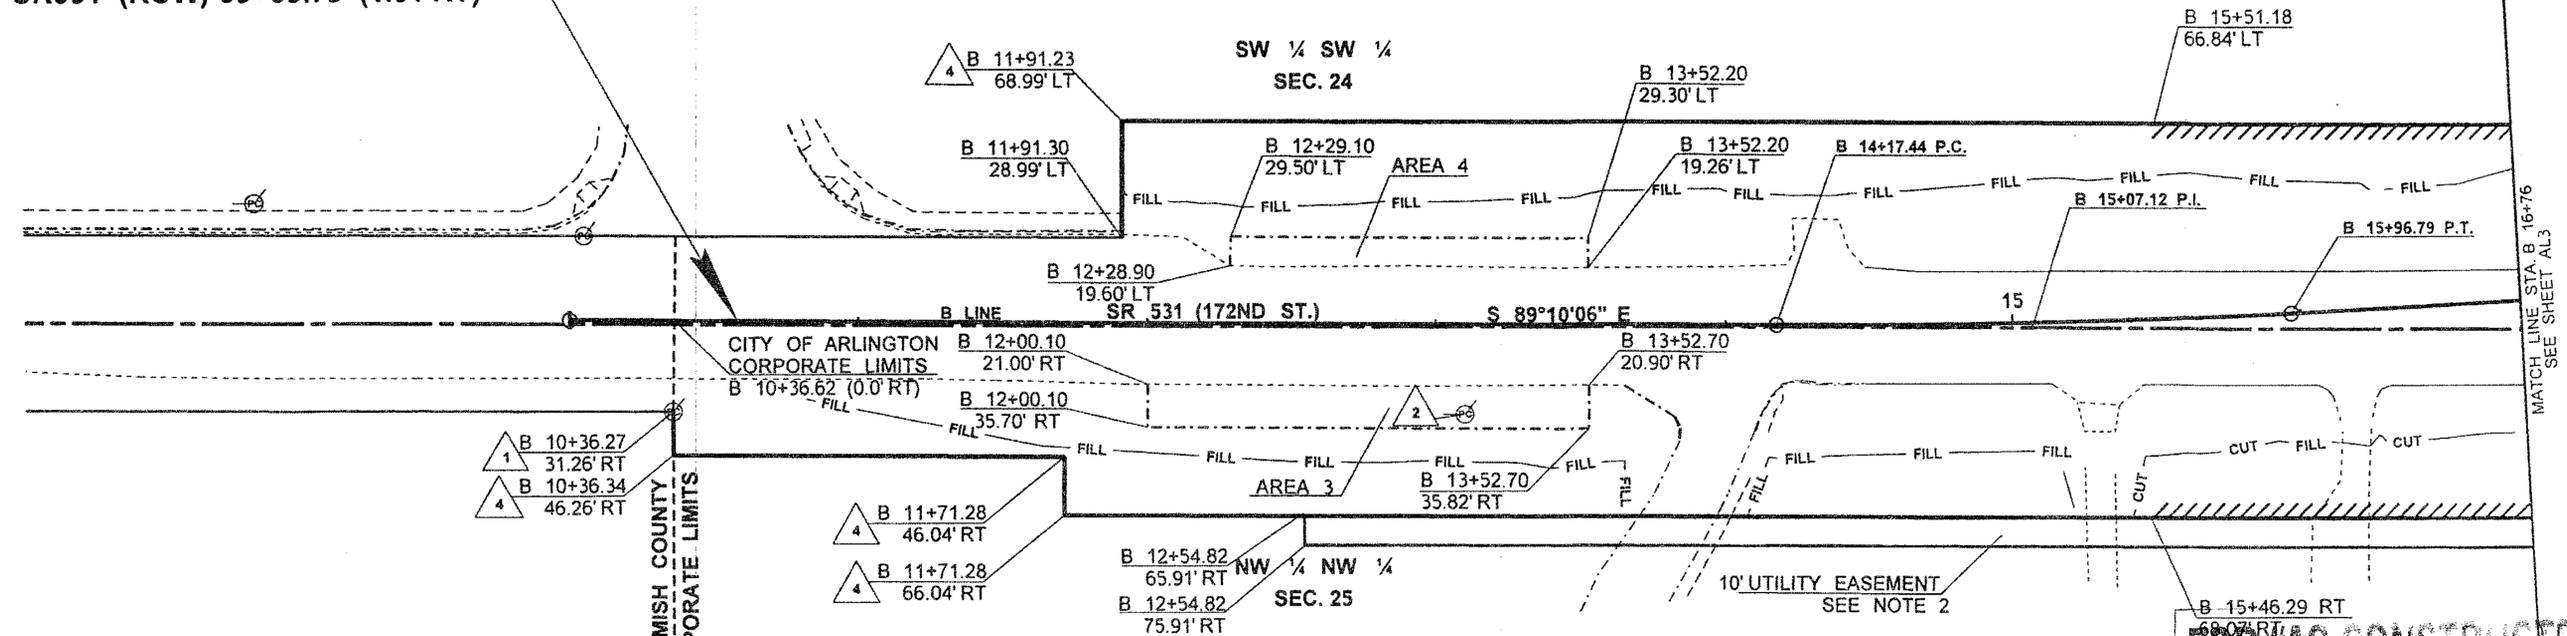


**FOR AS CONSTRUCTED
 PLANS ONLY**

LEGEND	
— — — — —	EXISTING EDGE LINE
- - - - -	EXISTING EDGE OF PAVEMENT
- - - - -	EXISTING EDGE OF SHOULDER
- - - - -	EXISTING CURB
- - - - -	UNSUITABLE FOUNDATION EXCAVATION LIMITS
- CUT	CUT LINE
- FILL	FILL LINE
⊙	PROPERTY CORNER
△	SURVEY CONTROL POINT
- - - - -	CORPORATE LIMITS
- - - - -	SIXTEENTH SECTION LINE
- - - - -	SECTION LINE
- - - - -	WSDOT R/W
- - - - -	WSDOT LIMITED ACCESS
30 29	SECTION CORNER FOUND
31 32	SURVEY MONUMENT

- CONSTRUCTION NOTES:**
- 1 TO BE PROTECTED
 - 2 TO BE ABANDONED
 - 3 TO BE ADJUSTED
 - 4 TO BE INSTALLED BY OTHERS AND PROTECTED

- GENERAL NOTES:**
1. IN ACCORDANCE WITH RCW 58.09-130, ANY MONUMENT OR CORNER NOT SCHEDULED FOR REMOVAL, ABANDONMENT, OR ADJUSTMENT THAT IS DISTURBED BY THE CONTRACTORS SHALL BE REPLACED AT NO COST TO THE CONTRACTING AGENCY.
 2. A UTILITY EASEMENT HAS BEEN ACQUIRED BY THE CITY OF ARLINGTON AND RIGHTS HAVE BEEN ASSIGNED TO WSDOT FOR THE CONSTRUCTION OF SANITARY SEWER FACILITIES.
 3. FOR ABANDONING OR ADJUSTING MONUMENT CASE AND COVERS AND PROPERTY CORNERS SEE SPECIAL PROVISION ABANDON OR ADJUST MONUMENT CASE AND COVERS AND PROPERTY CORNERS.

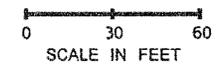


FILE NAME	I:\Projects\XL3325 SR9 SR531 172nd St NE Int\CAD\PS&ESheets\XL3325 PS AL RW.dgn	REGION NO.	10	STATE	WASH	FED.AID PROJ.NO.				SR 9 SR 531/172ND ST NE & EAGLEFIELD DR INTERSECTION IMPROVEMENT & PAVING ALIGNMENT/RIGHT OF WAY	Plot 5	
TIME	9:03:46 AM	JOB NUMBER	10A042	CONTRACT NO.		LOCATION NO.					PLAN REF NO.	AL5
DATE	9/27/2011	DESIGNED BY	M. GUNN	CHECKED BY	J. KORESKI	PROJ. ENGR.	S. SPAHR	REGIONAL ADM.	L. ENG	REVISION	DATE	BY

T. 31N. R. 5E. W.M.

CURVE DATA				
P.I. STATION	DELTA	RADIUS	TANGENT	LENGTH
B 22+59.95	2° 06' 08.64"	3745.00'	68.72'	137.42'
				S
				N/A



(NAD) 83/91

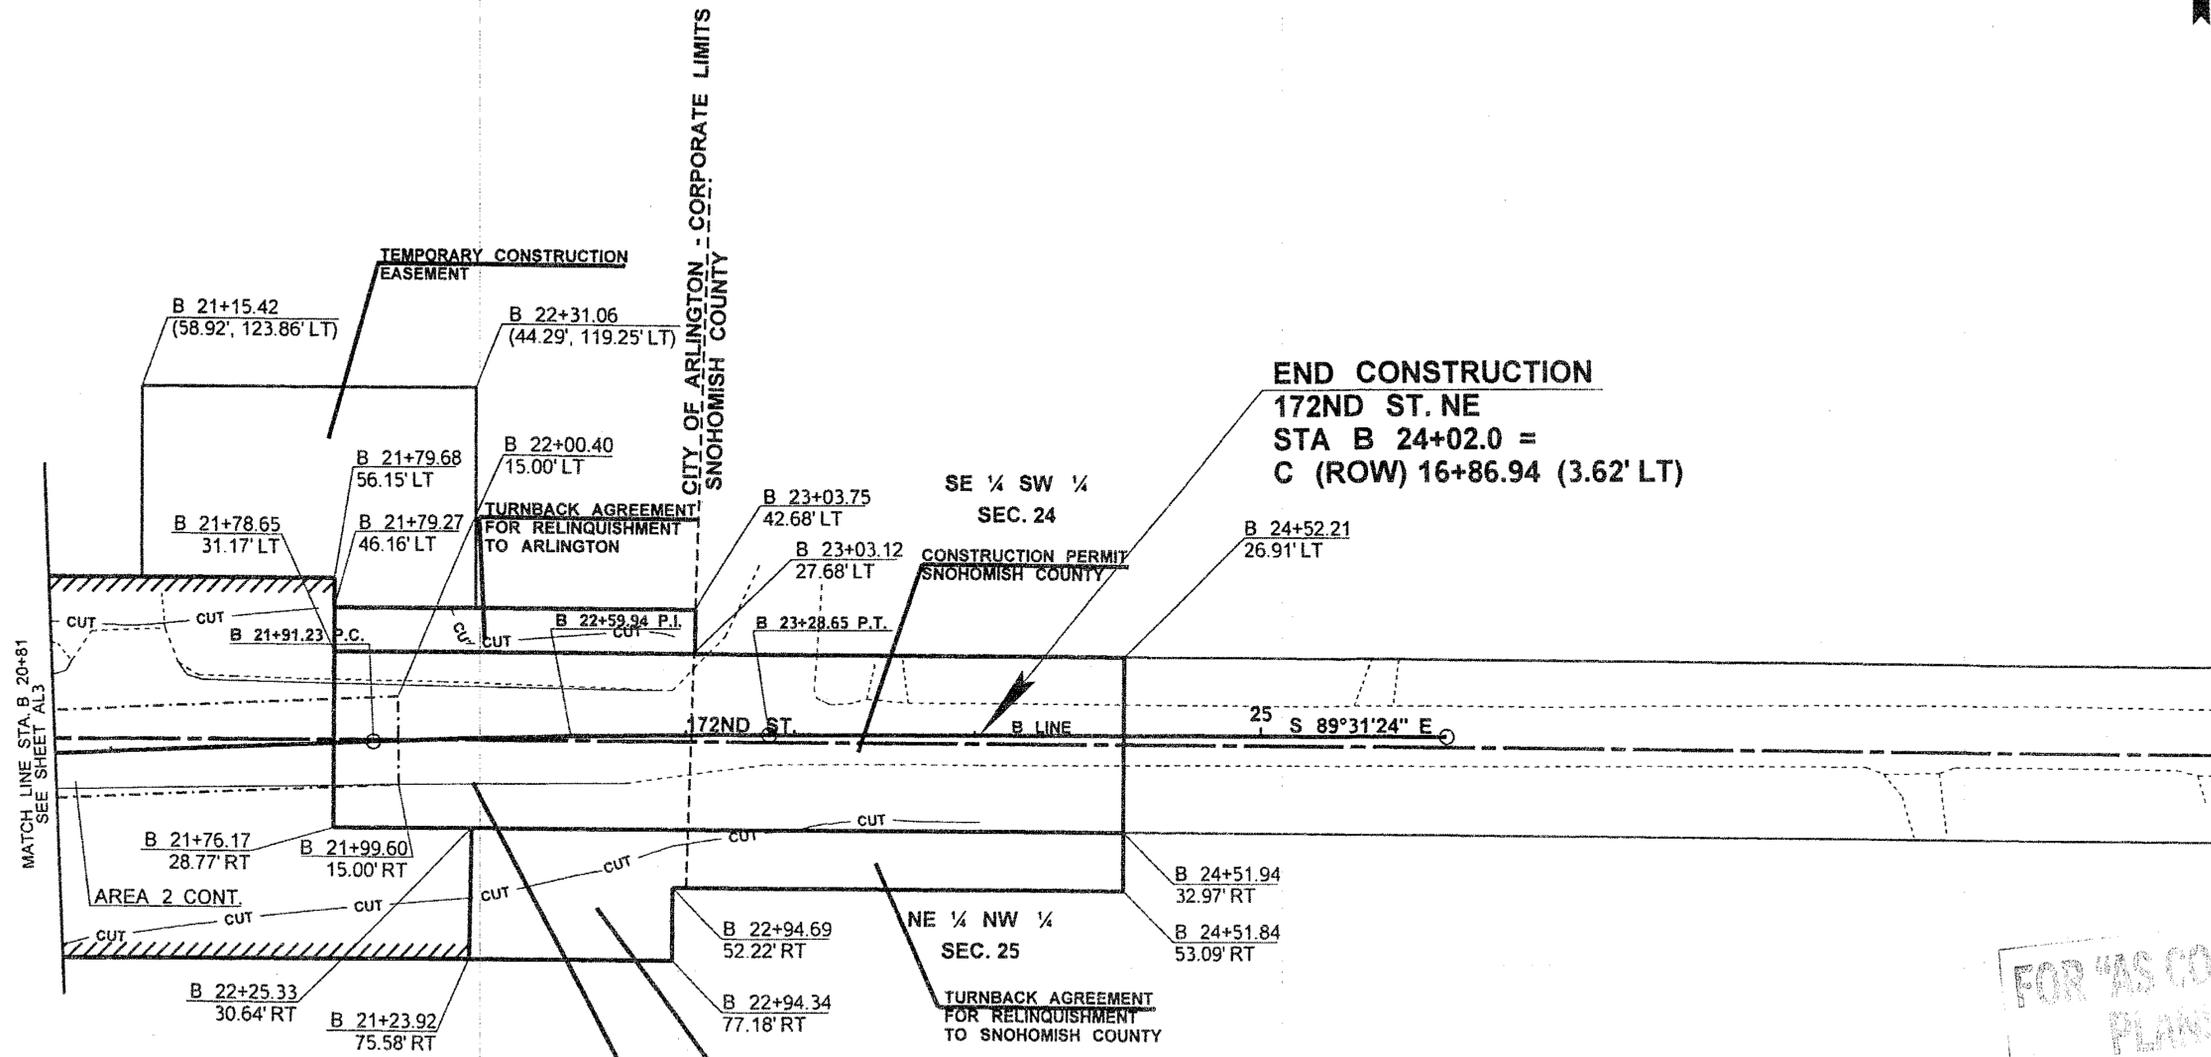


FOR "AS CONSTRUCTED" PLANS

LEGEND	
— — — — —	EXISTING EDGE LINE
- - - - -	EXISTING EDGE OF PAVEMENT
- - - - -	EXISTING EDGE OF SHOULDER
- - - - -	EXISTING CURB
- - - - -	UNSUITABLE FOUNDATION EXCAVATION LIMITS
- CUT	CUT LINE
- FILL	FILL LINE
⊙	PROPERTY CORNER
△	SURVEY CONTROL POINT
- - - - -	CORPORATE LIMITS
- - - - -	SIXTEENTH SECTION LINE
- - - - -	SECTION LINE
- - - - -	WSDOT R/W
	WSDOT LIMITED ACCESS
30 29	SECTION CORNER FOUND
31 32	SURVEY MONUMENT


- CONSTRUCTION NOTES:
- 1 TO BE PROTECTED
 - 2 TO BE ABANDONED
 - 3 TO BE ADJUSTED
 - 4 TO BE INSTALLED BY OTHERS AND PROTECTED

- GENERAL NOTES:
- IN ACCORDANCE WITH RCW 58.09-130, ANY MONUMENT OR CORNER NOT SCHEDULED FOR REMOVAL, ABANDONMENT, OR ADJUSTMENT THAT IS DISTURBED BY THE CONTRACTORS SHALL BE REPLACED AT NO COST TO THE CONTRACTING AGENCY.
 - A UTILITY EASEMENT HAS BEEN ACQUIRED BY THE CITY OF ARLINGTON AND RIGHTS HAVE BEEN ASSIGNED TO WSDOT FOR THE CONSTRUCTION OF SANITARY SEWER FACILITIES.
 - FOR ABANDONING OR ADJUSTING MONUMENT CASE AND COVERS AND PROPERTY CORNERS SEE SPECIAL PROVISION ABANDON OR ADJUST MONUMENT CASE AND COVERS AND PROPERTY CORNERS.

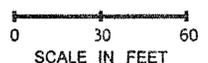

FILE NAME	I:\Projects\XL3325_SR9_SR531_172nd_St_NE_Int\CAD\PS&ESheets\XL3325_PS_AL_RW.dgn	REGION NO.	STATE	FED.AID PROJ.NO.			SR 9 SR 531/172ND ST NE & EAGLEFIELD DR INTERSECTION IMPROVEMENT & PAVING ALIGNMENT/RIGHT OF WAY	Plot 6 PLAN REF NO AL6 SHEET 26 OF 230 SHEETS
TIME	9:46:57 AM	10	WASH					
DATE	9/27/2011							
PLOTTED BY	lamaymp							
DESIGNED BY	M.GUNN							
ENTERED BY	K.SOLWOLD							
CHECKED BY	J.KORESKI							
PROJ. ENGR.	S.SPAHR							
REGIONAL ADM.	L.ENG							


T. 31N. R. 5E. W.M.

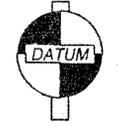

(NAD) 8391

LEGEND	
— — — — —	EXISTING EDGE LINE
- - - - -	EXISTING EDGE OF PAVEMENT
- - - - -	EXISTING EDGE OF SHOULDER
- - - - -	EXISTING CURB
- - - - -	UNSUITABLE FOUNDATION EXCAVATION LIMITS
- CUT —	CUT LINE
- FILL —	FILL LINE
⊙	PROPERTY CORNER
△	SURVEY CONTROL POINT
- - - - -	CORPORATE LIMITS
- - - - -	SIXTEENTH SECTION LINE
- - - - -	SECTION LINE
=====	WSDOT RW
///////	WSDOT LIMITED ACCESS
30 29 31 32	SECTION CORNER FOUND
○	SURVEY MONUMENT

END EXCEPTION
 SR 9
 MP 26.83
 STA A 851+45.0=
 SR9 (ROW) 851+19.4 (0.0' RT)

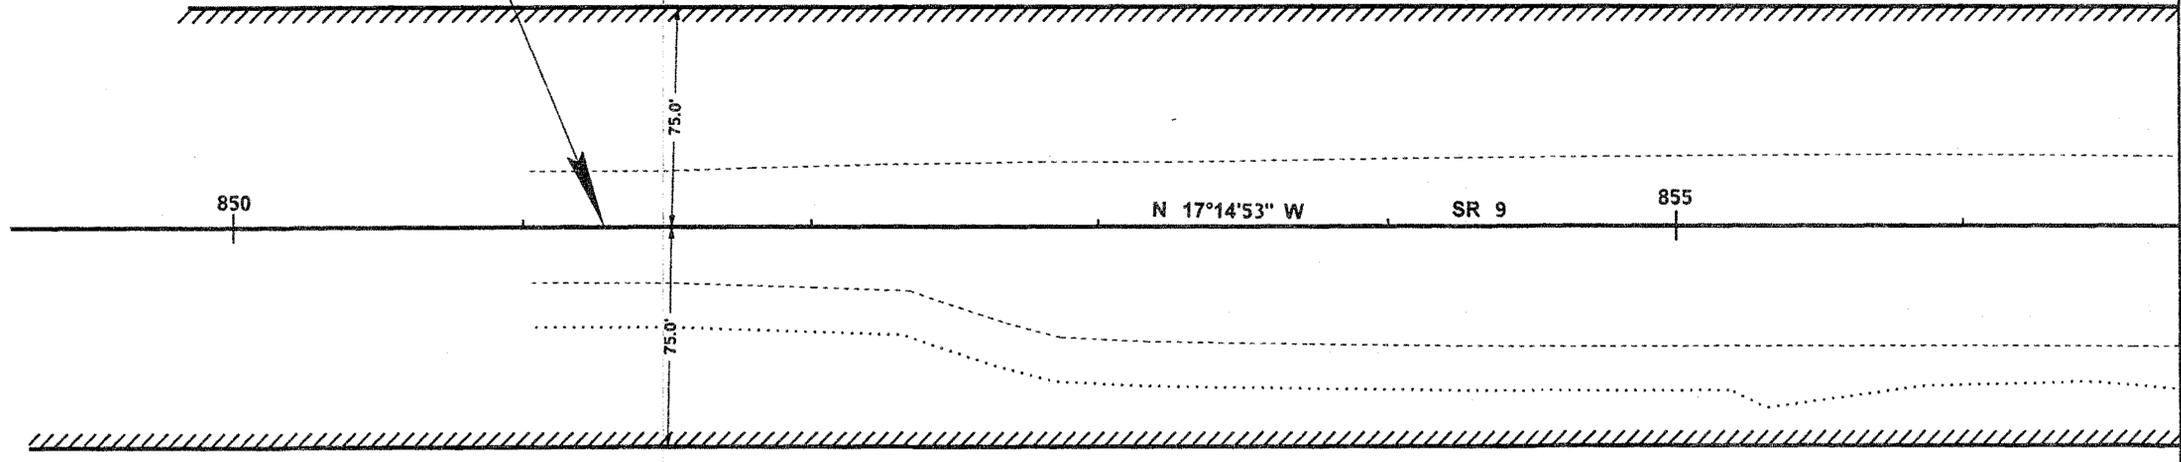


GENERAL NOTES:

1. IN ACCORDANCE WITH RCW 58.09-130, ANY MONUMENT OR CORNER NOT SCHEDULED FOR REMOVAL, ABANDONMENT, OR ADJUSTMENT THAT IS DISTURBED BY THE CONTRACTORS SHALL BE REPLACED AT NO COST TO THE CONTRACTING AGENCY.
2. A UTILITY EASEMENT HAS BEEN ACQUIRED BY THE CITY OF ARLINGTON AND RIGHTS HAVE BEEN ASSIGNED TO WSDOT FOR THE CONSTRUCTION OF SANITARY SEWER FACILITIES.
3. FOR ABANDONING OR ADJUSTING MONUMENT CASE AND COVERS AND PROPERTY CORNERS SEE SPECIAL PROVISION ABANDON OR ADJUST MONUMENT CASE AND COVERS AND PROPERTY CORNERS.

CONSTRUCTION NOTES:

- 1 TO BE PROTECTED
- 2 TO BE ABANDONED
- 3 TO BE ADJUSTED
- 4 TO BE INSTALLED BY OTHERS AND PROTECTED

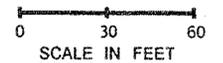

FOR "AS CONSTRUCTED
 PLANS" ONLY


FILE NAME	I:\Projects\XL3325 SR9 SR531 172nd St NE Int\CAD\IPS&ESheets\XL3325 PS AL RW.dgn			REGION NO.	STATE	FED.AID PROJ.NO.			SR 9 SR 531/172ND ST NE & EAGLEFIELD DR INTERSECTION IMPROVEMENT & PAVING ALIGNMENT / RIGHT OF WAY	Plot 11
TIME	11:11:25 AM			10	WASH					AL7
DATE	9/27/2011			JOB NUMBER	10A042	LOCATION NO.			SHEET 27 OF 230 SHEETS	
PLOTTED BY	lamaymp			CONTRACT NO.						
DESIGNED BY	M. LAMAY									
ENTERED BY	K. SOLWOLD									
CHECKED BY	J. KORESKE									
PROJ. ENGR.	S. SPAHR									
REGIONAL ADM.	L. ENG	REVISION	DATE	BY						

T. 31N. R. 5E. W.M.



(NAD) 83/91

LEGEND	
— — — — —	EXISTING EDGE LINE
- - - - -	EXISTING EDGE OF PAVEMENT
- - - - -	EXISTING EDGE OF SHOULDER
- - - - -	EXISTING CURB
- - - - -	UNSUITABLE FOUNDATION EXCAVATION LIMITS
- - - - -	CUT LINE
- - - - -	FILL LINE
○	PROPERTY CORNER
△	SURVEY CONTROL POINT
- - - - -	CORPORATE LIMITS
- - - - -	SIXTEENTH SECTION LINE
- - - - -	SECTION LINE
- - - - -	WSDOT R/W
	WSDOT LIMITED ACCESS
30 29 31 32	SECTION CORNER FOUND
○	SURVEY MONUMENT

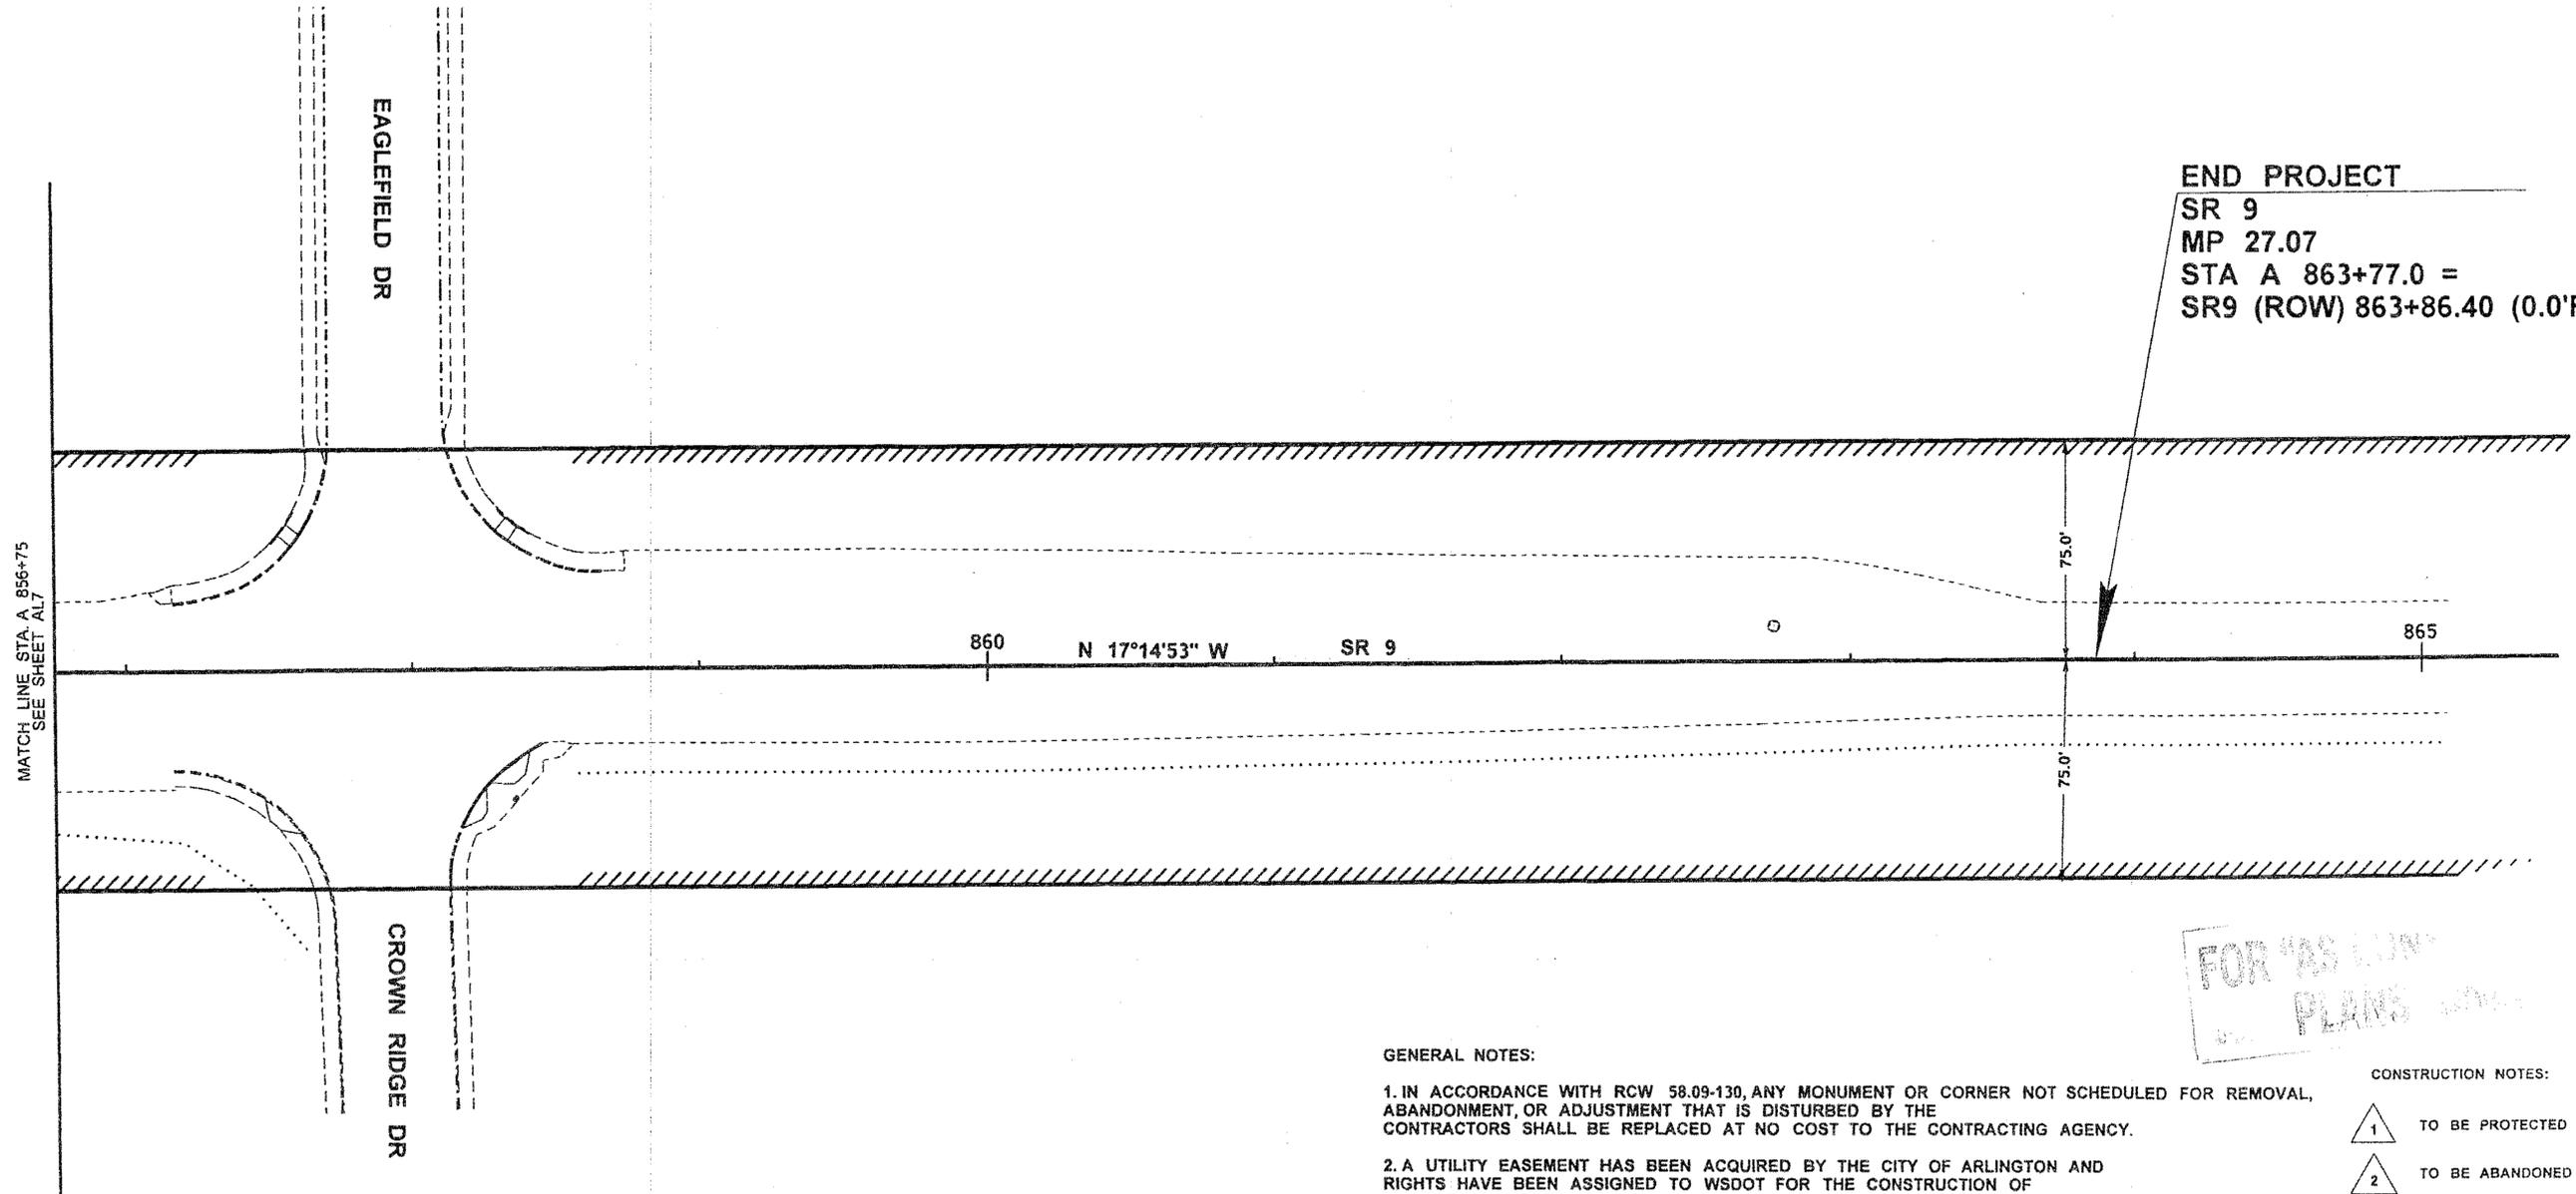


GENERAL NOTES:

1. IN ACCORDANCE WITH RCW 58.09-130, ANY MONUMENT OR CORNER NOT SCHEDULED FOR REMOVAL, ABANDONMENT, OR ADJUSTMENT THAT IS DISTURBED BY THE CONTRACTORS SHALL BE REPLACED AT NO COST TO THE CONTRACTING AGENCY.
2. A UTILITY EASEMENT HAS BEEN ACQUIRED BY THE CITY OF ARLINGTON AND RIGHTS HAVE BEEN ASSIGNED TO WSDOT FOR THE CONSTRUCTION OF SANITARY SEWER FACILITIES.
3. FOR ABANDONING OR ADJUSTING MONUMENT CASE AND COVERS AND PROPERTY CORNERS SEE SPECIAL PROVISION ABANDON OR ADJUST MONUMENT CASE AND COVERS AND PROPERTY CORNERS.

CONSTRUCTION NOTES:

- 1 TO BE PROTECTED
- 2 TO BE ABANDONED
- 3 TO BE ADJUSTED
- 4 TO BE INSTALLED BY OTHERS AND PROTECTED

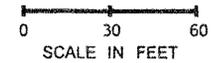

FILE NAME	I:\Projects\XL3325 SR9 SR531 172nd St NE int\CAD\PS&ESheets\XL3325 PS_AL_RW.dgn			REGION NO.	STATE	FED.AID PROJ.NO.			SR 9 SR 531/172ND ST NE & EAGLEFIELD DR INTERSECTION IMPROVEMENT & PAVING ALIGNMENT / RIGHT OF WAY	Plot 12
TIME	1:08:52 PM			10	WASH					PLAN REF NO AL8
DATE	9/27/2011			JOB NUMBER	10A042	LOCATION NO.				SHEET 28
PLOTTED BY	lamaymp			CONTRACT NO.						OF 230 SHEETS
DESIGNED BY	M. LAMAY									
ENTERED BY	K. SOLWOLD									
CHECKED BY	J. KORESKE									
PROJ. ENGR.	S. SPAHR									
REGIONAL ADM.	L. ENG	REVISION	DATE	BY						


QUANTITY TABULATION - SITE PREPARATION

NOTE: THE FIRST NUMBER OF THE "CODE" BELOW REFERS TO THE SHEET NO. OR THE SHEET REFERENCE NO. SHOWING THE CONSTRUCTION FEATURE. THE SECOND NUMBER REFERS TO THE CONSTRUCTION FEATURE FOUND ON THAT SHEET.		REMOVING PAINT LINE*	REMOVING PLASTIC LINE	REMOVING PLASTIC TRAFFIC MARKING	REMOVING PAINTED CROSSWALK LINE	REMOVING PLASTIC CROSSWALK LINE	REMOVING WIRE FENCE	REMOVING CATCH BASIN	REMOVING STORM SEWER PIPE	SEE GENERAL NOTES	GENERAL NOTES:
CODE	LOCATION < \ UNIT OF MEASURE >	L.F.	L.F.	EACH	S.F.	S.F.	L.F.	EACH	L.F.		
SP1	A 795+77 TO A 819+60	7540		4	330						3
SP1	B 10+00 TO B 24+00	4200		4	660						3
SP2-1	A 799+67 (75' RT) TO A 806+70 (75.8' RT)						710				2
SP3-1	B 18+16.1 (23.4' RT) TO B 19+36.2 (25.0' RT)								121		2
SP3-2	B 18+15 (23' RT)							1			1
SP3-3	B 18+15 (24' RT) TO A 809+32.2 (46.5' LT)								57		2
SP3-4	B 18+10 (19' LT)							1			1
SP3-5	A 809+14.2 (50' RT) TO B 19+37.2 (26.5' RT)								53		2
SP3-6	B 19+38 (25' RT)							1			1
SP3-7	B 19+38.9 (25.1' RT) TO B 21+29.3 (12.4' RT)								193		2
SP3-8	B 20+47 (22' RT) TO B 24+00 (21' RT)						360				2
SP3-9	B 19+35.2 (31.3' LT) TO B 21+31.6 (22.4' LT)								193		2
SP3-10	B 19+34.0 (31.0' RT)							1			1
SP3-11	A 811+23.0 (38.8' RT)							1			1
SP3-12	A 812+98.0 (40.2' RT)							1			1
SP3-13	A 810+98 (79' LT) TO A 819+57 (74' LT)						860				2
SP3-14	A 811+23.8 (39.0' RT) TO A 812+97.2 (39.9' RT)								175		2
SP3-15	A 810+23.76 (61.2' RT) TO A 811+22.33 (39.2' RT)								105		2
SP5-1	B 12+88 (30' LT) TO B 13+97 (30' LT)						110				2
SP5-2	B 14+60 (18' LT)							1			1
SP5-3	B 14+62 (30' LT) TO B 17+45 (22' LT)						290				2
SP5-4	B 16+41 (12' LT)							1			1
SP5-5	B 13+53.6 (26.3' RT) TO B 14+25.9 (17.6' RT)								75		2
SP5-6	B 14+27 (26' RT)							1			1
SP5-7	B 14+28.1 (17.8' RT) TO B 16+37.0 (25.1' RT)								210		2
SP5-8	B 16+38 (26' RT)							1			1
SP6-1	B 21+33 (22' LT)							1			1
SP6-2	B 21+33 (22' LT) TO B 22+91.4 (23.3' LT)								158		2
SP6-3	B 22+91.4 (23.3' LT)							1			1
SP6-4	B 22+91.4 (23.3' LT) TO B 23+45 (16' LT)								55		2
SP6-5	B 21+31 (12' RT)							1			1
SP6-6	B 21+31 (12' RT) TO B 22+96.7 (18.7' RT)								165		2
SP7	A 852+34.1 TO A 857+16.3	210	3580	12		740					3
SHEET TOTAL		11950	3580	20	990	740	2330	13	1560		
PROJECT TOTAL		11950	3580	20	990	740	2330	13	1560		

FOR 'AS PLANS


*SEE SHEET QTPM1-QTPM10 FOR ADDITIONAL QUANTITIES.

1. PLUG REMAINING CONNECTIONS AFTER REMOVAL IN ACCORDANCE WITH SECTION 2-02 OF THE SPECIAL PROVISION REMOVAL OF STRUCTURES AND OBSTRUCTIONS.
2. REFER TO THE SPECIAL PROVISION REMOVAL OF STRUCTURES AND OBSTRUCTIONS FOR REMOVAL REQUIREMENTS.
3. REMOVAL OF PAVEMENT MARKINGS SHALL BE COORDINATED WITH THE APPROPRIATE CONSTRUCTION PHASE.

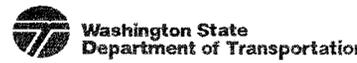DESIGNED BY	M. LAMAY	ENTERED BY	M. MCREYNOLDS	CHECKED BY	J. KORESKI	PROJ. ENGR.	S. SPAHR	REGION ADM.	L. ENG	DATE	DATE	REVISION	BY	REGION NO.	STATE	FED. AID PROJ. NO.		SR 9 SR 531/172ND ST NE & EAGLEFIELD DR. INTERSECTION IMPROVEMENT & PAVING	QTSP 1 SHEET 29 OF 230 SHEETS		
														JOB NUMBER 10A042		CONTRACT NO.		QUANTITY TABULATION - SITE PREPARATION			

CONSTRUCTION NOTE		LEGEND	
	PART OF LUMP SUM ITEM "REMOVAL OF STRUCTURE AND OBSTRUCTION"		PAVEMENT REMOVAL
	QUANTITY TABULATION NOTE		EXISTING CATCH BASIN
	EXISTING FENCE		EXISTING STORM SEWER
	EXISTING LANE LINE		EXISTING CULVERT
	EXISTING STOP BAR		WETLAND BOUNDARY
	EXISTING PAVED EDGE		WETLAND BUFFER
	EXISTING GUIDE POST		WETLAND SYMBOL
	EXISTING SIGN		STREAM BUFFER
	SAW CUT		EXISTING DITCH
	CLEAR AND GRUB LIMITS		EXISTING MAILBOX
	CUT LINE		EXISTING VEGETATION TO SAVE AND PROTECT
	FILL LINE		ORDINARY HIGH WATER MARK
	WSDOT R/W		
	WSDOT LIMITED ACCESS		

T. 31N. R. 5E. W.M.

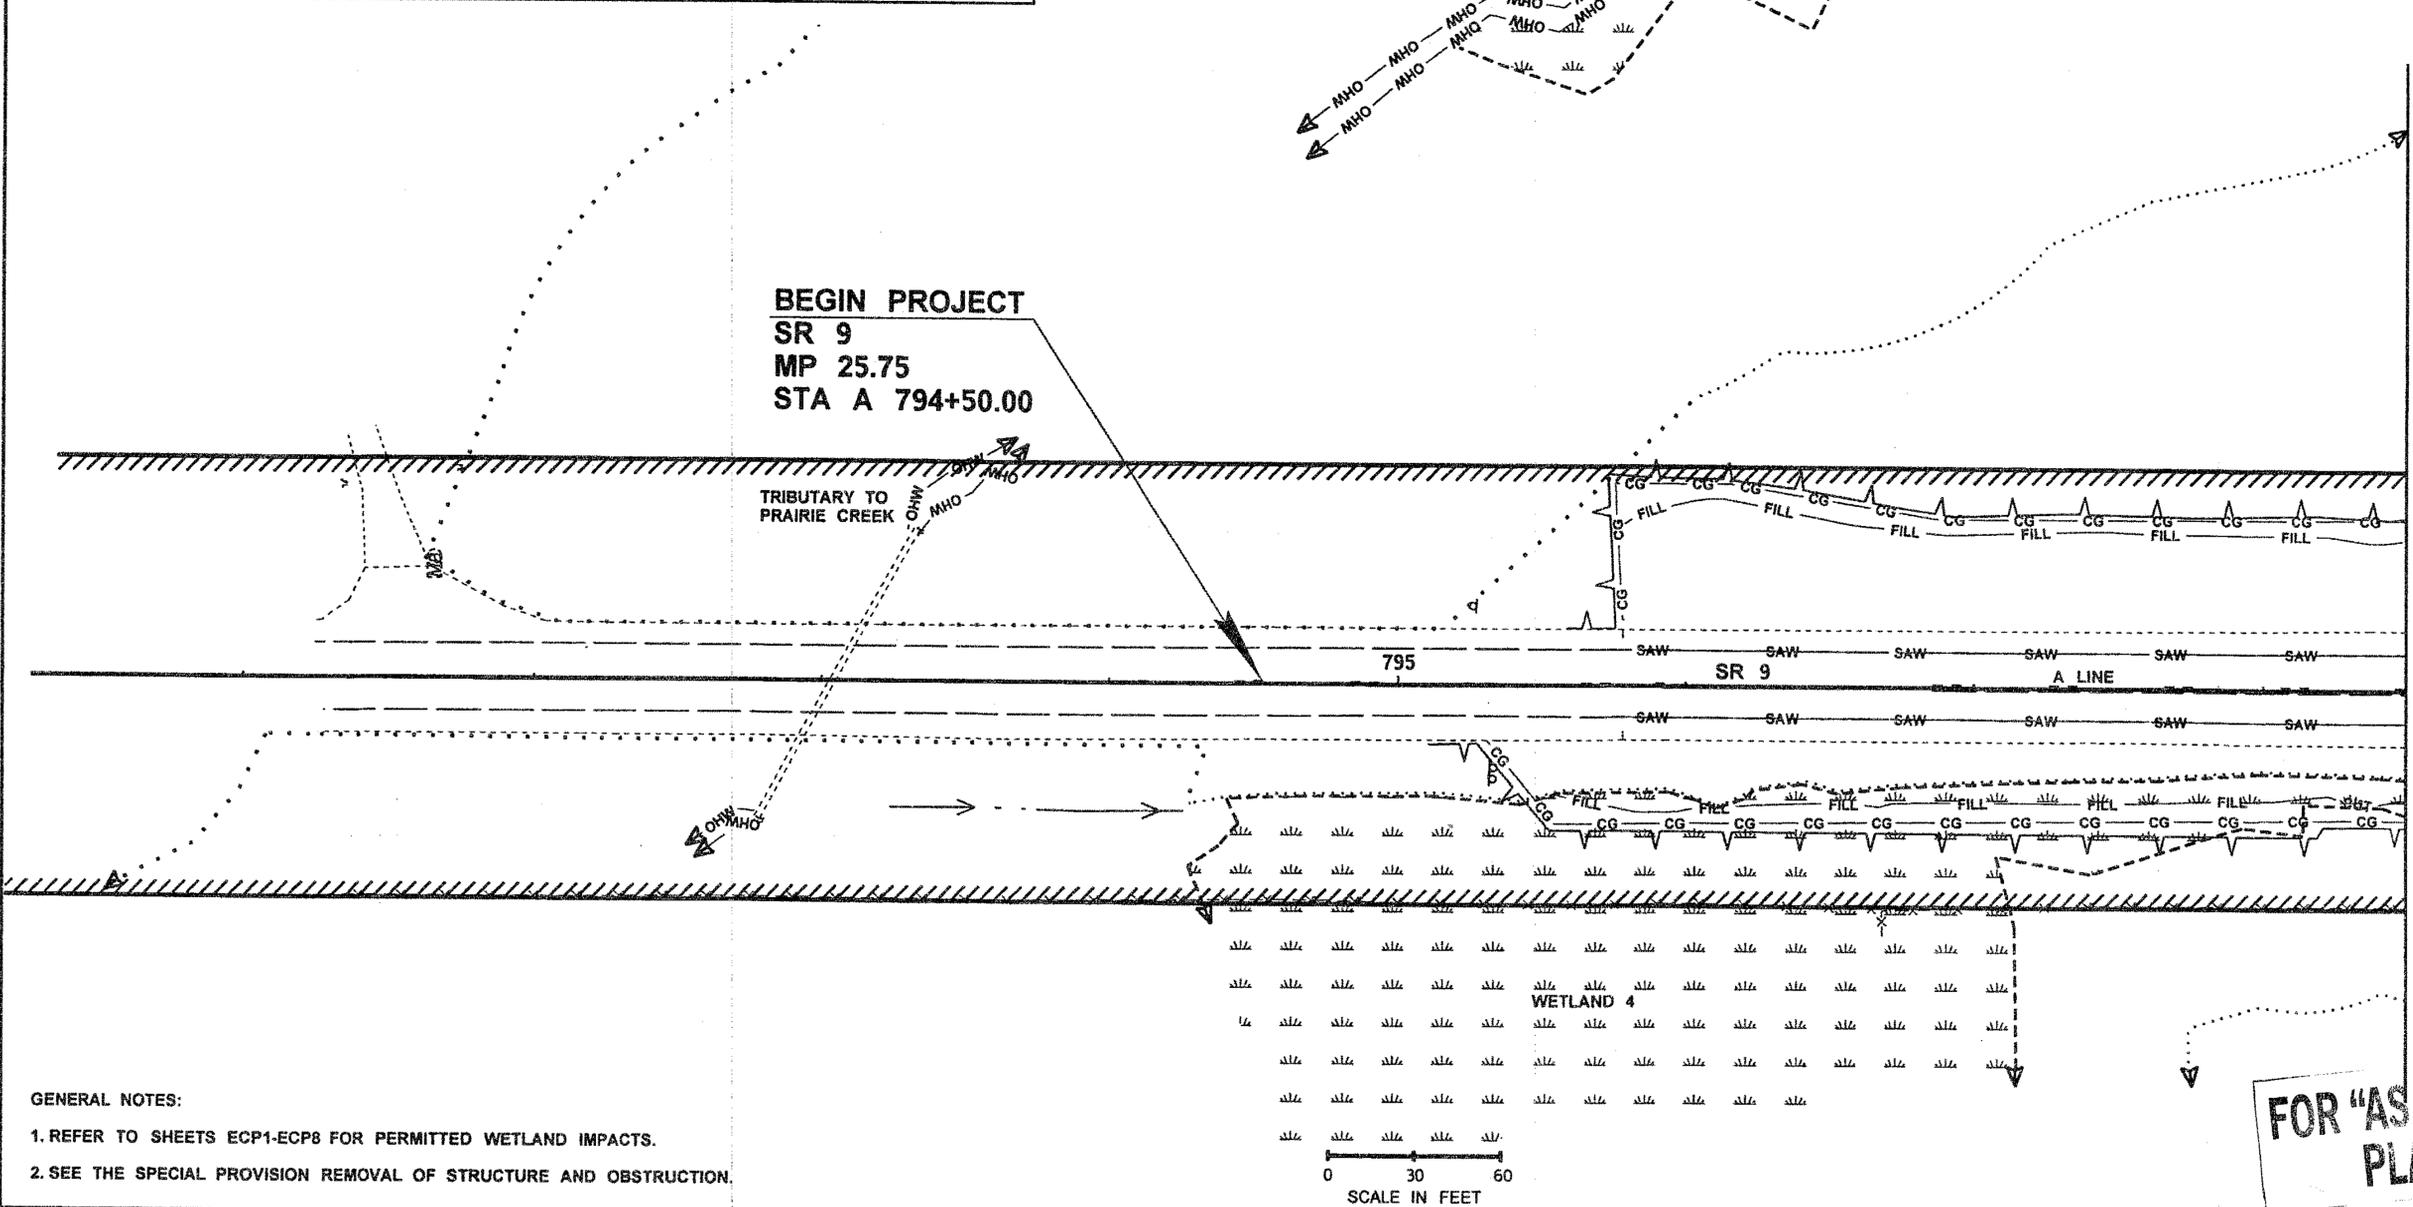

BEGIN PROJECT
SR 9
MP 25.75
STA A 794+50.00

- GENERAL NOTES:
- REFER TO SHEETS ECP1-ECP8 FOR PERMITTED WETLAND IMPACTS.
 - SEE THE SPECIAL PROVISION REMOVAL OF STRUCTURE AND OBSTRUCTION.


FOR "AS CONSTRUCTED
PLANS" ONLY

FILE NAME: I:\Projects\XL3325 SR9 SR531 172nd St NE Int\CAD\PS&ESheets\XL3325 PS SITE PREP.dgn		REGION NO. STATE		FED.AID PROJ.NO.		Washington State Department of Transportation		SR 9 SR 531/172ND ST NE & EAGLEFIELD DR INTERSECTION IMPROVEMENT & PAVING		Plot 1 PLAN REF NO SP1	
TIME: 9:45:24 AM	DATE: 9/22/2011	10	WASH			P.E. STAMP BOX		DATE: 9/22/11		SHEET 30 OF 230 SHEETS	
PLOTTED BY: solwalk	DESIGNED BY: M. GUNN	JOB NUMBER: 10A042		LOCATION NO.		P.E. STAMP BOX		DATE:		SITE PREPARATION PLAN	
ENTERED BY: K.SOLWOLD	CHECKED BY: J.KOESKI	CONTRACT NO.									
PROJ. ENGR: S.SPAHR	REGIONAL ADM: L. ENG	REVISION	DATE	BY							


T. 31N. R. 5E. W.M.



LEGEND	
	CONSTRUCTION NOTE
	PART OF LUMP SUM ITEM "REMOVAL OF STRUCTURE AND OBSTRUCTION"
	QUANTITY TABULATION NOTE
	EXISTING FENCE
	EXISTING LANE LINE
	EXISTING STOP BAR
	EXISTING PAVED EDGE
	EXISTING GUIDE POST
	EXISTING SIGN
	SAW CUT
	CLEAR AND GRUB LIMITS
	CUT LINE
	FILL LINE
	WSDOT R/W
	WSDOT LIMITED ACCESS
	PAVEMENT REMOVAL
	EXISTING CATCH BASIN
	EXISTING STORM SEWER
	EXISTING CULVERT
	WETLAND BOUNDARY
	WETLAND BUFFER
	WETLAND SYMBOL
	STREAM BUFFER
	EXISTING DITCH
	EXISTING MAILBOX
	EXISTING VEGETATION TO SAVE AND PROTECT
	ORDINARY HIGH WATER MARK

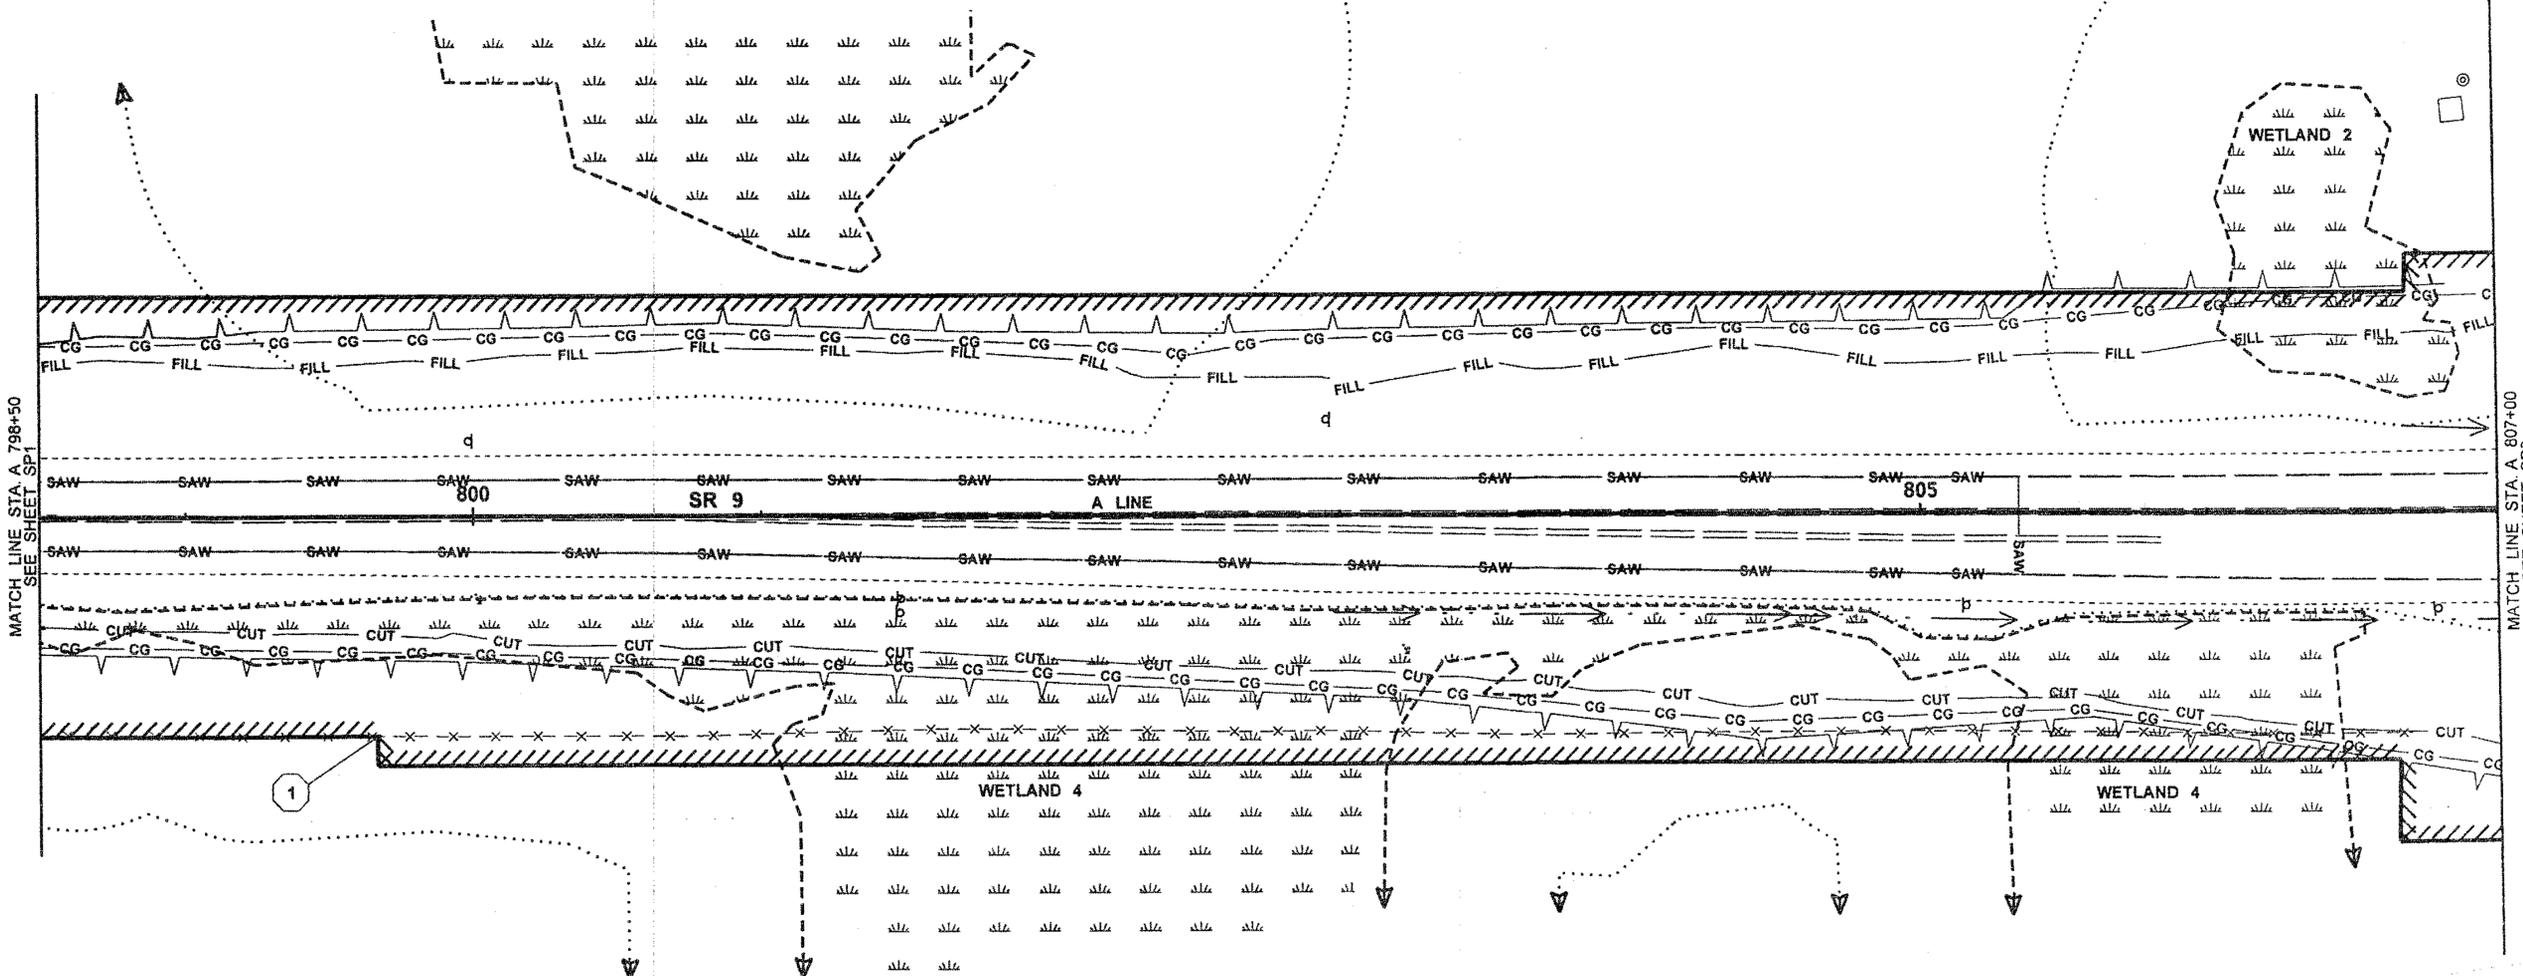

GENERAL NOTES:
 1. REFER TO SHEETS ECP1-ECP8 FOR PERMITTED WETLAND IMPACTS.
 2. SEE THE SPECIAL PROVISION REMOVAL OF STRUCTURE AND OBSTRUCTION.

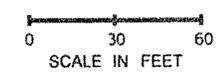


FOR "AS CONSTRUCTED" PLANS ONLY

FILE NAME	I:\Projects\XL3325 SR9 SR531 172nd St NE Int\CAD\PS&ESheets\XL3325 PS SITE PREP.dgn			REGION NO.	STATE	FED.AID PROJ.NO.			SR 9 SR 531/172ND ST NE & EAGLEFIELD DR INTERSECTION IMPROVEMENT & PAVING SITE PREPARATION PLAN	Plot 2	
TIME	9:45:25 AM			10	WASH					PLAN REF NO	SP2
DATE	9/22/2011			JOB NUMBER						SHEET	31
PLOTTED BY	solwolk			CONTRACT NO.		LOCATION NO.				OF	230
DESIGNED BY	M. GUNN						DATE		SHEETS	230	
ENTERED BY	K.SOLWOLD										
CHECKED BY	J. KORESKI										
PROJ. ENGR.	S.SPAHR										
REGIONAL ADM.	L. ENG										

T. 31N. R. 5E. W.M.


- △ ABANDON STORM SEWER PIPE IN PLACE.
- △ RELOCATE MAILBOX SUPPORT IN ACCORDANCE WITH SECTION 8-10.
- 1 REMOVAL OF WOOD FENCE.
- 2 REMOVAL OF CHAIN LINK FENCE.
- 3 REMOVAL OF RETAINING WALL.
- 4 SIGN TO BE REMOVED.

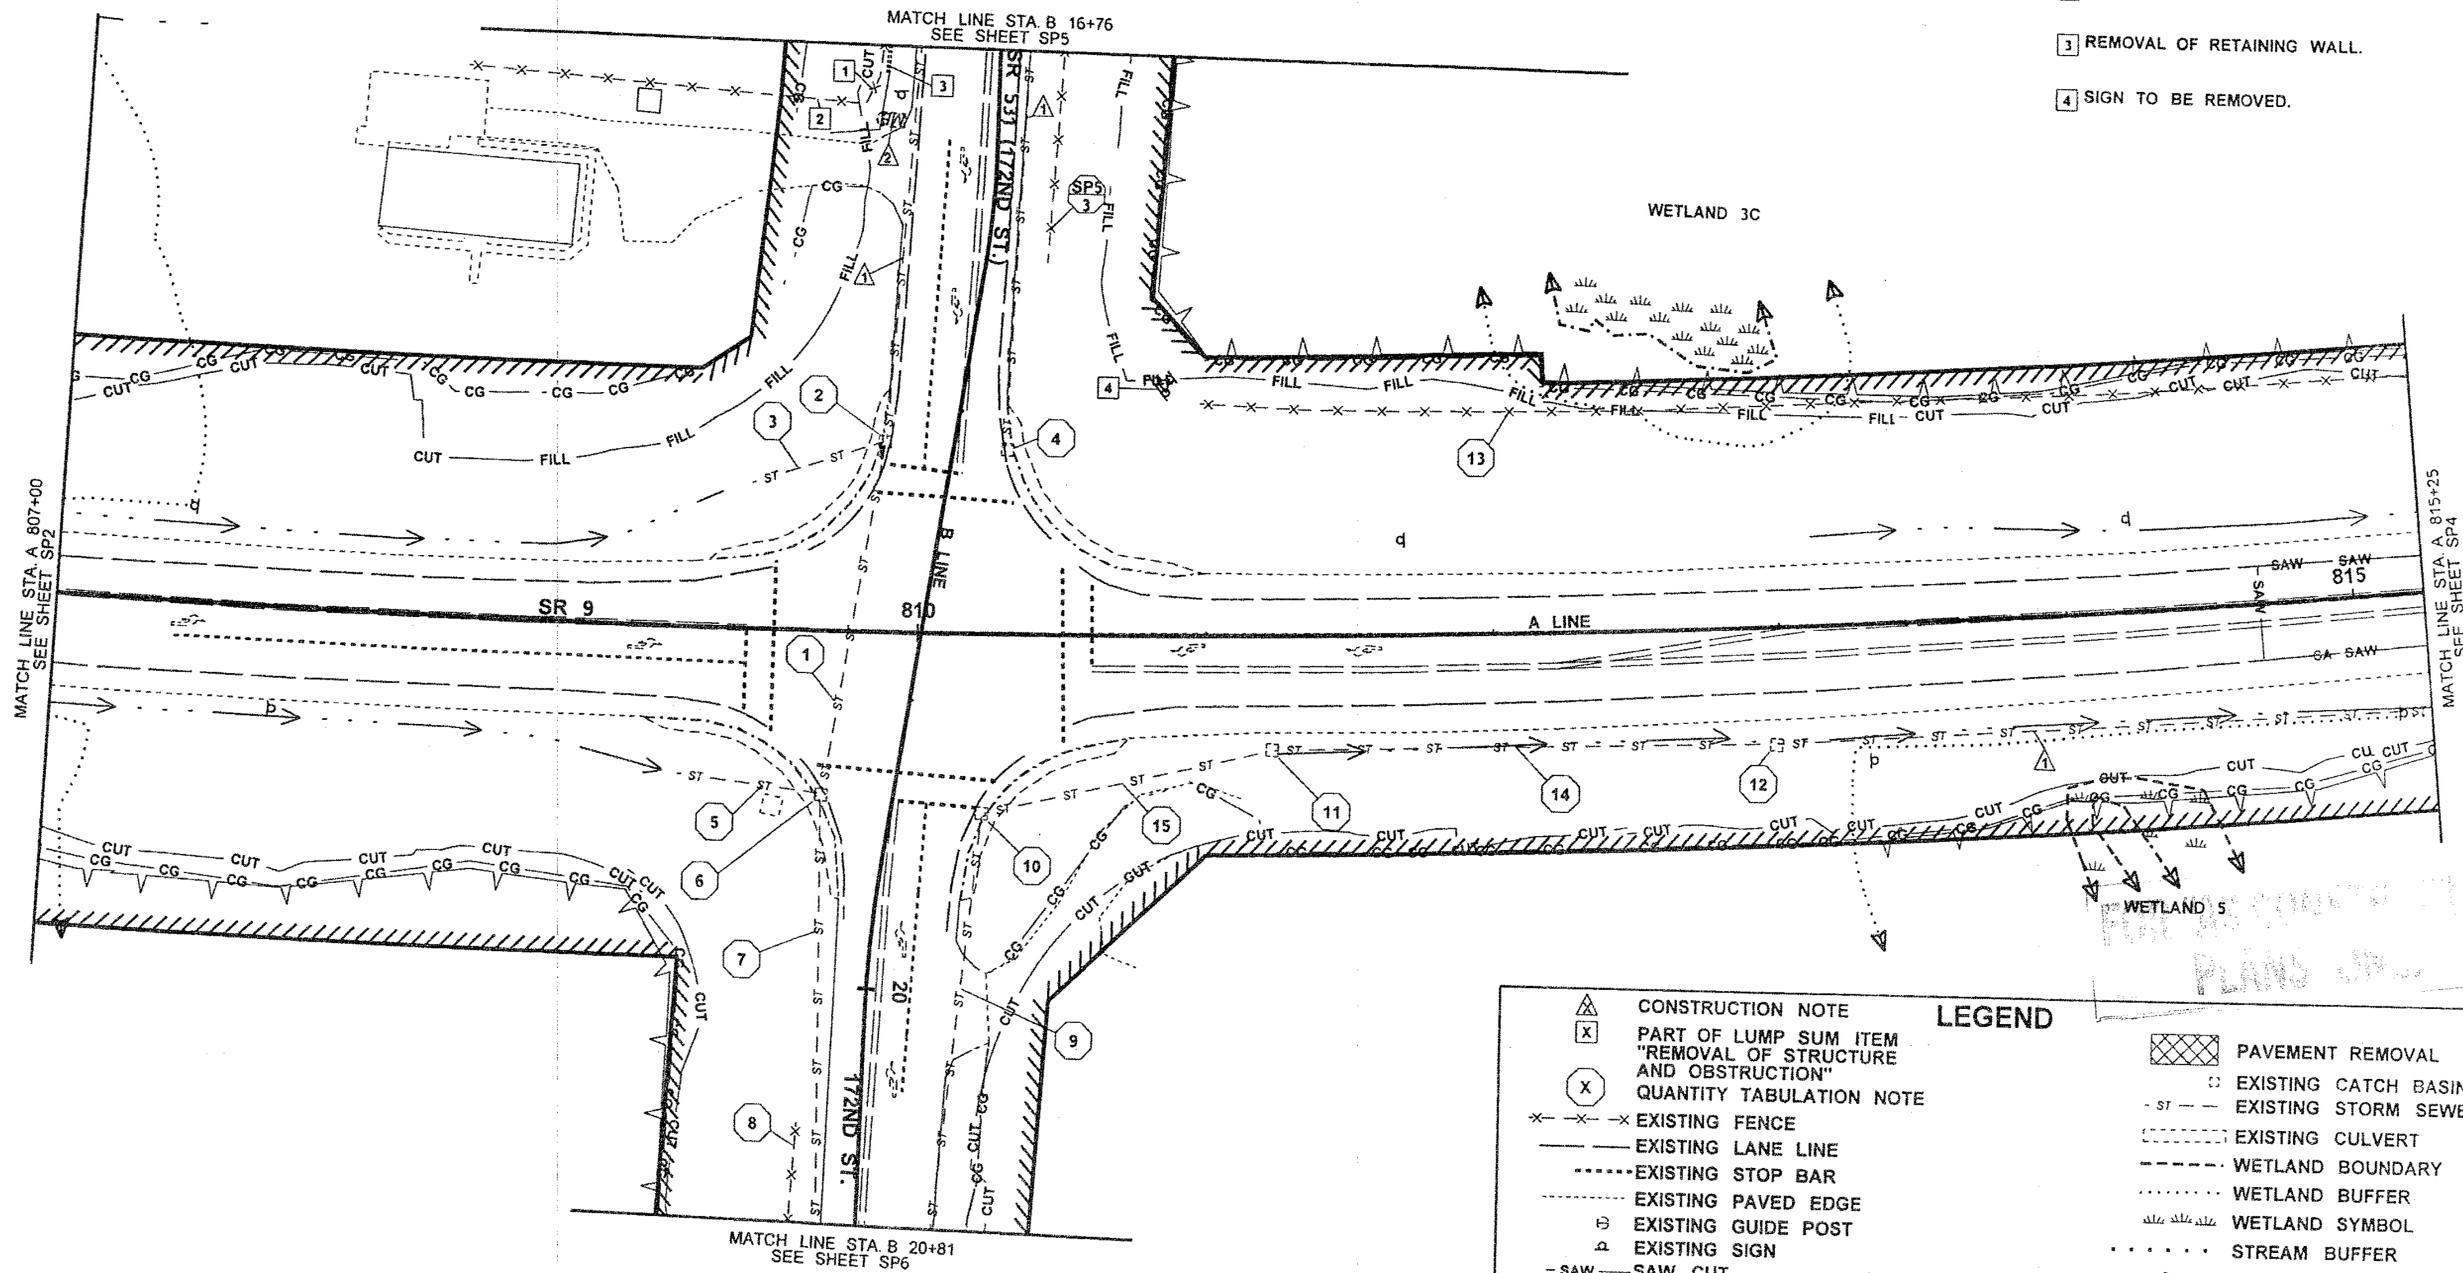

GENERAL NOTES:
 1. REFER TO SHEETS ECP1-ECP8 FOR PERMITTED WETLAND IMPACTS.
 2. SEE THE SPECIAL PROVISION REMOVAL OF STRUCTURE AND OBSTRUCTION.

LEGEND

△	CONSTRUCTION NOTE	▨	PAVEMENT REMOVAL
X	PART OF LUMP SUM ITEM "REMOVAL OF STRUCTURE AND OBSTRUCTION"	○	EXISTING CATCH BASIN
X	QUANTITY TABULATION NOTE	- ST -	EXISTING STORM SEWER
-X-X-	EXISTING FENCE	---	EXISTING CULVERT
---	EXISTING LANE LINE	---	WETLAND BOUNDARY
---	EXISTING STOP BAR	---	WETLAND BUFFER
---	EXISTING PAVED EDGE	---	WETLAND SYMBOL
⊕	EXISTING GUIDE POST	---	STREAM BUFFER
△	EXISTING SIGN	---	EXISTING DITCH
-SAW-	SAW CUT	MB	EXISTING MAILBOX
-CG-	CLEAR AND GRUB LIMITS	---	EXISTING VEGETATION TO SAVE AND PROTECT
-CUT-	CUT LINE	---	ORDINARY HIGH WATER MARK
-FILL-	FILL LINE		
////	WSDOT R/W		
////	WSDOT LIMITED ACCESS		

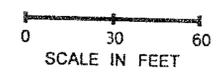

FILE NAME	I:\Projects\XL3325 SR9_SR531_172nd_St_NE_Int\CAD\PS&ESheets\XL3325 PS_SITE PREP.dgn			REGION NO.	STATE	FED.AID PROJ.NO.			SR 9 SR 531/172ND ST NE & EAGLEFIELD DR INTERSECTION IMPROVEMENT & PAVING	Plot 3
TIME	3:24:51 PM			10	WASH					PLAN REF NO
DATE	9/28/2011			JOB NUMBER					SHEET	32
PLOTTED BY	gunnm			CONTRACT NO.					OF	230
DESIGNED BY	M. GUNN			LOCATION NO.					SHEETS	
ENTERED BY	K.SOLWOLD									
CHECKED BY	J. KORESKE									
PROJ. ENGR.	S.SPAHR									
REGIONAL ADM.	L. ENG									
	REVISION	DATE	BY							


- CONSTRUCTION NOTE**
- (X) PART OF LUMP SUM ITEM "REMOVAL OF STRUCTURE AND OBSTRUCTION" QUANTITY TABULATION NOTE
 - (X) EXISTING FENCE
 - EXISTING LANE LINE
 - EXISTING STOP BAR
 - EXISTING PAVED EDGE
 - ⊕ EXISTING GUIDE POST
 - △ EXISTING SIGN
 - SAW — SAW CUT
 - CG — CG CLEAR AND GRUB LIMITS
 - CUT — CUT LINE
 - FILL — FILL LINE
 - WSDOT RW
 - ////// WSDOT LIMITED ACCESS

LEGEND

- ▨ PAVEMENT REMOVAL
- EXISTING CATCH BASIN
- ST - - EXISTING STORM SEWER
- EXISTING CULVERT
- WETLAND BOUNDARY
- WETLAND BUFFER
- WETLAND SYMBOL
- STREAM BUFFER
- EXISTING DITCH
- MB EXISTING MAILBOX
- ∨ EXISTING VEGETATION TO SAVE AND PROTECT
- OHW — ORDINARY HIGH WATER MARK

T. 31N. R. 5E. W.M.

△ ABANDON STORM SEWER PIPE IN PLACE.

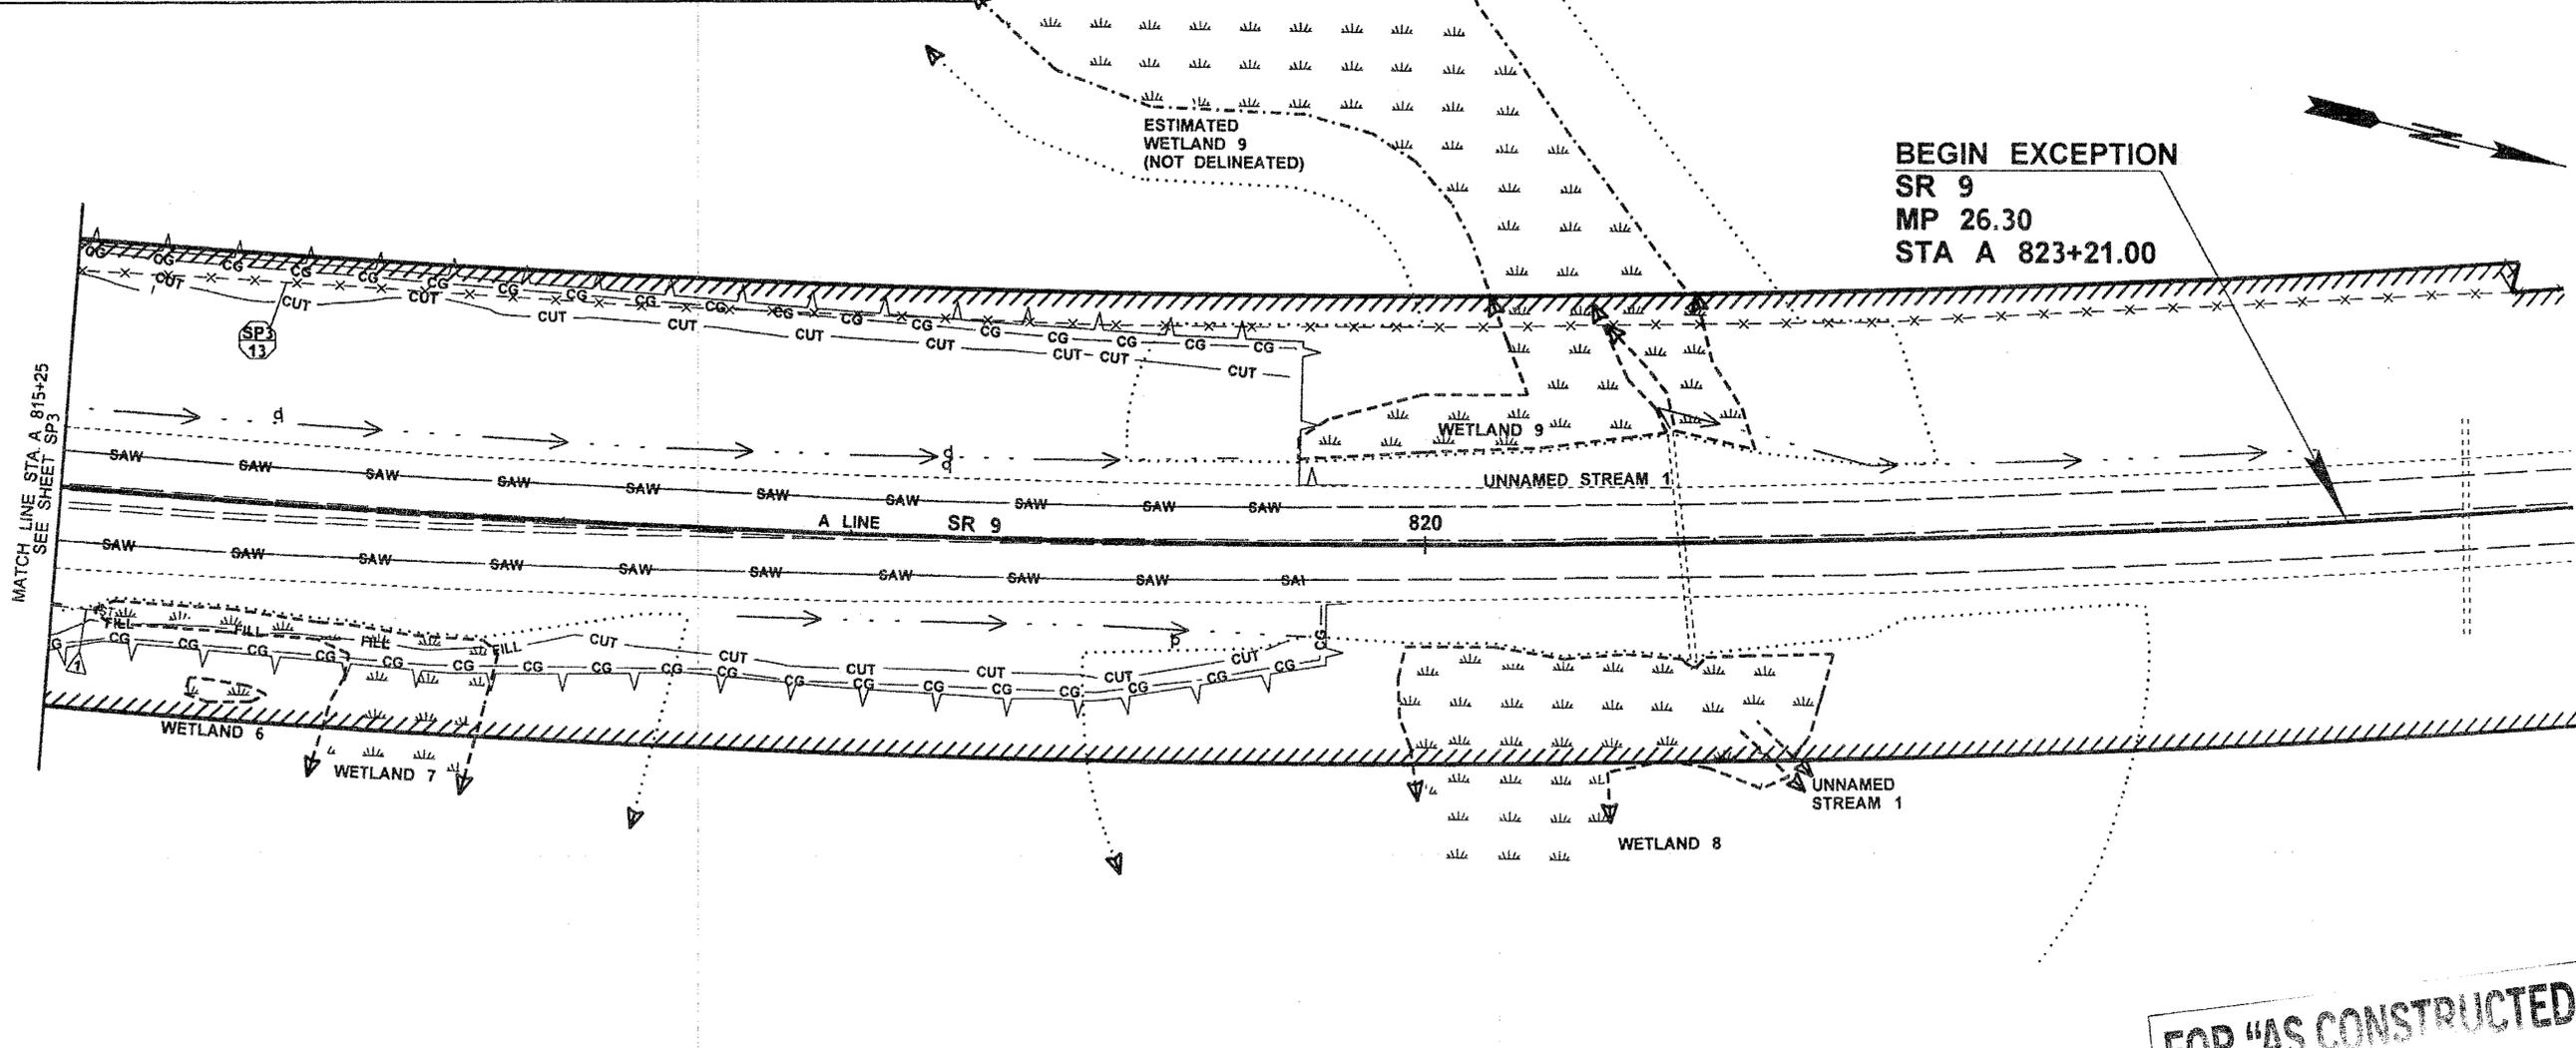

- GENERAL NOTES:**
- REFER TO SHEETS ECP1-ECP8 FOR PERMITTED WETLAND IMPACTS.
 - SEE THE SPECIAL PROVISION REMOVAL OF STRUCTURE AND OBSTRUCTION.

FOR "AS CONSTRUCTED PLANS" ONLY

FILE NAME: I:\Projects\XL3325_SR9_SR531_172nd_St_NE_Int\CAD\PS&ESheets\XL3325_PS_SITE_PREP.dgn		REGION NO. 10	STATE WASH	FED.AID PROJ.NO.			SR 9 SR 531/172ND ST NE & EAGLEFIELD DR INTERSECTION IMPROVEMENT & PAVING	Plot 4
TIME: 1:24:47 PM	DATE: 9/22/2011	JOB NUMBER: 10A042		CONTRACT NO.				LOCATION NO.
PLOTTED BY: lamaymp	DESIGNED BY: M. GUNN	CHECKED BY: J. KORESKE		PROJ. ENGR: S. SPAHR	REGIONAL ADM: L. ENG	SHEET 33 OF 230 SHEETS		
REVISION		DATE		BY		SITE PREPARATION PLAN		


T. 31N. R. 5E. W.M.

- △ ABANDON STORM SEWER PIPE IN PLACE.
- △ RELOCATE MAILBOX SUPPORT IN ACCORDANCE WITH SECTION 8-10.
- 1] REMOVAL OF WOOD FENCE.
- 2] REMOVAL OF CHAIN LINK FENCE.
- 3] REMOVAL OF RETAINING WALL.
- 4] SIGN TO BE REMOVED.
- 5] FLAG POLE TO BE REMOVED.
- 6] STREET LIGHT TO BE REMOVED.
- 7] GATE TO BE REMOVED.
- 8] YARD LIGHT TO BE REMOVED.
- 9] REMOVAL OF ASPHALT CONCRETE PAVEMENT.
- 10] REMOVAL OF CEMENT CONCRETE CURB AND GUTTER.
- 11] REMOVAL OF TREEHOUSE.
- 12] CONCRETE PILLAR TO BE REMOVED.

LEGEND


△	CONSTRUCTION NOTE	▨	PAVEMENT REMOVAL
⊗	PART OF LUMP SUM ITEM "REMOVAL OF STRUCTURE AND OBSTRUCTION"	□	EXISTING CATCH BASIN
⊗	QUANTITY TABULATION NOTE	- ST -	EXISTING STORM SEWER
- - - - -	EXISTING FENCE	- - - - -	EXISTING CULVERT
- - - - -	EXISTING LANE LINE	- - - - -	WETLAND BOUNDARY
- - - - -	EXISTING STOP BAR	- - - - -	WETLAND BUFFER
- - - - -	EXISTING PAVED EDGE	- - - - -	WETLAND SYMBOL
⊕	EXISTING GUIDE POST	- - - - -	STREAM BUFFER
⊕	EXISTING SIGN	→	EXISTING DITCH
- SAW	SAW CUT	MB	EXISTING MAILBOX
- CG - CG	CLEAR AND GRUB LIMITS	∨	EXISTING VEGETATION TO SAVE AND PROTECT
- CUT	CUT LINE	- OHW -	ORDINARY HIGH WATER MARK
- FILL	FILL LINE		
=====	WSDOT RW		
///////	WSDOT LIMITED ACCESS		

BEGIN CONSTRUCTION
 SR 531
 MP 9.73
 STA B 10+53.80

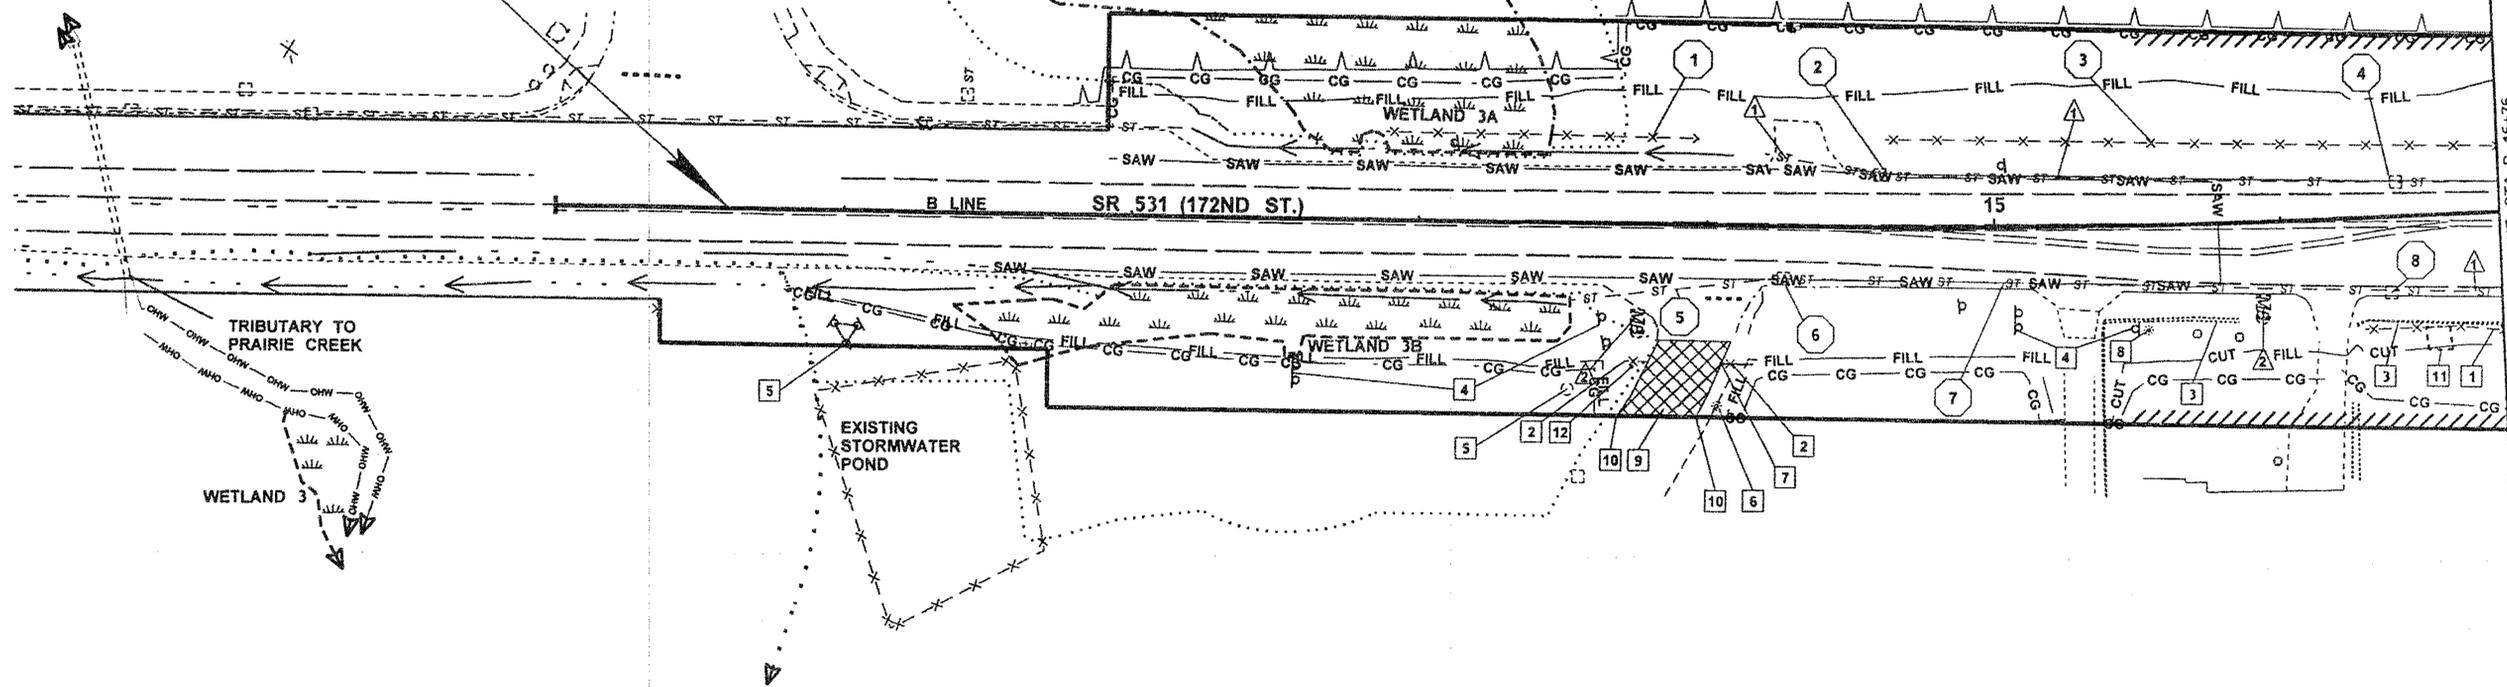

GENERAL NOTES:

1. REFER TO SHEETS ECP1-ECP8 FOR PERMITTED WETLAND IMPACTS.
2. SEE THE SPECIAL PROVISION REMOVAL OF STRUCTURE AND OBSTRUCTION.

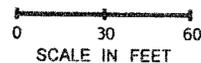


FOR "AS CONSTRUCTED" PLANS

FILE NAME: I:\Projects\XL3325 SR9 SR531 172nd St NE Int\CAD\PS&ESheets\XL3325 PS SITE PREP.dgn		REGION NO. 10	STATE WASH	FED.AID PROJ.NO.			SR 9 SR 531/172ND ST NE & EAGLEFIELD DR INTERSECTION IMPROVEMENT & PAVING	Plot 5
TIME: 9:45:29 AM	DATE: 9/22/2011	JOB NUMBER: 10A042	CONTRACT NO.	LOCATION NO.				DATE: 9/22/11
PLOTTED BY: solwalk	DESIGNED BY: M. GUNN	ENTERED BY: K. SOLWOLD	CHECKED BY: J. KORESKE	PROJ. ENGR.: S. SPAHR	REGIONAL ADM.: L. ENG	REVISION:	DATE:	BY:
SITE PREPARATION PLAN								SHEET 34 OF 230 SHEETS


T. 31N. R. 5E. W.M.

LEGEND	
	CONSTRUCTION NOTE
	PART OF LUMP SUM ITEM "REMOVAL OF STRUCTURE AND OBSTRUCTION"
	QUANTITY TABULATION NOTE
	EXISTING FENCE
	EXISTING LANE LINE
	EXISTING STOP BAR
	EXISTING PAVED EDGE
	EXISTING GUIDE POST
	EXISTING SIGN
	SAW CUT
	CLEAR AND GRUB LIMITS
	CUT LINE
	FILL LINE
	WSDOT R/W
	WSDOT LIMITED ACCESS
	PAVEMENT REMOVAL
	EXISTING CATCH BASIN
	EXISTING STORM SEWER
	EXISTING CULVERT
	WETLAND BOUNDARY
	WETLAND BUFFER
	WETLAND SYMBOL
	STREAM BUFFER
	EXISTING DITCH
	EXISTING MAILBOX
	EXISTING VEGETATION TO SAVE AND PROTECT
	ORDINARY HIGH WATER MARK

- ABANDON STORM SEWER PIPE IN PLACE.
- RELOCATE MAILBOX SUPPORT IN ACCORDANCE WITH SECTION 8-10.
- 1 REMOVAL OF WOOD FENCE.
- 2 REMOVAL OF CHAIN LINK FENCE.
- 3 REMOVAL OF RETAINING WALL.
- 4 SIGN TO BE REMOVED.
- 5 FLAG POLE TO BE REMOVED.
- 6 STREET LIGHT TO BE REMOVED.
- 7 GATE TO BE REMOVED.
- 8 YARD LIGHT TO BE REMOVED.
- 9 REMOVAL OF ASPHALT CONCRETE PAVEMENT.
- 10 REMOVAL OF CEMENT CONCRETE CURB AND GUTTER.
- 11 REMOVAL OF TREEHOUSE.
- 12 CONCRETE PILLAR TO BE REMOVED.

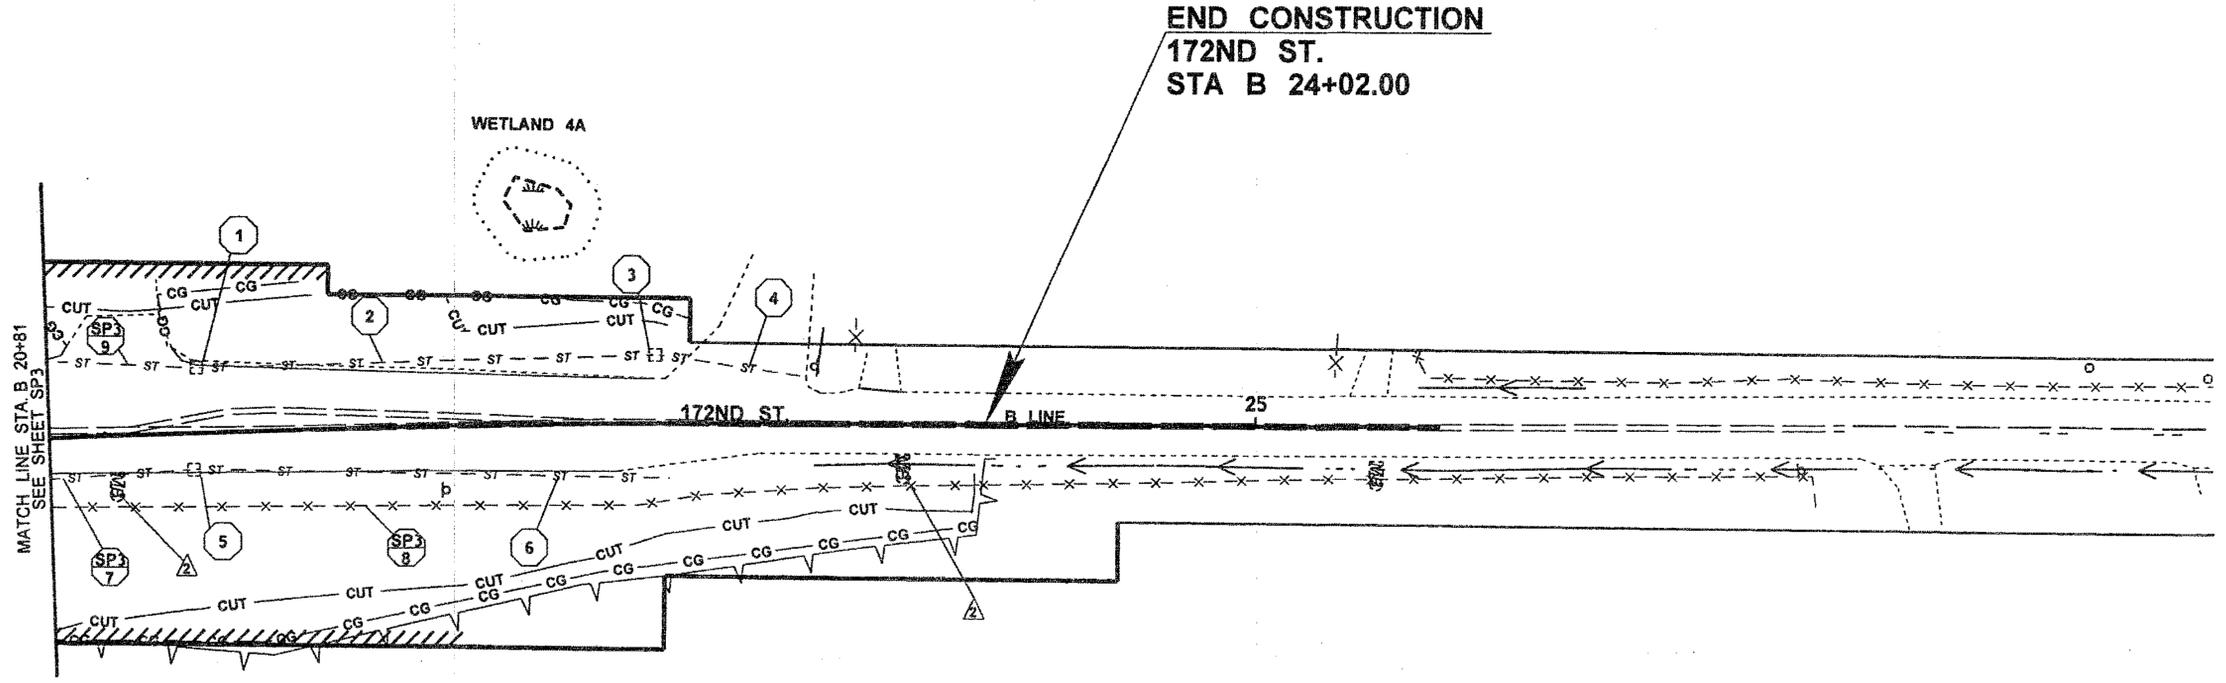

GENERAL NOTES:
 1. REFER TO SHEETS ECP1-ECP8 FOR PERMITTED WETLAND IMPACTS.
 2. SEE THE SPECIAL PROVISION REMOVAL OF STRUCTURE AND OBSTRUCTION.

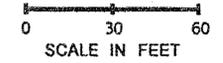


FOR "AS CONSTRUCTED PLANS" ONLY

RELOCATE MAILBOX SUPPORT IN ACCORDANCE WITH SECTION 8-10 OF THE STANDARD PLANS.

FILE NAME	I:\Projects\XL3325_SR9_SR531_172nd St NE Int\CAD\PS&ESheets\XL3325_PS_SITE PREP.dgn			REGION NO.	STATE	FED.AID PROJ.NO.			SR 9 SR 531/172ND ST NE & EAGLEFIELD DR INTERSECTION IMPROVEMENT & PAVING SITE PREPARATION PLAN	Plot 6
TIME	9:45:30 AM			10	WASH	LOCATION NO.				PLAN REF NO
DATE	9/22/2011			JOB NUMBER			DATE		SHEET 35 OF 230 SHEETS	
PLOTTED BY	solwalk			CONTRACT NO.						
DESIGNED BY	M.GUNN									
ENTERED BY	K.SOLWOLD									
CHECKED BY	J.KORESKE									
PROJ. ENGR.	S.SPAHR									
REGIONAL ADM.	L.ENG			REVISION	DATE	BY				

LEGEND	
	CONSTRUCTION NOTE
	PART OF LUMP SUM ITEM "REMOVAL OF STRUCTURE AND OBSTRUCTION"
	QUANTITY TABULATION NOTE
	EXISTING FENCE
	EXISTING LANE LINE
	EXISTING STOP BAR
	EXISTING PAVED EDGE
	EXISTING GUIDE POST
	EXISTING SIGN
	SAW CUT
	CLEAR AND GRUB LIMITS
	CUT LINE
	FILL LINE
	WSDOT R/W
	WSDOT LIMITED ACCESS
	PAVEMENT REMOVAL
	EXISTING CATCH BASIN
	EXISTING STORM SEWER
	EXISTING CULVERT
	WETLAND BOUNDARY
	WETLAND BUFFER
	WETLAND SYMBOL
	STREAM BUFFER
	EXISTING DITCH
	EXISTING MAILBOX
	EXISTING VEGETATION TO SAVE AND PROTECT
	ORDINARY HIGH WATER MARK

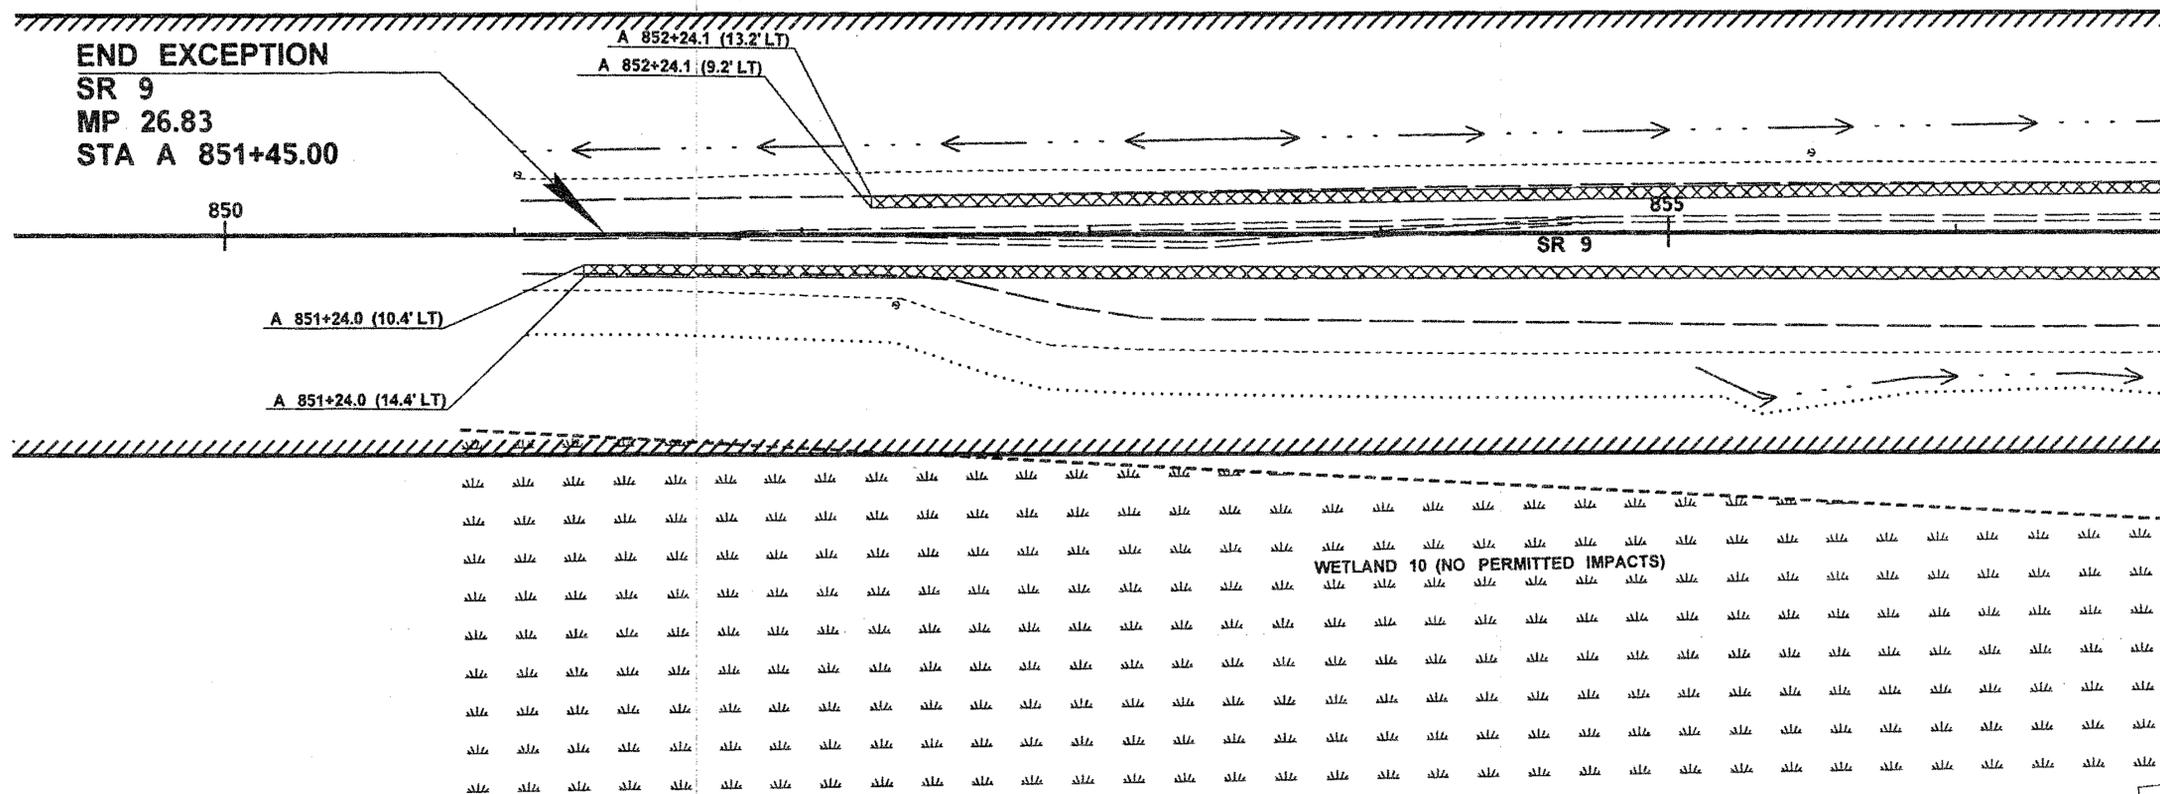


MATCH LINE STA. A 856+75
SEE SHEET SP8

GENERAL NOTES:

- REFER TO SHEETS ECP1-ECP8 FOR PERMITTED WETLAND IMPACTS.
- SEE THE SPECIAL PROVISION REMOVAL OF STRUCTURE AND OBSTRUCTION.

FOR "AS CONSTRUCTED" PLANS ONLY

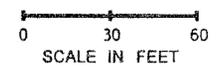

FILE NAME: I:\Projects\XL3325 SR9 SR531 172nd St NE Int\CAD\PS&ESheets\XL3325 PS SITE PREP.dgn		REGION NO. 10	STATE WASH	FED.AID PROJ.NO.			SR 9 SR 531/172ND ST NE & EAGLEFIELD DR INTERSECTION IMPROVEMENT & PAVING SITE PREPARATION PLAN	Plot 7
TIME: 9:45:31 AM	DATE: 9/22/2011	JOB NUMBER: 10A042	CONTRACT NO.	LOCATION NO.				PLAN REF NO: SP7
PLOTTED BY: solwolk	DESIGNED BY: M.GUNN	CHECKED BY: J.KORESKI	PROJ. ENGR: S.SPAHR	REGIONAL ADM: L.ENG	REVISION	DATE	BY	SHEET 36 OF 230 SHEETS

- 1 REMOVAL OF ASPHALT CONCRETE PAVEMENT
- 2 REMOVAL OF CEMENT CONCRETE SIDEWALK
- 3 REMOVAL OF CEMENT CONCRETE CURB AND GUTTER
- 4 REMOVAL OF CEMENT CONCRETE CURB

LEGEND

CONSTRUCTION NOTE

(X) PART OF LUMP SUM ITEM "REMOVAL OF STRUCTURE AND OBSTRUCTION"

QUANTITY TABULATION NOTE

X-X-X EXISTING FENCE

--- EXISTING LANE LINE

----- EXISTING STOP BAR

----- EXISTING PAVED EDGE

⊕ EXISTING GUIDE POST

△ EXISTING SIGN

-SAW- SAW CUT

-CG- CLEAR AND GRUB LIMITS

-CUT- CUT LINE

-FILL- FILL LINE

WSDOT R/W

WSDOT LIMITED ACCESS

⊗ PAVEMENT REMOVAL

⊕ EXISTING CATCH BASIN

-ST- EXISTING STORM SEWER

----- EXISTING CULVERT

----- WETLAND BOUNDARY

----- WETLAND BUFFER

WETLAND SYMBOL


----- STREAM BUFFER

→ EXISTING DITCH

M EXISTING MAILBOX


∩ EXISTING VEGETATION TO SAVE AND PROTECT

-OHW- ORDINARY HIGH WATER MARK

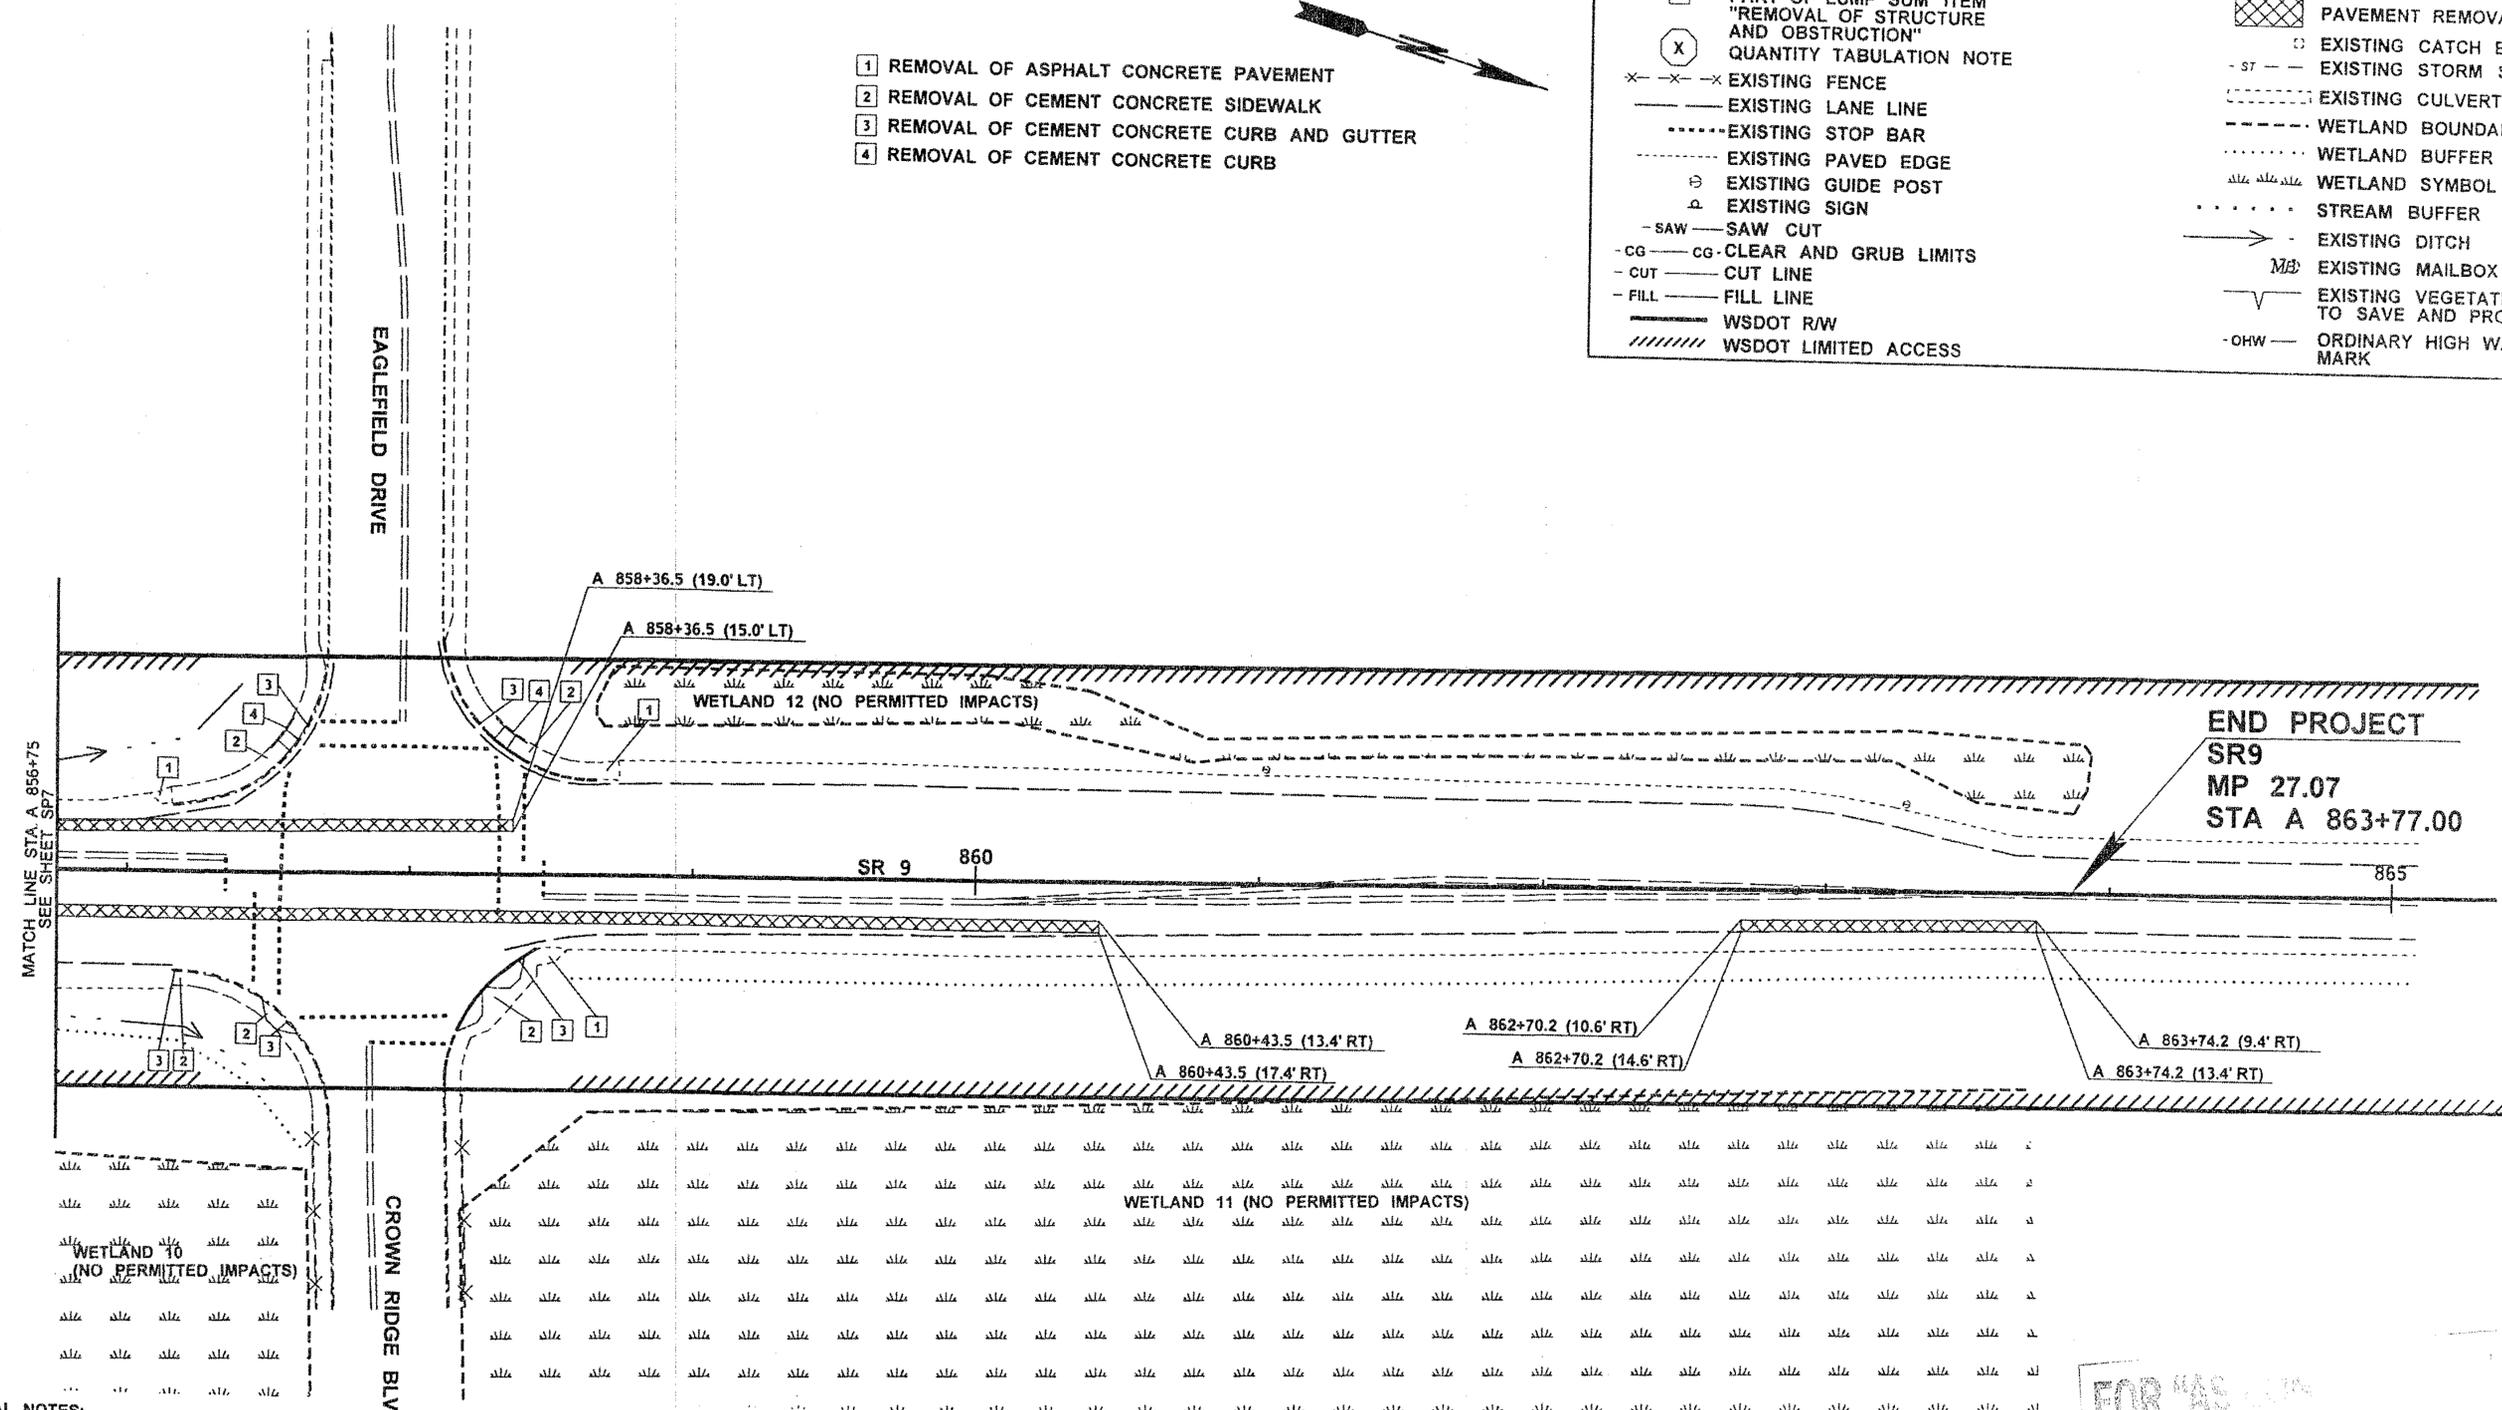

END PROJECT
SR9
MP 27.07
STA A 863+77.00

- GENERAL NOTES:**
- REFER TO SHEETS ECP1-ECP8 FOR PERMITTED WETLAND IMPACTS.
 - SEE THE SPECIAL PROVISION REMOVAL OF STRUCTURE AND OBSTRUCTION.

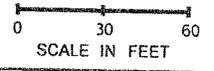

FOR AS-BUILT PLANS

FILE NAME: I:\Projects\XL3325 SR9 SR531 172nd St NE IntCAD\PS&ESheets\XL3325 PS SITE PREP.dgn		REGION NO. 10		STATE WASH		FED.AID PROJ.NO.		DATE 9/28/11		PLOT 8	
TIME: 1:57:52 PM	DATE: 9/27/2011	JOB NUMBER: 10A042		CONTRACT NO.		LOCATION NO.		Washington State Department of Transportation		SR 9 SR 531/172ND ST NE & EAGLEFIELD DR INTERSECTION IMPROVEMENT & PAVING	
PLOTTED BY: lamaymp	DESIGNED BY: M.GUNN	PROJ. ENGR: S.SPAHR		REGIONAL ADM: L.ENG		REVISION		DATE		BY	
ENTERED BY: K.SOLWOLD	CHECKED BY: J.KORESKE	REVISION		DATE		BY		DATE		SHEET 37 OF 230 SHEETS	
SITE PREPARATION PLAN										SP8	




ROADWAY SECTION A

ROADWAY SECTION B

MATCH EXISTING SUPER ELEVATION
A 795+77.70

CENTERLINE PROFILE GRADE & PIVOT POINT

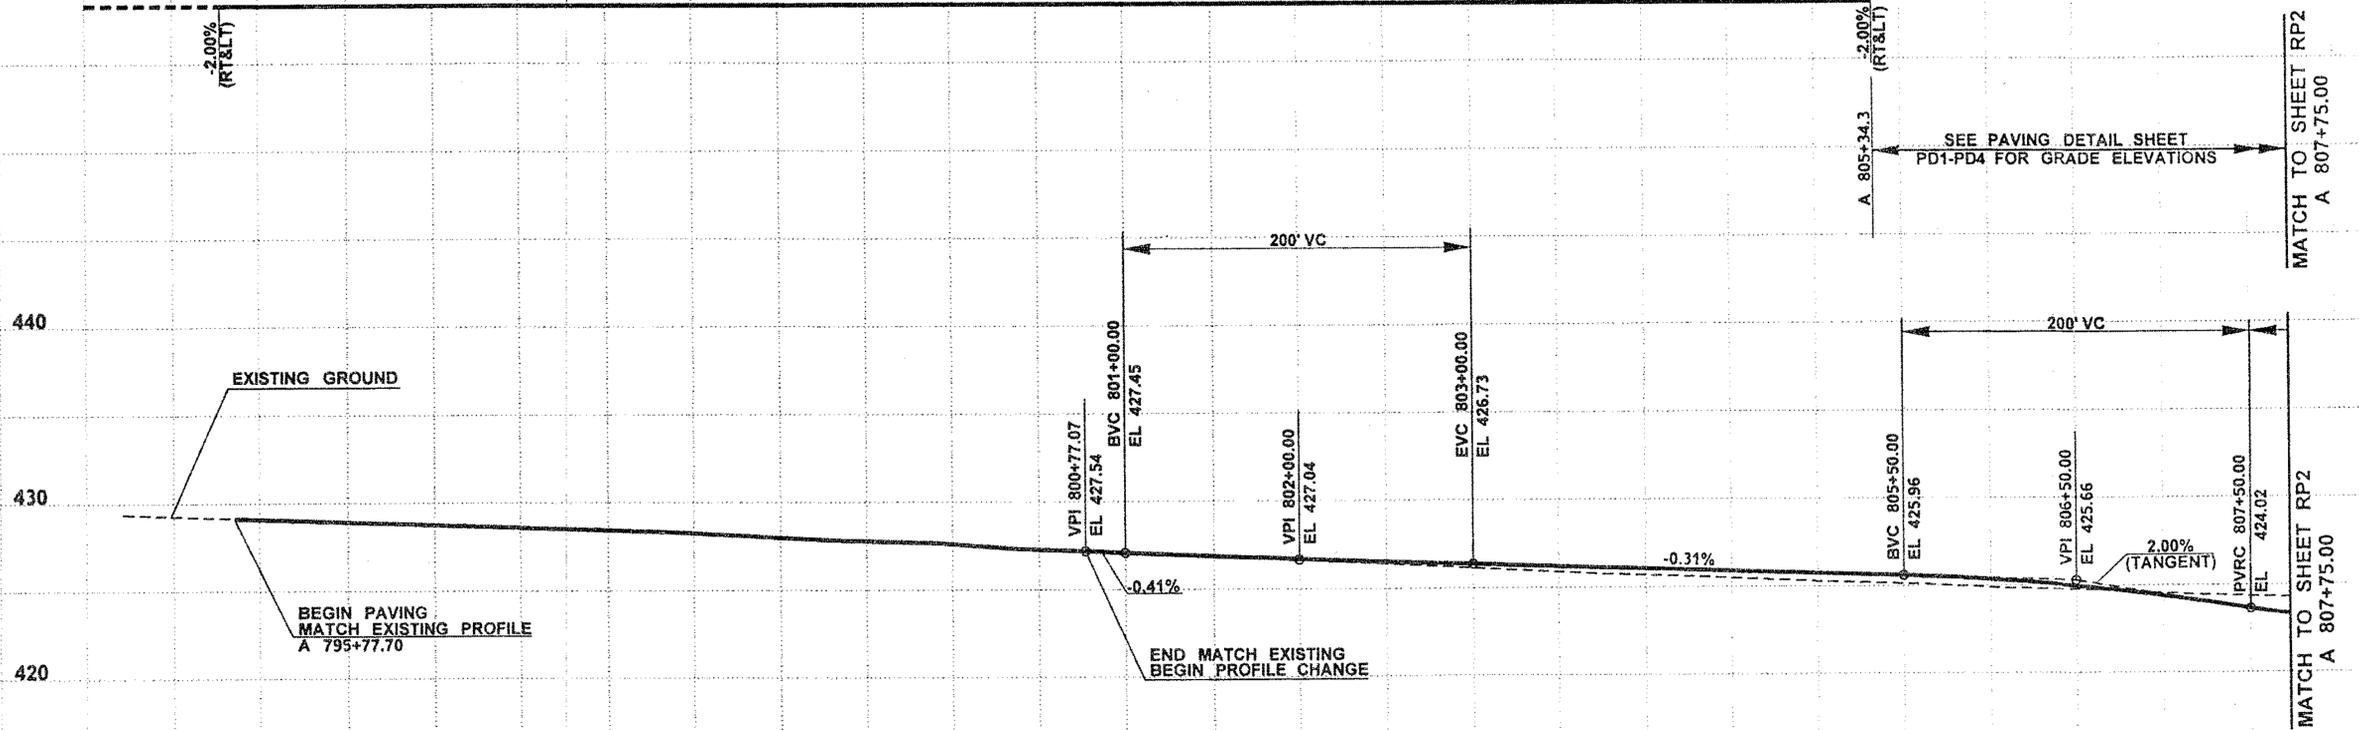

BEGIN A 795+77.70	SELECT BORROW INCL. HAUL = 2320 TON **	SELECT BORROW INCL. HAUL = 100 TON **
	ROADWAY EXCAVATION INCL. HAUL = 2140 C.Y. *	ROADWAY EXCAVATION INCL. HAUL = 2230 C.Y. *
	CLEARING AND GRUBBING = 1.57 ACRE	CLEARING AND GRUBBING = 0.57 ACRE
	EMBANKMENT COMPACTION = 1250 C.Y. **	EMBANKMENT COMPACTION = 50 C.Y. **
	SEEDING, FERTILIZING AND MULCHING = 0.63 ACRES	SEEDING, FERTILIZING AND MULCHING = 0.10 ACRES

795+00 796+00 797+00 798+00 799+00 800+00 801+00 802+00 803+00 804+00 805+00 806+00 807+00

* REFER TO SHEET TPP2 AND TCP1 FOR ADDITIONAL QUANTITIES.
** REFER TO SHEETS DSN1 - DSN6, TPP2, AND TCP1 FOR ADDITIONAL QUANTITIES.

A LINE PROFILE

FOR "AS CONSTRUCTED"
PLANS

FILE NAME I:\Projects\XL3325 SR9 SR531 172nd St NE IntCADIPS&ESheets\XL3325 PS RP.dgn	REGION NO. 10	STATE WASH	FED.AID PROJ.NO.			SR 9 SR 531/172ND ST NE & EAGLEFIELD DR INTERSECTION IMPROVEMENT & PAVING ROADWAY PROFILE	Plot 1	
TIME 4:12:17 PM	JOB NUMBER 10A042	CONTRACT NO.	LOCATION NO.				DATE 9/28/11	DATE
DATE 9/28/2011	DESIGNED BY M.GUNN	CHECKED BY J.KORESKE	PROJ. ENGR. S.SPAHR	REGIONAL ADM. LENG	REVISION	DATE	BY	SHEET 38 OF 230 SHEETS



ROADWAY SECTION B

ROADWAY SECTION G

ROADWAY SECTION B

ROADWAY SECTION A

CENTERLINE PROFILE GRADE & PIVOT POINT

CENTERLINE PROFILE GRADE & PIVOT POINT

MATCH TO SHEET RP1
A 807+75.00


SEE PAVING DETAIL SHEET
PD1-PD4 FOR GRADE ELEVATIONS

440

430

420

410

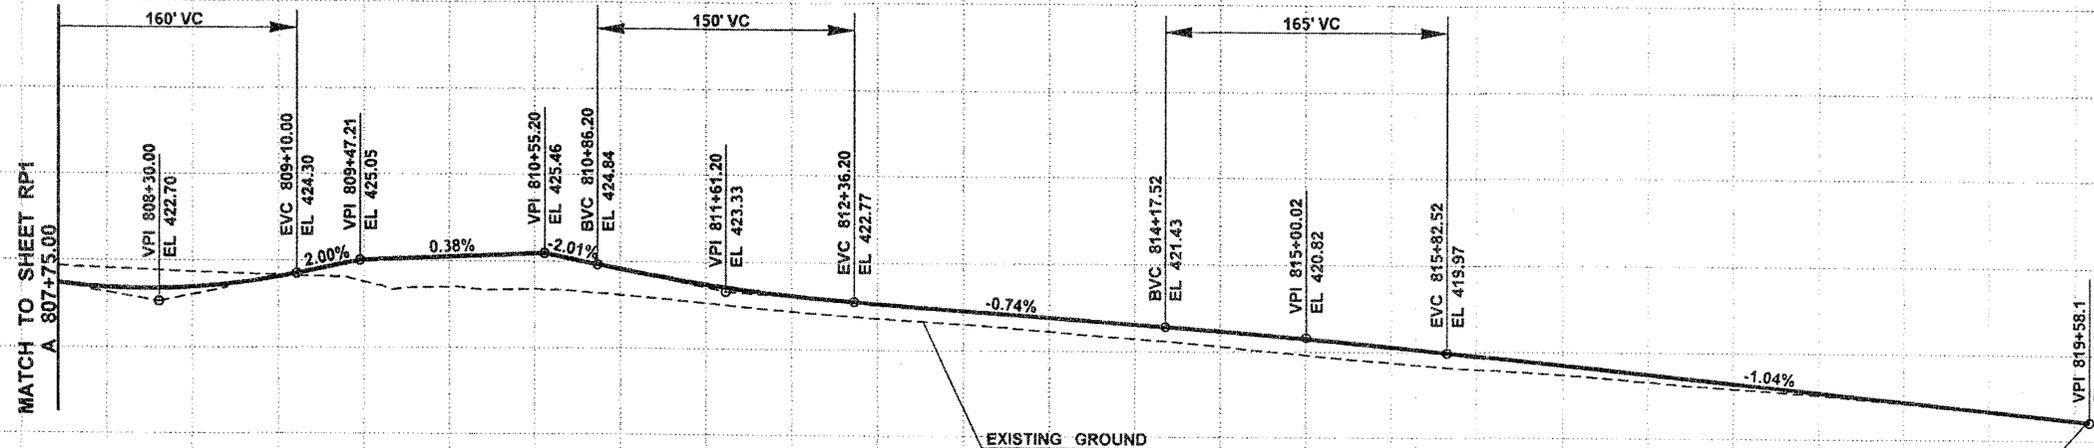

SELECT BORROW INCL. HAUL = 730 TON**	SELECT BORROW INCL. HAUL = 320 TON**
ROADWAY EXCAVATION INCL. HAUL = 3610 C.Y.*	ROADWAY EXCAVATION INCL. HAUL = 1670 C.Y.*
CLEARING AND GRUBBING = 1.57 ACRE	CLEARING AND GRUBBING = 0.91 ACRE
EMBANKMENT COMPACTION = 390 C.Y.**	EMBANKMENT COMPACTION = 170 C.Y.**
SEEDING, FERTILIZING, AND MULCHING = 0.37 ACRES	SEEDING, FERTILIZING, AND MULCHING = 0.41 ACRES


808+00 809+00 810+00 811+00 812+00 813+00 814+00 815+00 816+00 817+00 818+00 819+00

A LINE PROFILE

* REFER TO SHEET TPP2 AND TCP1 FOR ADDITIONAL QUANTITIES.
 ** REFER TO SHEETS DSN1 - DSN6, TPP2, AND TCP1 FOR ADDITIONAL QUANTITIES.

FOR 'AS SHOWN' PLANS USE

FILE NAME	I:\Projects\XL3325 SR9 SR531 172nd St NE Int\CAD\PS&ESheets\XL3325 PS RP.dgn			REGION NO.	STATE	FED.AID PROJ.NO.			SR 9 SR 531/172ND ST NE & EAGLEFIELD DR INTERSECTION IMPROVEMENT & PAVING ROADWAY PROFILE	Plot 2
TIME	4:12:20 PM			10	WASH	PLAN REF. NO.				RP2
DATE	9/28/2011			JOB NUMBER	10A042	SHEET 39 OF 230 SHEETS				
PLOTTED BY	gunnm			CONTRACT NO.						
DESIGNED BY	M.GUNN			LOCATION NO.						
ENTERED BY	K.SOLWOLD			REVISION						
CHECKED BY	J.KORESKE			DATE						
PROJ. ENGR.	S.SPAHR			BY						
REGIONAL ADM.	LENG									

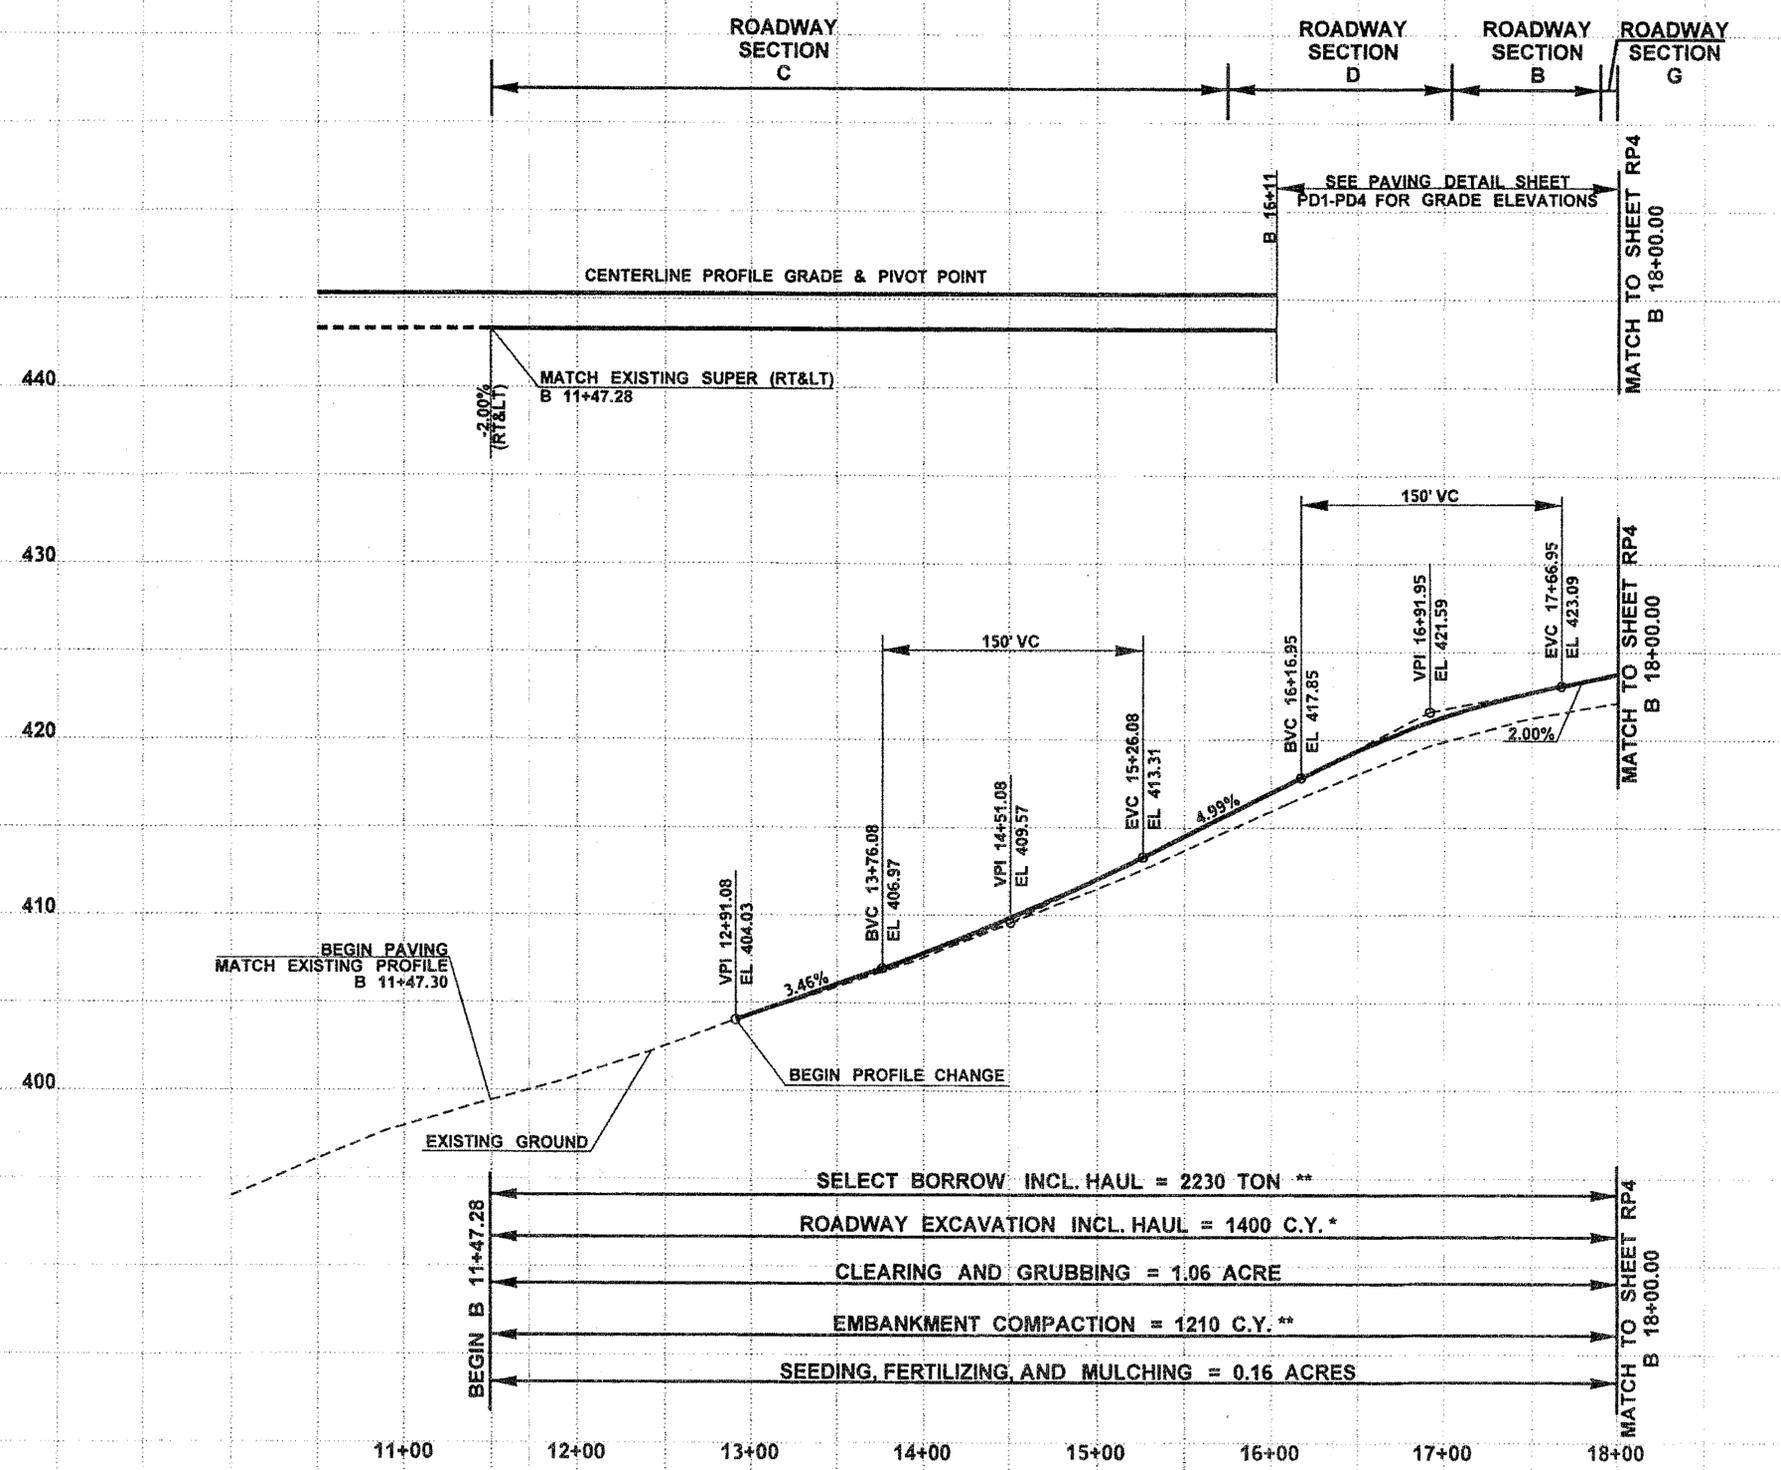

- SELECT BORROW INCL. HAUL = 2230 TON **
- ROADWAY EXCAVATION INCL. HAUL = 1400 C.Y. *
- CLEARING AND GRUBBING = 1.06 ACRE
- EMBANKMENT COMPACTION = 1210 C.Y. **
- SEEDING, FERTILIZING, AND MULCHING = 0.16 ACRES

FOR 'AS CONSTRUCTED PLANS' ONLY

* REFER TO SHEET TPP2 AND TCP1 FOR ADDITIONAL QUANTITIES.
 ** REFER TO SHEETS DSN1 - DSN6, TPP2, AND TCP1 FOR ADDITIONAL QUANTITIES.


B LINE PROFILE

FILE NAME	I:\Projects\XL3325 SR9 SR531 172nd St NE Int\CAD\PS&ESheets\XL3325 PS RP.dgn			REGION NO.	STATE	FED.AID PROJ.NO.			SR 9 SR 531/172ND ST NE & EAGLEFIELD DR INTERSECTION IMPROVEMENT & PAVING ROADWAY PROFILE	Plot 3
TIME	4:12:22 PM			10	WASH	PLAN REF. NO.				RP3
DATE	9/28/2011			JOB NUMBER	10A042	SHEET				40
PLOTTED BY	gunnm			CONTRACT NO.		OF				230
DESIGNED BY	M.GUNN			LOCATION NO.		SHEETS				
ENTERED BY	K.SOLWOLD			REVISION		DATE				
CHECKED BY	J.KORESKI			BY		DATE				
PROJ. ENGR.	S.SPAHR									
REGIONAL ADM.	L.ENG									

QUANTITY TABULATION - TEMPORARY EROSION CONTROL

NOTE: THE FIRST NUMBER OF THE "CODE" BELOW REFERS TO THE SHEET NO. OR THE SHEET REFERENCE NO. SHOWING THE CONSTRUCTION FEATURE. THE SECOND NUMBER REFERS TO THE CONSTRUCTION FEATURE FOUND ON THAT SHEET.		QUARRY SPALLS*	SCHEDULE A CULV. PIPE 12 IN. DIAM.*	TEMPORARY EROSION CONTROL BLANKET	CHECK DAM	INLET PROTECTION	SILT FENCE	HIGH VISIBILITY FENCE	STRUCTURE EXCAVATION CLASS B INCL. HAUL**	CONSTRUCTION GEOTEXTILE FOR SEPERATION*	GEOMEMBRANE **	SEE GENERAL NOTES	GENERAL NOTES:
CODE	LOCATION \ UNIT OF MEASURE >	TON	L.F.	S.Y.	L.F.	EACH	L.F.	L.F.	C.Y.	S.Y.	S.Y.		
TESC1	A 795+43.9 (32.0' RT) TO A 807+22.6 (112.9' RT)						1210	1210				4, 5	* REFER TO DSN1-DSN6 AND AL1 FOR ADDITIONAL QUANTITIES. ** REFER TO DSN1- DSN6 FOR ADDITIONAL QUANTITIES. 1. SEE EROSION CONTROL BLANKET PLACEMENT IN CHANNEL STANDARD PLAN I-60.20-00. 2. SEE GEOTEXTILE ENCASED CHECK DAM INSTALLATION STANDARD PLAN I-50.10-00. 3. SEE STORM DRAIN INLET PROTECTION STANDARD PLAN I-40.20-00. 4. SEE SILT FENCE STANDARD PLAN I-30.15-00. 5. SEE HIGH VISIBILITY FENCE STANDARD PLAN I-10.10-01. 6. SEE SHEET TECD1. 7. SEE SHEET TECD2. 8. REMOVE SCHEDULE A CULV. PIPE 12 IN. DIAM. DURING PHASE 4 OF CONSTRUCTION.
TESC1	A 798+25.0 (35.7' RT) TO B 24+01.0 (23.1' LT)				200							2	
TESC2	A 798+99.1 (75.1' LT) TO A 802+88.3 (75.1' LT)						420	420				4, 5	
TESC2	A 805+31.8 (75.1' LT) TO A 807+66.0 (88.1' LT)						240	240				4, 5	
TESC3	A 807+49.0 (73.6' LT) TO B 14+23.5 (35.9' RT)			640	100							1, 2	
TESC3-2	B 18+15.0 (23.5' RT)					1						3	
TESC3-3	B 18+10.2 (18.7' LT)					1						3	
TESC3-4	B 19+37.6 (25.1' RT)					1						3	
TESC3-5	B 19+34.0 (31.1' LT)					1						3	
TESC3-6	A 811+23.0 (38.8' RT)					1						3	
TESC3	A 811+80.0 (74.6' LT) TO A 817+62.5 (52.0' LT)				200							2	
TESC3	A 812+05.8 (94.9' LT) TO A 813+33.0 (76.0' LT)						130	130				3	
TESC3-7	A 812+98.0 (40.2' RT)					1						3	
TESC3	A 813+17.5 (57.3' RT) TO A 817+51.5 (49.1' RT)						440	440				4, 5	
TESC4	A 817+15.0 (36.5' RT) TO A 819+45.4 (32.3' RT)				100							2	
TESC4	TEMPORARY SEDIMENT TRAP	315							800		450	6	
TESC4	A 818+79.9 (74.9' RT) TO A 822+48.9 (74.9' RT)						100	460				4, 5	
TESC4	A 818+99.2 (85.1' LT) TO A 821+63.6 (85.1' LT)						90	400				4, 5	
TESC5	B 10+82.0 (22.0' RT) TO B 10+91.0 (46.2' RT)						30	30				4, 5	
TESC5	B 11+91.7 (37.3' LT) TO B 13+70.7 (69.3' LT)						210	210				4, 5	
TESC5	B 12+20.9 (30.1' LT) TO B 14+08.8 (24.1' LT)				60							2	
TESC5	PAD FOR CESF	170								270		7	
TESC5	TEMPORARY SEDIMENT TRAP	222							460		600	7	
TESC5-1	B 11+27.6 (30.3' LT)					1						3	
TESC5-2	B 13+53 (36.6' RT) TO B 14+23.5 (37.0' RT)		71									8	
TESC5-3	B 14+26.8 (17.7' RT)					1						3	
TESC5-4	B 14+60.3 (17.9' LT)					1						3	
TESC5-5	B 16+37.9 (26.0' RT)					1						3	
TESC5-6	B 16+40.7 (11.7' LT)					1						3	
TESC5-7	B 15+19.6 (41.9' RT) TO B 15+37.4 (43.4' RT)		18									8	
SHEET TOTAL		707	89	640	660	11	2870	3540	1260	270	1050		

FOR "AS CONSTRUCTED"
PLANS ONLY

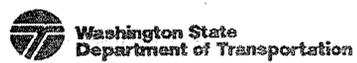DESIGNED BY	M. LAMAY	10/25/11	AD1 - DELETED ITEM	SMS	REGION NO.	STATE	FED. AID PROJ. NO.		SR 9 SR 531/172ND ST NE & EAGLEFIELD DR. INTERSECTION IMPROVEMENT & PAVING	QTEC 1
ENTERED BY	M. MCREYNOLDS				10	WASH				SHEET
CHECKED BY	J. KORESKE				JOB NUMBER					42
PROJ. ENGR.	S. SPAHR				10A042					OF
REGION ADM.	L. ENG				CONTRACT NO.					230
		DATE	DATE	REVISION	BY					SHEETS
										CONTROL

QUANTITY TABULATION - TEMPORARY EROSION CONTROL

NOTE:
THE FIRST NUMBER OF THE "CODE" BELOW REFERS TO THE SHEET NO. OR THE SHEET REFERENCE NO. SHOWING THE CONSTRUCTION FEATURE.

THE SECOND NUMBER REFERS TO THE CONSTRUCTION FEATURE FOUND ON THAT SHEET.


GENERAL NOTES:

CODE	LOCATION < \ UNIT OF MEASURE >	QUARRY SPALLS*	SCHEDULE A CULV. PIPE 12 IN. DIAM.*	TEMPORARY EROSION CONTROL BLANKET	CHECK DAM	INLET PROTECTION	SILT FENCE	HIGH VISIBILITY FENCE	STRUCTURE EXCAVATION CLASS	CONSTRUCTION GEOTEXTILE FOR SEPERATION*	GEOMEMBRANE **	SEE GENERAL NOTES
		TON	L.F.	S.Y.	L.F.	EACH	L.F.	L.F.	C.Y. B INCL. HAUL**	S.Y.	S.Y.	
TESC6	B 22+92.9 (25.7' LT) TO A 815+36.2 (44.5' RT)				300							2
TESC6-1	B 21+30.7 (12.5' RT)					1						3
TESC6-2	B 21+32.6 (22.4' LT)					1						3
TESC6-3	B 22+92.0 (23.4' LT)					1						3
TESC7	A 851+02.1 (24.1' LT) TO A 857+57.7 (74.7' LT)						680	680				4, 5
TESC7	A 851+02.7 (23.9' RT) TO A 857+65.2 (74.0' RT)						680	680				4, 5
TESC8	A 858+18.6 (74.0' RT) TO A 865+08.8 (27.3' RT)						710	710				4, 5
TESC8	A 858+29.4 (74.2' LT) TO A 865+09.3 (24.3' LT)						690	690				4, 5
SHEET TOTAL												
PROJECT TOTAL		707	89	640	300	3	2760	2760	1260	270	1050	

- * REFER TO DSN1-DSN6 AND AL1 FOR ADDITIONAL QUANTITIES.
- ** REFER TO DSN1- DSN6 AND FOR ADDITIONAL QUANTITIES.
- 1. SEE EROSION CONTROL BLANKET PLACEMENT IN CHANNEL STANDARD PLAN I-60.20-00.
- 2. SEE GEOTEXTILE ENCASED CHECK DAM INSTALLATION STANDARD PLAN I-50.10-00.
- 3. SEE STORM DRAIN INLET PROTECTION STANDARD PLAN I-40.20-00.
- 4. SEE SILT FENCE STANDARD PLAN I-30.15-00.
- 5. SEE HIGH VISIBILITY FENCE STANDARD PLAN I-10.10-01.
- 6. SEE SHEET TECD1.
- 7. SEE SHEET TECD2.
- 8. REMOVE SCHEDULE A CULV. PIPE 12 IN. DIAM. DURING PHASE 4 OF CONSTRUCTION.

FOR "AS CONSTRUCTION PLANS" ONLY

DESIGNED BY	M. LAMAY	10/25/11	AD1 - DELETED ITEM	SMS	REGION NO.	STATE	FED. AID PROJ. NO.
ENTERED BY	M. MCREYNOLDS				10	WASH	
CHECKED BY	J. KORESKI						
PROJ. ENGR.	S. SPAHR				JOB NUMBER		
REGION ADM.	L. ENG				10A042		
		DATE	DATE	REVISION	CONTRACT NO.		

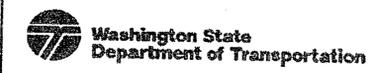

SR 9
SR 531/172ND ST NE & EAGLEFIELD DR.
INTERSECTION IMPROVEMENT & PAVING

QTEC 2

SHEET
43
OF
230
SHEETS



QUANTITY TABULATION - TEMPORARY EROSION CONTROL

LEGEND	
	CHECK DAM
	FORCE ACCOUNT STEEL PLATE CONSTRUCTION ENTRANCE
	ORDINARY HIGH WATER
	EXISTING CURB
	EXISTING FENCE
	EXISTING EDGE OF PAVEMENT
	EXISTING EDGE OF SHOULDER
	EXISTING GUTTER FACE
	EXISTING CATCH BASIN
	EXISTING MAN HOLE
	QUANTITY TABULATION
	INLET PROTECTION
	HIGH VISIBILITY FENCING
	SILT FENCE
	WSDOT LIMITED ACCESS
	WSDOT RW
	WETLAND SYMBOL
	EXISTING STORM SEWER
	EXISTING CULVERT
	WETLAND BOUNDARY
	WETLAND BUFFER
	EXISTING DITCH
	NEW DITCH
	TEMPORARY EROSION CONTROL BLANKET

GENERAL NOTES:

1. ERODIBLE EARTH CONSTRUCTED TO FINAL GRADES AND IN ACCORDANCE WITH THE PLANTING PLANS WILL BE CONSIDERED PERMANENTLY STABILIZED.
2. SOIL TACKIFIERS SHALL NOT BE USED ON AREAS TO BE TREATED BY THE CHITOSAN ENHANCED SAND FILTRATION (CESF) SYSTEM.
3. FORCE ACCOUNT STEEL PLATE CONSTRUCTION ENTRANCE LOCATIONS MAY BE REVISED TO FIT CONSTRUCTION ACTIVITIES.
4. REFER TO THIS SHEET FOR TYPICAL SILT FENCE PLACEMENT.
5. BREAKS IN HIGH VISIBILITY FENCE WILL BE ALLOWED FOR ACCESS TO AREAS IDENTIFIED AS "FOOT TRAFFIC ONLY", REFER TO ECP1 - ECP8


T. 31N. R. 5E. W.M.

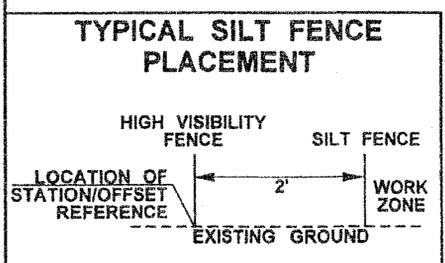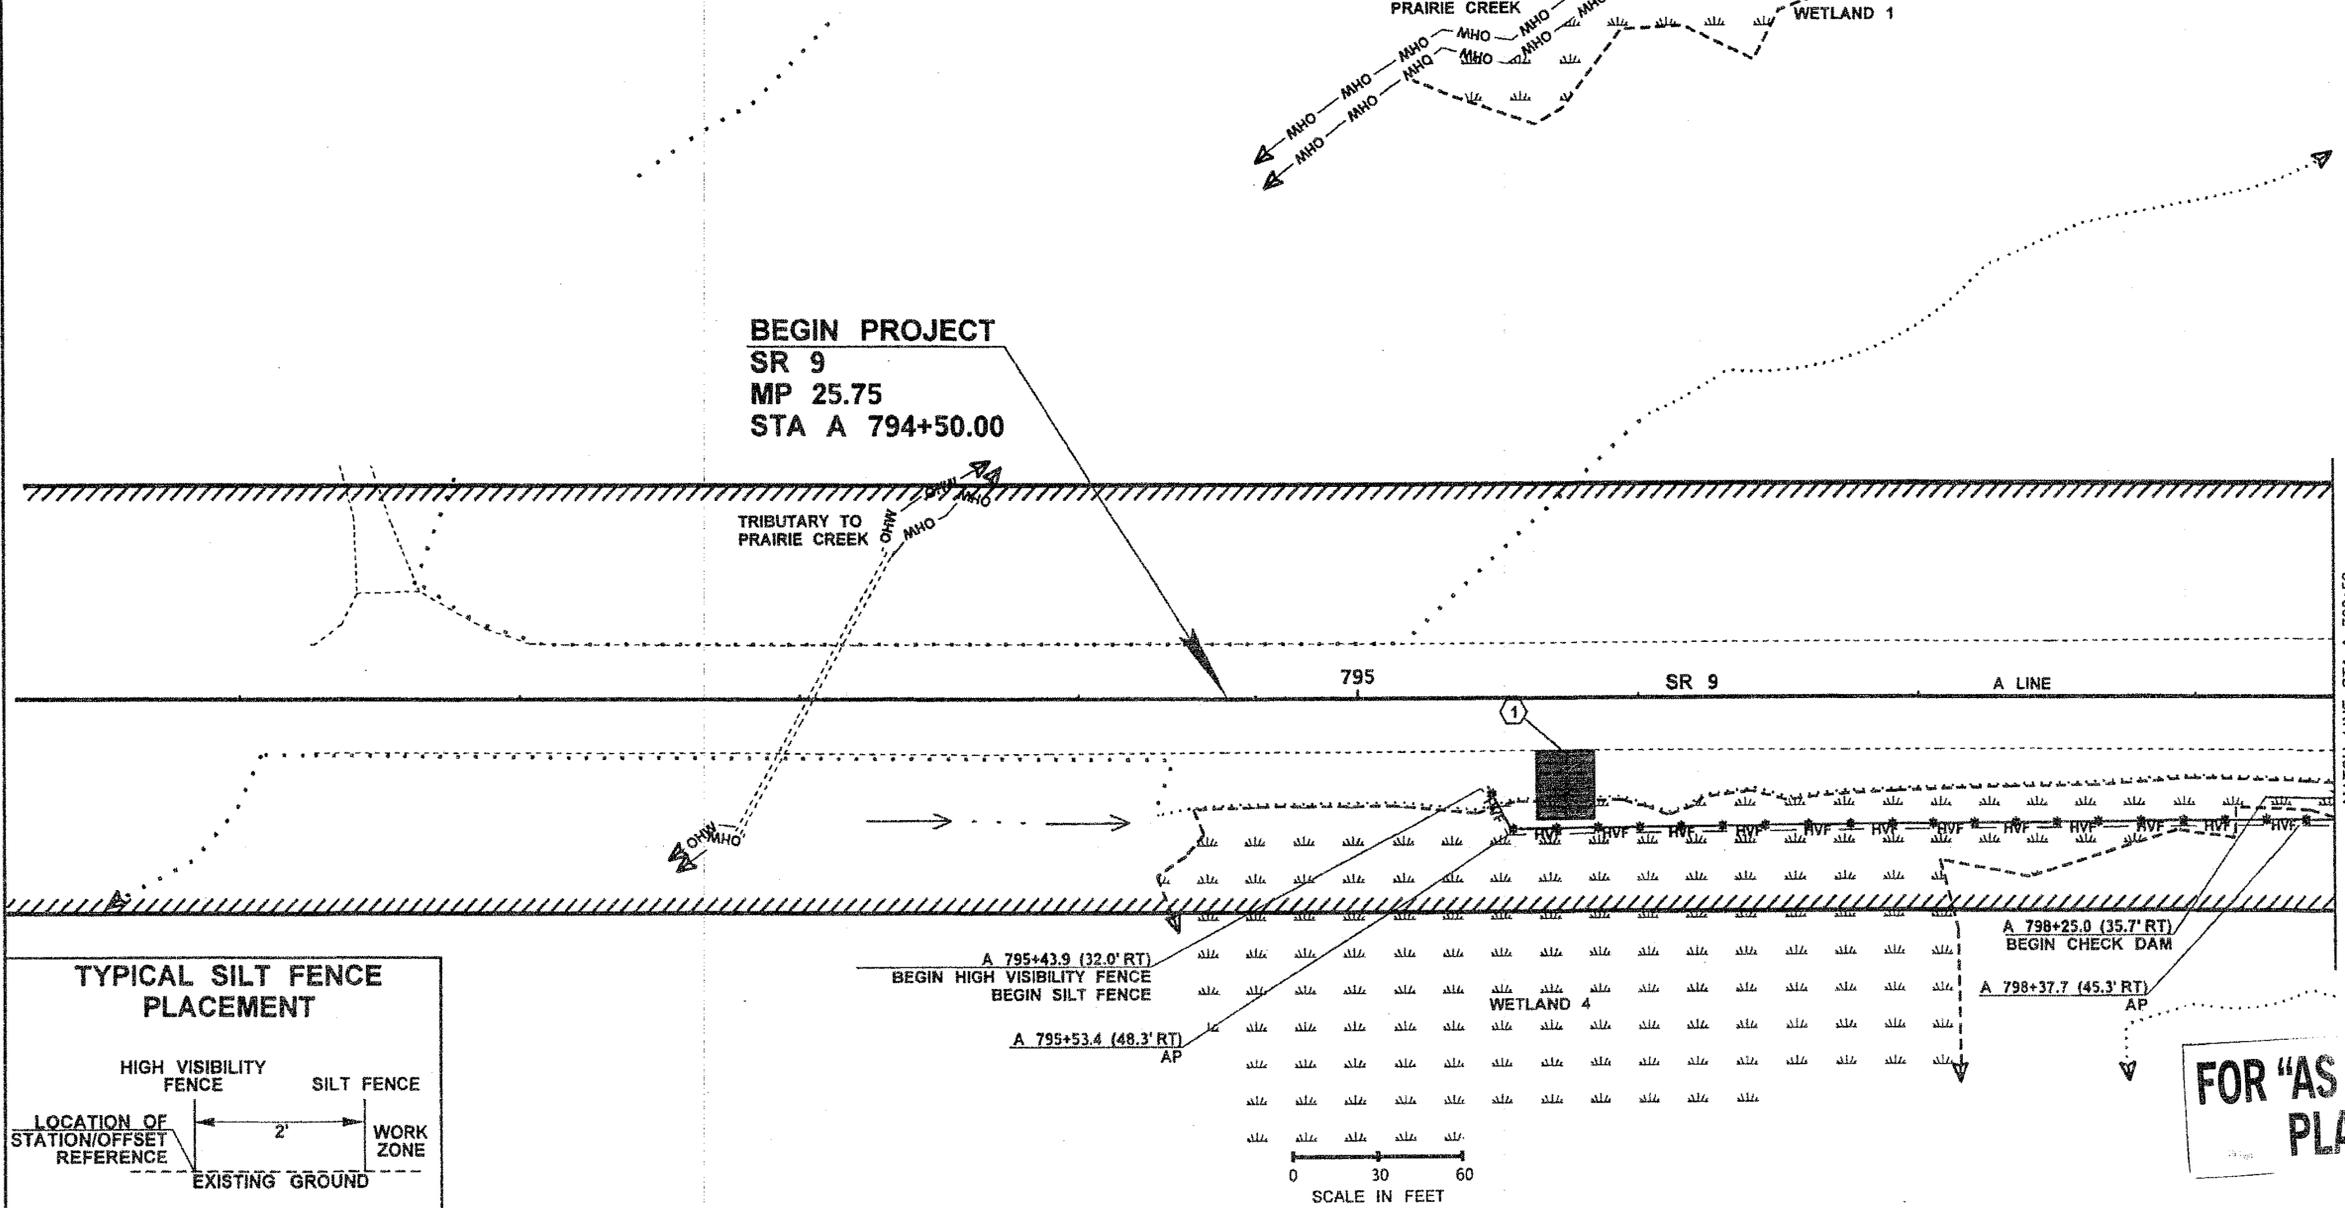

FOR "AS CONSTRUCTED PLANS" ONLY

FILE NAME	\\nwbrp\file01\412358\Projects\XL3325_SR9_SR531_172nd St NE IntCAD\PS&ESheets\XL3325_PS_TESC.dgn			REGION NO.	STATE	FED.AID PROJ.NO.	Washington State Department of Transportation	SR 9 SR 531/172ND ST NE & EAGLEFIELD DR INTERSECTION IMPROVEMENT & PAVING TEMPORARY EROSION CONTROL PLAN	Plot 1 PLAN REF NO TESC1 SHEET 44 OF 230 SHEETS
TIME	11:20:33 AM	AD1	REVISED LEGEND & GENERAL NOTES	10	WASH				
DATE	10/26/2011		10/25/2011	JOB NUMBER	10A042	LOCATION NO.			
PLOTTED BY	lamaymp			CONTRACT NO.					
DESIGNED BY	M. LAMAY								
ENTERED BY	K. SOLWOLD								
CHECKED BY	J. KORESKE								
PROJ. ENGR.	S. SPAHR								
REGIONAL ADM.	L. ENG	REVISION	DATE	BY					

T. 31N. R. 5E. W.M.

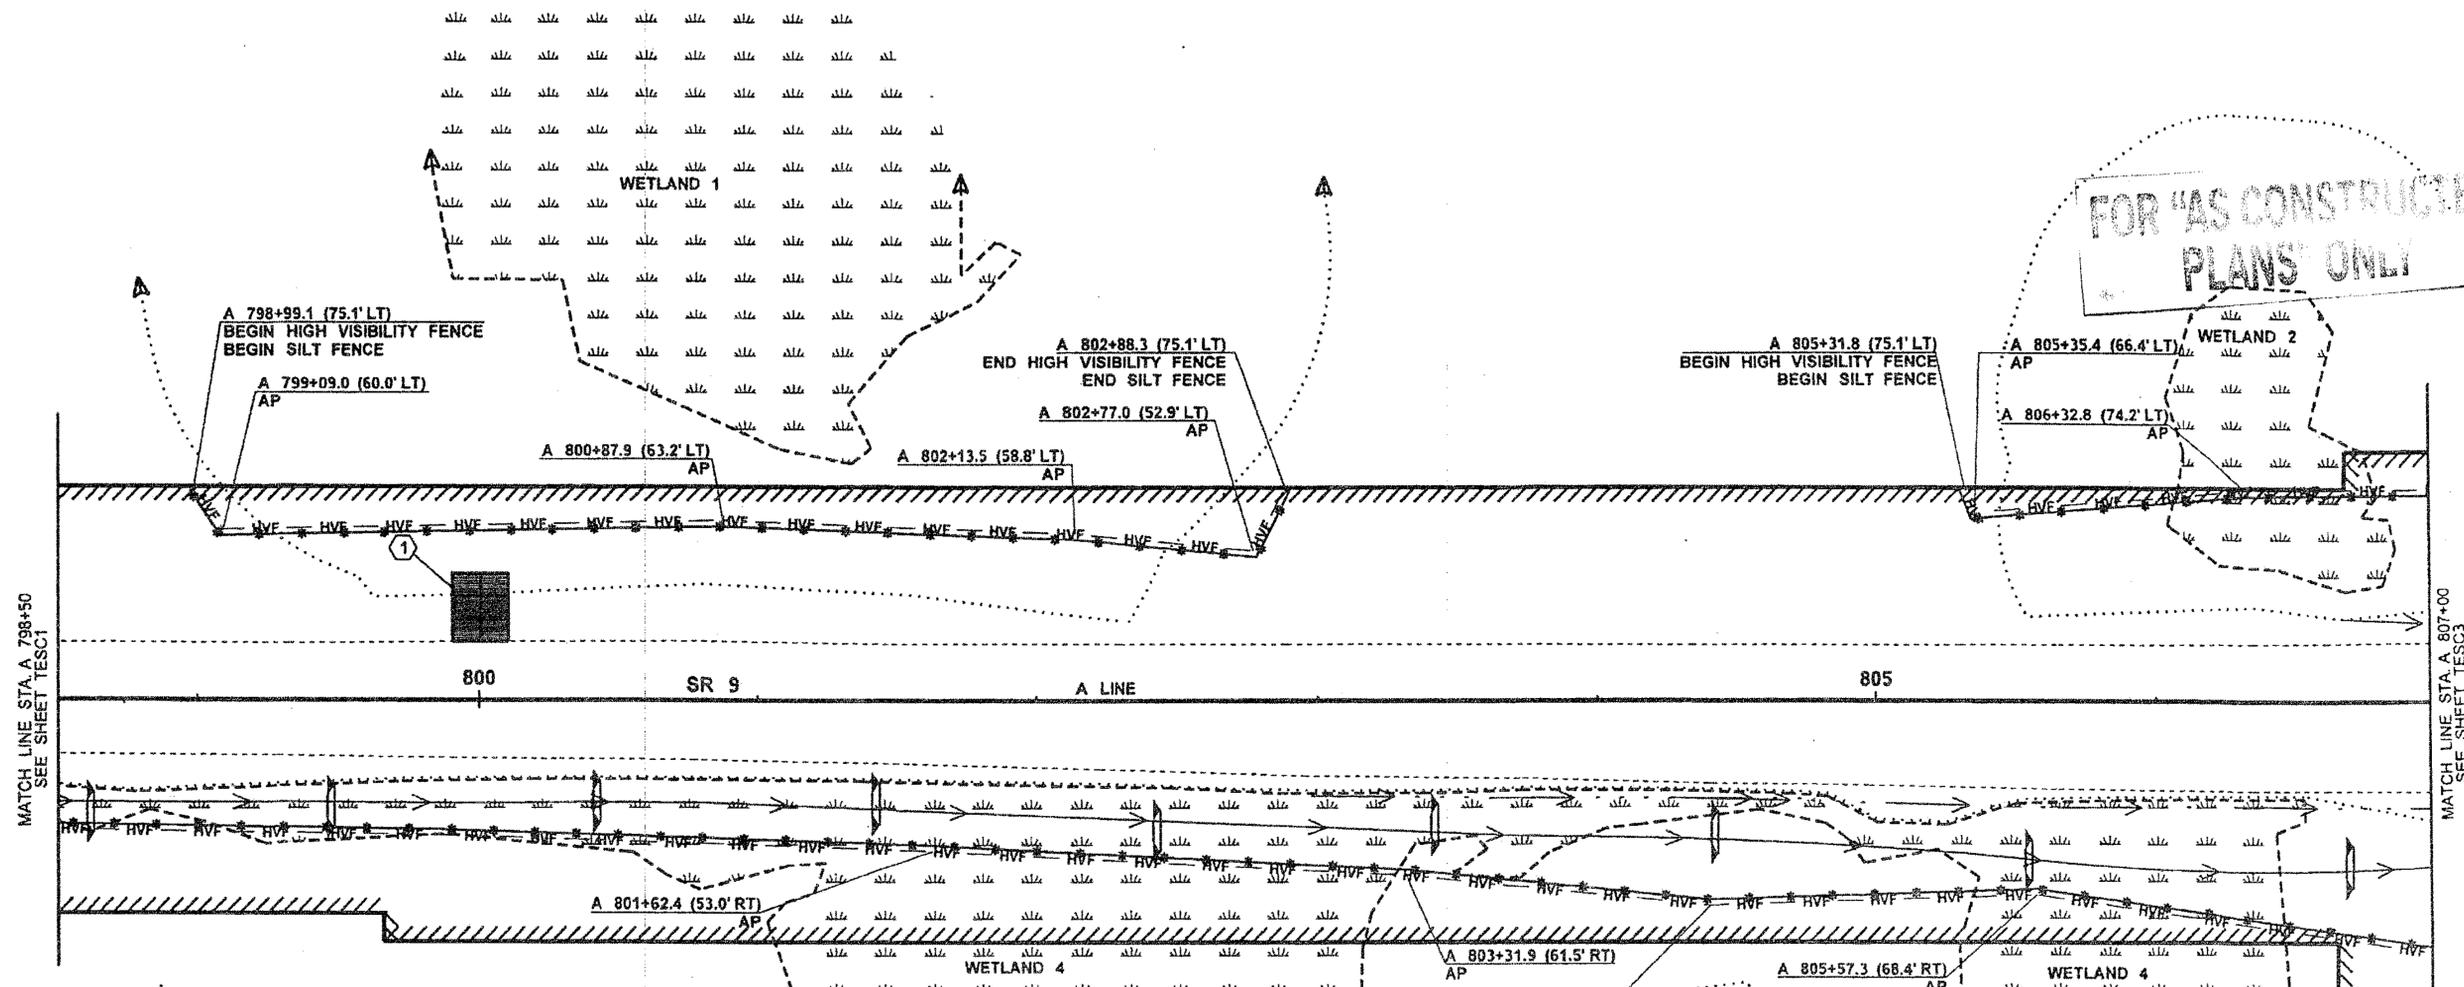

FOR "AS CONSTRUCTED PLANS" ONLY


MATCH LINE STA. A 798+50
SEE SHEET TESC1

MATCH LINE STA. A 807+00
SEE SHEET TESC3

LEGEND

CHECK DAM	QUANTITY TABULATION
FORCE ACCOUNT STEEL PLATE CONSTRUCTION ENTRANCE	INLET PROTECTION
ORDINARY HIGH WATER	HIGH VISIBILITY FENCING
EXISTING CURB	SILT FENCE
EXISTING FENCE	WSDOT LIMITED ACCESS
EXISTING EDGE OF PAVEMENT	WSDOT R/W
EXISTING EDGE OF SHOULDER	WETLAND SYMBOL
EXISTING GUTTER FACE	EXISTING STORM SEWER
EXISTING CATCH BASIN	EXISTING CULVERT
EXISTING MAN HOLE	WETLAND BOUNDARY
	WETLAND BUFFER
	EXISTING DITCH
	NEW DITCH
	TEMPORARY EROSION CONTROL BLANKET

- GENERAL NOTES:**
1. ERODIBLE EARTH CONSTRUCTED TO FINAL GRADES AND IN ACCORDANCE WITH THE PLANTING PLANS WILL BE CONSIDERED PERMANENTLY STABILIZED.
 2. SOIL TACKIFIERS SHALL NOT BE USED ON AREAS TO BE TREATED BY THE CHITOSAN ENHANCED SAND FILTRATION (CESF) SYSTEM.
 3. FORCE ACCOUNT STEEL PLATE CONSTRUCTION ENTRANCE LOCATIONS MAY BE REVISED TO FIT CONSTRUCTION ACTIVITIES.
 4. REFER TO THIS SHEET FOR TYPICAL SILT FENCE PLACEMENT.
 5. BREAKS IN HIGH VISIBILITY FENCE WILL BE ALLOWED FOR ACCESS TO AREAS IDENTIFIED AS "FOOT TRAFFIC ONLY", REFER TO ECP1 - ECP8

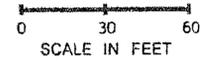


FILE NAME	\\nwbrj\pfile014123581\Projects\XL3325 SR9 SR531 172nd St NE In\CAD\PS&ESheets\XL3325 PS TESC.dgn			REGION NO.	STATE	FED.AID PROJ.NO.	Washington State Department of Transportation	SR 9	Plot 2
TIME	11:20:34 AM	AD1	REVISED LEGEND & GENERAL NOTES	10	WASH			SR 531/172ND ST NE & EAGLEFIELD DR	PLAN REF NO
DATE	10/26/2011							TESC2	
DESIGNED BY	M. LAMAY							SHEET	
ENTERED BY	K. SOLWOLD							45	
CHECKED BY	J. KORESKE							OF	
PROJ. ENGR.	S. SPAHR							230	
REGIONAL ADM.	L. ENG	REVISION	DATE	BY				SHEETS	

TEMPORARY EROSION CONTROL PLAN

GENERAL NOTES:

1. ERODIBLE EARTH CONSTRUCTED TO FINAL GRADES AND IN ACCORDANCE WITH THE PLANTING PLANS WILL BE CONSIDERED PERMANENTLY STABILIZED.
2. SOIL TACKIFIERS SHALL NOT BE USED ON AREAS TO BE TREATED BY THE CHITOSAN ENHANCED SAND FILTRATION (CESF) SYSTEM.
3. FORCE ACCOUNT STEEL PLATE CONSTRUCTION ENTRANCE LOCATIONS MAY BE REVISED TO FIT CONSTRUCTION ACTIVITIES.
4. REFER TO THIS SHEET FOR TYPICAL SILT FENCE PLACEMENT.
5. BREAKS IN HIGH VISIBILITY FENCE WILL BE ALLOWED FOR ACCESS TO AREAS IDENTIFIED AS "FOOT TRAFFIC ONLY", REFER TO ECP1 - ECP8

T. 31N. R. 5E. W.M.

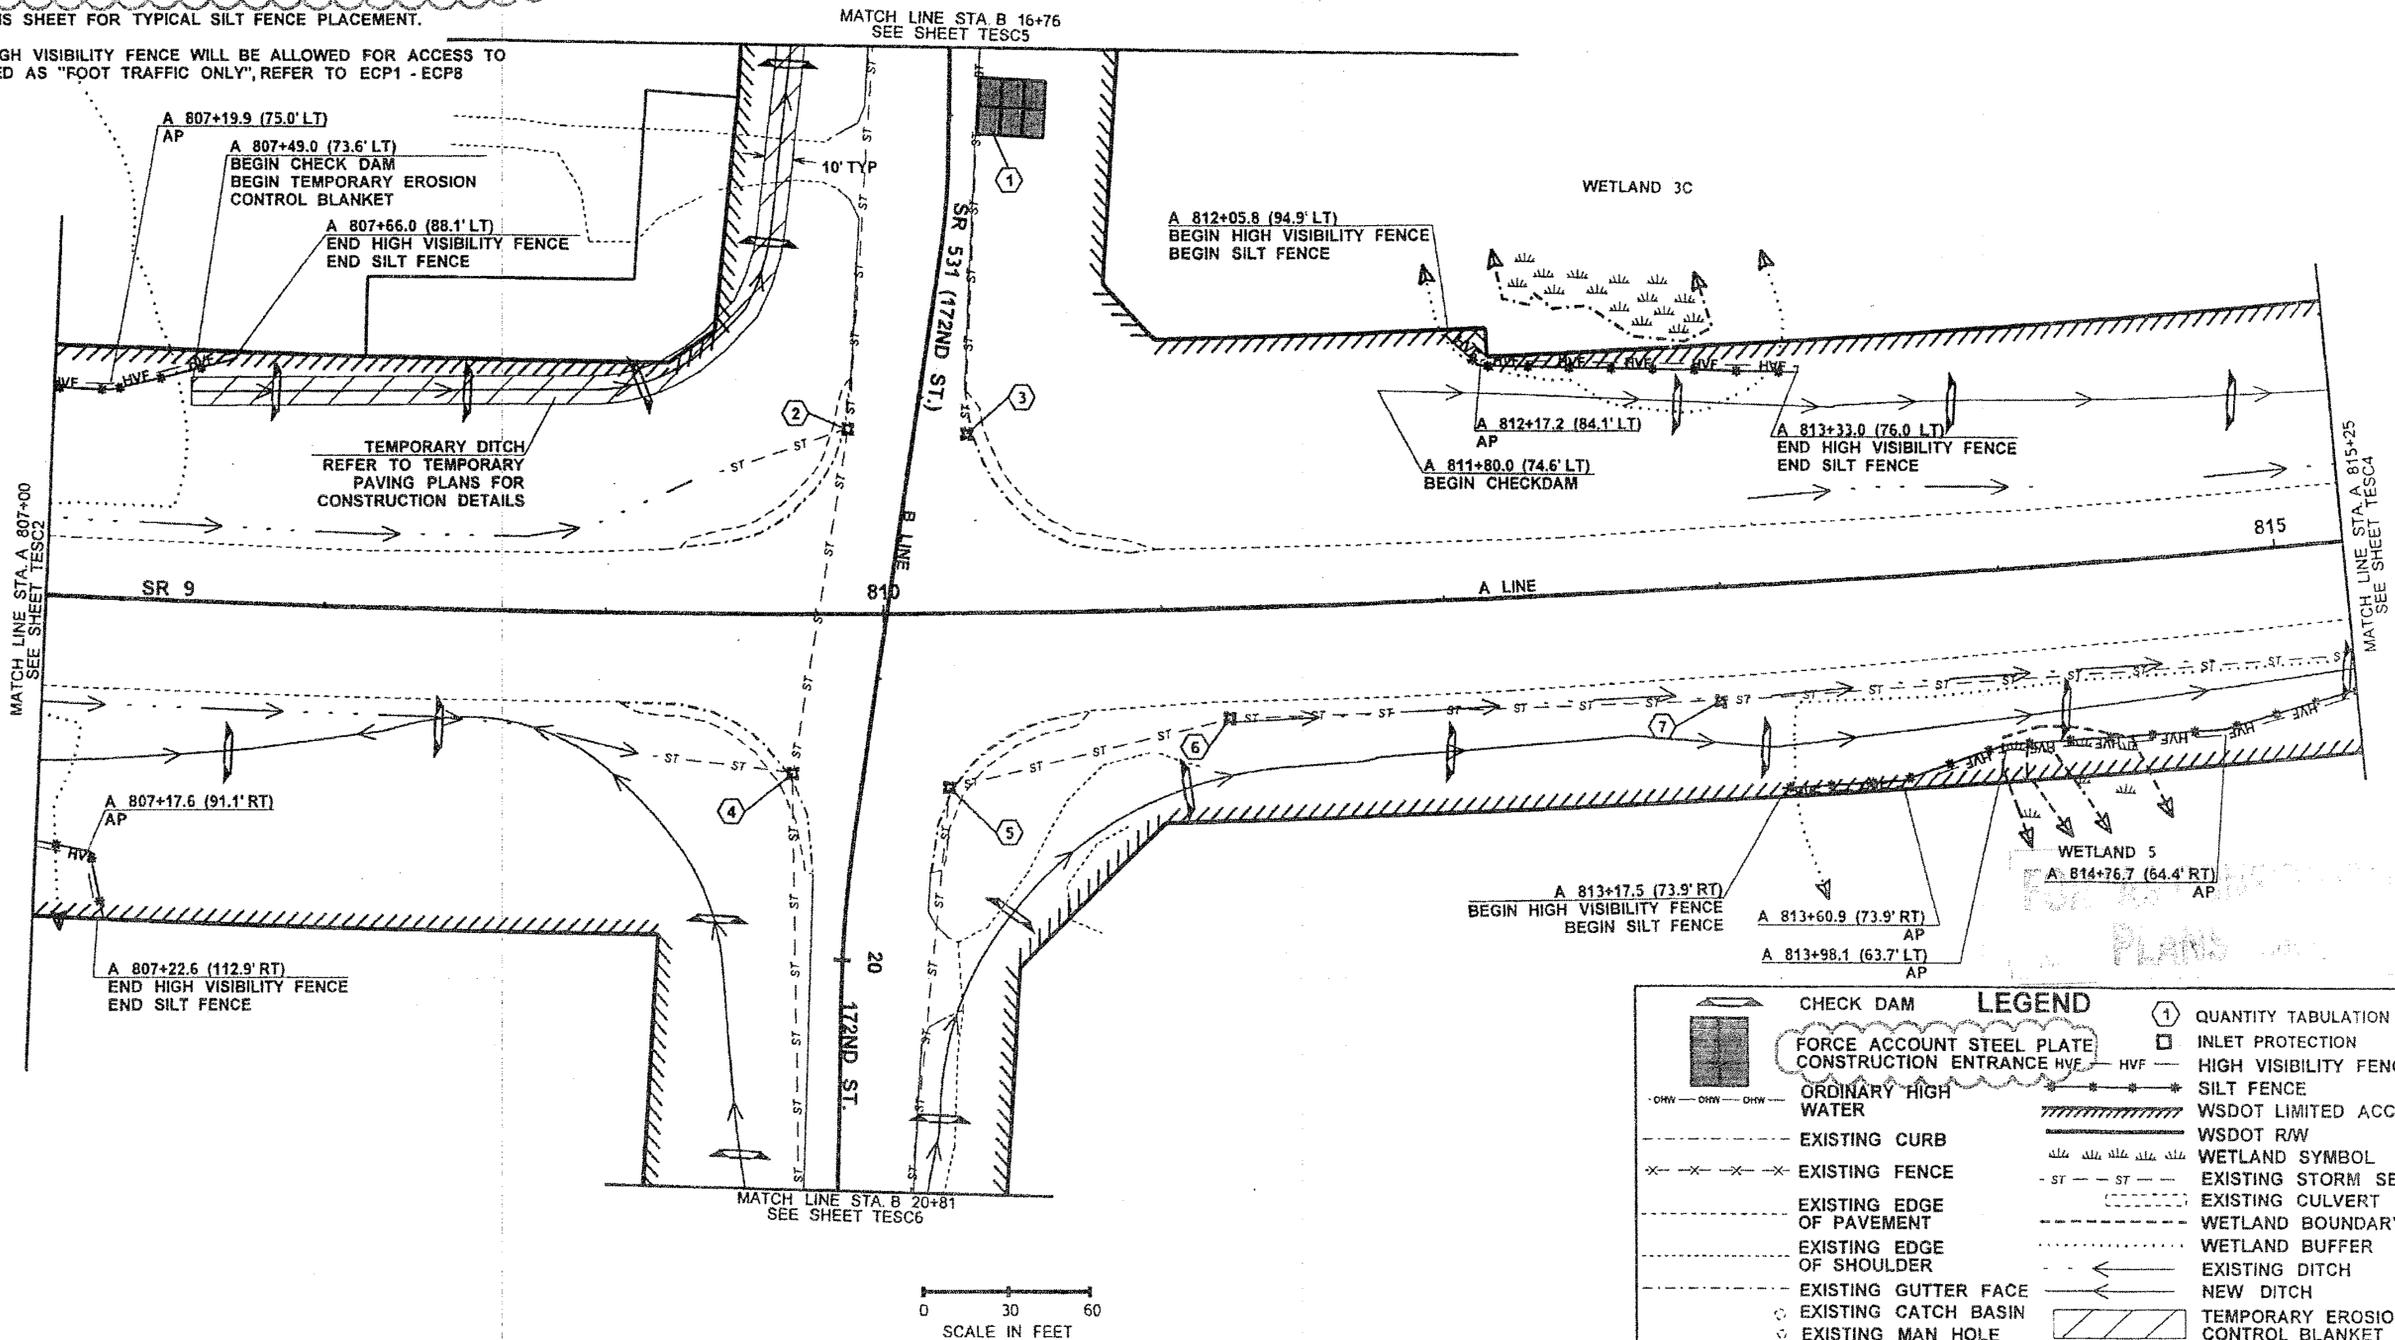


LEGEND	
	CHECK DAM
	FORCE ACCOUNT STEEL PLATE CONSTRUCTION ENTRANCE
	ORDINARY HIGH WATER
	EXISTING CURB
	EXISTING FENCE
	EXISTING EDGE OF PAVEMENT
	EXISTING EDGE OF SHOULDER
	EXISTING GUTTER FACE
	EXISTING CATCH BASIN
	EXISTING MAN HOLE
	QUANTITY TABULATION
	INLET PROTECTION
	HIGH VISIBILITY FENCING
	SILT FENCE
	WSDOT LIMITED ACCESS
	WSDOT R/W
	WETLAND SYMBOL
	EXISTING STORM SEWER
	EXISTING CULVERT
	WETLAND BOUNDARY
	WETLAND BUFFER
	EXISTING DITCH
	NEW DITCH
	TEMPORARY EROSION CONTROL BLANKET

FILE NAME	\\nwbrpfile01\412358\Projects\XL3325_SR9_SR531_172nd_St_NE_Int\CAD\PS&ESheets\XL3325_PS_TESC.dgn			REGION NO.	STATE	FED.AID PROJ.NO.	 Washington State Department of Transportation	SR 9	SR 531/172ND ST NE & EAGLEFIELD DR INTERSECTION IMPROVEMENT & PAVING	PLAN REF NO
TIME	11:20:36 AM	AD1 - REVISED LEGEND & GENERAL NOTES	10/25/2011 SMS	10	WASH			TESC3		
DATE	10/26/2011									SHEET
PLOTTED BY	lamaymp									46
DESIGNED BY	M. LAMAY									OF
ENTERED BY	K. SOLWOLD									230
CHECKED BY	J. KORESKI									SHEETS
PROJ. ENGR.	S. SPAHR									
REGIONAL ADM.	L. ENG	REVISION	DATE	BY						

T. 31N. R. 5E. W.M.


BEGIN CONSTRUCTION
SR 531
MP 9.73
STA B 10+53.80

FOR 'AS CONSTRUCTED'
 PLANS ONLY

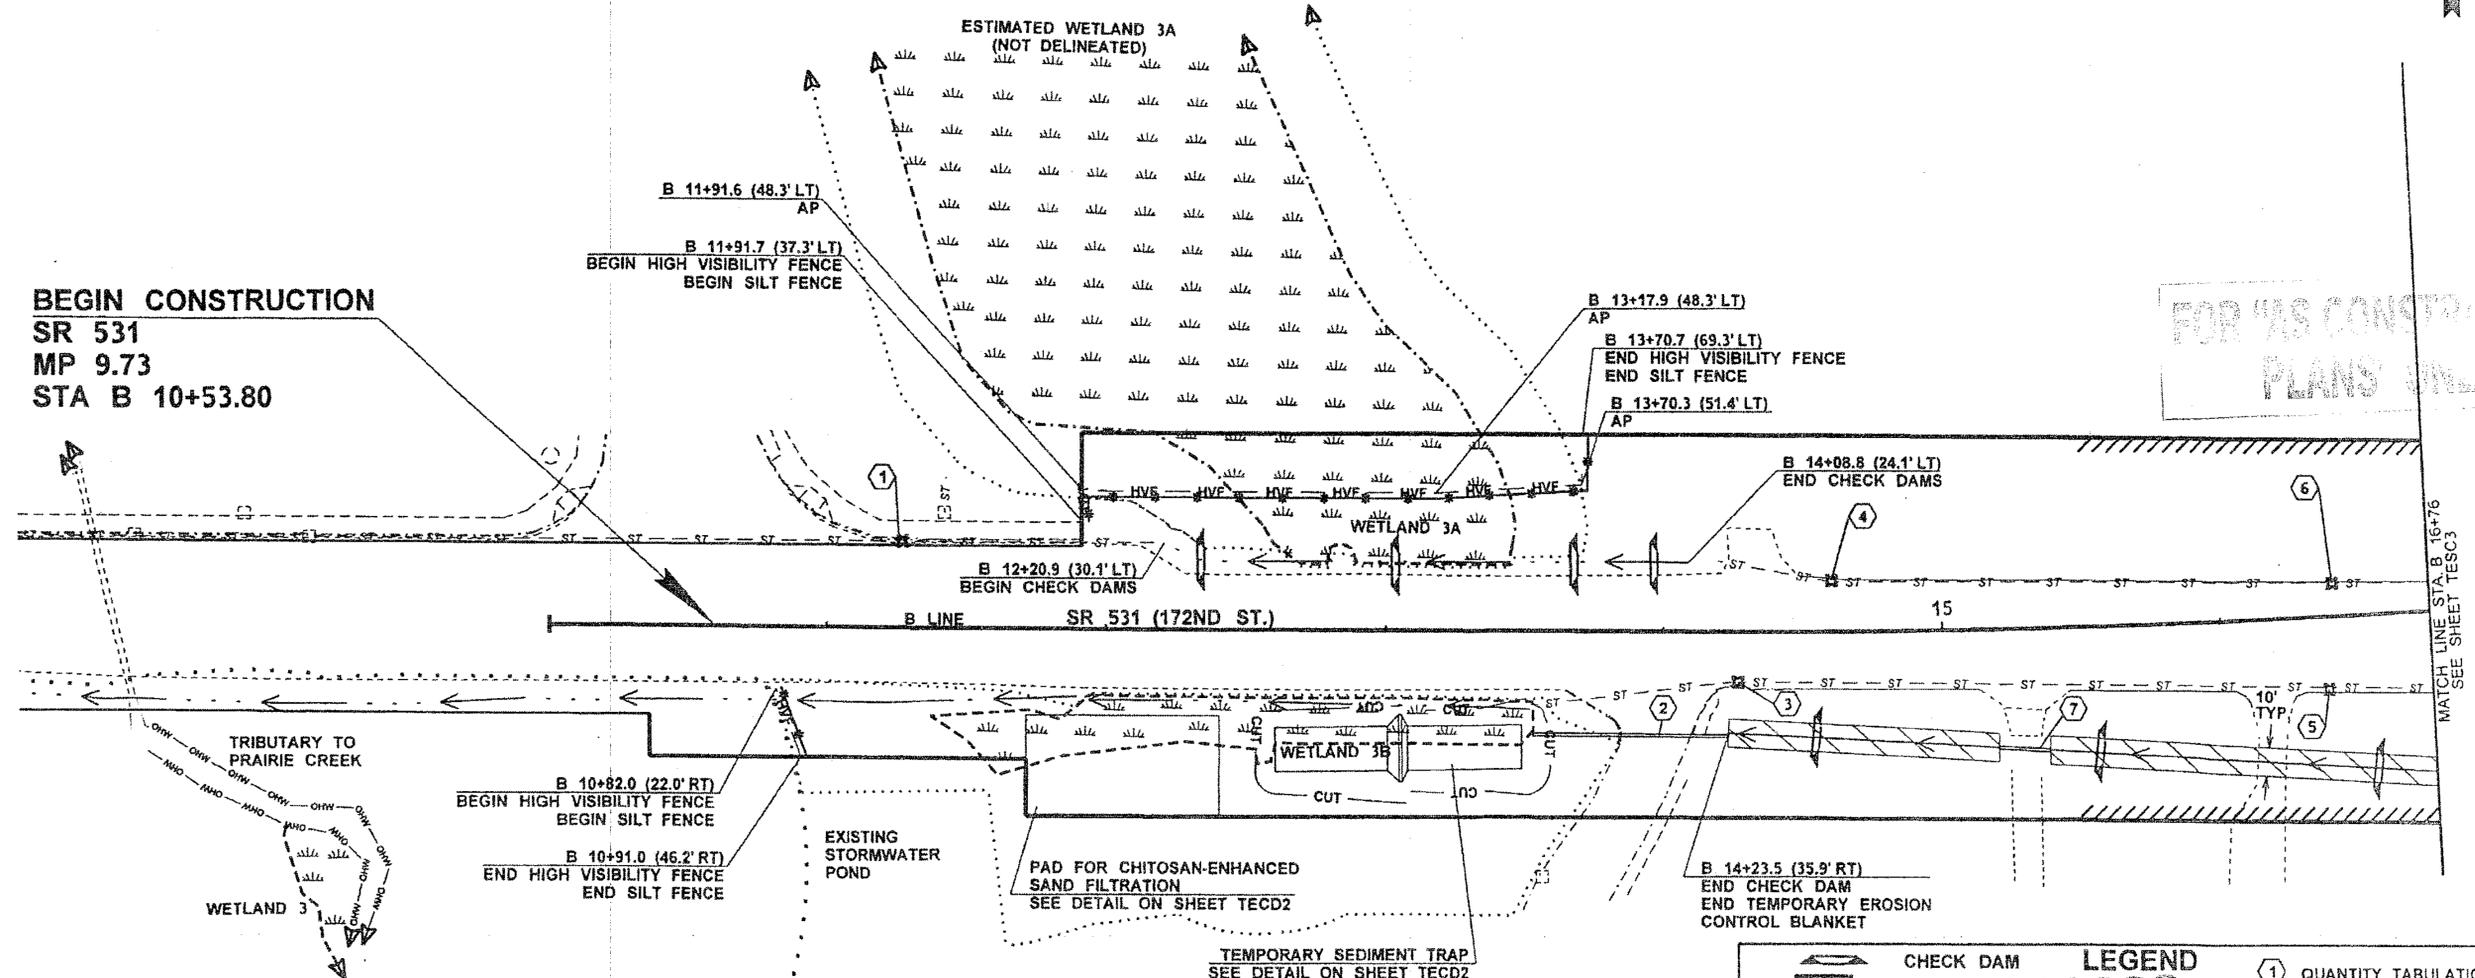

GENERAL NOTES:

1. ERODIBLE EARTH CONSTRUCTED TO FINAL GRADES AND IN ACCORDANCE WITH THE PLANTING PLANS WILL BE CONSIDERED PERMANENTLY STABILIZED.
2. SOIL TACKIFIERS SHALL NOT BE USED ON AREAS TO BE TREATED BY THE CHITOSAN ENHANCED SAND FILTRATION (CESF) SYSTEM.
3. FORCE ACCOUNT STEEL PLATE CONSTRUCTION ENTRANCE LOCATIONS MAY BE REVISED TO FIT CONSTRUCTION ACTIVITIES.
4. REFER TO THIS SHEET FOR TYPICAL SILT FENCE PLACEMENT.
5. BREAKS IN HIGH VISIBILITY FENCE WILL BE ALLOWED FOR ACCESS TO AREAS IDENTIFIED AS "FOOT TRAFFIC ONLY", REFER TO ECP1 - ECP8

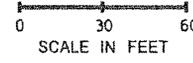

CHECK DAM		LEGEND	
	FORCE ACCOUNT STEEL PLATE CONSTRUCTION ENTRANCE		QUANTITY TABULATION
	ORDINARY HIGH WATER		INLET PROTECTION
	EXISTING CURB		HIGH VISIBILITY FENCING
	EXISTING FENCE		SILT FENCE
	EXISTING EDGE OF PAVEMENT		WSDOT LIMITED ACCESS
	EXISTING EDGE OF SHOULDER		WSDOT R/W
	EXISTING GUTTER FACE		WETLAND SYMBOL
	EXISTING CATCH BASIN		EXISTING STORM SEWER
	EXISTING MAN HOLE		EXISTING CULVERT
			WETLAND BOUNDARY
			WETLAND BUFFER
			EXISTING DITCH
			NEW DITCH
			TEMPORARY EROSION CONTROL BLANKET

FILE NAME: \\nwbrp\file01\4123581\Projects\XL3325_SR9_SR531_172nd_St_NE_Int\CAD\PS&ESheets\XL3325_PS_TESC.dgn	AD1 - REVISED LEGEND & GENERAL NOTES 10/25/2011 SMS	REGION NO. 10	STATE WASH	FED.AID PROJ.NO.	DATE	DATE	<p>Washington State Department of Transportation</p>	SR 9 SR 531/172ND ST NE & EAGLEFIELD DR INTERSECTION IMPROVEMENT & PAVING TEMPORARY EROSION CONTROL PLAN	Plot 5
TIME: 11:20:38 AM		JOB NUMBER: 10A042	CONTRACT NO.	LOCATION NO.	P.E. STAMP BOX	P.E. STAMP BOX			PLAN REF NO: TESC5
DATE: 10/26/2011									
PLOTTED BY: lamaymp									
DESIGNED BY: M. LAMAY									
ENTERED BY: K. SOLWOLD									
CHECKED BY: J. KORESKE									
PROJ. ENGR: S. SPAHR									
REGIONAL ADM: L. ENG	REVISION	DATE	BY						

GENERAL NOTES:


1. ERODIBLE EARTH CONSTRUCTED TO FINAL GRADES AND IN ACCORDANCE WITH THE PLANTING PLANS WILL BE CONSIDERED PERMANENTLY STABILIZED.

2. SOIL TACKIFIERS SHALL NOT BE USED ON AREAS TO BE TREATED BY THE CHITOSAN ENHANCED SAND FILTRATION (CESF) SYSTEM.

3. FORCE ACCOUNT STEEL PLATE CONSTRUCTION ENTRANCE LOCATIONS MAY BE REVISED TO FIT CONSTRUCTION ACTIVITIES.


4. REFER TO THIS SHEET FOR TYPICAL SILT FENCE PLACEMENT.

5. BREAKS IN HIGH VISIBILITY FENCE WILL BE ALLOWED FOR ACCESS TO AREAS IDENTIFIED AS "FOOT TRAFFIC ONLY", REFER TO ECP1 - ECP8

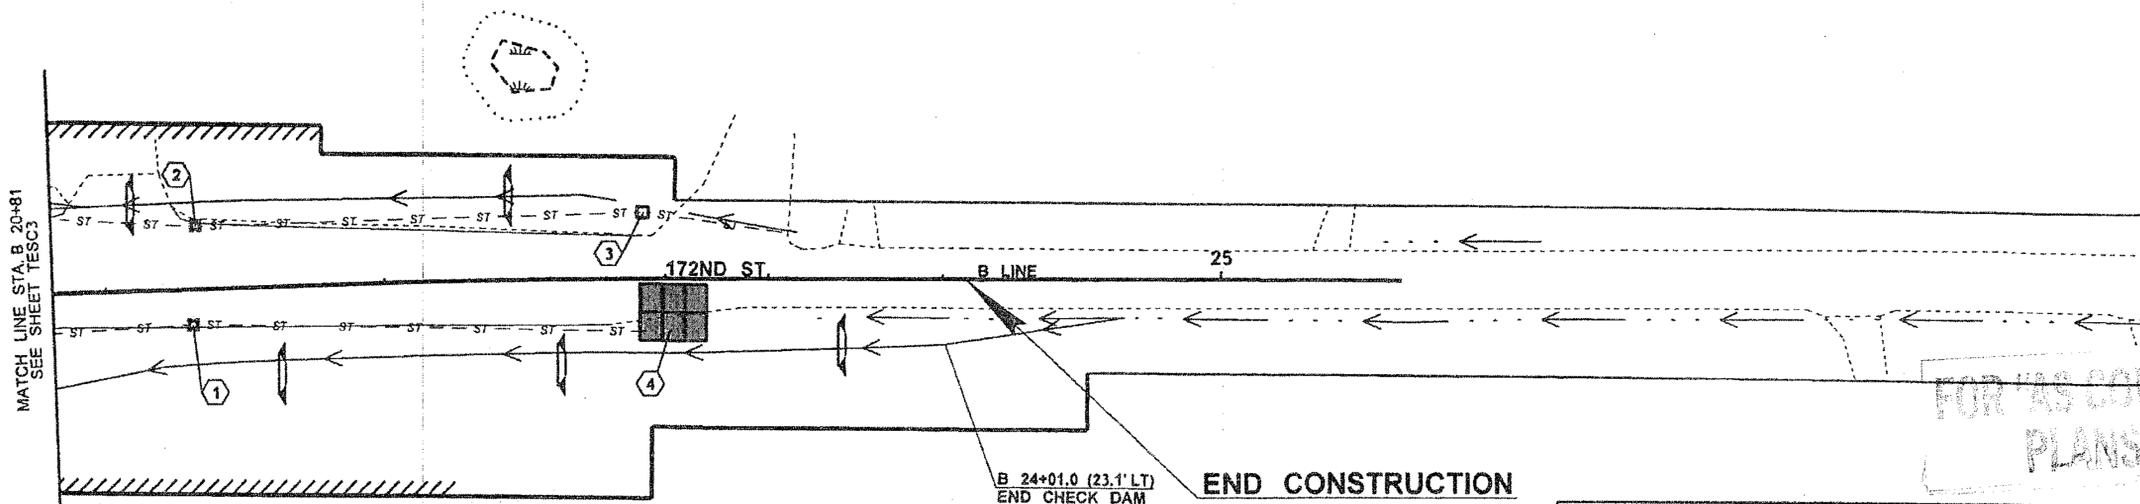

FOR AS CONSTRUCTED PLANS ONLY


END CONSTRUCTION
172ND ST.
STA B 24+02.00

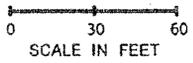

LEGEND	
	CHECK DAM
	FORCE ACCOUNT STEEL PLATE CONSTRUCTION ENTRANCE
	ORDINARY HIGH WATER
	EXISTING CURB
	EXISTING FENCE
	EXISTING EDGE OF PAVEMENT
	EXISTING EDGE OF SHOULDER
	EXISTING GUTTER FACE
	EXISTING CATCH BASIN
	EXISTING MAN HOLE
	QUANTITY TABULATION
	INLET PROTECTION
	HIGH VISIBILITY FENCING
	SILT FENCE
	WSDOT LIMITED ACCESS
	WSDOT R/W
	WETLAND SYMBOL
	EXISTING STORM SEWER
	EXISTING CULVERT
	WETLAND BOUNDARY
	WETLAND BUFFER
	EXISTING DITCH
	NEW DITCH
	TEMPORARY EROSION CONTROL BLANKET


FILE NAME	\\nwbrpfile01\412358\Projects\XL3325_SR9_SR531_172nd_St_NE_Int\CAD\PS&ESheets\XL3325_PS_TESC.dgn			REGION NO.	STATE	FED.AID PROJ.NO.	Washington State Department of Transportation	SR 9 SR 531/172ND ST NE & EAGLEFIELD DR INTERSECTION IMPROVEMENT & PAVING	TEMPORARY EROSION CONTROL PLAN	Plot 6
TIME	11:20:40 AM	AD1 - REVISED LEGEND & GENERAL NOTES	10/25/2011	SMS	10	WASH				PLAN REF NO TESC6
DATE	10/26/2011									SHEET
PLOTTED BY	lamaymp									49
DESIGNED BY	M. LAMAY									OF
ENTERED BY	K. SOLWOLD									230
CHECKED BY	J. KORESKI									SHEETS
PROJ. ENGR.	S. SPAHR									
REGIONAL ADM.	L. ENG	REVISION	DATE	BY						

LEGEND	
	CHECK DAM
	FORCE ACCOUNT STEEL PLATE CONSTRUCTION ENTRANCE HVE
	ORDINARY HIGH WATER
	EXISTING CURB
	EXISTING FENCE
	EXISTING EDGE OF PAVEMENT
	EXISTING EDGE OF SHOULDER
	EXISTING GUTTER FACE
	EXISTING CATCH BASIN
	EXISTING MAN HOLE
	QUANTITY TABULATION
	INLET PROTECTION
	HIGH VISIBILITY FENCING
	SILT FENCE
	WSDOT LIMITED ACCESS
	WSDOT R/W
	WETLAND SYMBOL
	EXISTING STORM SEWER
	EXISTING CULVERT
	WETLAND BOUNDARY
	WETLAND BUFFER
	EXISTING DITCH
	NEW DITCH
	TEMPORARY EROSION CONTROL BLANKET

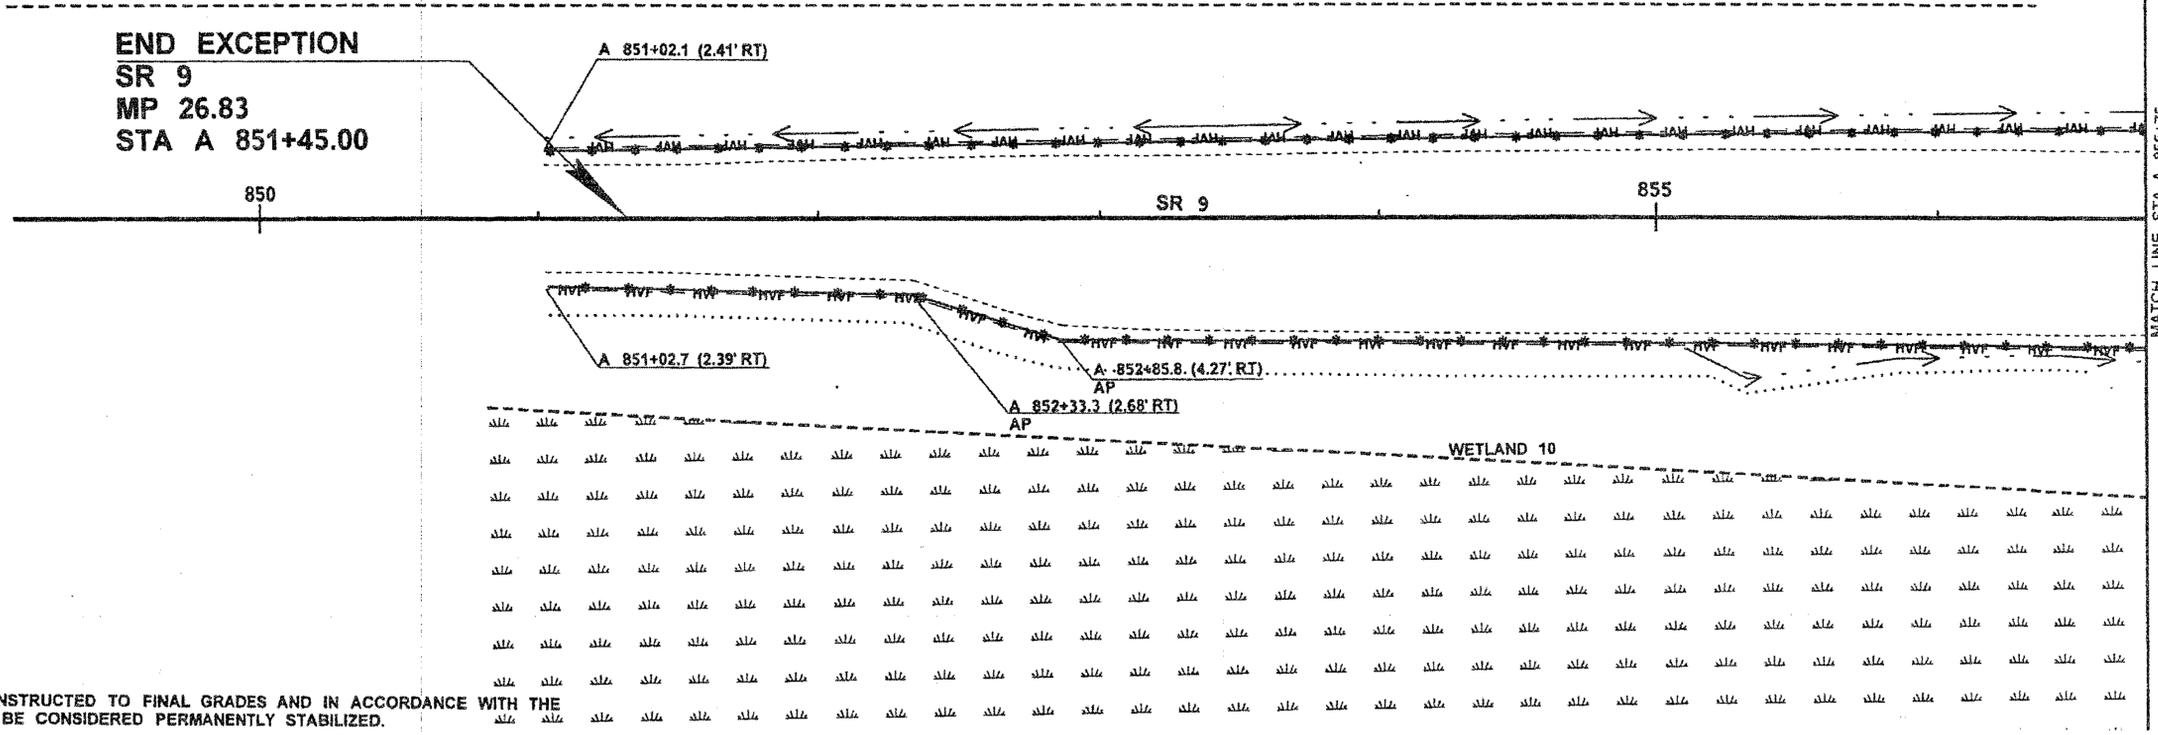

- GENERAL NOTES:
1. ERODIBLE EARTH CONSTRUCTED TO FINAL GRADES AND IN ACCORDANCE WITH THE PLANTING PLANS WILL BE CONSIDERED PERMANENTLY STABILIZED.
 2. SOIL TACKIFIERS SHALL NOT BE USED ON AREAS TO BE TREATED BY THE CHITOSAN ENHANCED SAND FILTRATION (CESF) SYSTEM.
 3. FORCE ACCOUNT STEEL PLATE CONSTRUCTION ENTRANCE LOCATIONS MAY BE REVISED TO FIT CONSTRUCTION ACTIVITIES.
 4. REFER TO THIS SHEET FOR TYPICAL SILT FENCE PLACEMENT.
 5. BREAKS IN HIGH VISIBILITY FENCE WILL BE ALLOWED FOR ACCESS TO AREAS IDENTIFIED AS "FOOT TRAFFIC ONLY", REFER TO ECP1 - ECP8

FOR "AS CONSTRUCTED PLANS" ONLY

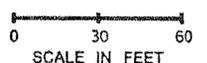


FILE NAME	\\nwbrpfile01\412358\Projects\XL3325_SR9_SR531_172nd_St_NE_Int\CAD\PS&ESheets\XL3325_PS_TESC.dgn			REGION NO.	STATE	FED.AID PROJ.NO.	Washington State Department of Transportation	SR 9	Plot 7
TIME	11:20:41 AM	AD1	REVISED LEGEND & GENERAL NOTES	10	WASH			SR 531/172ND ST NE & EAGLEFIELD DR	TESC7
DATE	10/26/2011							INTERSECTION IMPROVEMENT & PAVING	
PLOTTED BY	lamaymp								
DESIGNED BY	M. LAMAY								
ENTERED BY	K. SOLWOLD								
CHECKED BY	J. KORESKE								
PROJ. ENGR.	S. SPAHR								
REGIONAL ADM.	L. ENG							TEMPORARY EROSION CONTROL PLAN	SHEET 50 OF 230 SHEETS
		REVISION	DATE	BY					

GENERAL NOTES:

1. ERODIBLE EARTH CONSTRUCTED TO FINAL GRADES AND IN ACCORDANCE WITH THE PLANTING PLANS WILL BE CONSIDERED PERMANENTLY STABILIZED.
2. SOIL TACKIFIERS SHALL NOT BE USED ON AREAS TO BE TREATED BY THE CHITOSAN ENHANCED SAND FILTRATION (CESF) SYSTEM.
3. FORCE ACCOUNT STEEL PLATE CONSTRUCTION ENTRANCE LOCATIONS MAY BE REVISED TO FIT CONSTRUCTION ACTIVITIES.
4. REFER TO THIS SHEET FOR TYPICAL SILT FENCE PLACEMENT.
5. BREAKS IN HIGH VISIBILITY FENCE WILL BE ALLOWED FOR ACCESS TO AREAS IDENTIFIED AS "FOOT TRAFFIC ONLY", REFER TO ECP1 - ECP8


LEGEND	
	CHECK DAM
	FORCE ACCOUNT STEEL PLATE CONSTRUCTION ENTRANCE
	ORDINARY HIGH WATER
	EXISTING CURB
	EXISTING FENCE
	EXISTING EDGE OF PAVEMENT
	EXISTING EDGE OF SHOULDER
	EXISTING GUTTER FACE
	EXISTING CATCH BASIN
	EXISTING MAN HOLE
	QUANTITY TABULATION
	INLET PROTECTION
	HIGH VISIBILITY FENCING
	SILT FENCE
	WSDOT LIMITED ACCESS
	WSDOT R/W
	WETLAND SYMBOL
	EXISTING STORM SEWER
	EXISTING CULVERT
	WETLAND BOUNDARY
	WETLAND BUFFER
	EXISTING DITCH
	NEW DITCH
	TEMPORARY EROSION CONTROL BLANKET

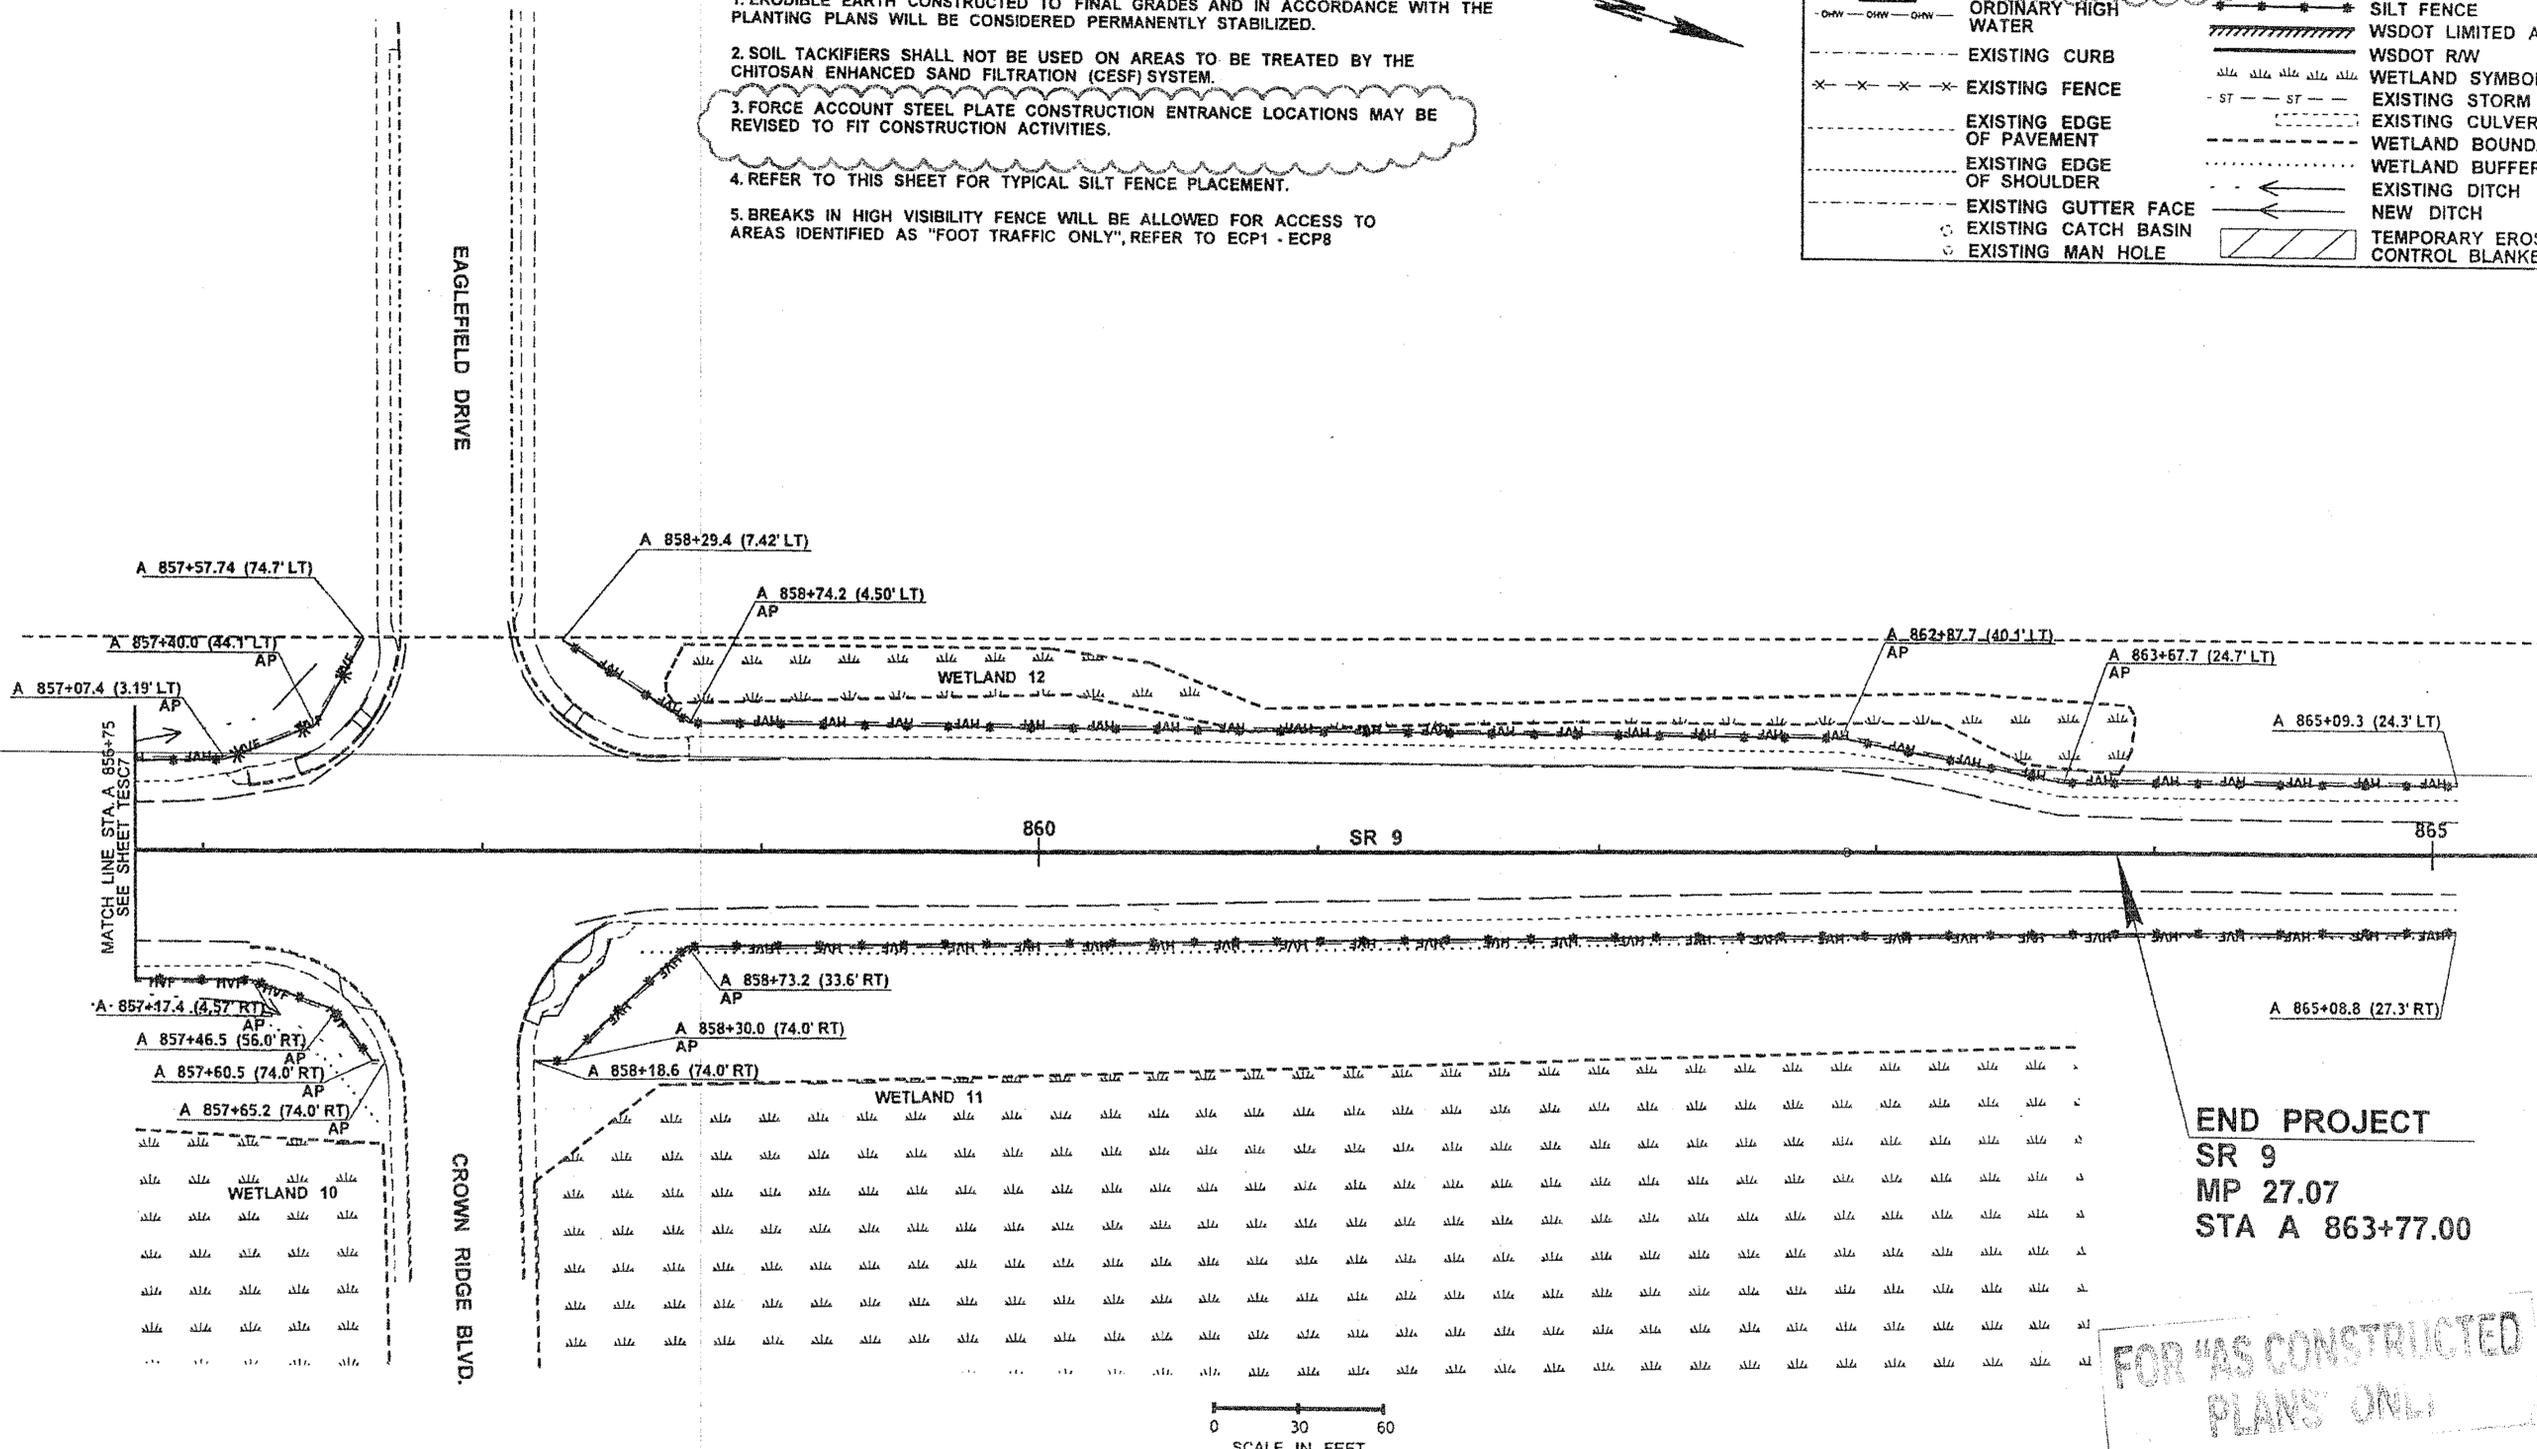



END PROJECT
SR 9
MP 27.07
STA A 863+77.00

FOR "AS CONSTRUCTED
PLANS ONLY

FILE NAME	\\nwbrl\pfile01\4123581\Projects\XL3325 SR9 SR531 172nd St NE Int\CADIPS&ESheets\XL3325 PS TESC.dgn			REGION NO.	10	STATE	WASH	FED.AID PROJ.NO.		<p>Washington State Department of Transportation</p>	SR 9	Plot 8
TIME	11:20:42 AM			AD1 - REVISED LEGEND & GENERAL NOTES	10/25/2011	SMS					SR 531/172ND ST NE & EAGLEFIELD DR	PLAN REF NO TESC8
DATE	10/26/2011									INTERSECTION IMPROVEMENT & PAVING	SHEET 51	
PLOTTED BY	lamaymp									TEMPORARY EROSION CONTROL PLAN	OF 230	
DESIGNED BY	M. LAMAY											
ENTERED BY	K. SOLWOLD											
CHECKED BY	J. KORESKI											
PROJ. ENGR.	S. SPAHR											
REGIONAL ADM.	L. ENG			REVISION	DATE	BY						

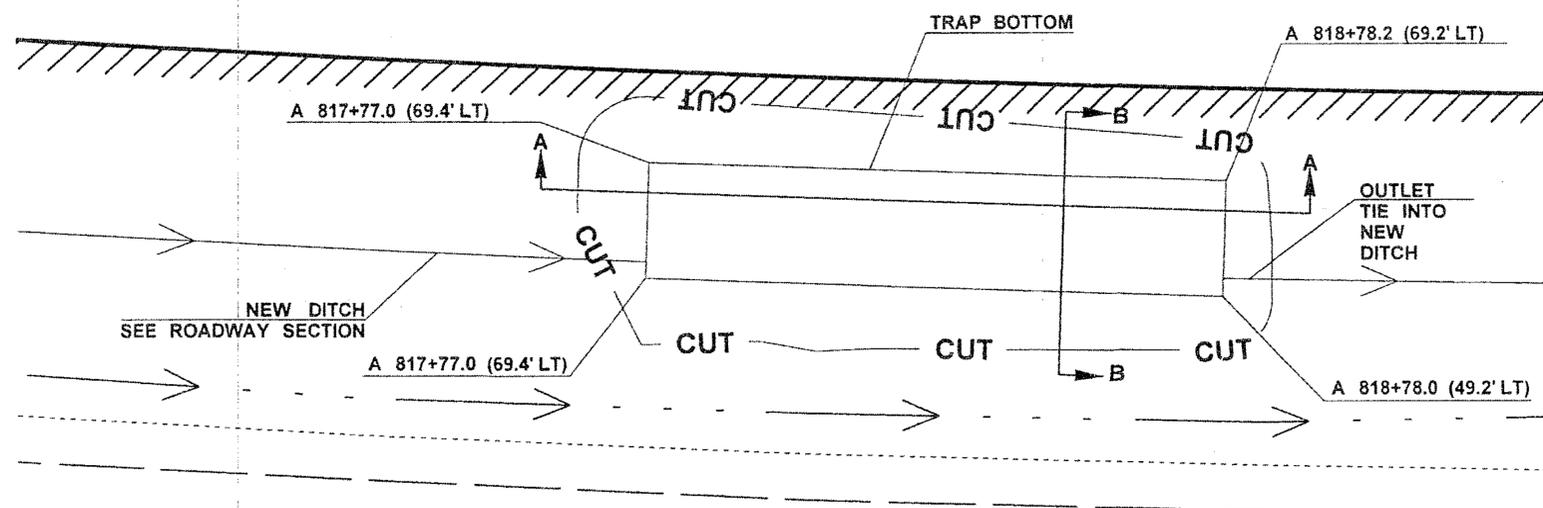

TEMPORARY SEDIMENT TRAP DETAIL
N.T.S.

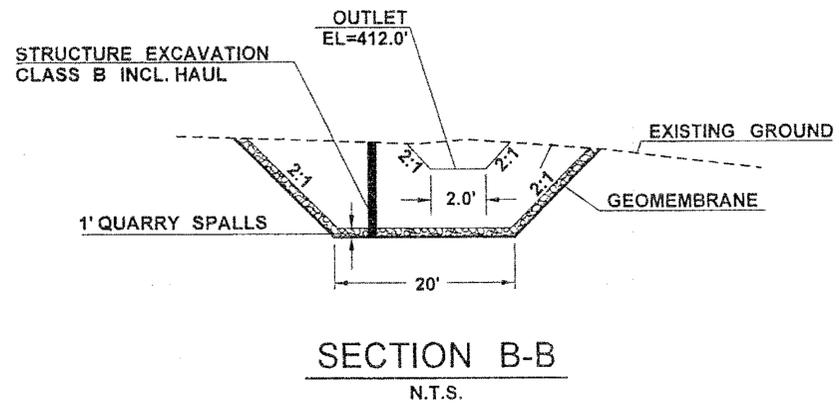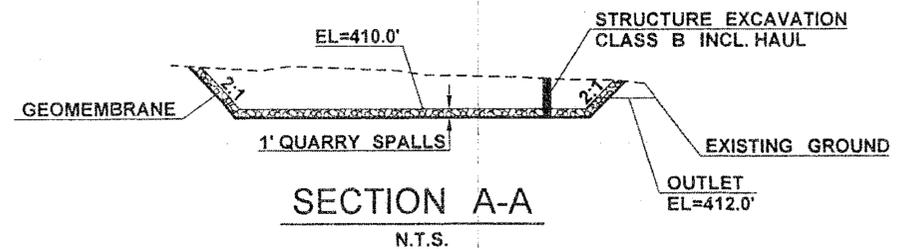


FOR "AS CONSTRUCTED
PLANS" ONLY


FILE NAME	I:\Projects\XL3325 SR9 SR531 172nd St NE Int\CAD\PS&ESheets\XL3325 PS_TESC.dgn			REGION NO.	STATE	FED.AID PROJ.NO.	 Washington State Department of Transportation	SR 9	Plot 11
TIME	9:26:21 AM			10	WASH			SR 531/172ND ST NE & EAGLEFIELD DR	PLAN REF NO
DATE	9/19/2011			JOB NUMBER			INTERSECTION IMPROVEMENT & PAVING	TECD1	
PLOTTED BY	gunnm			CONTRACT NO.			TEMPORARY EROSION CONTROL DETAIL	SHEET	
DESIGNED BY	M.LAMAY							52	
ENTERED BY	A.MUCHONEY							OF	
CHECKED BY	J.KORESKE							230	
PROJ. ENGR.	S.SPAHR							SHEETS	
REGIONAL ADM.	L.ENG			REVISION	DATE	BY			




(NAVD) 88

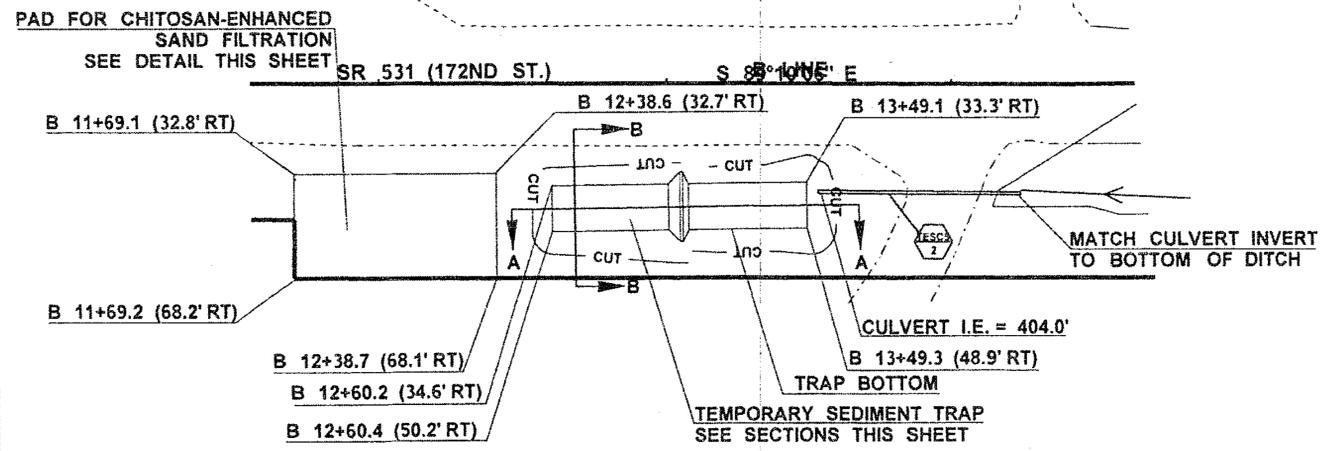


PLAN VIEW
N.T.S.

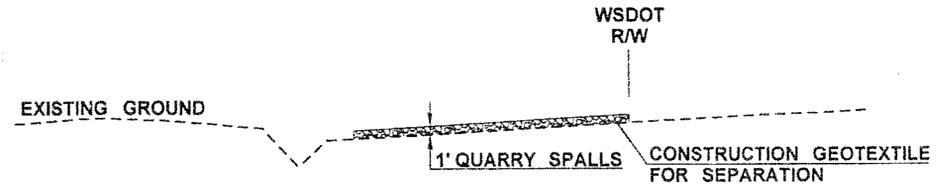

PAD FOR CHITOSAN-ENHANCED SAND FILTRATION
N.T.S.

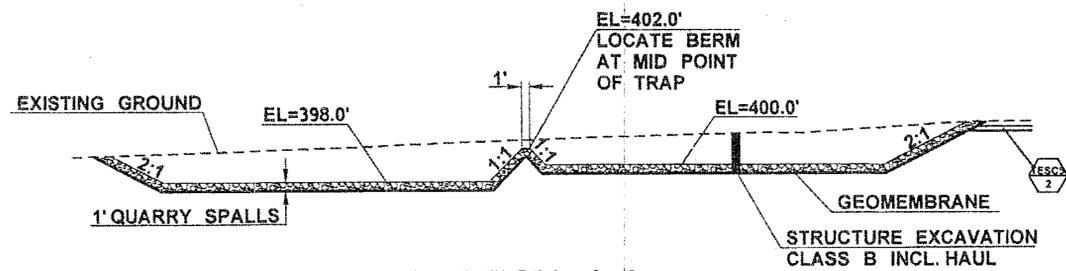

SECTION A-A
N.T.S.

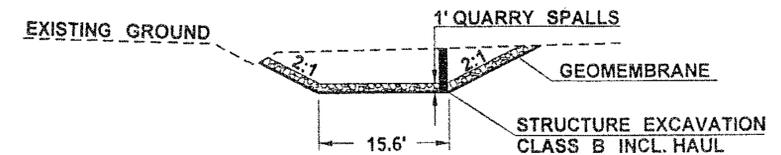

SECTION B-B
N.T.S.

FOR "AS CONSTRUCTED" PLANS ONLY

FILE NAME I:\Projects\XL3325 SR9 SR531 172nd St NE Int\CAD\PS&ESheets\XL3325 PS_TESC.dgn		REGION NO. 10		STATE WASH	FED.AID PROJ.NO.	<p>Washington State Department of Transportation</p>	<p>SR 9</p> <p>SR 531/172ND ST NE & EAGLEFIELD DR INTERSECTION IMPROVEMENT & PAVING</p> <p>TEMPORARY EROSION CONTROL DETAIL</p>	Plot 12
TIME 9:26:23 AM	DATE 9/19/2011	JOB NUMBER 10A042		CONTRACT NO.	LOCATION NO.			PLAN REF NO TECD2
PLOTTED BY gunnm	DESIGNED BY M.LAMAY	ENTERED BY A.MUCHONEY	CHECKED BY J.KORESKI	PROJ. ENGR. S.SPAHR	REGIONAL ADM. L.ENG	REVISION	DATE	BY
								SHEET 53 OF 230 SHEETS

T. 31N. R. 5E. W.M.

PERMITTED WETLAND IMPACTS				
SQ. FT. (ACRES)				
WETLAND #	1	4	IMPACT LEGEND	PERMITTED ACTIVITIES
DOE CATEGORY	III	III		
WETLAND AREA	-871,193 -(20.00)	-1,088,922 -(25.00)		
PERM. WETLAND IMPACT PERCENTAGE	0.0%	*1.5%		
PERM. WETLAND IMPACT	0	15,803 (0.37)		GENERAL ROADWAY CONSTRUCTION
TEMP. WETLAND IMPACT	0	4,726 (0.11)		CLEARING AND CONSTRUCTION ACCESS ONLY. NO GRUBBING ALLOWED.
PERM. WETLAND BUFFER IMPACT	5,103 (0.12)	5,064 (0.12)		GENERAL ROADWAY CONSTRUCTION
TEMP. WETLAND BUFFER IMPACT	1,850 (0.04)	1,854 (0.04)		CLEARING AND CONSTRUCTION ACCESS ONLY. NO GRUBBING ALLOWED.


- WETLAND EXTENDS BEYOND DELINEATION. AREAS HAVE BEEN APPROXIMATED.
 * WETLAND EXTENDS BEYOND DELINEATION. PERCENTAGE HAS BEEN APPROXIMATED.
 ** VALUE REPRESENTS PERMANENT AND INDIRECT WETLAND IMPACTS.
 + VALUE REPRESENTS LONG TERM AND SHORT TERM WETLAND IMPACTS (DOES NOT INCLUDE FOOT TRAFFIC IMPACTS).

LEGEND	
	WSDOT RW
	WSDOT LIMITED ACCESS
	EXISTING CURB
	EXISTING EDGE LINE
	EXISTING EDGE OF PAVEMENT
	EXISTING STOP BAR
	ORDINARY HIGH WATER
	JURISDICTIONAL DITCH
	EXISTING CATCH BASIN
	EXISTING CULVERT
	EXISTING STORM SEWER
	WETLAND BOUNDARY
	WETLAND BUFFER
	EXISTING DITCH
	FILL LINE
	CUT LINE
	CLEAR AND GRUB LIMITS

PERMITTED FOOT TRAFFIC IMPACT		
SQ. FT. (ACRES)		
WETLAND #	1	4
TEMP WETLAND IMPACT ***	0	3,789 (0.08)
TEMP WETLAND BUFFER IMPACT ***	1,777 (0.04)	4,577 (0.11)

*** FOOT TRAFFIC ONLY FOR INSTALLATION OR REMOVAL OF RIGHT OF WAY FENCE

BEGIN PROJECT
SR 9
MP 25.75
STA A 794+50.00

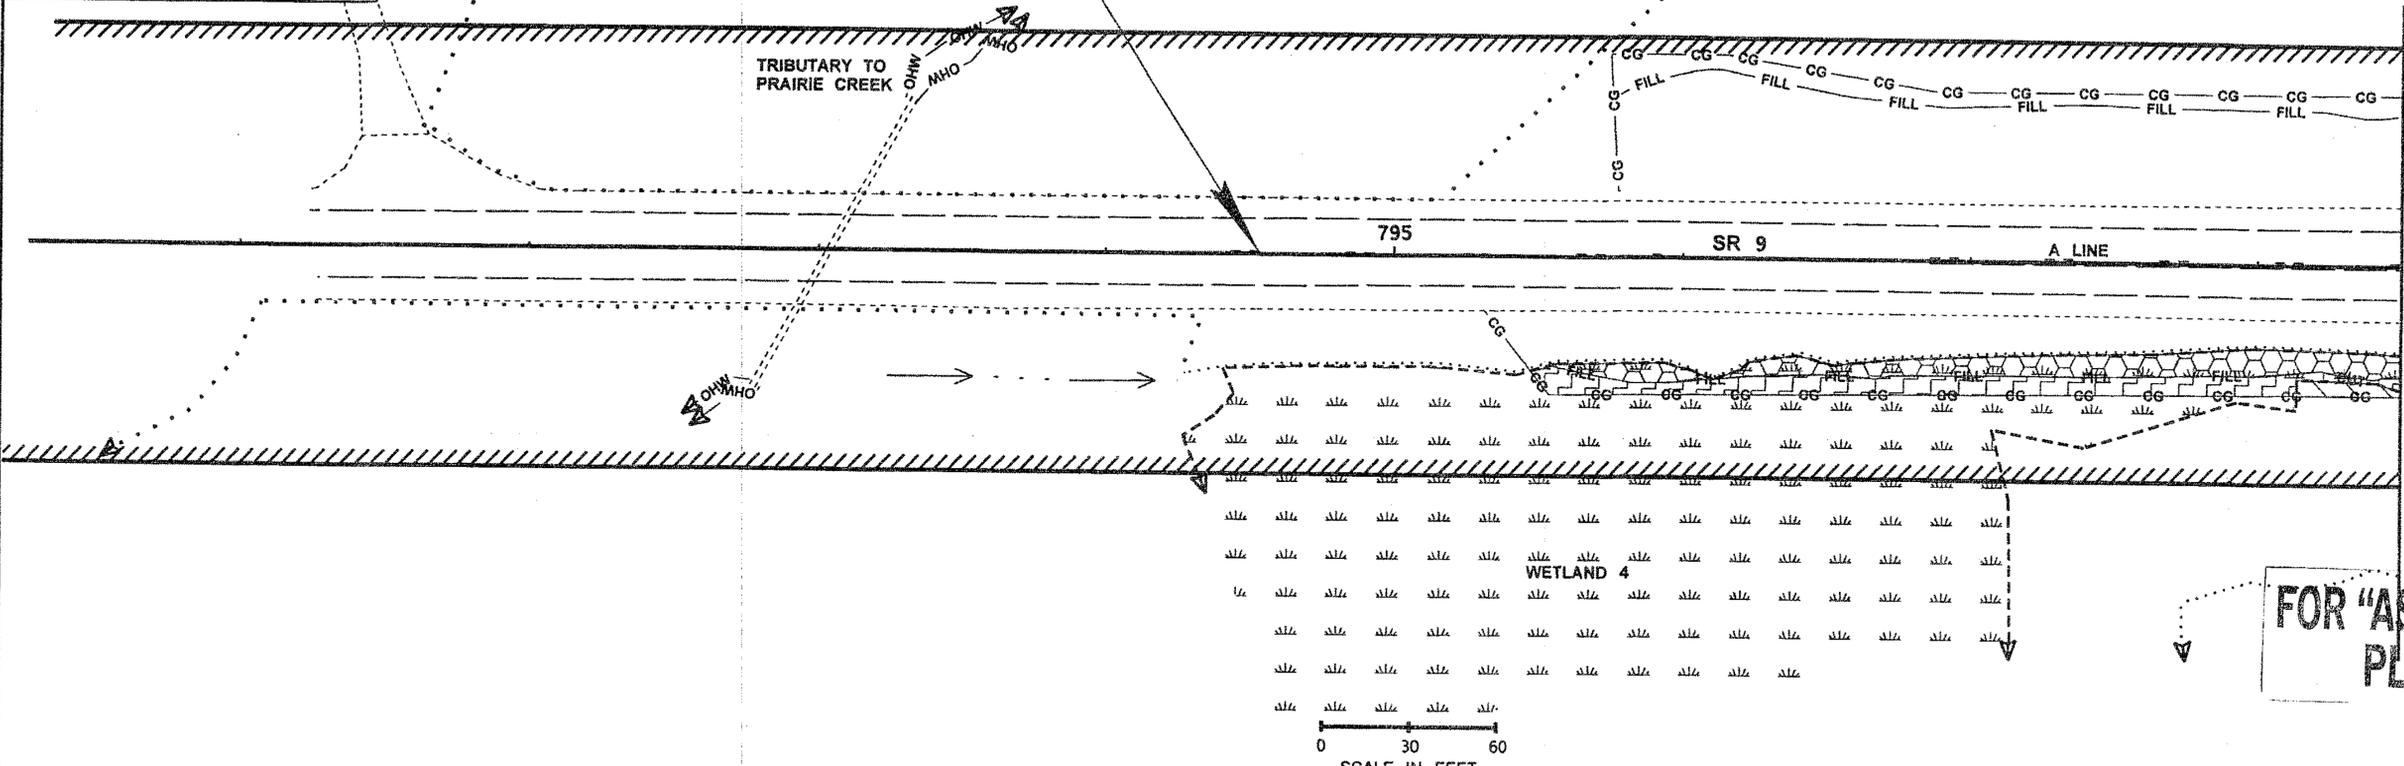

FOR "AS CONSTRUCTED
PLANS" ONLY

FILE NAME	I:\Projects\XL3325 SR9 SR531 172nd St NE Int\CAD\PS&ESheets\XL3325 PS ENV-COMPLIANCE.dgn			REGION NO.	STATE	FED.AID PROJ.NO.			SR 9 SR 531/172ND ST NE & EAGLEFIELD DR INTERSECTION IMPROVEMENT & PAVING ENVIRONMENTAL COMPLIANCE PLAN	Plot 1
TIME	2:33:54 PM			10	WASH					PLAN REF NO
DATE	9/22/2011			JOB NUMBER					SHEET	54
PLOTTED BY	lamaymp			CONTRACT NO.					OF	230
DESIGNED BY	M. GUNN			LOCATION NO.					SHEETS	
ENTERED BY	K. SOLWOLD									
CHECKED BY	J. KORESKI									
PROJ. ENGR.	S. SPAHR									
REGIONAL ADM.	L. ENG									
	REVISION		DATE	BY						

T. 31N. R. 5E. W.M.

PERMITTED FOOT TRAFFIC IMPACT		IMPACT LEGEND
WETLAND #	SQ. FT. (ACRES)	
WETLAND #	2	
TEMP WETLAND IMPACT ***	216 (<0.01)	
TEMP WETLAND BUFFER IMPACT ***	606 (0.01)	

*** FOOT TRAFFIC ONLY FOR INSTALLATION OR REMOVAL OF RIGHT OF WAY FENCE


PERMITTED WETLAND IMPACTS			
WETLAND #	DOE CATEGORY	WETLAND AREA	PERM. WETLAND IMPACT PERCENTAGE
2	III	6,050 (0.14)	34.4%
PERM. WETLAND IMPACT	2,080 (0.05)		
TEMP. WETLAND IMPACT	0		
PERM. WETLAND BUFFER IMPACT	5950 (0.14)		
TEMP. WETLAND BUFFER IMPACT	0		

IMPACT LEGEND

PERMITTED ACTIVITIES

- GENERAL ROADWAY CONSTRUCTION
- CLEARING AND CONSTRUCTION ACCESS ONLY, NO GRUBBING ALLOWED.

~ WETLAND EXTENDS BEYOND DELINEATION. AREAS HAVE BEEN APPROXIMATED.
 • WETLAND EXTENDS BEYOND DELINEATION. PERCENTAGE HAS BEEN APPROXIMATED. SEE SHEET ECP1 FOR WETLAND 1 AND 4 IMPACT QUANTITIES.

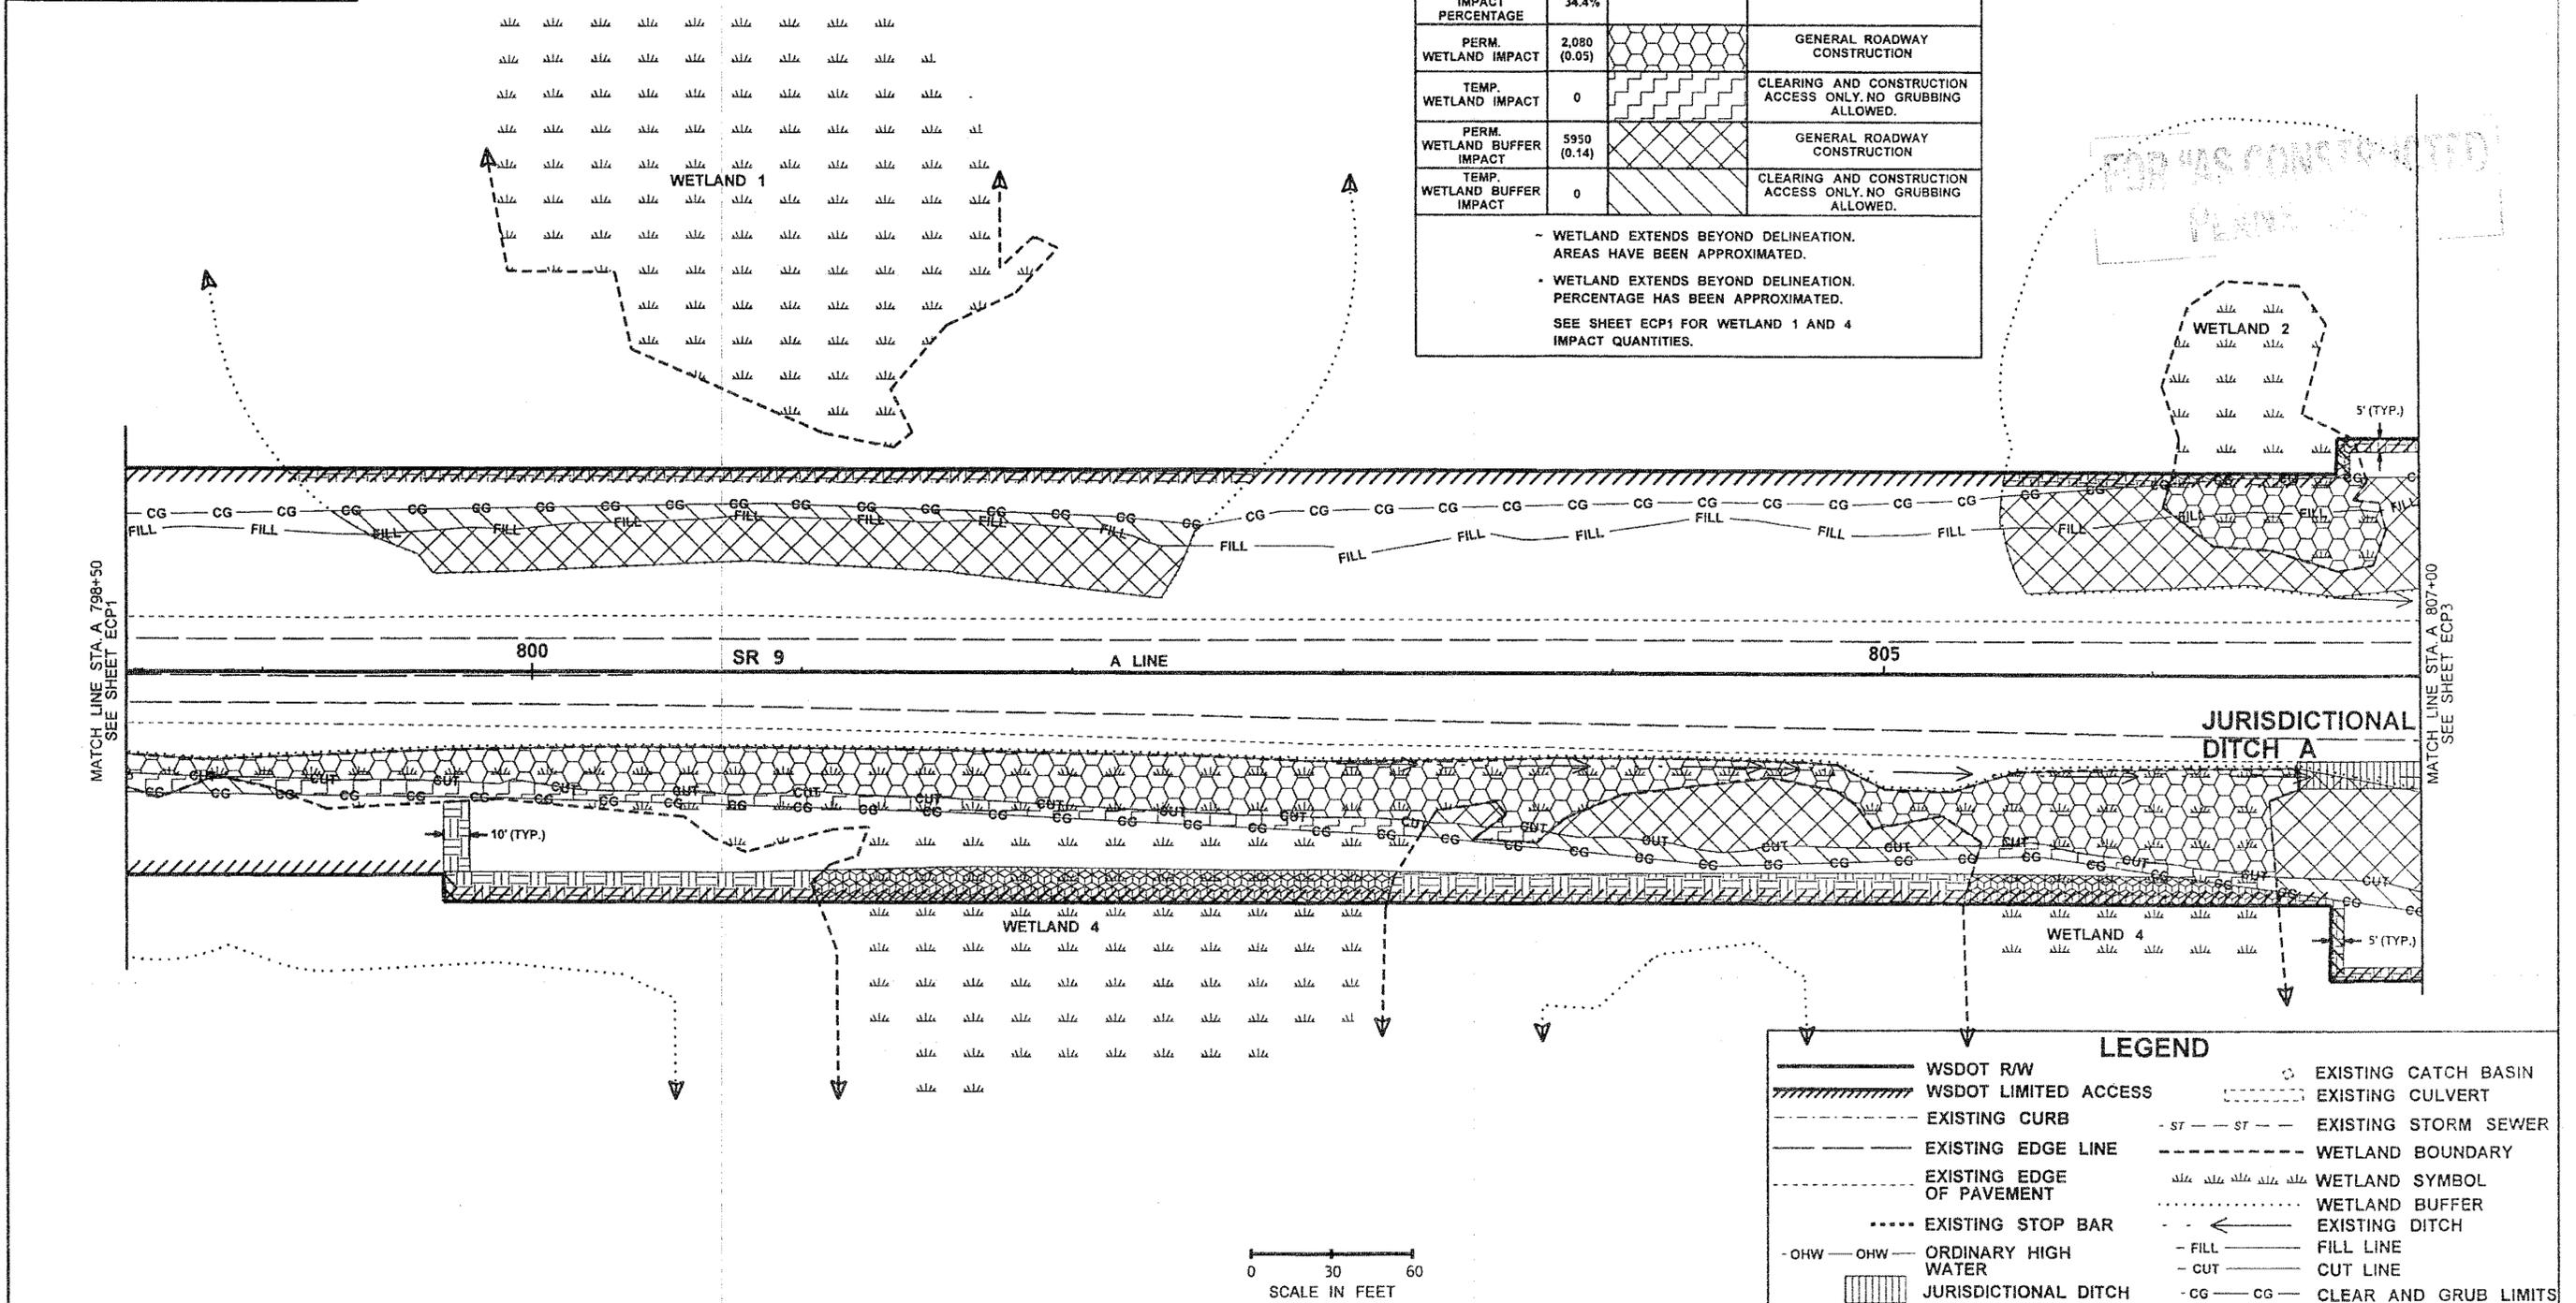

FILE NAME	I:\Projects\XL3325_SR9_SR531_172nd St_NE_IntCADIPS&ESheets\XL3325_PS_ENV-COMPLIANCE.dgn			REGION NO.	STATE	FED.AID PROJ.NO.			SR 9 SR 531/172ND ST NE & EAGLEFIELD DR INTERSECTION IMPROVEMENT & PAVING ENVIRONMENTAL COMPLIANCE PLAN	Plot 2	
TIME	4:25:24 PM			10	WASH					PLAN REF NO	ECP2
DATE	9/22/2011			JOB NUMBER	10A042	LOCATION NO.				SHEET	55
PLOTTED BY	gunnm			CONTRACT NO.						OF	230
DESIGNED BY	M. GUNN						REVISION	DATE	BY	SHEETS	
ENTERED BY	K. SOLWOLD										
CHECKED BY	J. KORESKE										
PROJ. ENGR.	S. SPAHR										
REGIONAL ADM.	L. ENG										


T. 31N. R. 5E. W.M.

PERMITTED FOOT TRAFFIC IMPACT SQ. FT. (ACRES)			IMPACT LEGEND
WETLAND #	3C	5	
TEMP WETLAND IMPACT ***	0	186 (<0.01)	[Pattern]
TEMP WETLAND BUFFER IMPACT ***	660 (0.02)	693 (0.03)	[Pattern]

*** FOOT TRAFFIC ONLY FOR INSTALLATION OR REMOVAL OF RIGHT OF WAY FENCE


PERMITTED WETLAND IMPACTS SQ. FT. (ACRES)				
WETLAND #	3C	5	IMPACT LEGEND	PERMITTED ACTIVITIES
DOE CATEGORY	III	II		
WETLAND AREA	-9,000 (-0.21)	-13,067 (-0.30)		
PERM. WETLAND IMPACT PERCENTAGE	0.0%	0.0%		
PERM. WETLAND IMPACT	0	0	[Pattern]	GENERAL ROADWAY CONSTRUCTION
TEMP. WETLAND IMPACT	0	210 (<0.01)	[Pattern]	CLEARING AND CONSTRUCTION ACCESS ONLY. NO GRUBBING ALLOWED.
PERM. WETLAND BUFFER IMPACT	500 (0.01)	3,134 (0.07)	[Pattern]	GENERAL ROADWAY CONSTRUCTION
TEMP. WETLAND BUFFER IMPACT	600 (0.01)	793 (0.02)	[Pattern]	CLEARING AND CONSTRUCTION ACCESS ONLY. NO GRUBBING ALLOWED.

- WETLAND EXTENDS BEYOND DELINEATION. AREAS HAVE BEEN APPROXIMATED.
 - WETLAND EXTENDS BEYOND DELINEATION. PERCENTAGE HAS BEEN APPROXIMATED.
 SEE SHEETS ECP1 AND ECP2 FOR WETLAND 2 AND 4 IMPACT QUANTITIES.

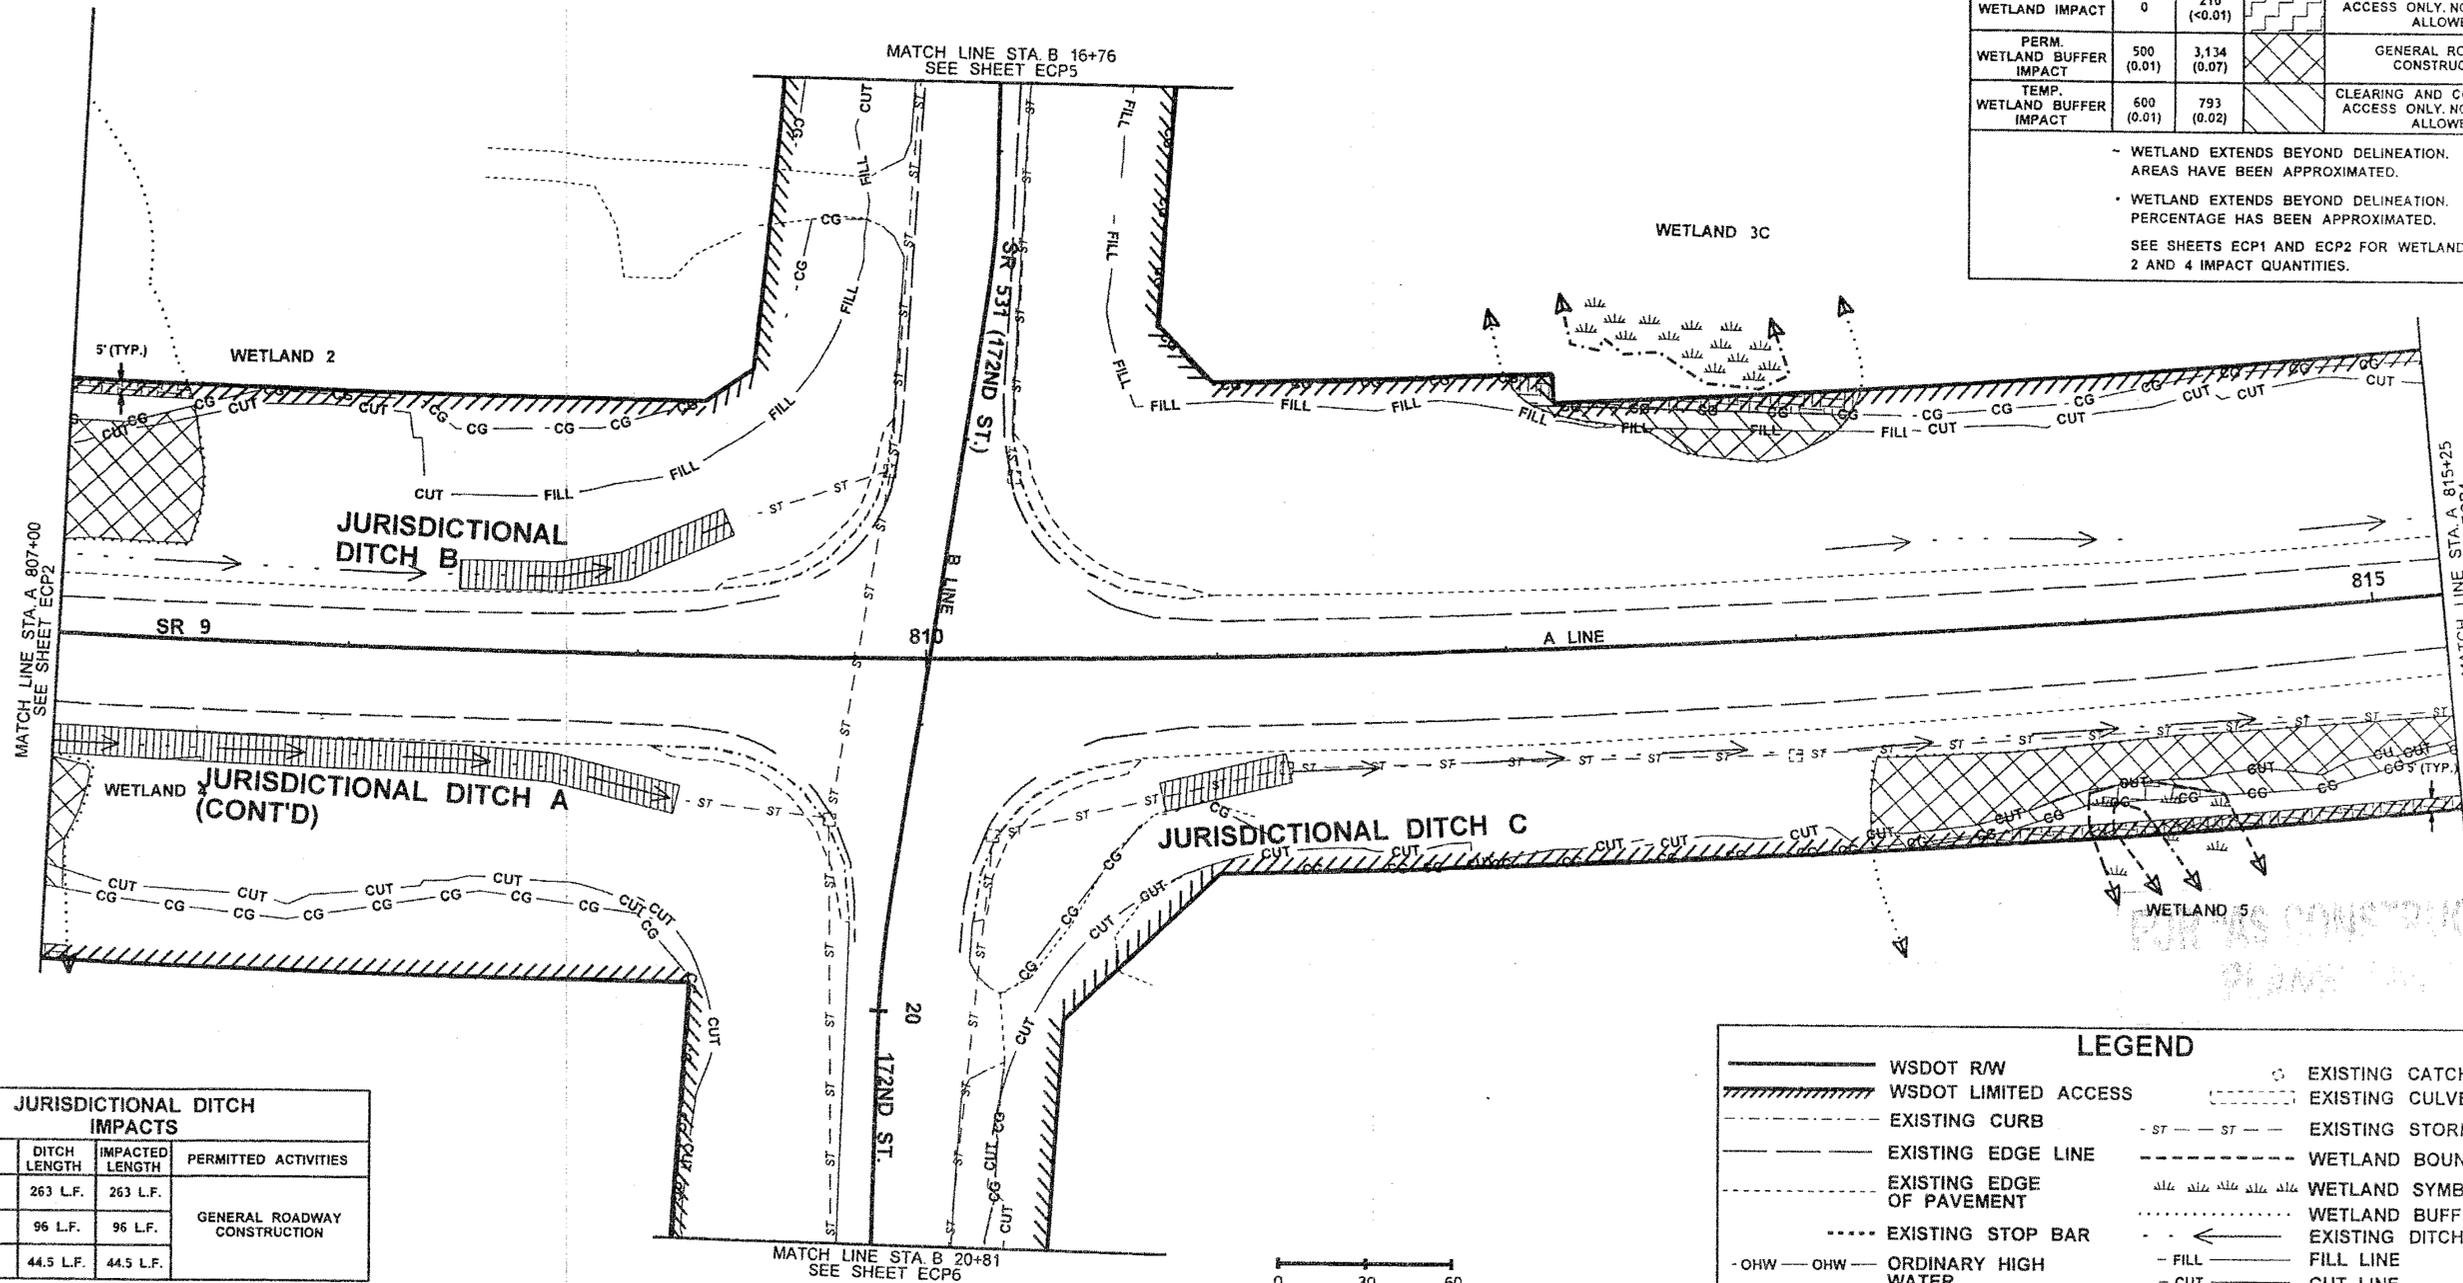

JURISDICTIONAL DITCH IMPACTS			
DITCH NAME	DITCH LENGTH	IMPACTED LENGTH	PERMITTED ACTIVITIES
A	263 L.F.	263 L.F.	GENERAL ROADWAY CONSTRUCTION
B	96 L.F.	96 L.F.	
C	44.5 L.F.	44.5 L.F.	

LEGEND	
[Symbol]	WSDOT R/W
[Symbol]	WSDOT LIMITED ACCESS
[Symbol]	EXISTING CURB
[Symbol]	EXISTING EDGE LINE
[Symbol]	EXISTING EDGE OF PAVEMENT
[Symbol]	EXISTING STOP BAR
[Symbol]	ORDINARY HIGH WATER
[Symbol]	JURISDICTIONAL DITCH
[Symbol]	EXISTING CATCH BASIN
[Symbol]	EXISTING CULVERT
[Symbol]	EXISTING STORM SEWER
[Symbol]	WETLAND BOUNDARY
[Symbol]	WETLAND SYMBOL
[Symbol]	WETLAND BUFFER
[Symbol]	EXISTING DITCH
[Symbol]	FILL LINE
[Symbol]	CUT LINE
[Symbol]	CLEAR AND GRUB LIMITS

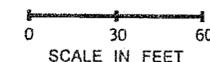

FILE NAME	I:\Projects\XL3325_SR9_SR531_172nd_St_NE_Int\CAD\IPS&ESheets\XL3325_PS_ENV-COMPLIANCE.dgn			REGION NO.	STATE	FED.AID PROJ.NO.			SR 9 SR 531/172ND ST NE & EAGLEFIELD DR INTERSECTION IMPROVEMENT & PAVING ENVIRONMENTAL COMPLIANCE PLAN	PLAN REF NO
TIME	3:52:14 PM			10	WASH					ECP3
DATE	9/28/2011			JOB NUMBER	10A042	LOCATION NO.				SHEET
PLOTTED BY	gunnm			CONTRACT NO.						56
DESIGNED BY	M. GUNN									OF
ENTERED BY	K. SOLWOLD									230
CHECKED BY	J. KORESKI									SHEETS
PROJ. ENGR.	S. SPAHR									
REGIONAL ADM.	L. ENG			REVISION	DATE	BY				


PERMITTED WETLAND IMPACTS						
WETLAND #	SQ. FT. (ACRES)				IMPACT LEGEND	PERMITTED ACTIVITIES
	6	7	8	9		
DOE CATEGORY	III	III	II	III		
WETLAND AREA	160 (0.01)	-21,779 (-0.50)	-13,067 (-0.30)	-108,899 (-2.50)		
PERM. WETLAND IMPACT PERCENTAGE	0.0%	*3.8%	0.0%	0.0%		
PERM. WETLAND IMPACT	0	820 (0.02)	0	0	[Symbol]	GENERAL ROADWAY CONSTRUCTION
TEMP. WETLAND IMPACT	0	320 + (0.01)	0	0	[Symbol]	CLEARING AND CONSTRUCTION ACCESS ONLY, NO GRUBBING ALLOWED.
PERM. WETLAND BUFFER IMPACT	0	902 (0.02)	398 (0.01)	1,818 (0.04)	[Symbol]	GENERAL ROADWAY CONSTRUCTION
TEMP. WETLAND BUFFER IMPACT	0	1,175 (0.03)	444 (0.01)	446 (0.01)	[Symbol]	CLEARING AND CONSTRUCTION ACCESS ONLY, NO GRUBBING ALLOWED.

- WETLAND EXTENDS BEYOND DELINEATION. AREAS HAVE BEEN APPROXIMATED.
 * WETLAND EXTENDS BEYOND DELINEATION. PERCENTAGE HAS BEEN APPROXIMATED.
 † VALUE REPRESENTS LONG TERM AND SHORT TERM WETLAND IMPACTS (DOES NOT INCLUDE FOOT TRAFFIC IMPACTS).

PERMITTED FOOT TRAFFIC IMPACT			IMPACT LEGEND
WETLAND #	7	8	
TEMP WETLAND IMPACT ***	265 (0.01)	0	[Symbol]
TEMP WETLAND BUFFER IMPACT ***	782 (0.02)	568 (0.01)	[Symbol]


*** FOOT TRAFFIC ONLY FOR INSTALLATION OR REMOVAL OF RIGHT OF WAY FENCE

T. 31N. R. 5E. W.M.

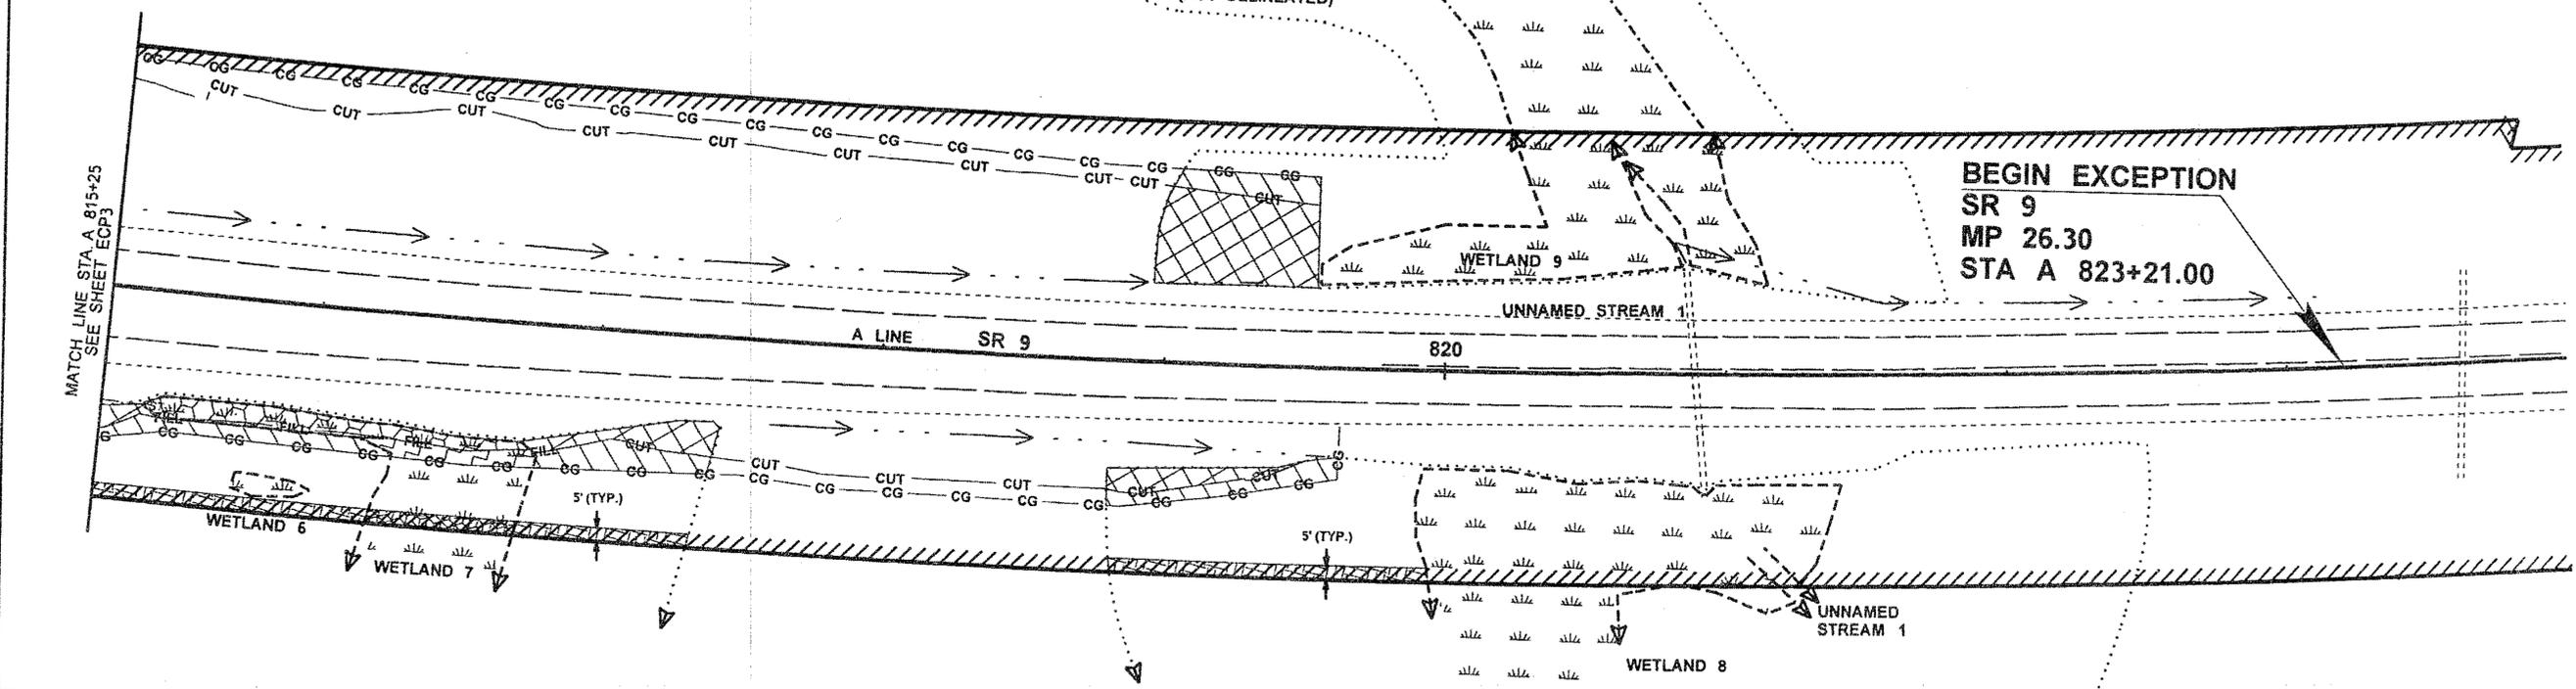

LEGEND	
[Symbol]	WSDOT R/W
[Symbol]	WSDOT LIMITED ACCESS
[Symbol]	EXISTING CURB
[Symbol]	EXISTING EDGE LINE
[Symbol]	EXISTING EDGE OF PAVEMENT
[Symbol]	EXISTING STOP BAR
[Symbol]	OHW - OHW ORDINARY HIGH WATER
[Symbol]	JURISDICTIONAL DITCH
[Symbol]	EXISTING CATCH BASIN
[Symbol]	EXISTING CULVERT
[Symbol]	EXISTING STORM SEWER
[Symbol]	WETLAND BOUNDARY
[Symbol]	WETLAND SYMBOL
[Symbol]	WETLAND BUFFER
[Symbol]	EXISTING DITCH
[Symbol]	FILL LINE
[Symbol]	CUT LINE
[Symbol]	CLEAR AND GRUB LIMITS

FOR "AS CONSTRUCTED PLANS ONLY"

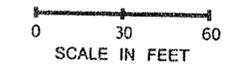

FILE NAME	I:\Projects\XL3325_SR9_SR531_172nd St_NE_IntCADPS&ESheets\XL3325_PS_ENV-COMPLIANCE.dgn	REGION NO.	10	STATE	WASH	FED.AID PROJ.NO.	
TIME	2:33:58 PM	JOB NUMBER	10A042	CONTRACT NO.		LOCATION NO.	
DATE	9/22/2011	DATE	9/22/11	DATE		DATE	
PLOTTED BY	lamaymp	Washington State Department of Transportation		SR 9		Plot 4	
DESIGNED BY	M. GUNN	SR 531/172ND ST NE & EAGLEFIELD DR		INTERSECTION IMPROVEMENT & PAVING		PLAN REF NO	ECP4
ENTERED BY	K. SOLWOLD	ENVIRONMENTAL COMPLIANCE PLAN				SHEET	57
CHECKED BY	J. KORESKI					OF	230
PROJ. ENGR.	S. SPAHR					SHEETS	
REGIONAL ADM.	L. ENG						


T. 31N. R. 5E. W.M.



PERMITTED WETLAND IMPACTS				
SQ. FT. (ACRES)				
WETLAND #	3	3A	3B	
DOE CATEGORY	IV	III	III	IMPACT LEGEND
WETLAND AREA	-2,237 (-0.05)	-101,600 (-2.33)	3,495 (0.08)	
PERM. WETLAND IMPACT PERCENTAGE	0.0%	*1.5%	100%	PERMITTED ACTIVITIES
PERM. WETLAND IMPACT	0	1,539 (0.04)	3,495 (0.08)	
TEMP. WETLAND IMPACT	0	555 + (0.01)	0	CLEARING AND CONSTRUCTION ACCESS ONLY. NO GRUBBING ALLOWED.
PERM. WETLAND BUFFER IMPACT	0	952 (0.03)	0	GENERAL ROADWAY CONSTRUCTION
TEMP. WETLAND BUFFER IMPACT	0	421 (0.01)	0	CLEARING AND CONSTRUCTION ACCESS ONLY. NO GRUBBING ALLOWED.


- WETLAND EXTENDS BEYOND DELINEATION. AREAS HAVE BEEN APPROXIMATED.
 * WETLAND EXTENDS BEYOND DELINEATION. PERCENTAGE HAS BEEN APPROXIMATED.
 + VALUE REPRESENTS LONG TERM AND SHORT TERM WETLAND IMPACTS (DOES NOT INCLUDE FOOT TRAFFIC IMPACTS).

BEGIN CONSTRUCTION
 SR 531
 MP 9.73
 STA B 10+53.80

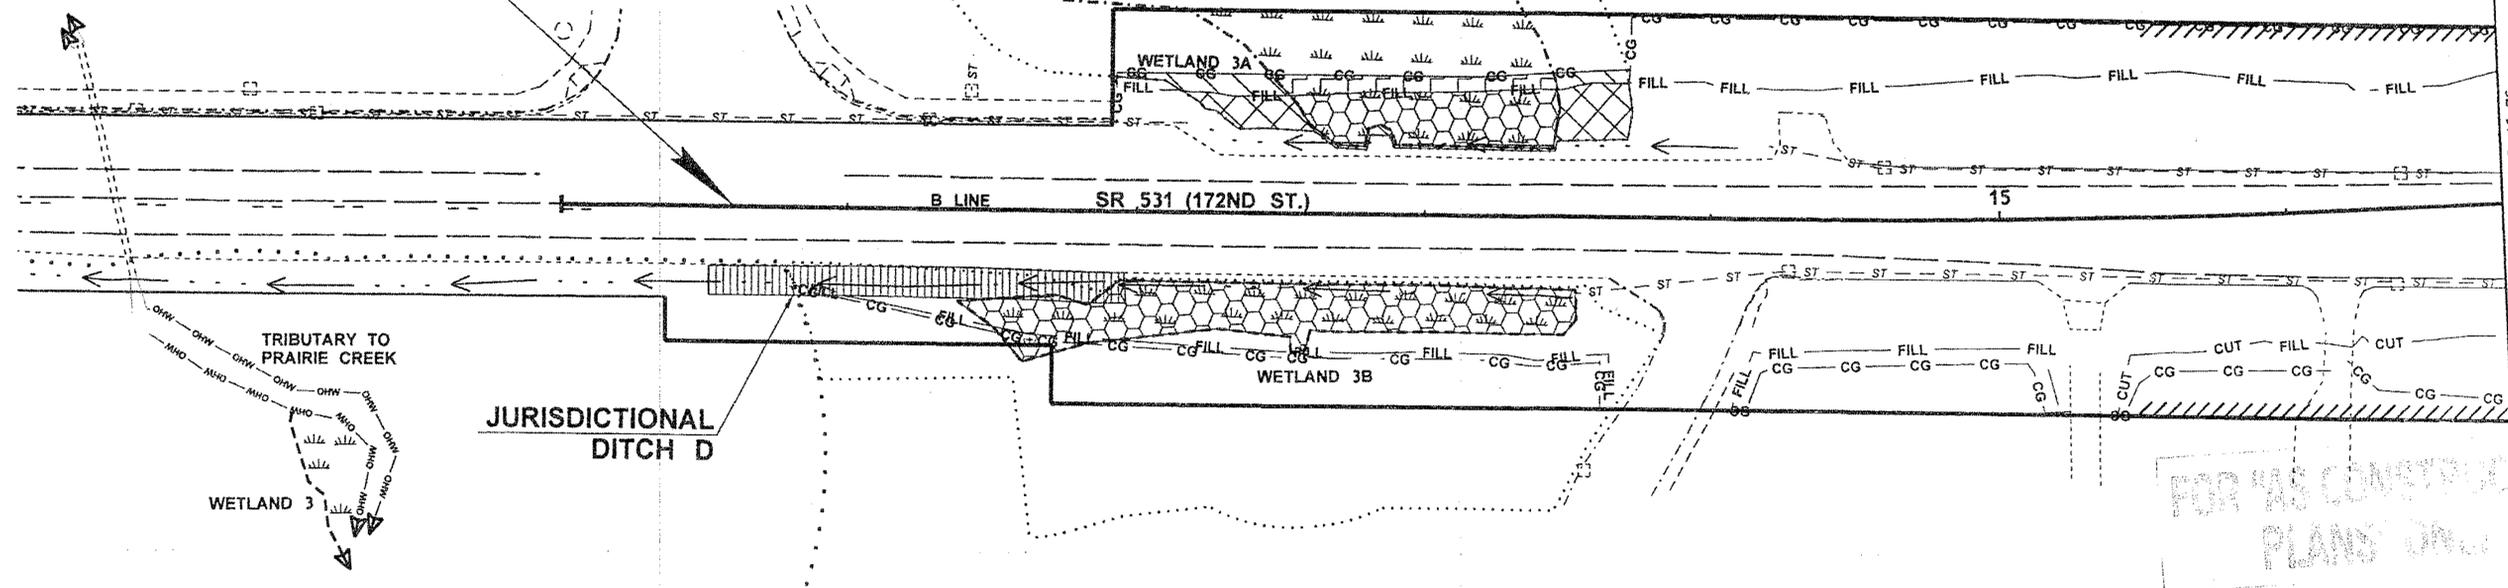

FOR HAS CONSTRUCTED PLANS ONLY

JURISDICTIONAL DITCH IMPACTS			
DITCH NAME	DITCH LENGTH	IMPACTED LENGTH	ALLOWABLE ACTIVITIES
D	141.5 L.F.	115 L.F.	GENERAL ROADWAY CONSTRUCTION

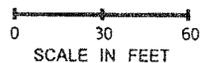


LEGEND	
	WSDOT R/W
	WSDOT LIMITED ACCESS
	EXISTING CURB
	EXISTING EDGE LINE
	EXISTING EDGE OF PAVEMENT
	EXISTING STOP BAR
	ORDINARY HIGH WATER
	JURISDICTIONAL DITCH
	EXISTING CATCH BASIN
	EXISTING CULVERT
	EXISTING STORM SEWER
	WETLAND BOUNDARY
	WETLAND SYMBOL
	WETLAND BUFFER
	EXISTING DITCH
	FILL LINE
	CUT LINE
	CLEAR AND GRUB LIMITS


FILE NAME	I:\Projects\XL3325 SR9 SR531 172nd St NE Int\CAD\PS&ESheets\XL3325 PS ENV-COMPLIANCE.dgn			REGION NO.	STATE	FED.AID PROJ.NO.		Washington State Department of Transportation	SR 9	Plot 5
TIME	3:43:39 PM			10	WASH				SR 531/172ND ST NE & EAGLEFIELD DR	PLAN REF NO
DATE	9/22/2011			JOB NUMBER				INTERSECTION IMPROVEMENT & PAVING	SHEET	58
PLOTTED BY	lamaymp			CONTRACT NO.				ENVIRONMENTAL COMPLIANCE PLAN	OF	230
DESIGNED BY	M. GUNN			LOCATION NO.					SHEETS	
ENTERED BY	K. SOLWOLD									
CHECKED BY	J. KORESKE									
PROJ. ENGR.	S. SPAHR									
REGIONAL ADM.	L. ENG			REVISION						

PERMITTED WETLAND IMPACTS		SQ. FT. (ACRES)	
WETLAND #	4A	IMPACT LEGEND	PERMITTED ACTIVITIES
DOE CATEGORY	IV		
WETLAND AREA	300 (<0.01)		
PERM. WETLAND IMPACT PERCENTAGE	0.0%		
PERM. WETLAND IMPACT	0	NO PERMITTED ACTIVITIES	
TEMP. WETLAND IMPACT	0		
PERM. WETLAND BUFFER IMPACT	0		
TEMP. WETLAND BUFFER IMPACT	0		

~ WETLAND EXTENDS BEYOND DELINEATION. AREAS HAVE BEEN APPROXIMATED.
 * WETLAND EXTENDS BEYOND DELINEATION. PERCENTAGE HAS BEEN APPROXIMATED.

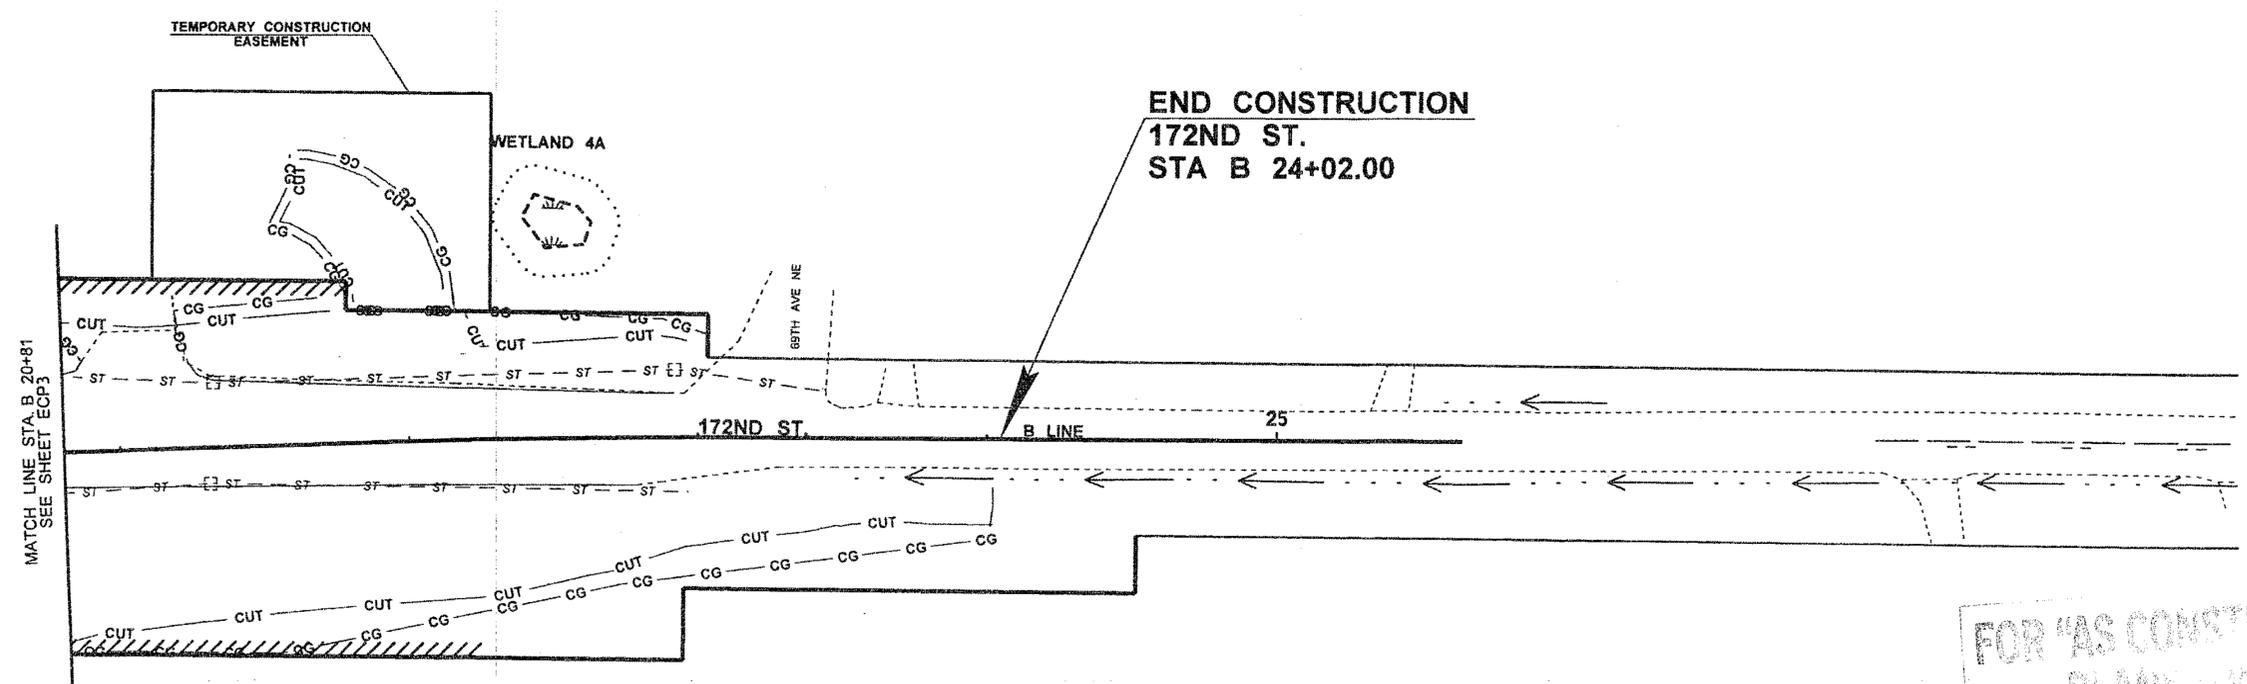

LEGEND			
	WSDOT R/W		EXISTING CATCH BASIN
	WSDOT LIMITED ACCESS		EXISTING CULVERT
	EXISTING CURB		EXISTING STORM SEWER
	EXISTING EDGE LINE		WETLAND BOUNDARY
	EXISTING EDGE OF PAVEMENT		WETLAND SYMBOL
	EXISTING STOP BAR		WETLAND BUFFER
	ORDINARY HIGH WATER		EXISTING DITCH
	JURISDICTIONAL DITCH		FILL LINE
			CUT LINE
			CLEAR AND GRUB LIMITS

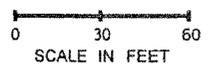


FILE NAME: I:\Projects\13325 SR9 SR531 172nd St NE Int\CAD\PS&ESheets\13325 PS ENV-COMPLIANCE.dgn		REGION NO.	STATE	FED.AID PROJ.NO.			SR 9 SR 531/172ND ST NE & EAGLEFIELD DR INTERSECTION IMPROVEMENT & PAVING ENVIRONMENTAL COMPLIANCE PLAN	PLAN REF NO.
TIME: 9:06:09 AM	DATE: 9/27/2011	10	WASH					ECP6
PLOTTED BY: solwolk	DESIGNED BY: M. GUNN	JOB NUMBER:	10A042	LOCATION NO.	DATE: 9/27/11		SHEET 59 OF 230 SHEETS	
ENTERED BY: K. SOLWOLD	CHECKED BY: J. KORESKE	CONTRACT NO.						
PROJ. ENGR: S. SPAHR	REGIONAL ADM: L. ENG	REVISION	DATE	BY				

LEGEND			
	WSDOT RW		EXISTING CATCH BASIN
	WSDOT LIMITED ACCESS		EXISTING CULVERT
	EXISTING CURB		EXISTING STORM SEWER
	EXISTING EDGE LINE		WETLAND BOUNDARY
	EXISTING EDGE OF PAVEMENT		WETLAND SYMBOL
	EXISTING STOP BAR		WETLAND BUFFER
	ORDINARY HIGH WATER		EXISTING DITCH
	JURISDICTIONAL DITCH		FILL LINE
			CUT LINE
			CLEAR AND GRUB LIMITS

PERMITTED WETLAND & JURISDICTIONAL DITCH IMPACTS

NO PERMITTED WETLAND OR JURISDICTIONAL DITCH IMPACTS THIS SHEET

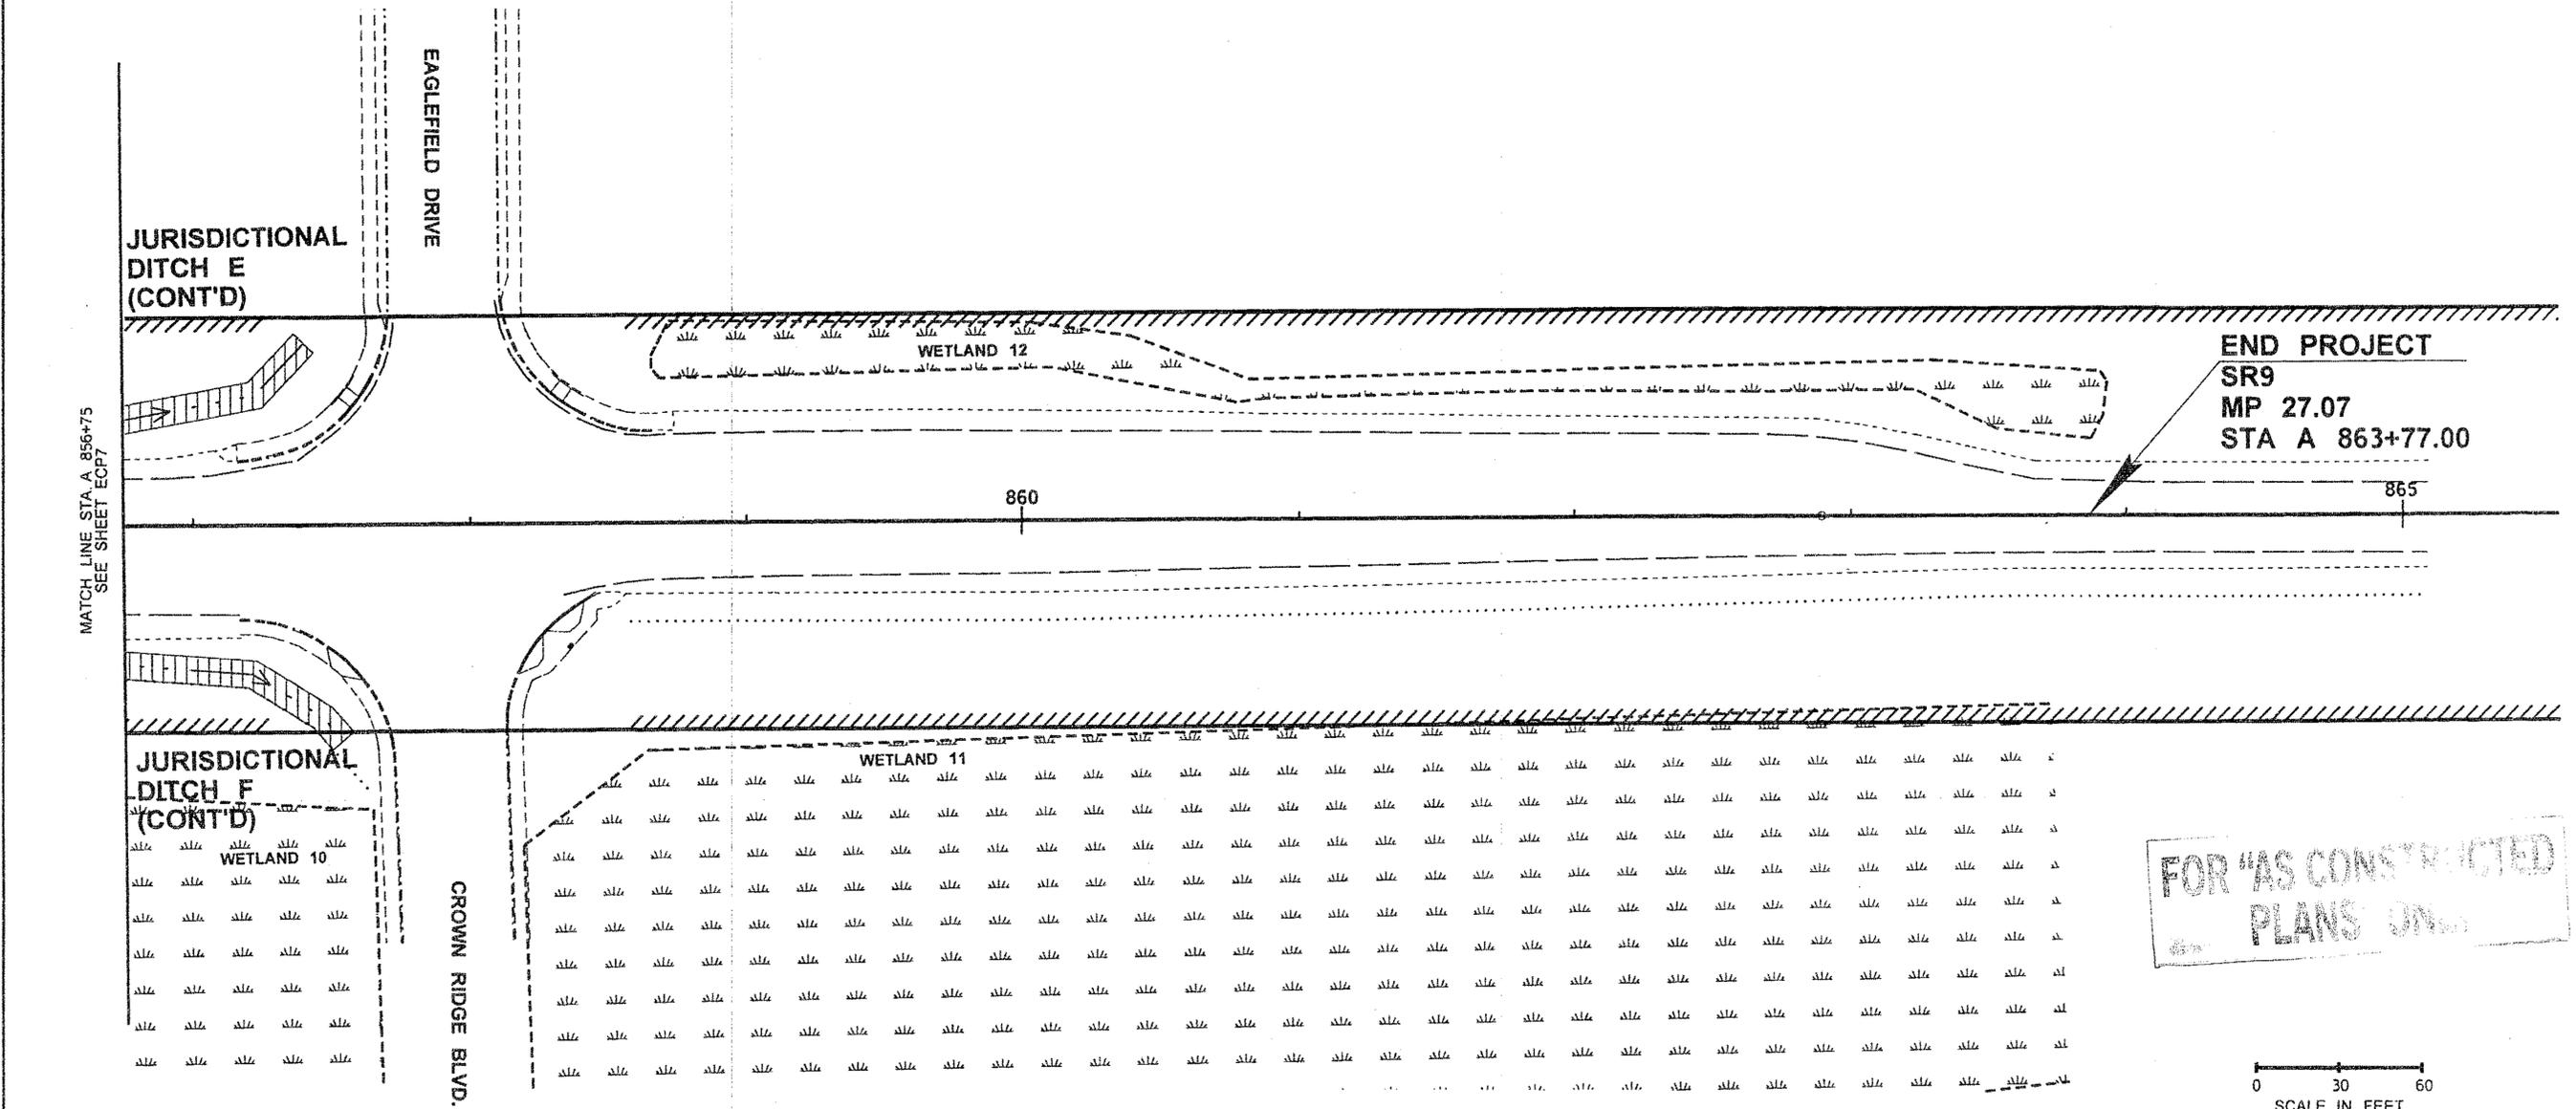

FOR "AS CONSTRUCTED PLANS" ONLY

0 30 60
SCALE IN FEET

FILE NAME: I:\Projects\XL3325_SR9_SR531_172nd St NE Int\CAD\IPS&ESheets\XL3325_PS_ENV-COMPLIANCE.dgn		REGION NO. 10	STATE WASH	FED.AID PROJ.NO.			SR 9 SR 531/172ND ST NE & EAGLEFIELD DR INTERSECTION IMPROVEMENT & PAVING	Plot 8	
TIME: 2:02:57 PM	DATE: 9/27/2011	JOB NUMBER: 10A042	CONTRACT NO.	LOCATION NO.				DATE: 9/28/11	ENVIRONMENTAL COMPLIANCE PLAN
PLOTTED BY: lamaymp	DESIGNED BY: M. GUNN	ENTERED BY: K. SOLWOLD	CHECKED BY: J. KORESKE	PROJ. ENGR: S. SPAHR	REGIONAL ADM: L. ENG	REVISION	DATE	BY	SHEET 61 OF 230 SHEETS

STRUCTURE NOTES - DRAINAGE

NOTE:
THE FIRST NUMBER OF THE "CODE DESIGNATION" BELOW REFERS TO THE SHEET NO. OR THE SHEET REFERENCE NO. SHOWING THE DRAINAGE FEATURE.

THE SECOND NUMBER REFERS TO THE DRAINAGE FEATURE FOUND ON THAT SHEET.

GENERAL NOTES:

- * - Refer to sheets RP1-RP4, TCP1 and TPP2 for additional quantities.
- ** - Refer to sheets QTEC1-QTEC2 and AL1 for additional quantities.
- *** - Refer to sheets QTEC1-QTEC2 for additional quantities.

CODE	LOCATION \ UNIT OF MEASURE	SELECT BORROW INCL. HAUL*	SAND DRAINAGE BLANKET	EMBANKMENT COMPACTION *	GEOSYNTHETIC CLAY LINER	CONCRETE INLET	GRATE INLET TYPE 2	DROP INLET TYPE 1	QUARRY SPALLS **	UNDERDRAIN PIPE 6 IN. DIAM.	SCHEDULE A CULV. PIPE 12 IN. DIAM. **	CATCH BASIN TYPE 2 54 IN. DIAM. WITH FLOW RESTRICTOR	SEE GENERAL NOTES
		TON	TON	C.Y.	S.F.	EACH	EACH	EACH	TON	L.F.	L.F.	EACH	
D1-1	A 795+78.0 (23.3' LT) TO A 802+50.0 (35.0' LT)												
D1-2	A 795+78.0 (21.6' RT) TO A 798+05.0 (19.6' RT)												6
D1-3	A 798+05.0 (19.6' RT) TO A 807+50.0 (40.6' RT)												6
D2-1	A 802+50.0 (35.0' LT) TO A 808+18.0 (52.1' LT)												7, 11
D3-1	A 807+94.1 (41.0' RT) TO A 808+19.5 (65.2' LT)	126											7
D3-2	A 808+18.0 (58.1' LT) TO A 808+28.2 (58.6' LT)	10						1					5, 12
D3-3	A 808+28.2 (58.6' LT) TO A 808+29.4 (41.8' LT)	15											5, 12
D3-4	A 808+29.4 (41.8' LT) TO A 808+96.8 (46.0' LT)	54											1, 5, 12
D3-5	A 808+96.8 (46.0' LT) TO A 809+48.3 (68.6' LT)	47											1, 5, 12
D3-6	A 808+19.5 (65.2' LT) TO A 809+50.2 (87.6' LT)	171											2, 5, 12
D3-7	A 809+48.3 (68.6' LT) TO B 17+66.8 (32.9' RT)	43											2, 5, 12
D3-8	A 809+50.2 (87.6' LT) TO A 809+79.6 (28.2' LT)	62											1, 5, 12
D3-9	A 809+79.6 (28.2' LT) TO A 810+24.7 (31.1' RT)	15											10, 12
D3-10	A 809+50.2 (87.6' LT) TO B 15+51.2 (52.0' RT)	372								74			5, 12
D3-11	B 17+13.5 (27.2' RT) TO B 17+66.8 (32.9' RT)	26											1, 5, 12
D3-12	B 15+50.4 (35.6' RT) TO B 17+13.5 (27.2' RT)	119											1, 5, 12
D3-13	B 15+72.0 (33.6' LT) TO B 17+66.3 (33.0' LT)	124											1, 5, 12
D3-14	A 811+79.8 (13.6' LT) TO A 811+80.9 (44.1' LT)	8											1, 5, 8, 12
D3-15	A 812+17.4 (62.7' LT) TO A 812+18.1 (70.4' LT)											1	3, 5
D3-16	A 812+18.1 (70.4' LT) TO A 813+44.7 (61.4' LT)								4				5, 8, 9
D3-17	A 813+68.0 (44.2' LT) TO A 819+34.0 (23.5' LT)												6
D3-18	A 807+51.8 (53.6' RT) TO A 807+51.1 (46.6' RT)	12											1, 5, 8, 12
D3-19	A 807+51.1 (46.6' RT) TO A 807+94.1 (41.0' RT)	56											1, 5, 12
D3-20	A 807+94.1 (41.0' RT) TO A 807+94.9 (47.7' RT)	10											5, 8, 12
D3-21	A 808+26.0 (17.8' RT) TO A 808+88.2 (24.3' RT)	54											1, 5, 12
D3-22	A 808+88.2 (24.3' RT) TO A 808+96.8 (46.0' LT)	60											1, 5, 12
D3-23	A 808+88.2 (24.3' RT) TO A 809+45.9 (73.6' RT)	63											1, 5, 12
D3-24	A 809+45.9 (73.6' RT) TO B 20+03.3 (22.6' RT)	41											1, 5, 12
D3-25	B 20+03.3 (22.6' RT) TO B 20+74.7 (16.5' RT)	78											1, 5, 12
D3-26	B 20+06.5 (21.6' LT) TO B 20+75.6 (14.0' LT)	91											1, 5, 12
D3-27	B 19+79.8 (31.8' LT) TO B 20+06.5 (21.6' LT)	30											1, 5, 12
D3-28	B 19+79.8 (31.8' LT) TO A 811+04.9 (46.0' RT)	87											1, 5, 12
SHEET TOTAL		1774				3	1	1	4	74		1	4, 5, 12


1. STANDARD PLAN B-5.20-00, CATCH BASIN TYPE 1
2. STANDARD PLAN B-10.20-00, CATCH BASIN TYPE 2
3. STANDARD PLAN B-10.40-00, CATCH BASIN TYPE 2 WITH FLOW RESTRICTOR. SEE SHEET DD3 FOR CONICAL OVERFLOW RACK DETAIL.
4. STANDARD PLAN B-35.40-00, GRATE INLET TYPE 2. A FRAME AND DUAL VANED GRATE SHALL BE USED, SEE STANADARD PLAN B-40.40-00.
5. SCHEDULE A PIPE SHALL BE CONSTRUCTED OF CORRUGATED POLYETHYLENE (PE), REFERENCE STANDARD SPECIFICATIONS 1-07.7(2) FOR SHALLOW COVER STANDARDS
6. MEDIA FILTER DRAIN TYPE 1 (WITHOUT UNDERDRAIN), SEE SHEET DD1 FOR DETAIL
7. MEDIA FILTER DRAIN TYPE 2 (WITH UNDERDRAIN), SEE SHEET DD1 FOR DETAIL
8. STANDARD PLAN B-70.20-00, BEVELED END SECTIONS.
9. SEE SHEET DD1 FOR STORM SEWER OUTLET DETAIL.
10. SEE SHEET DD3 FOR UNDERDRAIN DETAIL.
11. SEE SHEET DD3 FOR GEOMEMBRANE ANCHOR DETAIL. GEOMEMBRANE ANCHOR SHALL MATCH GEOSYNTHETIC CLAY LINER ANCHOR
12. SELECT BORROW INCL. HAUL SHALL BE USED TO BACKFILL STORM SEWER PIPES

FOR CONSTRUCTION PLANS ONLY

DESIGNED BY M. GUNN
ENTERED BY M. GUNN
CHECKED BY J. KORESKE
PROJ. ENGR. S. SPAHR
REGION ADM. L. ENG

DATE DATE REVISION BY

REGION NO. STATE FED. AID PROJ. NO.
10 WASH
JOB NUMBER 10A042
CONTRACT NO.

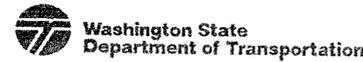

SR 9
SR 531/172ND ST NE & EAGLEFIELD DR
INTERSECTION IMPROVEMENT & PAVING

DSN 1
SHEET 62 OF 230 SHEETS


STRUCTURE NOTES - DRAINAGE

STRUCTURE NOTES - DRAINAGE

NOTE:
THE FIRST NUMBER OF THE "CODE DESIGNATION" BELOW REFERS TO THE SHEET NO. OR THE SHEET REFERENCE NO. SHOWING THE DRAINAGE FEATURE.

THE SECOND NUMBER REFERS TO THE DRAINAGE FEATURE FOUND ON THAT SHEET.

NOTE:													GENERAL NOTES:			
THE FIRST NUMBER OF THE "CODE DESIGNATION" BELOW REFERS TO THE SHEET NO. OR THE SHEET REFERENCE NO. SHOWING THE DRAINAGE FEATURE. THE SECOND NUMBER REFERS TO THE DRAINAGE FEATURE FOUND ON THAT SHEET.		STRUCTURE EXCAVATION CLASS B INCL. HAUL ***	SHORING OR EXTRA EXCAVATION CLASS B ***		GRAVEL BACKFILL FOR DRAIN	CONNECTION TO DRAINAGE STRUCTURE		CONSTRUCTION GEOTEXTILE FOR SEPARATION **	CONSTRUCTION GEOTEXTILE FOR UNDERGROUND DRAINAGE	GEOMEMBRANE ***					SEE GENERAL NOTES	* - Refer to sheets RP1-RP4, TCP1 and TPP2 for additional quantities. ** - Refer to sheets QTEC1-QTEC2 and AL1 for additional quantities. *** - Refer to sheets QTEC1-QTEC2 for additional quantities.
		C.Y.	S.F.	C.Y.	EACH	S.Y.	S.Y.	S.Y.								
CODE	LOCATION & \ UNIT OF MEASURE >															
D1-1	A 795+78.0 (23.3' LT) TO A 802+50.0 (35.0' LT)														6	1. STANDARD PLAN B-5.20-00, CATCH BASIN TYPE 1 2. STANDARD PLAN B-10.20-00, CATCH BASIN TYPE 2 3. STANDARD PLAN B-10.40-00, CATCH BASIN TYPE 2 WITH FLOW RESTRICTOR. SEE SHEET DD3 FOR CONICAL OVERFLOW RACK DETAIL. 4. STANDARD PLAN B-35.40-00, GRATE INLET TYPE 2. A FRAME AND DUAL VANED GRATE SHALL BE USED, SEE STANDARD PLAN B-40.40-00. 5. SCHEDULE A PIPE SHALL BE CONSTRUCTED OF CORRUGATED POLYETHYLENE (PE), REFERENCE STANDARD SPECIFICATIONS 1-07.7(2) FOR SHALLOW COVER STANDARDS 6. MEDIA FILTER DRAIN TYPE 1 (WITHOUT UNDERDRAIN), SEE SHEET DD1 FOR DETAIL 7. MEDIA FILTER DRAIN TYPE 2 (WITH UNDERDRAIN), SEE SHEET DD1 FOR DETAIL 8. STANDARD PLAN B-70.20-00, BEVELED END SECTIONS. 9. SEE SHEET DD1 FOR STORM SEWER OUTLET DETAIL. 10. SEE SHEET DD3 FOR UNDERDRAIN DETAIL. 11. SEE SHEET DD3 FOR GEOMEMBRANE ANCHOR DETAIL. GEOMEMBRANE ANCHOR SHALL MATCH GEOSYNTHETIC CLAY LINER ANCHOR 12. SELECT BORROW INCL. HAUL SHALL BE USED TO BACKFILL STORM SEWER PIPES
D1-2	A 795+78.0 (21.6' RT) TO A 798+05.0 (19.6' RT)													6		
D1-3	A 798+05.0 (19.6' RT) TO A 807+50.0 (40.6' RT)									220				7, 11		
D2-1	A 802+50.0 (35.0' LT) TO A 808+18.0 (52.1' LT)													7		
D3-1	A 807+94.1 (41.0' RT) TO A 808+19.5 (65.2' LT)	97	690											5, 12		
D3-2	A 808+18.0 (58.1' LT) TO A 808+28.2 (58.6' LT)	11	60											5, 12		
D3-3	A 808+28.2 (58.6' LT) TO A 808+29.4 (41.8' LT)	10	90											5, 12		
D3-4	A 808+29.4 (41.8' LT) TO A 808+96.8 (46.0' LT)	47	330											1, 5, 12		
D3-5	A 808+96.8 (46.0' LT) TO A 809+48.3 (68.6' LT)	41	280											1, 5, 12		
D3-6	A 808+19.5 (65.2' LT) TO A 809+50.2 (87.6' LT)	128	910											2, 5, 12		
D3-7	A 809+48.3 (68.6' LT) TO B 17+66.8 (32.9' RT)	43	270											2, 5, 12		
D3-8	A 809+50.2 (87.6' LT) TO A 809+79.6 (28.2' LT)	53	360											1, 5, 12		
D3-9	A 809+79.6 (28.2' LT) TO A 810+24.7 (31.1' RT)	27			6			70						10, 12		
D3-10	A 809+50.2 (87.6' LT) TO B 15+51.2 (52.0' RT)	248	1920											5, 12		
D3-11	B 17+13.5 (27.2' RT) TO B 17+66.8 (32.9' RT)	30												1, 5, 12		
D3-12	B 15+50.4 (35.6' RT) TO B 17+13.5 (27.2' RT)	101	740											1, 5, 12		
D3-13	B 15+72.0 (33.6' LT) TO B 17+66.3 (33.0' LT)	112	820											1, 5, 12		
D3-14	A 811+79.8 (13.6' LT) TO A 811+80.9 (44.1' LT)	15												1, 5, 8, 12		
D3-15	A 812+17.4 (62.7' LT) TO A 812+18.1 (70.4' LT)	9												3, 5		
D3-16	A 812+18.1 (70.4' LT) TO A 813+44.7 (61.4' LT)	13												5, 8, 9		
D3-17	A 813+68.0 (44.2' LT) TO A 819+34.0 (23.5' LT)													6		
D3-18	A 807+51.8 (53.6' RT) TO A 807+51.1 (46.6' RT)	9	60											1, 5, 8, 12		
D3-19	A 807+51.1 (46.6' RT) TO A 807+94.1 (41.0' RT)	38	300											1, 5, 12		
D3-20	A 807+94.1 (41.0' RT) TO A 807+94.9 (47.7' RT)	8	50											5, 8, 12		
D3-21	A 808+26.0 (17.8' RT) TO A 808+88.2 (24.3' RT)	45	320											1, 5, 12		
D3-22	A 808+88.2 (24.3' RT) TO A 808+96.8 (46.0' LT)	50	350											1, 5, 12		
D3-23	A 808+88.2 (24.3' RT) TO A 809+45.9 (73.6' RT)	54	380											1, 5, 12		
D3-24	A 809+45.9 (73.6' RT) TO B 20+03.3 (22.6' RT)	37	250											1, 5, 12		
D3-25	B 20+03.3 (22.6' RT) TO B 20+74.7 (16.5' RT)	61	440											1, 5, 12		
D3-26	B 20+06.5 (21.6' LT) TO B 20+75.6 (14.0' LT)	67	480											1, 5, 12		
D3-27	B 19+79.8 (31.8' LT) TO B 20+06.5 (21.6' LT)	27	170											1, 5, 12		
D3-28	B 19+79.8 (31.8' LT) TO A 811+04.9 (46.0' RT)	75	520											4, 5, 12		
SHEET TOTAL		1456	9790		6			70	220							

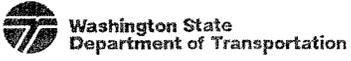DESIGNED BY	M. GUNN	ENTERED BY	M. GUNN	CHECKED BY	J. KORESKI	PROJ. ENGR.	S. SPAHR	REGION ADM.	L. ENG	DATE	DATE	REVISION	BY	REGION NO.	STATE	FED. AID PROJ. NO.		SR 9	DSN 3
			10		WASH									SR 531/172ND ST NE & EAGLEFIELD DR INTERSECTION IMPROVEMENT & PAVING					
			JOB NUMBER																
			10A042																
	CONTRACT NO.																		STRUCTURE NOTES - DRAINAGE

FOR AS CONSTRUCTION
 PLANS

STRUCTURE NOTES - DRAINAGE

NOTE: THE FIRST NUMBER OF THE "CODE DESIGNATION" BELOW REFERS TO THE SHEET NO. OR THE SHEET REFERENCE NO. SHOWING THE DRAINAGE FEATURE. THE SECOND NUMBER REFERS TO THE DRAINAGE FEATURE FOUND ON THAT SHEET.		SELECT BORROW INCL. HAUL *	SAND DRAINAGE BLANKET	EMBANKMENT COMPACTION *	GEOSYNTHETIC CLAY LINER	CONCRETE INLET	GRATE INLET TYPE 2	DROP INLET TYPE 1	QUARRY SPALLS **	UNDERDRAIN PIPE 6 IN. DIAM.	SCHEDULE A CULV. PIPE 12 IN. DIAM. **	CATCH BASIN TYPE 2 54 IN. DIAM. WITH FLOW RESTRICTOR	SEE GENERAL NOTES	GENERAL NOTES:
CODE	LOCATION \ UNIT OF MEASURE >	TON	TON	C.Y.	S.F.	EACH	EACH	EACH	TON	L.F.	L.F.	EACH		
D3-29	A 811+04.9 (46.0' RT) TO A 811+71.9 (42.1' RT)	41												1. 5, 12
D3-30	A 811+71.9 (42.1' RT) TO A 811+79.8 (13.6' LT)	19												1. 5, 12
D3-31	A 811+08.2 (62.7' RT) TO B 19+92.4 (51.3' LT)	78												1. 5, 8, 12
D3-32	A 811+08.2 (62.7' RT) TO A 812+50.2 (45.0' RT)	143												1. 5, 12
D3-33	A 812+50.2 (45.9' RT) TO A 813+15.5 (57.3' RT)	49							4					1. 5, 8, 9, 12
D3	DETENTION POND	1057	122	576	5286									
D3	PERMANENT BERM	7		4										
D5-1	B 12+00.8 (30.3' LT) TO B 12+19.8 (30.3' LT)	19												2, 8, 12
D5-2	B 12+19.8 (30.3' LT) TO B 13+01.2 (30.7' LT)	56												1, 5, 12
D5-3	B 13+01.2 (30.7' LT) TO B 14+06.8 (34.1' LT)	65												1, 12
D5-4	B 13+64.8 (35.4' RT) TO B 14+21.5 (45.5' LT)	176												12
D5-5	B 15+50.4 (49.4' LT) TO B 15+72.0 (33.6' LT)	62												2, 5, 12
D5-6	B 11+45.8 (25.6' RT) TO B 12+55.7' (35.8' RT)	7							4					1, 5, 8, 9, 12
D5-7	B 12+55.7 (35.8' RT) TO B 13+64.8 (35.4' RT)	123												2, 5, 12
D5-8	B 14+16.0 (35.2' RT) TO B 15+50.4 (35.6' RT)	195												1, 5, 12
D5-9	B 13+64.8 (35.4' RT) TO B 15+51.2 (52.0' RT)	346												2, 5, 12
D5-10	B 15+50.4 (35.6' RT) TO B 15+72.0 (33.6' LT)	180												2, 5, 12
D5	DETENTION VAULT								270					
D6-1	B 20+75.6 (16.2' LT) TO B 22+44.9 (15.2' LT)	250												1, 5, 12
D6-2	B 22+82.7 (27.5' LT) TO B 23+47.9 (16.3' LT)	30				1								1, 5, 12
D6-3	B 20+74.7 (18.6' RT) TO B 22+01.4 (15.1' RT)	180												1, 5, 12
D6-4	B 21+49.2 (30.3' LT) TO B 22+32.4 (29.2' LT)	83									84			5, 12
D3-34	B 19+95 TO B 20+15 RT										20			
SHEET TOTAL		3166	122	580	5286				278		84			
PROJECT TOTAL		4940	122	580	5286	3	1	1	282	74	84	1		

1. STANDARD PLAN B-5.20-00, CATCH BASIN TYPE 1

2. STANDARD PLAN B-10.20-00, CATCH BASIN TYPE 2

3. STANDARD PLAN B-10.40-00, CATCH BASIN TYPE 2 WITH FLOW RESTRICTOR. SEE SHEET DD3 FOR CONICAL OVERFLOW RACK DETAIL.

4. STANDARD PLAN B-35.40-00, GRATE INLET TYPE 2. A FRAME AND DUAL VANED GRATE SHALL BE USED, SEE STANDARD PLAN B-40.40-00.

5. SCHEDULE A PIPE SHALL BE CONSTRUCTED OF CORRUGATED POLYETHYLENE (PE), REFERENCE STANDARD SPECIFICATIONS 1-07.7(2) FOR SHALLOW COVER STANDARDS

6. MEDIA FILTER DRAIN TYPE 1 (WITHOUT UNDERDRAIN), SEE SHEET DD1 FOR DETAIL

7. MEDIA FILTER DRAIN TYPE 2 (WITH UNDERDRAIN), SEE SHEET DD1 FOR DETAIL


8. STANDARD PLAN B-70.20-00, BEVELED END SECTIONS

9. SEE SHEET DD1 FOR STORM SEWER OUTLET DETAIL

10. SEE SHEET DD3 FOR UNDERDRAIN DETAIL.

11. SEE SHEET DD3 FOR GEOMEMBRANE ANCHOR DETAIL. GEOMEMBRANE ANCHOR SHALL MATCH GEOSYNTHETIC CLAY LINER ANCHOR

12. SELECT BORROW INCL. HAUL SHALL BE USED TO BACKFILL STORM SEWER PIPES

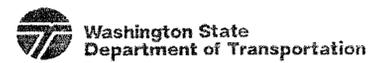
DESIGNED BY	M. GUNN	ENTERED BY	M. GUNN	CHECKED BY	J. KORESKI	PROJ. ENGR.	S. SPAHR	REGION ADM.	L. ENG	DATE	DATE	REVISION	BY	REGION NO.	STATE	FED. AID PROJ. NO.		SR 9 SR 531/172ND ST NE & EAGLEFIELD DR INTERSECTION IMPROVEMENT & PAVING	DSN 4 SHEET 65 OF 230 SHEETS				
														JOB NUMBER 10A042			CONTRACT NO.				STRUCTURE NOTES - DRAINAGE		

STRUCTURE NOTES - DRAINAGE

NOTE: THE FIRST NUMBER OF THE "CODE DESIGNATION" BELOW REFERS TO THE SHEET NO. OR THE SHEET REFERENCE NO. SHOWING THE DRAINAGE FEATURE. THE SECOND NUMBER REFERS TO THE DRAINAGE FEATURE FOUND ON THAT SHEET.															CATCH BASIN TYPE 1		CATCH BASIN TYPE 2 48 IN. DIAM.	TESTING STORM SEWER PIPE		SCHEDULE A STORM SEWER PIPE 12 IN. DIAM.	SCHEDULE A STORM SEWER PIPE 18 IN. DIAM.	60# DUCTILE IRON SEWER PIPE 12 IN. DIAM.	CONICAL OVERFLOW RACK		STRUCTURE EXCAVATION CLASS A INCL. HAUL	CRUSHED SURFACING BASE COURSE*	MEDIA FILTER DRAIN TYPE 1	MEDIA FILTER DRAIN TYPE 2	SEE GENERAL NOTES	GENERAL NOTES:
CODE	LOCATION \ UNIT OF MEASURE >	EACH	EACH	L.F.		L.F.	L.F.		EACH		C.Y.	TON	L.F.	L.F.		GENERAL NOTES:														
D3-29	A 811+04.9 (46.0' RT) TO A 811+71.9 (42.1' RT)	1		68		68									1, 5, 12	* - Refer to sheets RP1-RP4, TCP1 and TPP2 for additional quantities. ** - Refer to sheets QTEC1-QTEC2 and AL1 for additional quantities. *** - Refer to sheets QTEC1-QTEC2 for additional quantities.														
D3-30	A 811+71.9 (42.1' RT) TO A 811+79.8 (13.6' LT)	1		57		57	59.6								1, 5, 12															
D3-31	A 811+08.2 (62.7' RT) TO B 19+92.4 (51.3' LT)	1		112		112									1, 5, 8, 12															
D3-32	A 811+08.2 (62.7' RT) TO A 812+50.2 (45.0' RT)	1		144		144									1, 5, 12															
D3-33	A 812+50.2 (45.9' RT) TO A 813+15.5 (57.3' RT)			67		67									1, 5, 8, 9, 12															
D3	DETENTION POND											63																		
D3	PERMANENT BERM																													
D5-1	B 12+00.8 (30.3' LT) TO B 12+19.8 (30.3' LT)	1	X	19		19									2, 8, 12															
D5-2	B 12+19.8 (30.3' LT) TO B 13+01.2 (30.7' LT)	1		81		81									1, 5, 12															
D5-3	B 13+01.2 (30.7' LT) TO B 14+06.8 (34.1' LT)	1		106		106									1, 12															
D5-4	B 13+64.8 (35.4' RT) TO B 14+21.5 (45.5' LT)			99		99									12															
D5-5	B 15+50.4 (49.4' LT) TO B 15+72.0 (33.6' LT)		1	27			27								2, 5, 12															
D5-6	B 11+45.8 (25.6' RT) TO B 12+55.7' (35.8' RT)	1		110		110									1, 5, 8, 9, 12															
D5-7	B 12+55.7 (35.8' RT) TO B 13+64.8 (35.4' RT)		1	109		109									2, 5, 12															
D5-8	B 14+16.0 (35.2' RT) TO B 15+50.4 (35.6' RT)	1		136		136									1, 5, 12															
D5-9	B 13+64.8 (35.4' RT) TO B 15+51.2 (52.0' RT)		1	188		188									2, 5, 12															
D5-10	B 15+50.4 (35.6' RT) TO B 15+72.0 (33.6' LT)		1	73			73								2, 5, 12															
D5	DETENTION VAULT										1490	55																		
D6-1	B 20+75.6 (16.2' LT) TO B 22+44.9 (15.2' LT)	1		170		170									1, 5, 12															
D6-2	B 22+82.7 (27.5' LT) TO B 23+47.9 (16.3' LT)	X		67		67	10								1, 5, 12															
D6-3	B 20+74.7 (18.6' RT) TO B 22+01. (15.1' RT)	1		127		127									1, 5, 12															
D6-4	B 21+49.2 (30.3' LT) TO B 22+32.4 (29.2' LT)														5, 12															
	SHEET TOTAL	11	5	1760		1660	100				1490	118																		
	PROJECT TOTAL	25	7	3679		3579	100		1		1490	118	1462	1509																

1. STANDARD PLAN B-5.20-00, CATCH BASIN TYPE 1
2. STANDARD PLAN B-10.20-00, CATCH BASIN TYPE 2
3. STANDARD PLAN B-10.40-00, CATCH BASIN TYPE 2 WITH FLOW RESTRICTOR. SEE SHEET DD3 FOR CONICAL OVERFLOW RACK DETAIL.
4. STANDARD PLAN B-35.40-00, GRATE INLET TYPE 2. A FRAME AND DUAL VANED GRATE SHALL BE USED, SEE STANADARD PLAN B-40.40-00.
5. SCHEDULE A PIPE SHALL BE CONSTRUCTED OF CORRUGATED POLYETHYLENE (PE), REFERENCE STANDARD SPECIFICATIONS 1-07.7(2) FOR SHALLOW COVER STANDARDS
6. MEDIA FILTER DRAIN TYPE 1 (WITHOUT UNDERDRAIN), SEE SHEET DD1 FOR DETAIL
7. MEDIA FILTER DRAIN TYPE 2 (WITH UNDERDRAIN), SEE SHEET DD1 FOR DETAIL
8. STANDARD PLAN B-70.20-00, BEVELED END SECTIONS
9. SEE SHEET DD1 FOR STORM SEWER OUTLET DETAIL
10. SEE SHEET DD3 FOR UNDERDRAIN DETAIL.
11. SEE SHEET DD3 FOR GEOMEMBRANE ANCHOR DETAIL. GEOMEMBRANE ANCHOR SHALL MATCH GEOSYNTHETIC CLAY LINER ANCHOR
12. SELECT BORROW INCL. HAUL SHALL BE USED TO BACKFILL STORM SEWER PIPES

FOR AS CONSTRUCTION PLANS ONLY

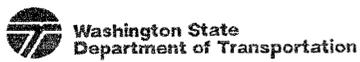
DESIGNED BY	M. GUNN	ENTERED BY	M. GUNN	CHECKED BY	J. KORESKE	PROJ. ENGR.	S. SPAHR	REGION ADM.	L. ENG	DATE	DATE	REVISION	BY	REGION NO.	STATE	FED. AID PROJ. NO.	JOB NUMBER	CONTRACT NO.		SR 9 SR 531/172ND ST NE & EAGLEFIELD DR INTERSECTION IMPROVEMENT & PAVING	DSN 5 SHEET 66 OF 230 SHEETS
STRUCTURE NOTES - DRAINAGE																					

STRUCTURE NOTES - DRAINAGE

NOTE: THE FIRST NUMBER OF THE "CODE DESIGNATION" BELOW REFERS TO THE SHEET NO. OR THE SHEET REFERENCE NO. SHOWING THE DRAINAGE FEATURE. THE SECOND NUMBER REFERS TO THE DRAINAGE FEATURE FOUND ON THAT SHEET.		STRUCTURE EXCAVATION CLASS B INCL. HAUL ***	SHORING OR EXTRA EXCAVATION CLASS B***	GRAVEL BACKFILL FOR DRAIN	CONNECTION TO DRAINAGE STRUCTURE	CONSTRUCTION GEOTEXTILE FOR SEPARATION**	CONSTRUCTION GEOTEXTILE FOR UNDERGROUND DRAINAGE	GEOMEMBRANE ***	SEE GENERAL NOTES	GENERAL NOTES:
CODE	LOCATION \ UNIT OF MEASURE >	C.Y.	S.F.	C.Y.	EACH	S.Y.	S.Y.	S.Y.		
D3-29	A 811+04.9 (46.0' RT) TO A 811+71.9 (42.1' RT)	40							1, 5, 12	* - Refer to sheets RP1-RP4, TCP1 and TPP2 for additional quantities. ** - Refer to sheets QTEC1-QTEC2 and AL1 for additional quantities. *** - Refer to sheets QTEC1-QTEC2 for additional quantities.
D3-30	A 811+71.9 (42.1' RT) TO A 811+79.8 (13.6' LT)	25							1, 5, 12	
D3-31	A 811+08.2 (62.7' RT) TO B 19+92.4 (51.3' LT)	65	470						1, 5, 8, 12	
D3-32	A 811+08.2 (62.7' RT) TO A 812+50.2 (45.0' RT)	109	810						1, 5, 12	
D3-33	A 812+50.2 (45.9' RT) TO A 813+15.5 (57.3' RT)	39	300						1, 5, 8, 9, 12	
D3	DETENTION POND	536								
D3	PERMANENT BERM									
D5-1	B 12+00.8 (30.3' LT) TO B 12+19.8 (30.3' LT)	24	110		1				2, 8, 12	
D5-2	B 12+19.8 (30.3' LT) TO B 13+01.2 (30.7' LT)	51	350						1, 5, 12	
D5-3	B 13+01.2 (30.7' LT) TO B 14+06.8 (34.1' LT)	61	430						1, 12	
D5-4	B 13+64.8 (35.4' RT) TO B 14+21.5 (45.5' LT)	105	810						12	
D5-5	B 15+50.4 (49.4' LT) TO B 15+72.0 (33.6' LT)	54	280						2, 5, 12	
D5-6	B 11+45.8 (25.6' RT) TO B 12+55.7' (35.8' RT)	29							1, 5, 8, 9, 12	
D5-7	B 12+55.7 (35.8' RT) TO B 13+64.8 (35.4' RT)	88	590						2, 5, 12	
D5-8	B 14+16.0 (35.2' RT) TO B 15+50.4 (35.6' RT)	136	1020						1, 5, 12	
D5-9	B 13+64.8 (35.4' RT) TO B 15+51.2 (52.0' RT)	208	1590						2, 5, 12	
D5-10	B 15+50.4 (35.6' RT) TO B 15+72.0 (33.6' LT)	127	810						2, 5, 12	
D5	DETENTION VAULT					470				
D6-1	B 20+75.6 (16.2' LT) TO B 22+44.9 (15.2' LT)	172	1290						1, 5, 12	
D6-2	B 22+82.7 (27.5' LT) TO B 23+47.9 (16.3' LT)	33	220						1, 5, 12	
D6-3	B 20+74.7 (18.6' RT) TO B 22+01.4 (15.1' RT)	126	940						1, 5, 12	
D6-4	B 21+49.2 (30.3' LT) TO B 22+32.4 (29.2' LT)	46	360						5, 12	
SHEET TOTAL		2074	10380		1	470				
PROJECT TOTAL		3530	20170	6	1	470	70	220		

1. STANDARD PLAN B-5.20-00, CATCH BASIN TYPE 1
2. STANDARD PLAN B-10.20-00, CATCH BASIN TYPE 2
3. STANDARD PLAN B-10.40-00, CATCH BASIN TYPE 2 WITH FLOW RESTRICTOR. SEE SHEET DD3 FOR CONICAL OVERFLOW RACK DETAIL.
4. STANDARD PLAN B-35.40-00, GRATE INLET TYPE 2. A FRAME AND DUAL VANED GRATE SHALL BE USED, SEE STANDARD PLAN B-40.40-00.
5. SCHEDULE A PIPE SHALL BE CONSTRUCTED OF CORRUGATED POLYETHYLENE (PE), REFERENCE STANDARD SPECIFICATIONS 1-07.7(2) FOR SHALLOW COVER STANDARDS
6. MEDIA FILTER DRAIN TYPE 1 (WITHOUT UNDERDRAIN), SEE SHEET DD1 FOR DETAIL
7. MEDIA FILTER DRAIN TYPE 2 (WITH UNDERDRAIN), SEE SHEET DD1 FOR DETAIL
8. STANDARD PLAN B-70.20-00, BEVELED END SECTIONS
9. SEE SHEET DD1 FOR STORM SEWER OUTLET DETAIL
10. SEE SHEET DD3 FOR UNDERDRAIN DETAIL.
11. SEE SHEET DD3 FOR GEOMEMBRANE ANCHOR DETAIL. GEOMEMBRANE ANCHOR SHALL MATCH GEOSYNTHETIC CLAY LINER ANCHOR
12. SELECT BORROW INCL. HAUL SHALL BE USED TO BACKFILL STORM SEWER PIPES


FOR HAS CONSTRUCTED PLANS ONLY

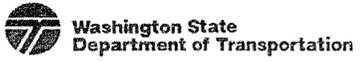DESIGNED BY	M. GUNN	ENTERED BY	M. GUNN	CHECKED BY	J. KORESKE	PROJ. ENGR.	S. SPAHR	REGION NO.	STATE	FED. AID PROJ. NO.			
REGION ADM.	L. ENG	DATE	DATE	REVISION	BY	JOB NUMBER	10A042	10	WASH			SR 9 SR 531/172ND ST NE & EAGLEFIELD DR INTERSECTION IMPROVEMENT & PAVING	DSN 6
												STRUCTURE NOTES - DRAINAGE	SHEET 67 OF 230 SHEETS

T. 31N. R. 5E. W.M.




LEGEND					
	WSDOT RW		EXISTING CULVERT		BERM
	STREAM BUFFER		NEW CULVERT		EXISTING MANHOLE
	WETLAND BUFFER		EXISTING STORM SEWER PIPE		EXISTING CATCH BASIN
	WETLAND SYMBOL		NEW STORM SEWER PIPE		NEW GRATE INLET
	WETLAND BOUNDARY		NEW UNDERDRAIN LINE		NEW CATCH BASIN
	ORDINARY HIGH WATER MARK		EXISTING DITCH		DRAINAGE STRUCTURE NOTE
	NEW EDGE		NEW DITCH		DRAINAGE CONTINUATION NOTE
	EXISTING EDGE		MEDIA FILTER DRAIN		

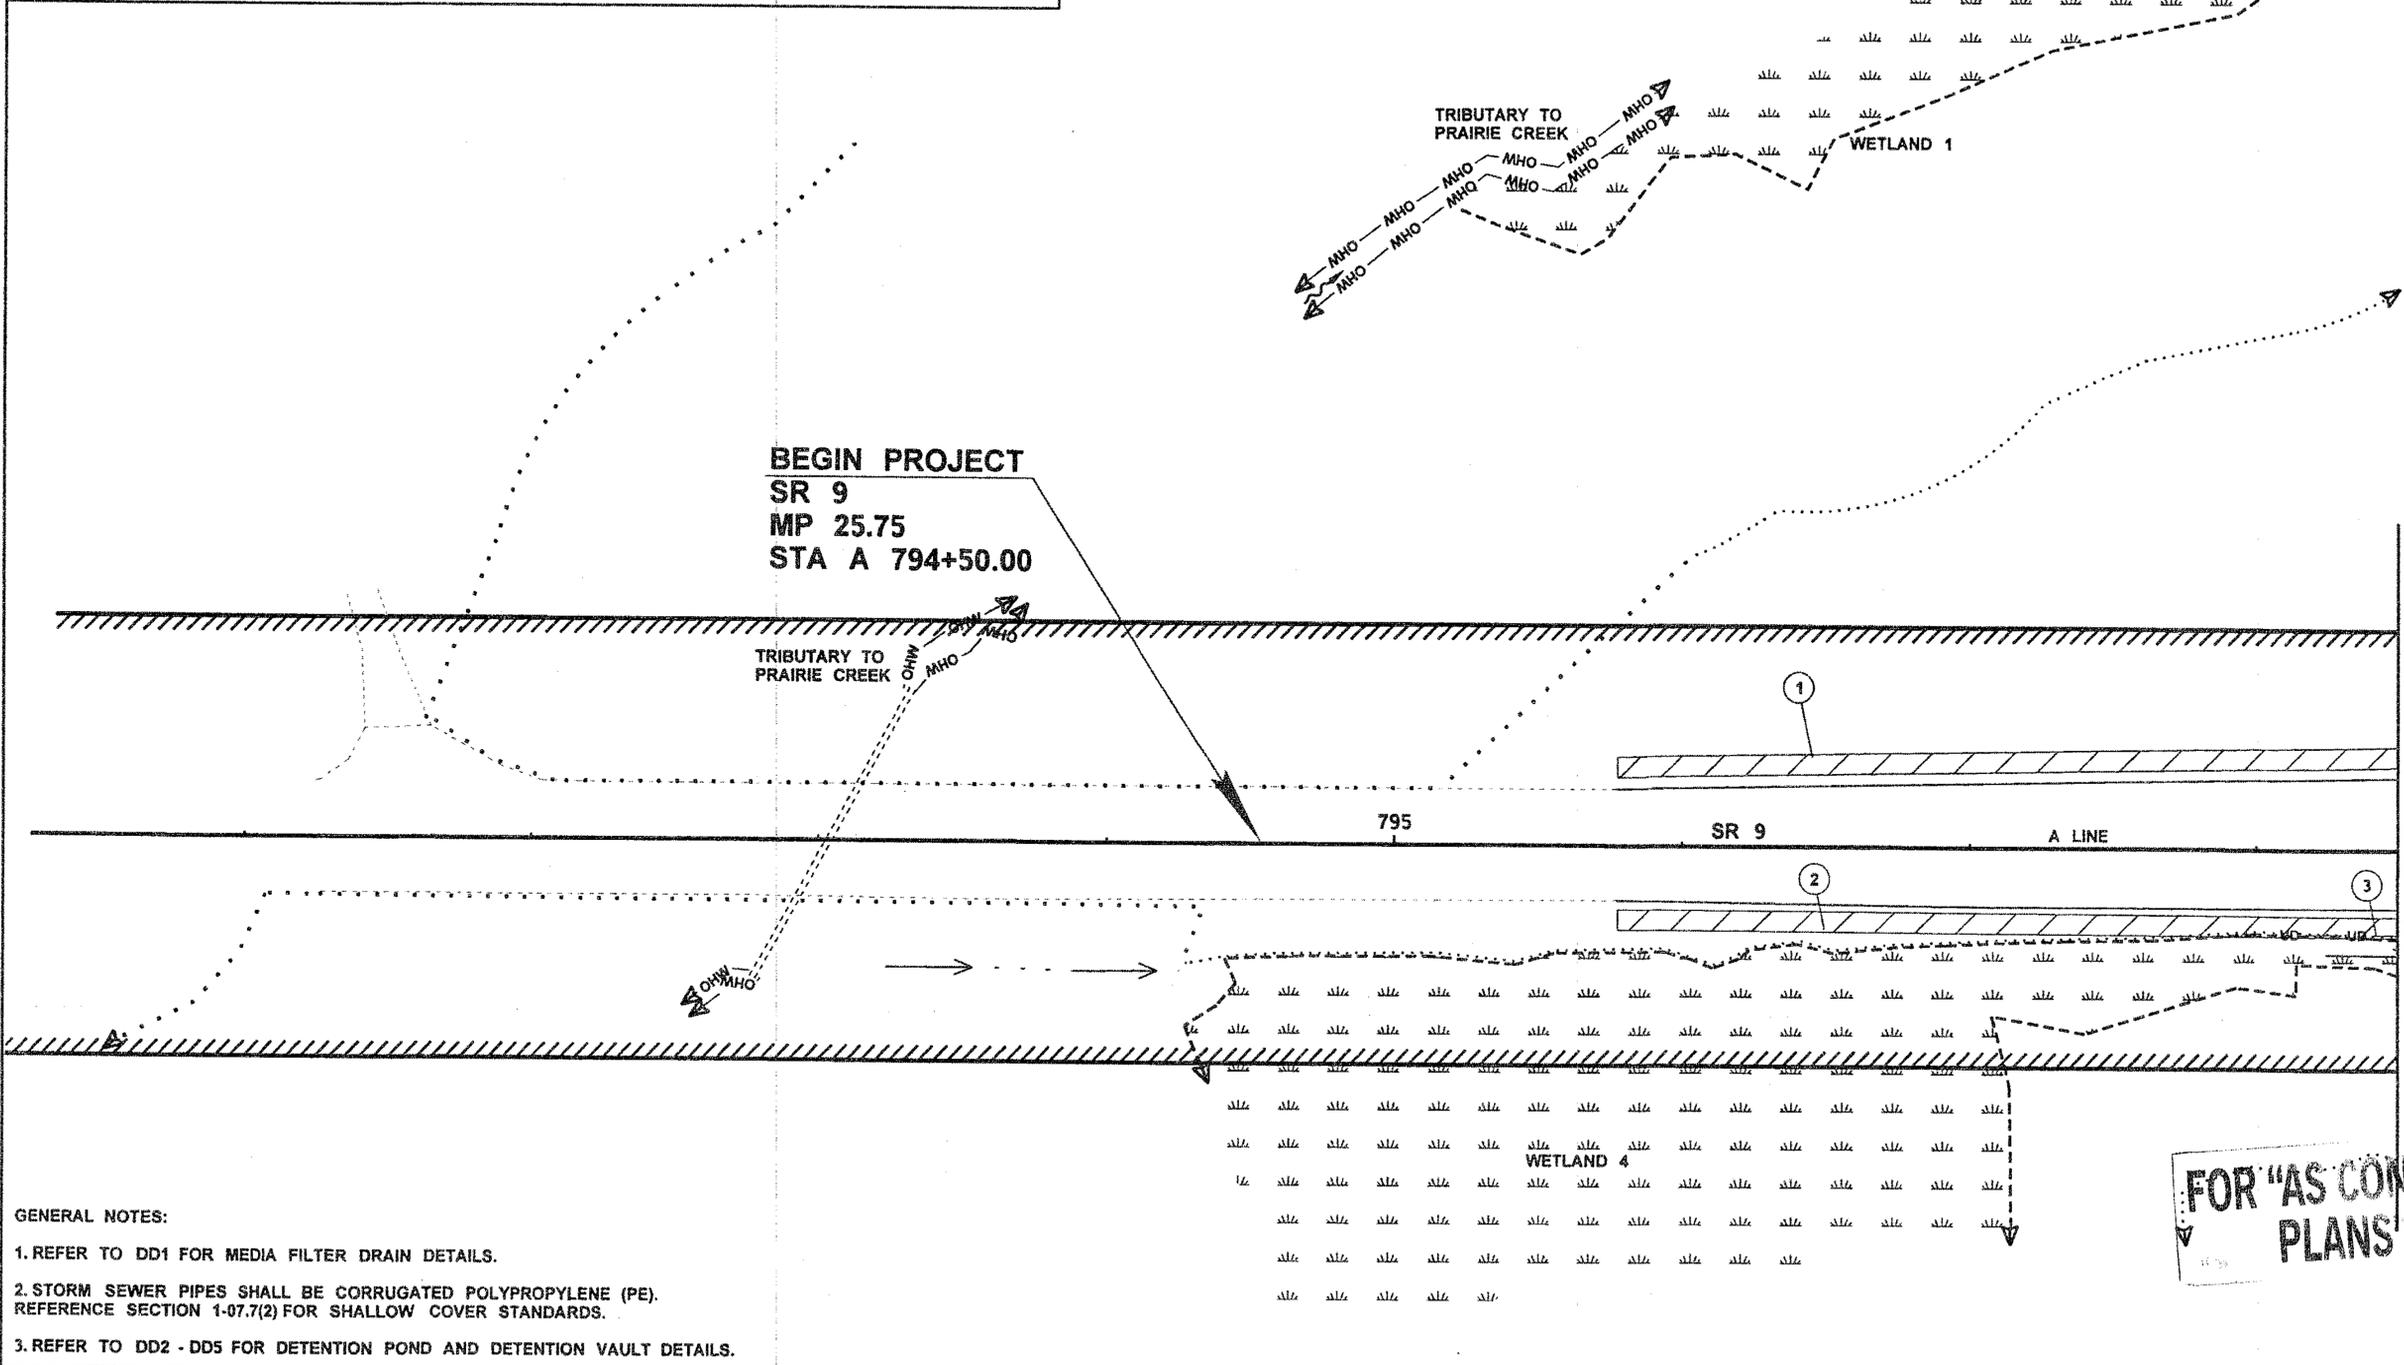

MATCH LINE STA A 798+50 SEE SHEET D2


- GENERAL NOTES:**
- REFER TO DD1 FOR MEDIA FILTER DRAIN DETAILS.
 - STORM SEWER PIPES SHALL BE CORRUGATED POLYPROPYLENE (PE). REFERENCE SECTION 1-07.7(2) FOR SHALLOW COVER STANDARDS.
 - REFER TO DD2 - DD5 FOR DETENTION POND AND DETENTION VAULT DETAILS.

FOR "AS CONSTRUCTED PLANS" ONLY

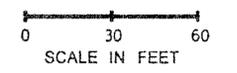


FILE NAME: I:\Projects\XL3325_SR9_SR531_172nd_St_NE_Int\CAD\PS&ESheets\XL3325_PS_DRAINAGE.dgn				REGION NO. 10 STATE WASH		FED.AID PROJ.NO.				SR 9		Plot 1
TIME: 9:05:11 AM	DATE: 9/20/2011	DESIGNED BY: M. GUNN	ENTERED BY: K. SOLWOLD	CHECKED BY: J. KORESKI	PROJ. ENGR: S. SPAHR	REGIONAL ADM: L. ENG	LOCATION NO.			SR 531/172ND ST NE & EAGLEFIELD DR INTERSECTION IMPROVEMENT & PAVING		PLAN REF NO: D1
								DATE: 9/22/11	DRAINAGE PLAN		SHEET 68 OF 230 SHEETS	

T. 31N. R. 5E. W.M.

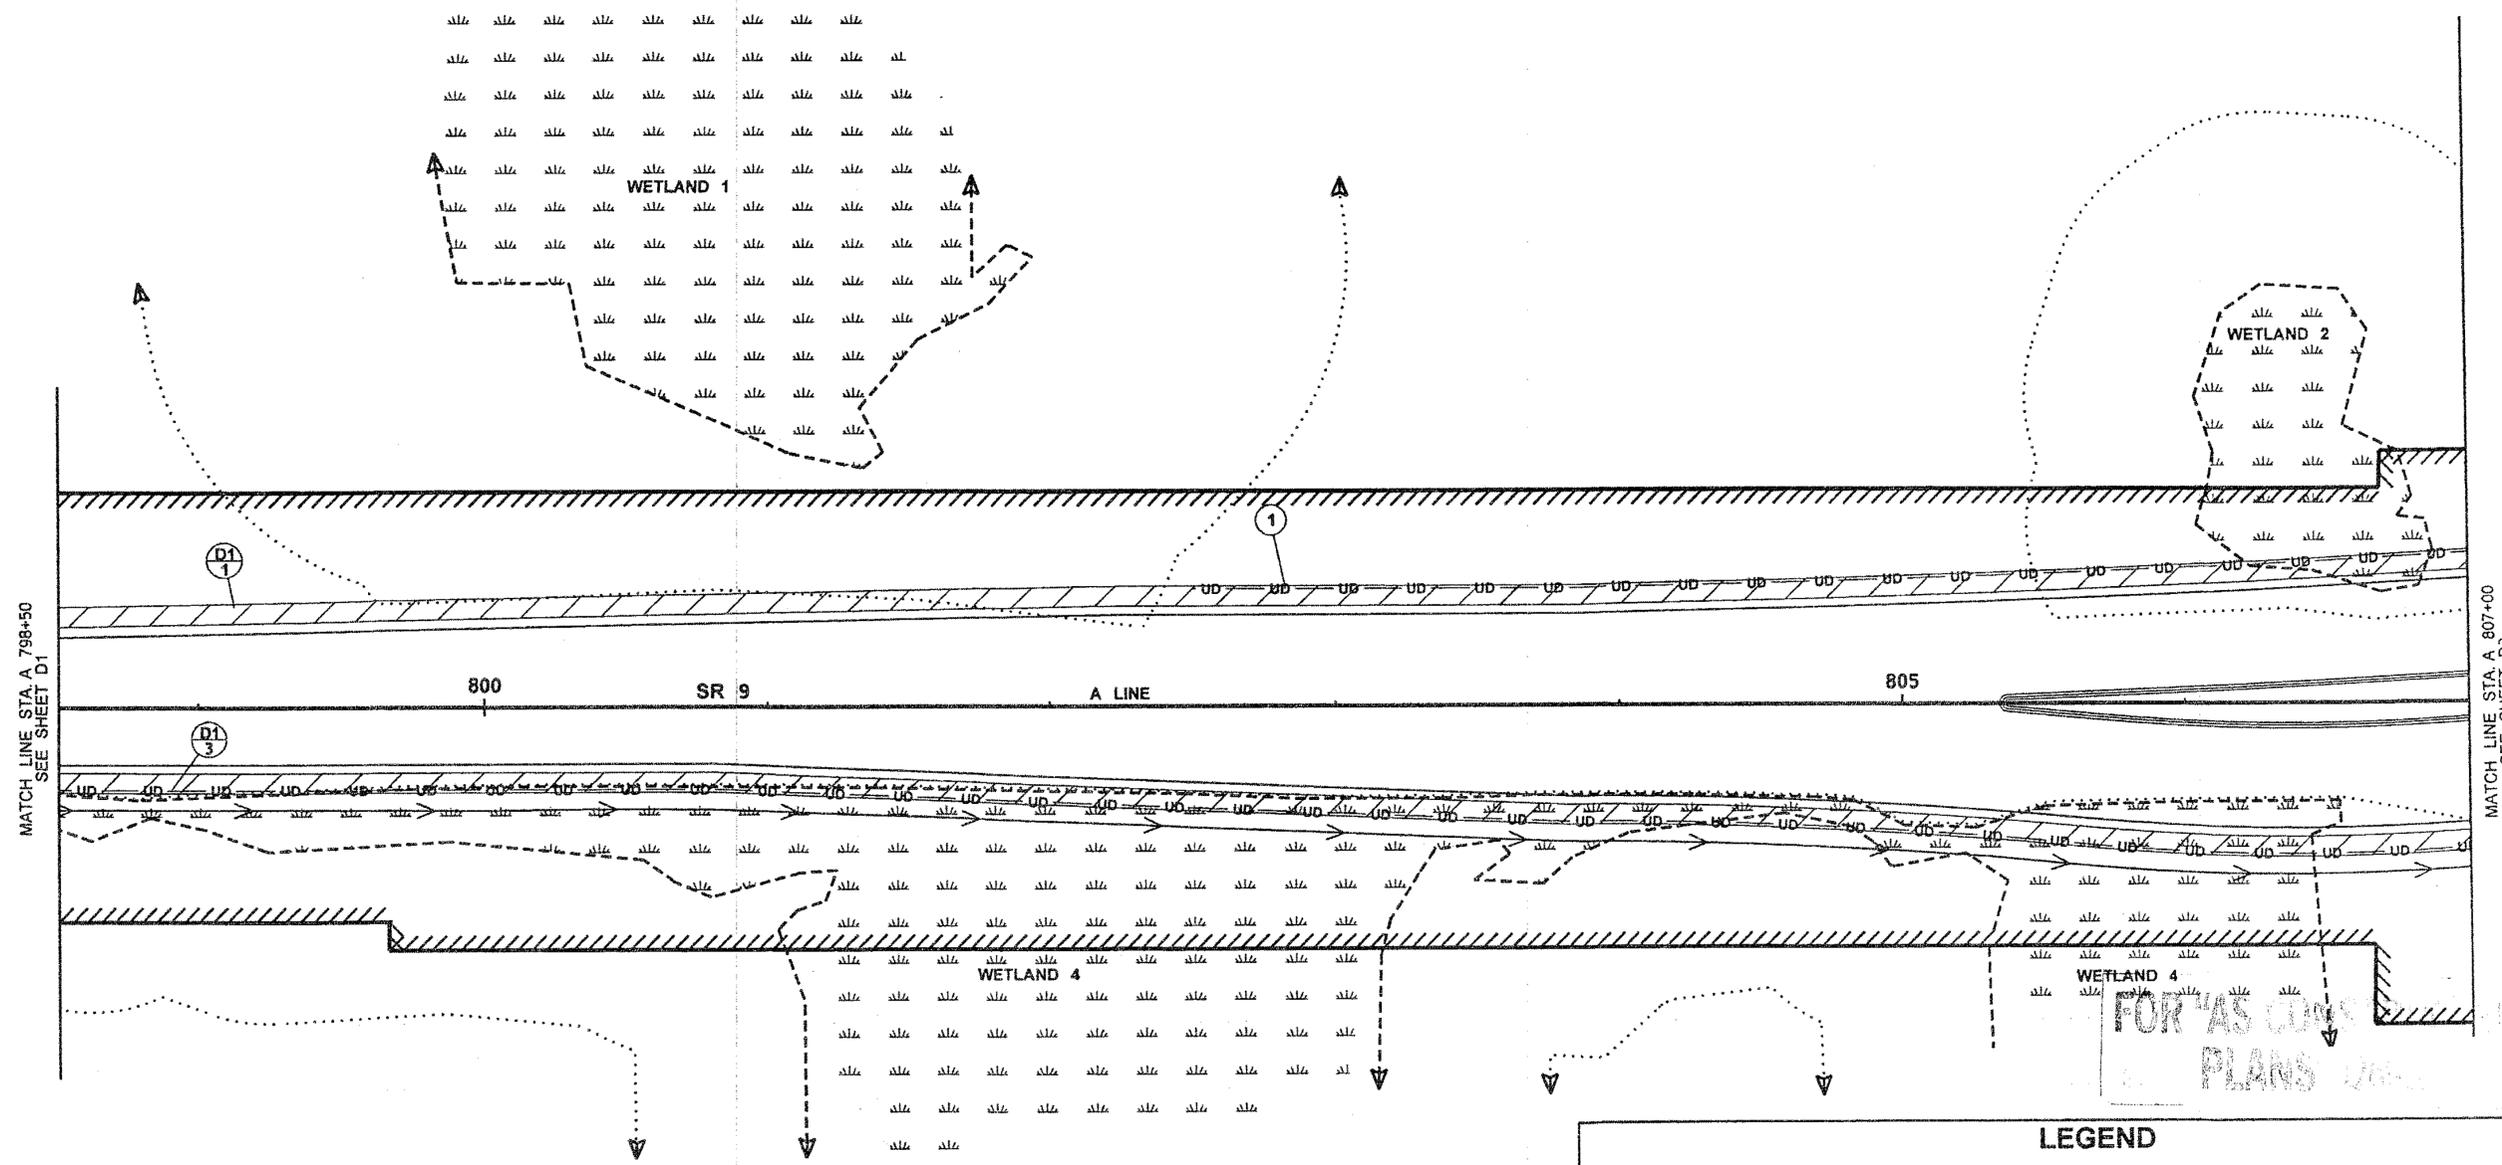


GENERAL NOTES:
 1. REFER TO DD1 FOR MEDIA FILTER DRAIN DETAILS.
 2. STORM SEWER PIPES SHALL BE CORRUGATED POLYPROPYLENE (PE). REFERENCE SECTION 1-07.7(2) FOR SHALLOW COVER STANDARDS.
 3. REFER TO DD2 - DD5 FOR DETENTION POND AND DETENTION VAULT DETAILS.

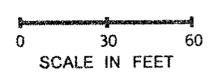

LEGEND			
	WSDOT R/W		EXISTING CULVERT
	STREAM BUFFER		NEW CULVERT
	WETLAND BUFFER		EXISTING STORM SEWER PIPE
	WETLAND SYMBOL		NEW STORM SEWER PIPE
	WETLAND BOUNDARY		NEW UNDERDRAIN LINE
	ORDINARY HIGH WATER MARK		EXISTING DITCH
	NEW EDGE		NEW DITCH
	EXISTING EDGE		MEDIA FILTER DRAIN
	BERM		EXISTING MANHOLE
			EXISTING CATCH BASIN
			NEW GRATE INLET
			NEW CATCH BASIN
			DRAINAGE STRUCTURE NOTE
			DRAINAGE CONTINUATION NOTE


FILE NAME: I:\Projects\XL3325 SR9 SR531 172nd St NE Int\CADIPS&ESheets\XL3325 PS_DRAINAGE.dgn		REGION NO. STATE		FED.AID PROJ.NO.				SR 9		SR 531/172ND ST NE & EAGLEFIELD DR INTERSECTION IMPROVEMENT & PAVING DRAINAGE PLAN	Plot 2
TIME: 9:05:12 AM	DATE: 9/20/2011	10	WASH					SR 531/172ND ST NE & EAGLEFIELD DR	SR 531/172ND ST NE & EAGLEFIELD DR		Plot 2
DESIGNED BY: M. GUNN	ENTERED BY: K.SOLWOLD	JOB NUMBER: 10A042	CONTRACT NO.	LOCATION NO.							PLAN REF NO: D2
CHECKED BY: J. KORESKI	PROJ. ENGR: S.SPAHR										SHEET 69 OF 230 SHEETS
REGIONAL ADM. L. ENG	REVISION	DATE	BY								

T. 31N. R. 5E. W.M.

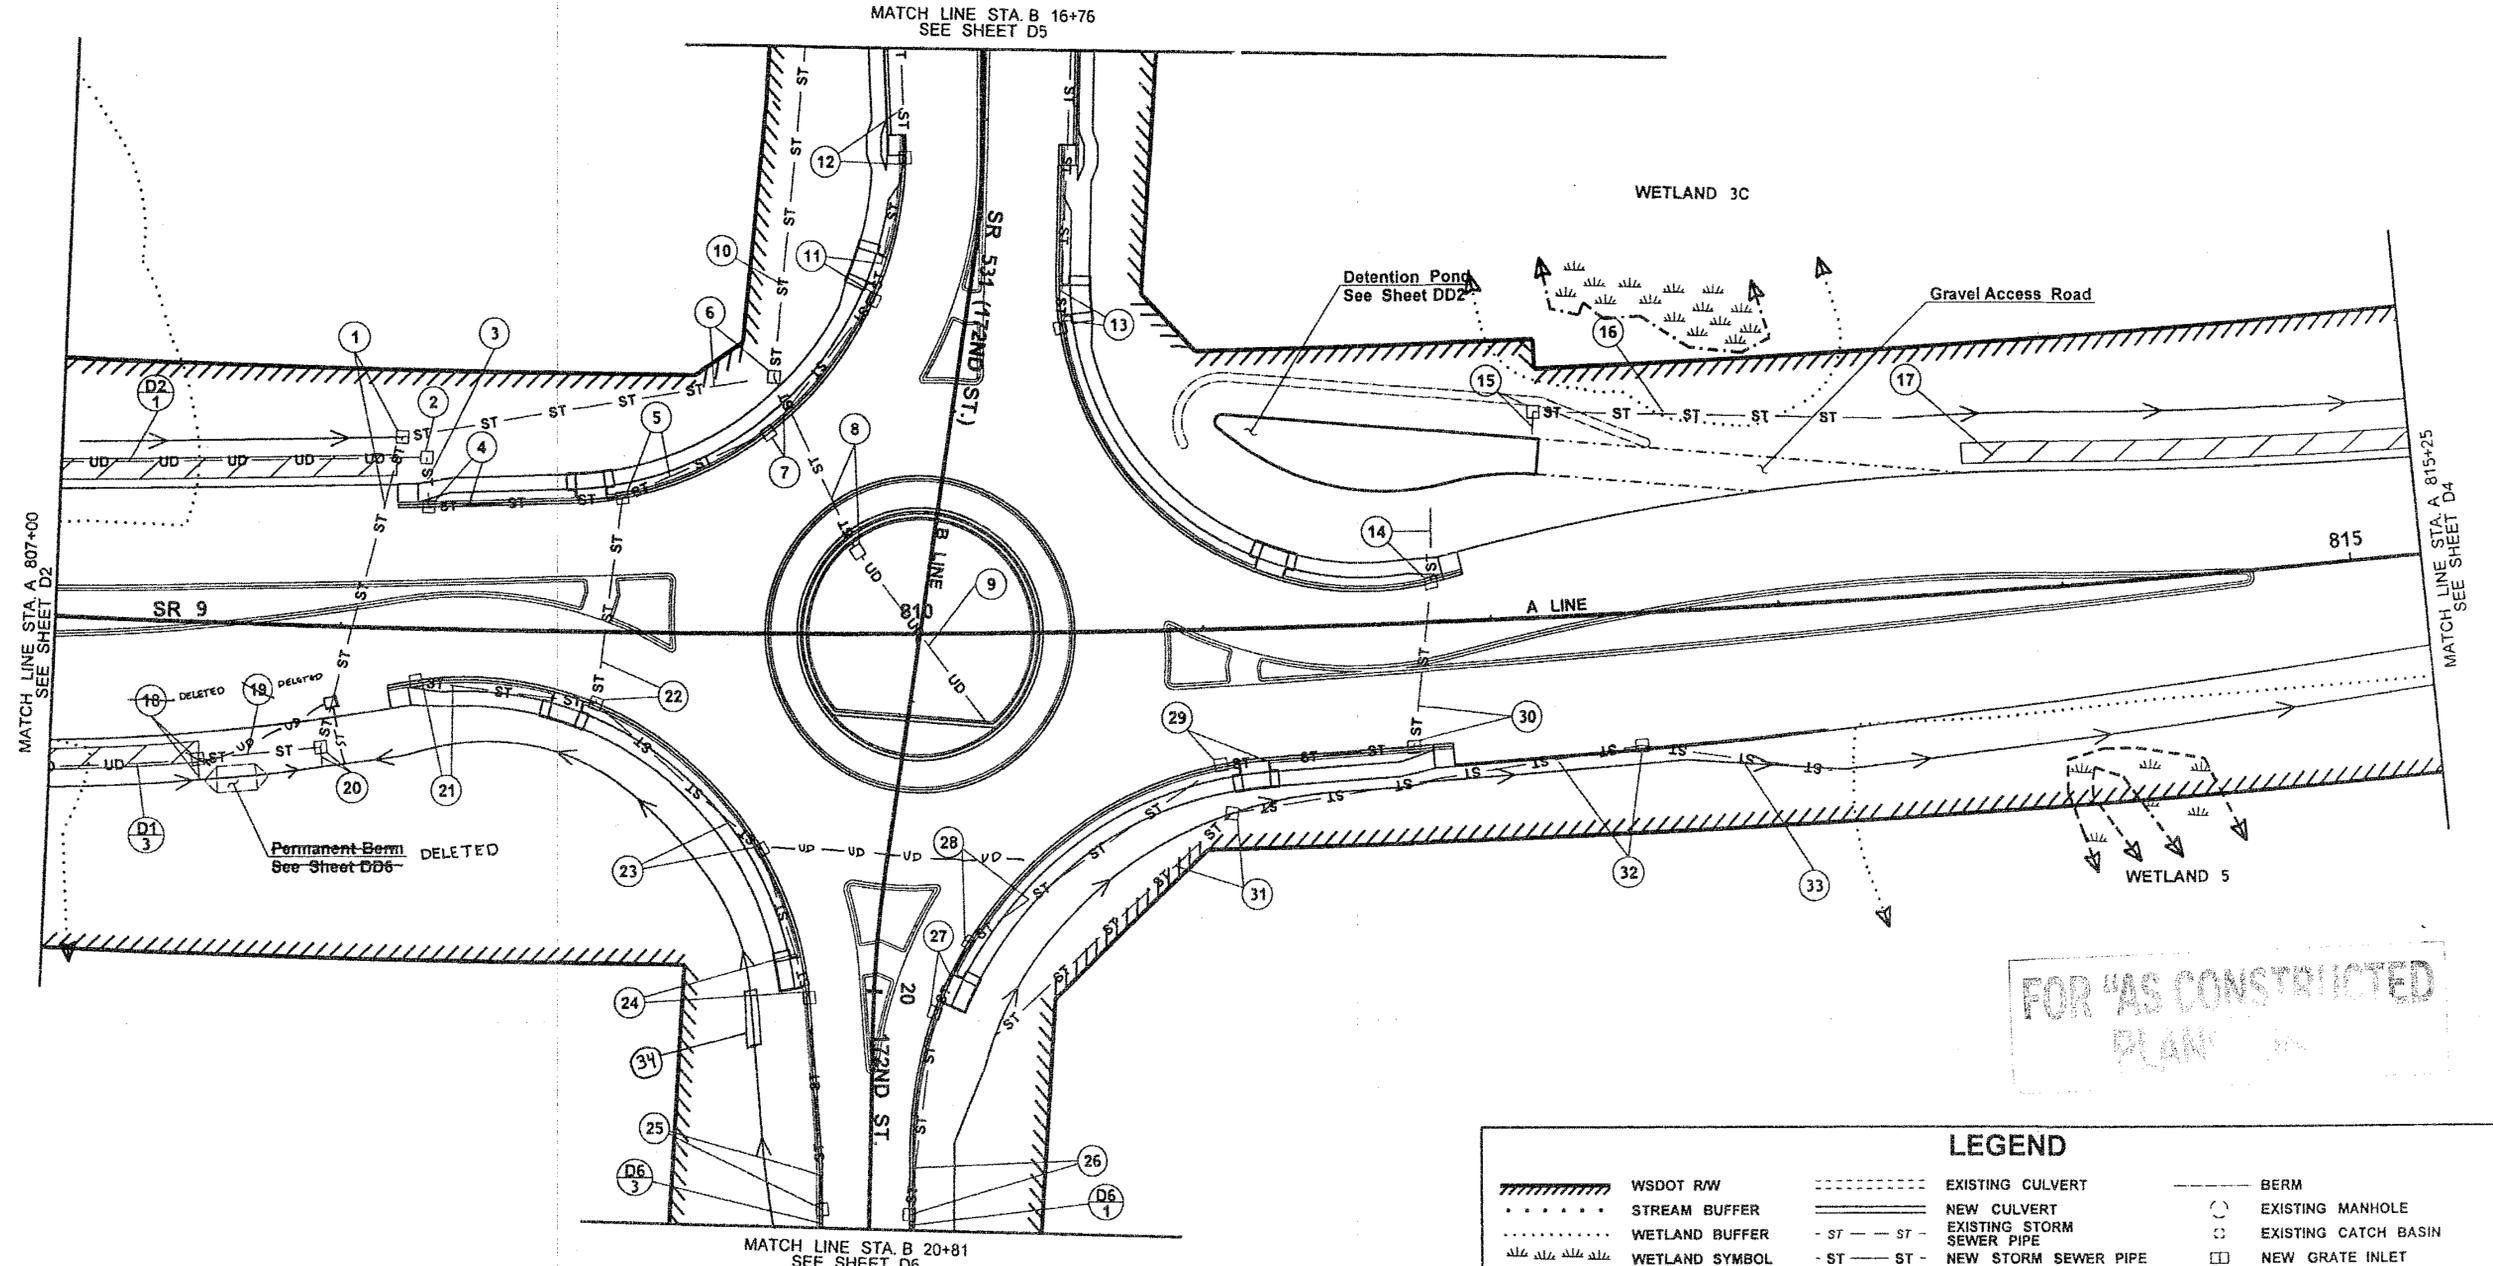

GENERAL NOTES:

- REFER TO DD1 FOR MEDIA FILTER DRAIN DETAILS.
- STORM SEWER PIPES SHALL BE CORRUGATED POLYPROPYLENE (PE). REFERENCE SECTION 1-07.7(2) FOR SHALLOW COVER STANDARDS.
- REFER TO DD2 - DD5 FOR DETENTION POND AND DETENTION VAULT DETAILS.

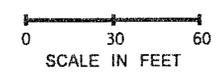


LEGEND			
	WSDOT RW		EXISTING CULVERT
	STREAM BUFFER		NEW CULVERT
	WETLAND BUFFER		EXISTING STORM SEWER PIPE
	WETLAND SYMBOL		NEW STORM SEWER PIPE
	WETLAND BOUNDARY		NEW UNDERDRAIN LINE
	ORDINARY HIGH WATER MARK		EXISTING DITCH
	NEW EDGE		NEW DITCH
	EXISTING EDGE		MEDIA FILTER DRAIN
	BERM		EXISTING MANHOLE
	EXISTING CATCH BASIN		NEW GRATE INLET
	NEW CATCH BASIN		DRAINAGE STRUCTURE NOTE
	DRAINAGE CONTINUATION NOTE		

FOR "AS CONSTRUCTED" PLAN

FILE NAME	I:\Projects\XL3325 SR9 SR531 172nd St NE Int\CAD\PS&ESheets\XL3325_PS_DRAINAGE.dgn			REGION NO.	STATE	FED.AID PROJ.NO.			SR 9 SR 531/172ND ST NE & EAGLEFIELD DR INTERSECTION IMPROVEMENT & PAVING DRAINAGE PLAN	Plot 3
TIME	3:51:10 PM			10	WASH					PLAN REF NO
DATE	9/29/2011			JOB NUMBER					SHEET	70
PLOTTED BY	gunnm			CONTRACT NO.					OF	230
DESIGNED BY	M. GUNN			LOCATION NO.					SHEETS	
ENTERED BY	K.SOLWOLD									
CHECKED BY	J. KORESKI									
PROJ. ENGR.	S.SPAHR									
REGIONAL ADM.	L. ENG			REVISION						
				DATE						
				BY						

T. 31N. R. 5E. W.M.

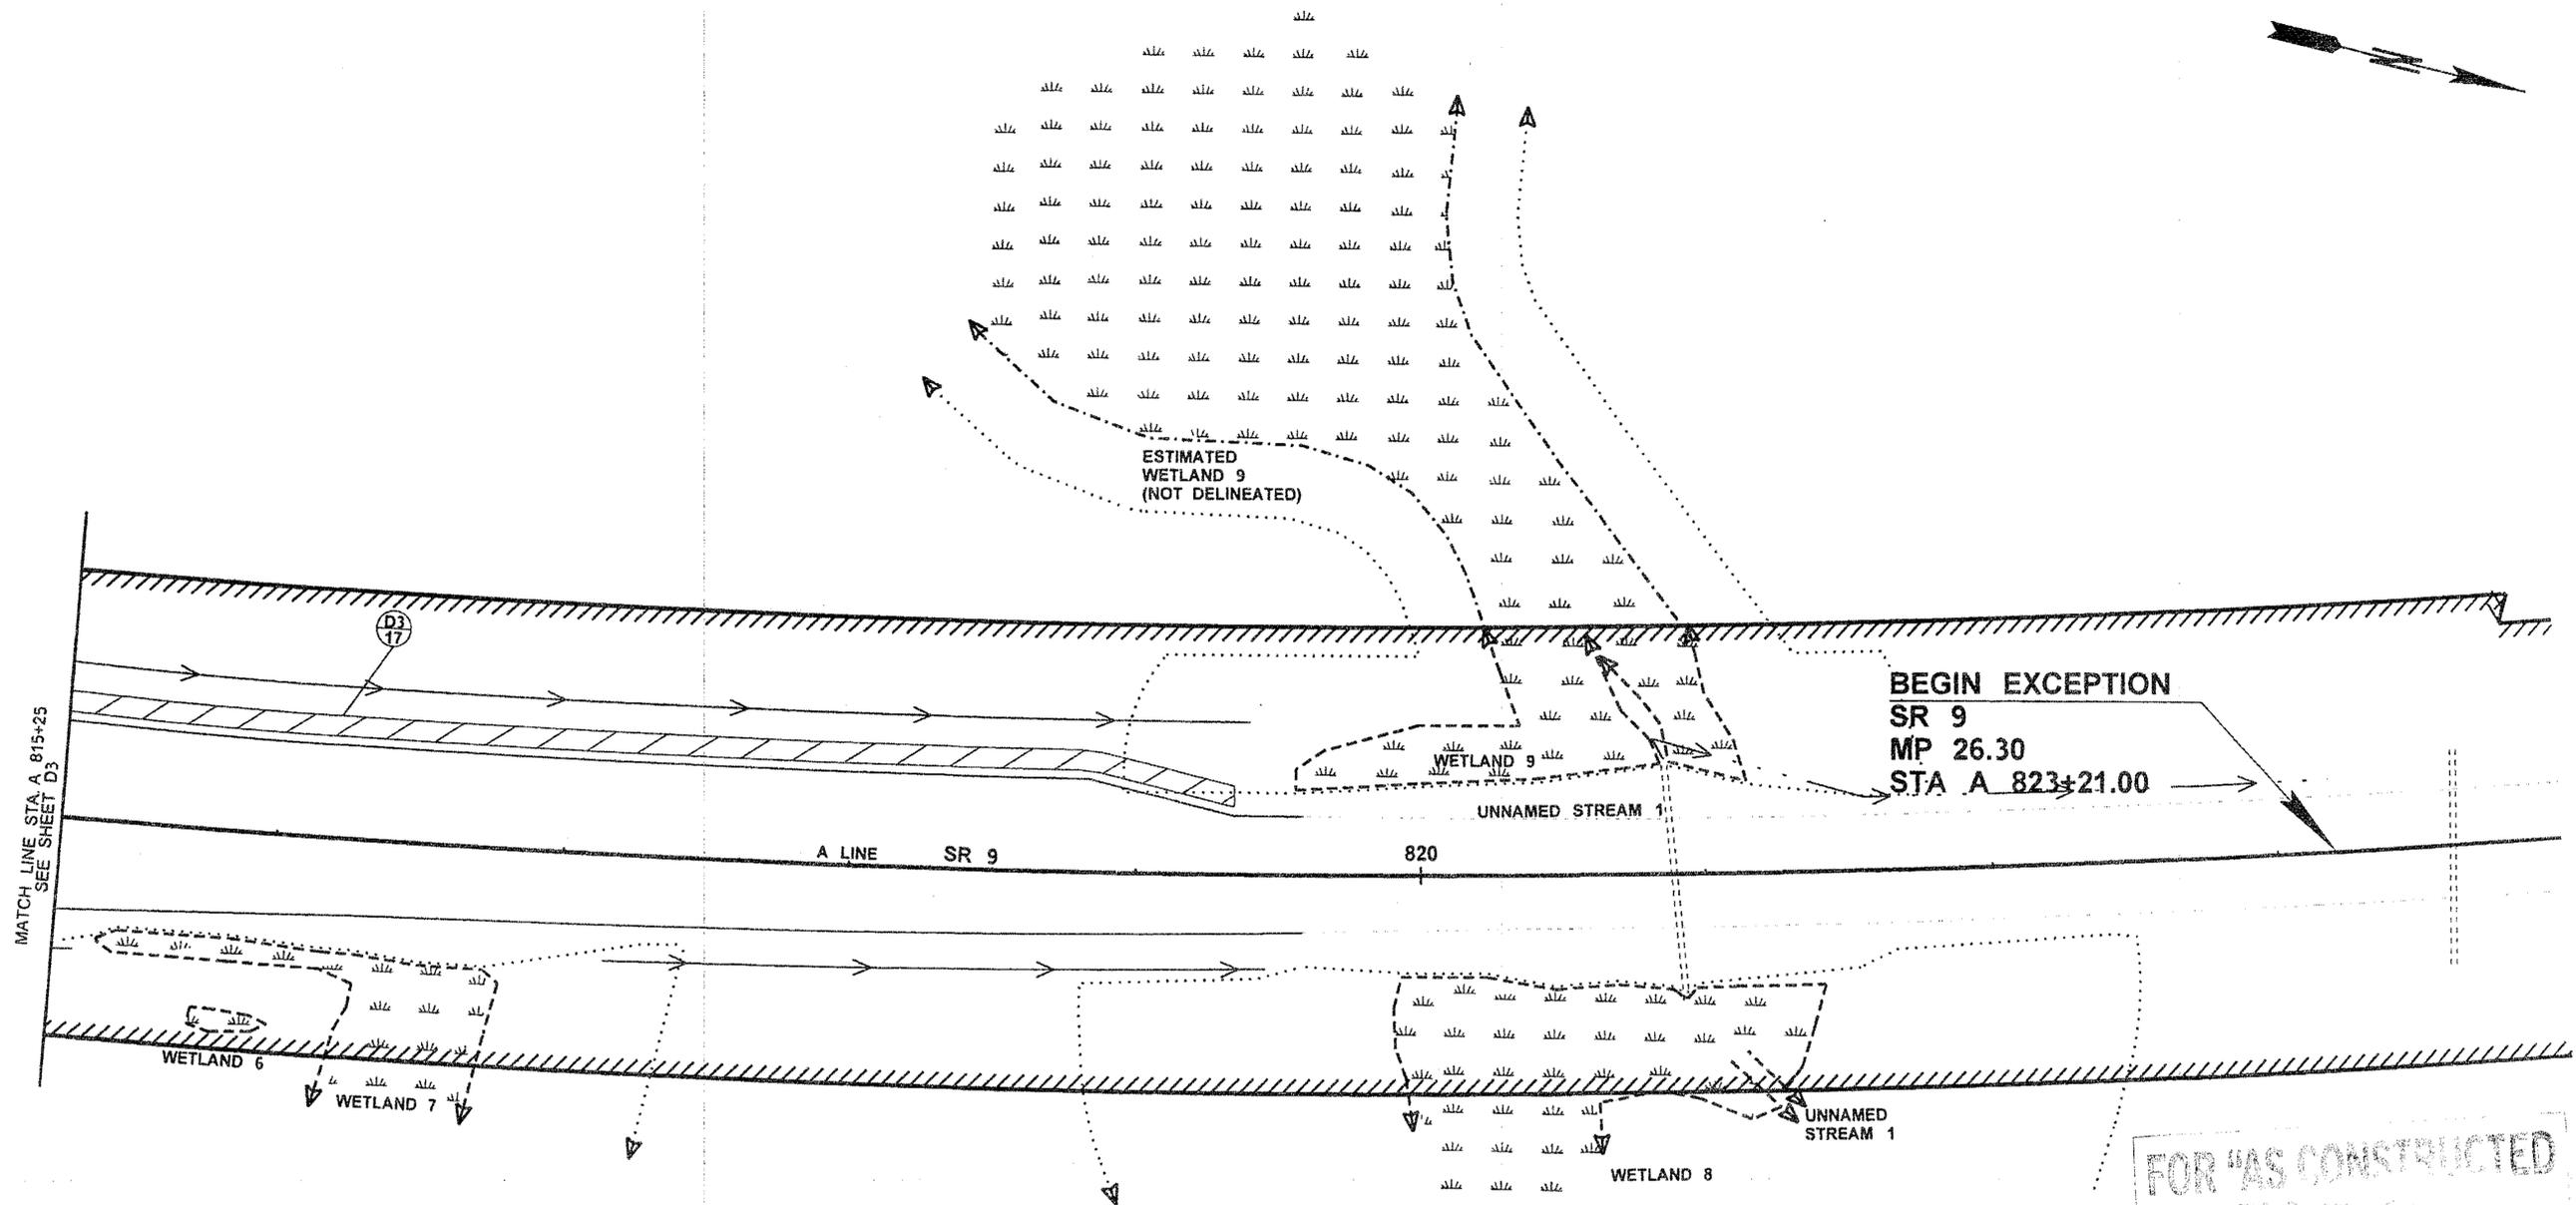


FOR 'AS CONSTRUCTED
PLANS ONLY

- GENERAL NOTES:**
- REFER TO DD1 FOR MEDIA FILTER DRAIN DETAILS.
 - STORM SEWER PIPES SHALL BE CORRUGATED POLYPROPYLENE (PE). REFERENCE SECTION 1-07.7(2) FOR SHALLOW COVER STANDARDS.
 - REFER TO DD2 - DD5 FOR DETENTION POND AND DETENTION VAULT DETAILS.



LEGEND					
	WSDOT RW		EXISTING CULVERT		BERM
	STREAM BUFFER		NEW CULVERT		EXISTING MANHOLE
	WETLAND BUFFER		EXISTING STORM SEWER PIPE		EXISTING CATCH BASIN
	WETLAND SYMBOL		NEW STORM SEWER PIPE		NEW GRATE INLET
	WETLAND BOUNDARY		NEW UNDERDRAIN LINE		NEW CATCH BASIN
	ORDINARY HIGH WATER MARK		EXISTING DITCH		DRAINAGE STRUCTURE NOTE
	NEW EDGE		NEW DITCH		DRAINAGE CONTINUATION NOTE
	EXISTING EDGE		MEDIA FILTER DRAIN		

FILE NAME	I:\Projects\XL3325_SR9_SR531_172nd St NE in\CAD\PS&ESheets\XL3325_PS_DRAINAGE.dgn			REGION NO.	STATE	FED.AID PROJ.NO.	DATE	PLOT 4
TIME	1:31:37 PM							
DATE	9/22/2011			10	WASH			PLAN REF NO
PLOTTED BY	gunnm			JOB NUMBER	10A042			D4
DESIGNED BY	M. GUNN			CONTRACT NO.		LOCATION NO.		SHEET
ENTERED BY	K.SOLWOLD							71
CHECKED BY	J. KORESKI							OF
PROJ. ENGR.	S.SPAHR							230
REGIONAL ADM.	L. ENG			REVISION		DATE	BY	SHEETS

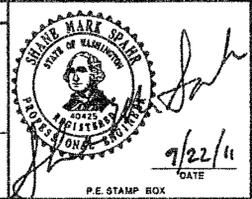


SR 9
SR 531/172ND ST NE & EAGLEFIELD DR
INTERSECTION IMPROVEMENT & PAVING
DRAINAGE PLAN

T. 31N. R. 5E. W.M.



BEGIN CONSTRUCTION
 SR 531
 MP 9.73
 STA B 10+53.80

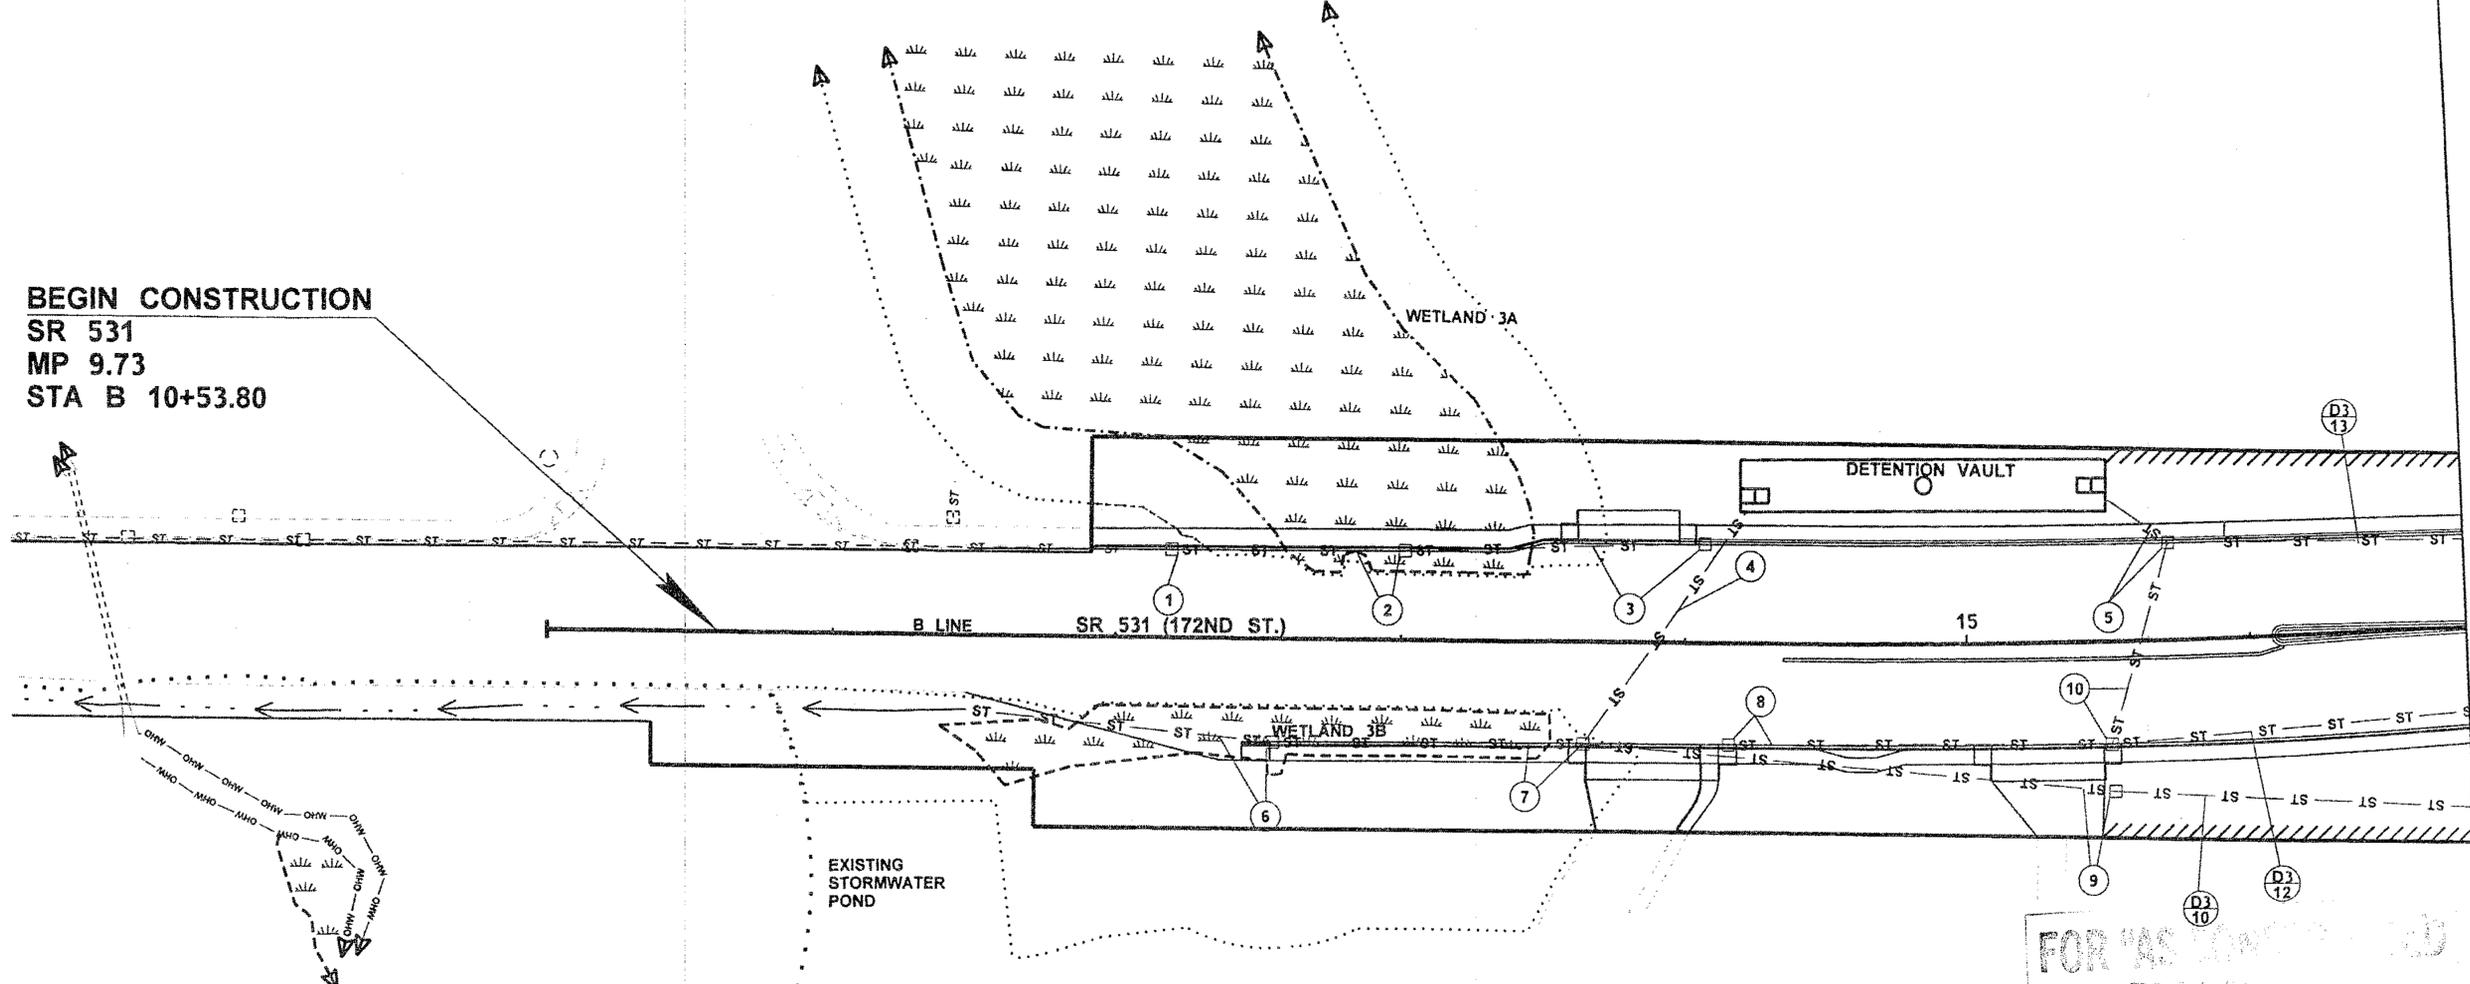


MATCH LINE STA. B 16+76
SEE SHEET D3

FOR 'AS SHOWN' PLANS ONLY

GENERAL NOTES:


- REFER TO DD1 FOR MEDIA FILTER DRAIN DETAILS.
- STORM SEWER PIPES SHALL BE CORRUGATED POLYPROPYLENE (PE). REFERENCE SECTION 1-07.7(2) FOR SHALLOW COVER STANDARDS.
- REFER TO DD2 - DD5 FOR DETENTION POND AND DETENTION VAULT DETAILS.

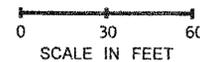

LEGEND			
	WSDOT RW		EXISTING CULVERT
	STREAM BUFFER		NEW CULVERT
	WETLAND BUFFER		EXISTING STORM SEWER PIPE
	WETLAND SYMBOL		NEW STORM SEWER PIPE
	WETLAND BOUNDARY		NEW UNDERDRAIN LINE
	ORDINARY HIGH WATER MARK		EXISTING DITCH
	NEW EDGE		NEW DITCH
	EXISTING EDGE		MEDIA FILTER DRAIN
	BERM		EXISTING MANHOLE
	EXISTING CATCH BASIN		NEW GRATE INLET
	NEW CATCH BASIN		DRAINAGE STRUCTURE NOTE
	DRAINAGE CONTINUATION NOTE		

FILE NAME: I:\Projects\XL3325 SR9 SR531 172nd St NE Int\CAD\PS&ESheets\XL3325 PS DRAINAGE.dgn		REGION NO. 10	STATE WASH	FED.AID PROJ.NO.			SR 9 SR 531/172ND ST NE & EAGLEFIELD DR INTERSECTION IMPROVEMENT & PAVING	DRAINAGE PLAN	Plot 5
TIME: 1:07:54 PM	DATE: 9/22/2011	CONTRACT NO. 10A042		PLAN REF NO. D5					
PLOTTED BY: gunnm	DESIGNED BY: M. GUNN	JOB NUMBER 10A042		LOCATION NO.	DATE: 9/22/11	SR 9		SHEET 72 OF 230 SHEETS	
ENTERED BY: K.SOLWOLD	CHECKED BY: J.KORESKE	CONTRACT NO. 10A042		LOCATION NO.	DATE: 9/22/11	SR 9		SHEET 72 OF 230 SHEETS	
PROJ. ENGR. S.SPAHR	REGIONAL ADM. L. ENG	REVISION	DATE	BY	DATE	SR 9		SHEET 72 OF 230 SHEETS	

T. 31N. R. 5E. W.M.

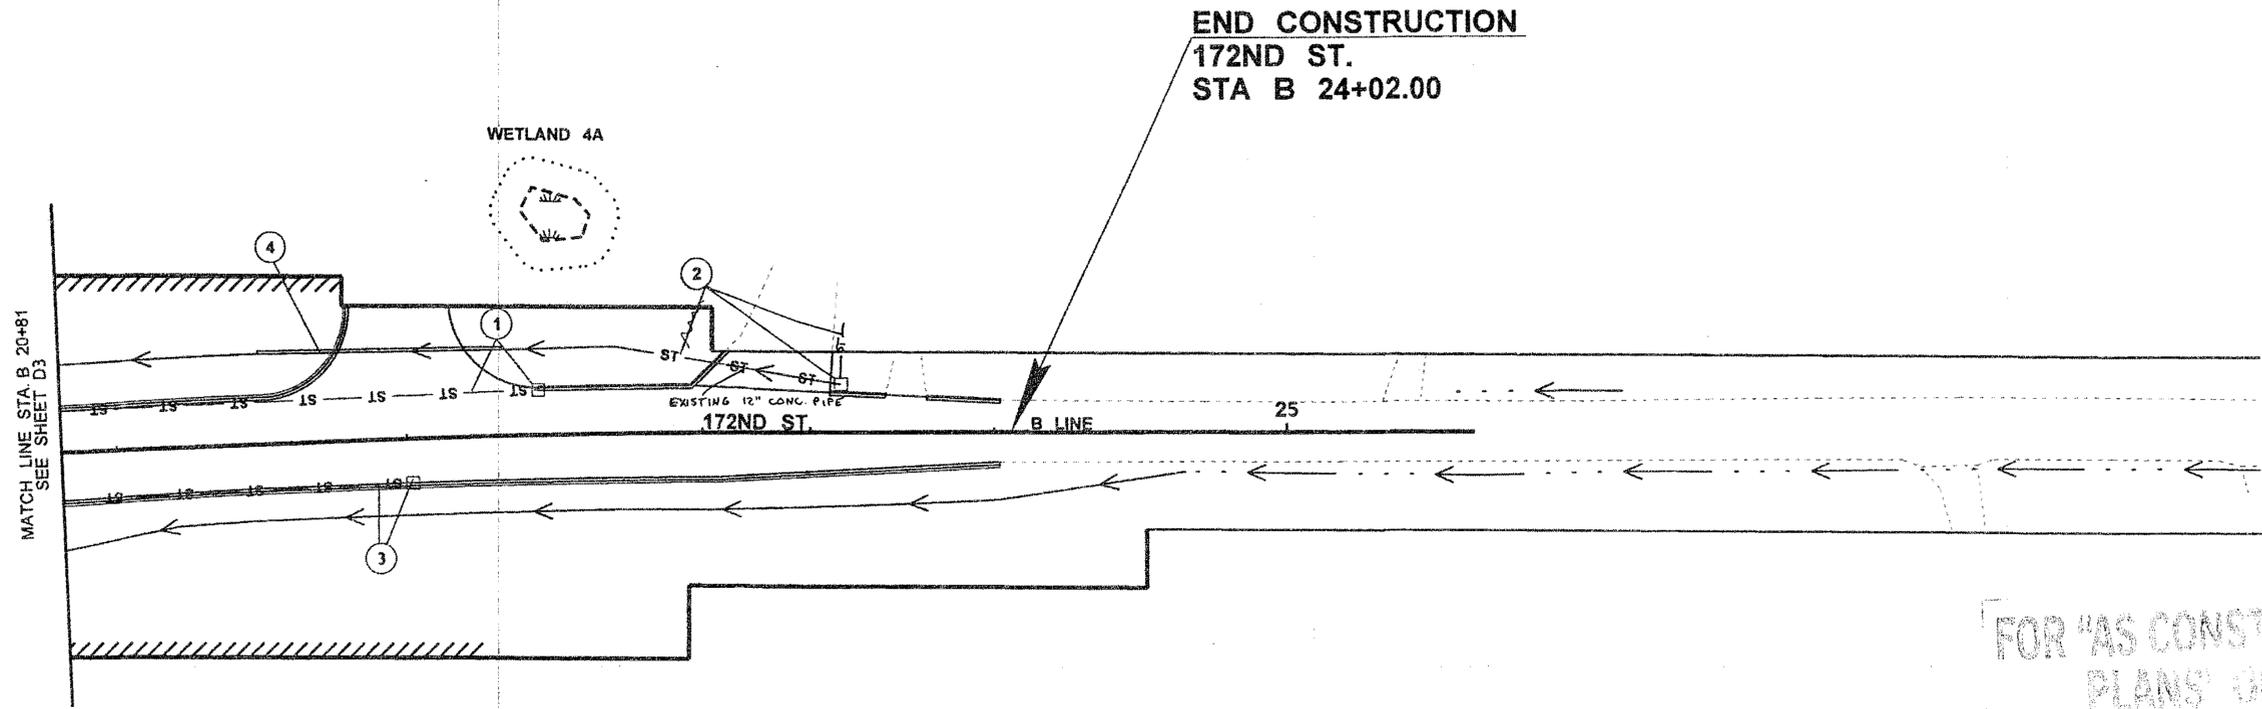


FOR 'AS CONSTRUCTED
PLANS' ONLY


GENERAL NOTES:

1. REFER TO DD1 FOR MEDIA FILTER DRAIN DETAILS.
2. STORM SEWER PIPES SHALL BE CORRUGATED POLYPROPYLENE (PE). REFERENCE SECTION 1-07.7(2) FOR SHALLOW COVER STANDARDS.
3. REFER TO DD2 - DD5 FOR DETENTION POND AND DETENTION VAULT DETAILS.

LEGEND					
	WSDOT RW		EXISTING CULVERT		BERM
	STREAM BUFFER		NEW CULVERT		EXISTING MANHOLE
	WETLAND BUFFER		EXISTING STORM SEWER PIPE		EXISTING CATCH BASIN
	WETLAND SYMBOL		NEW STORM SEWER PIPE		NEW GRATE INLET
	WETLAND BOUNDARY		NEW UNDERDRAIN LINE		NEW CATCH BASIN
	ORDINARY HIGH WATER MARK		EXISTING DITCH		DRAINAGE STRUCTURE NOTE
	NEW EDGE		NEW DITCH		DRAINAGE CONTINUATION NOTE
	EXISTING EDGE		MEDIA FILTER DRAIN		

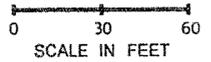

FILE NAME I:\Projects\XL3325 SR9 SR531 172nd St NE Int\CAD\PS&ESheets\XL3325 PS DRAINAGE.dgn				REGION NO. 10	STATE WASH	FED.AID PROJ.NO.			SR 9 SR 531/172ND ST NE & EAGLEFIELD DR INTERSECTION IMPROVEMENT & PAVING DRAINAGE PLAN	Plot 6	
TIME 9:05:17 AM	DATE 9/20/2011	PLOTTED BY solwolk	DESIGNED BY M.GUNN	ENTERED BY K.SOLWOLD	CHECKED BY J.KORESKI	PROJ. ENGR. S.SPAHR				REGIONAL ADM. L.ENG	REVISION
										SHEET 73 OF 230 SHEETS	

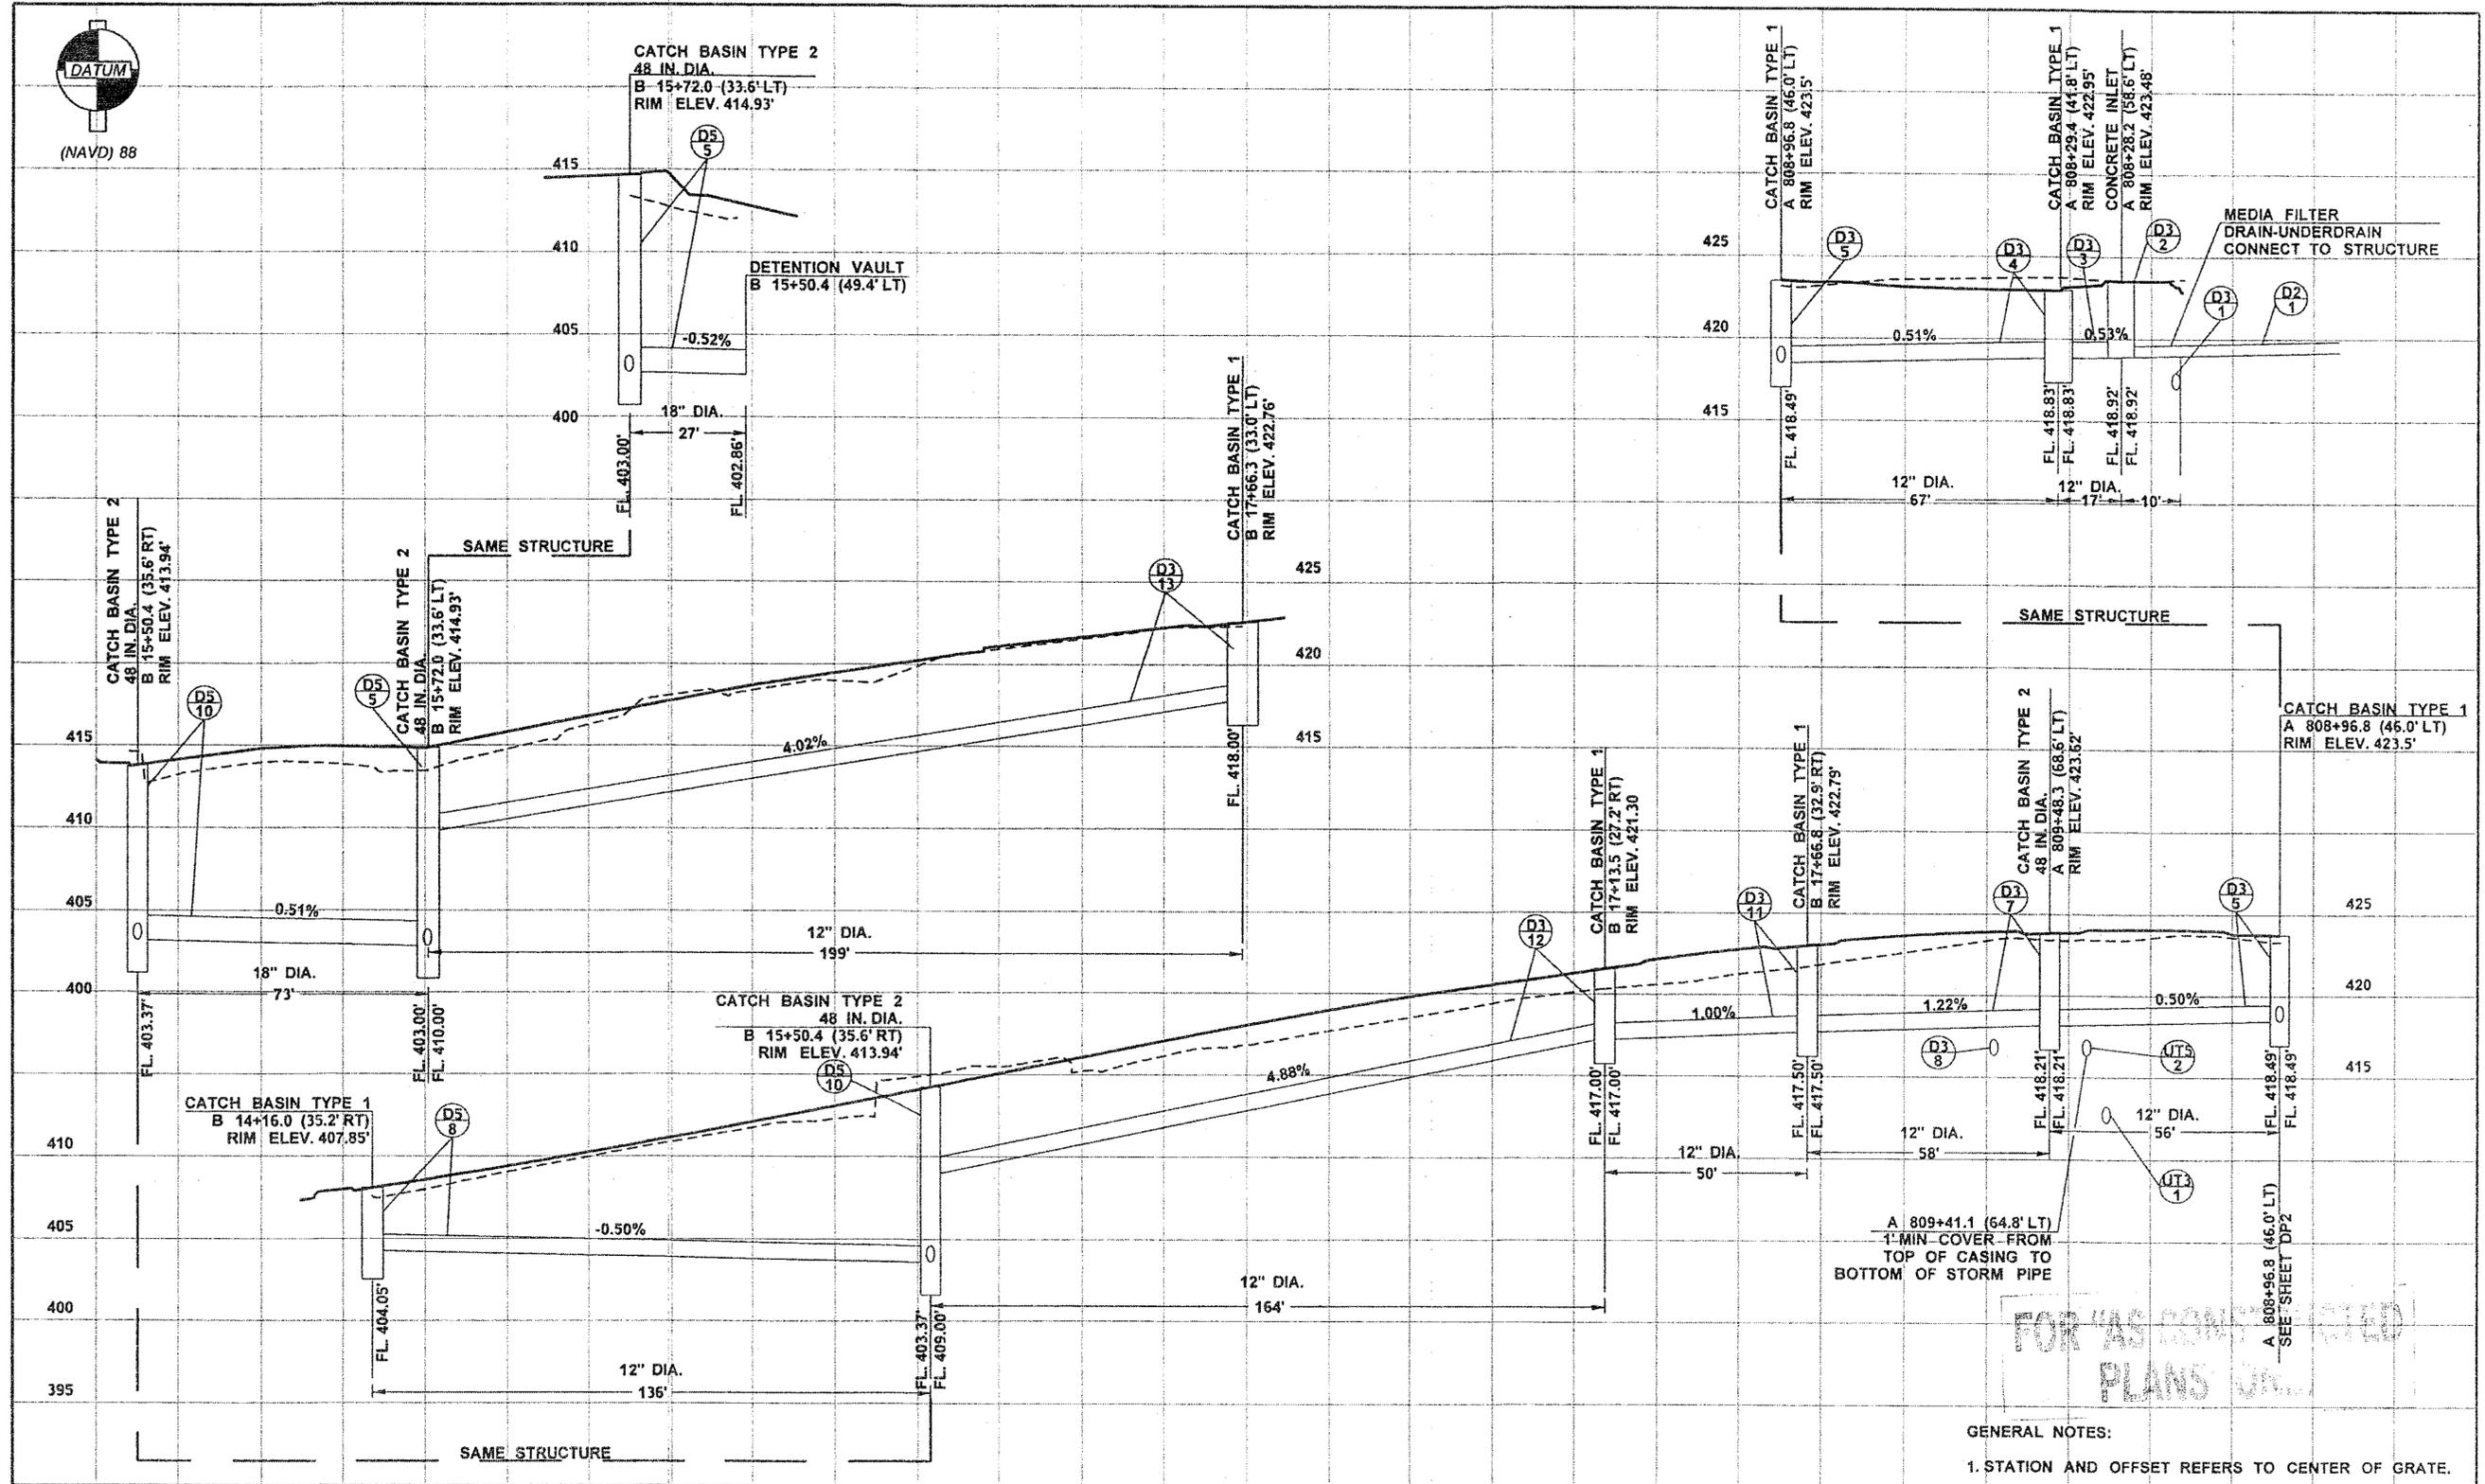

GENERAL NOTES:
 1. STATION AND OFFSET REFERS TO CENTER OF GRATE.

FOR 'AS CONSTRUCTED'
 PLANS ONLY

FILE NAME	I:\Projects\XL3325_SR9_SR531_172nd St NE Int\CAD\PS&ESheets\XL3325_PS DRAINAGE PROFILES.dgn		
TIME	8:57:35 AM		
DATE	9/20/2011		
PLOTTED BY	solwolk		
DESIGNED BY	M. GUNN		
ENTERED BY	K. SOLWOLD		
CHECKED BY	J. KORESKI		
PROJ. ENGR.	S. SPAHR		
REGIONAL ADM.	L. ENG		
REVISION	DATE	BY	

REGION NO.	STATE	FED.AID PROJ.NO.
10	WASH	
JOB NUMBER	10A042	
CONTRACT NO.	LOCATION NO.	



Washington State
 Department of Transportation

SR 9	Plot 1
SR 531/172ND ST NE & EAGLEFIELD DR	PLAN REF. NO.
INTERSECTION IMPROVEMENT & PAVING	DP1
DRAINAGE PROFILE	SHEET 74 OF 230 SHEETS



(NAVD) 88
 CATCH BASIN TYPE 1
 A 808+96.8 (46.0' LT)
 RIM ELEV. 423.5'
 FL. 418.49'
 FL. 418.49'
 A 808+96.8 (46.0' LT)
 SEE SHEET D01

CATCH BASIN TYPE 1
 A 808+88.2 (24.3' RT)
 RIM ELEV. 423.53'
 FL. 419.68'
 FL. 419.68'

CATCH BASIN TYPE 1
 A 809+45.9 (73.6' RT)
 RIM ELEV. 425.24'
 FL. 421.09'
 FL. 421.09'

CATCH BASIN TYPE 1
 B 20+03.3 (22.6' RT)
 RIM ELEV. 425.75'
 FL. 422.95'
 FL. 422.95'

CATCH BASIN TYPE 1
 B 20+74.7 (16.5' RT)
 RIM ELEV. 428.77'
 FL. 425.50'
 FL. 425.50'

CATCH BASIN TYPE 1
 B 22+01.4 (15.1' RT)
 RIM ELEV. 437.18'

CATCH BASIN TYPE 1
 A 808+88.2 (24.3' RT)
 RIM ELEV. 423.53'


CATCH BASIN TYPE 1
 A 808+26.0 (17.8' RT)
 RIM ELEV. 422.90'

CATCH BASIN TYPE 1
 B 14+06.8 (34.1' LT)
 RIM ELEV. 407.40'

CATCH BASIN TYPE 1
 B 13+01.2 (30.7' LT)
 RIM ELEV. 403.77'

CATCH BASIN TYPE 1
 B 12+19.8 (30.3' LT)
 RIM ELEV. 400.88'

CONNECTION TO
 DRAINAGE STRUCTURE
 B 12+00.8 (30.3' LT)

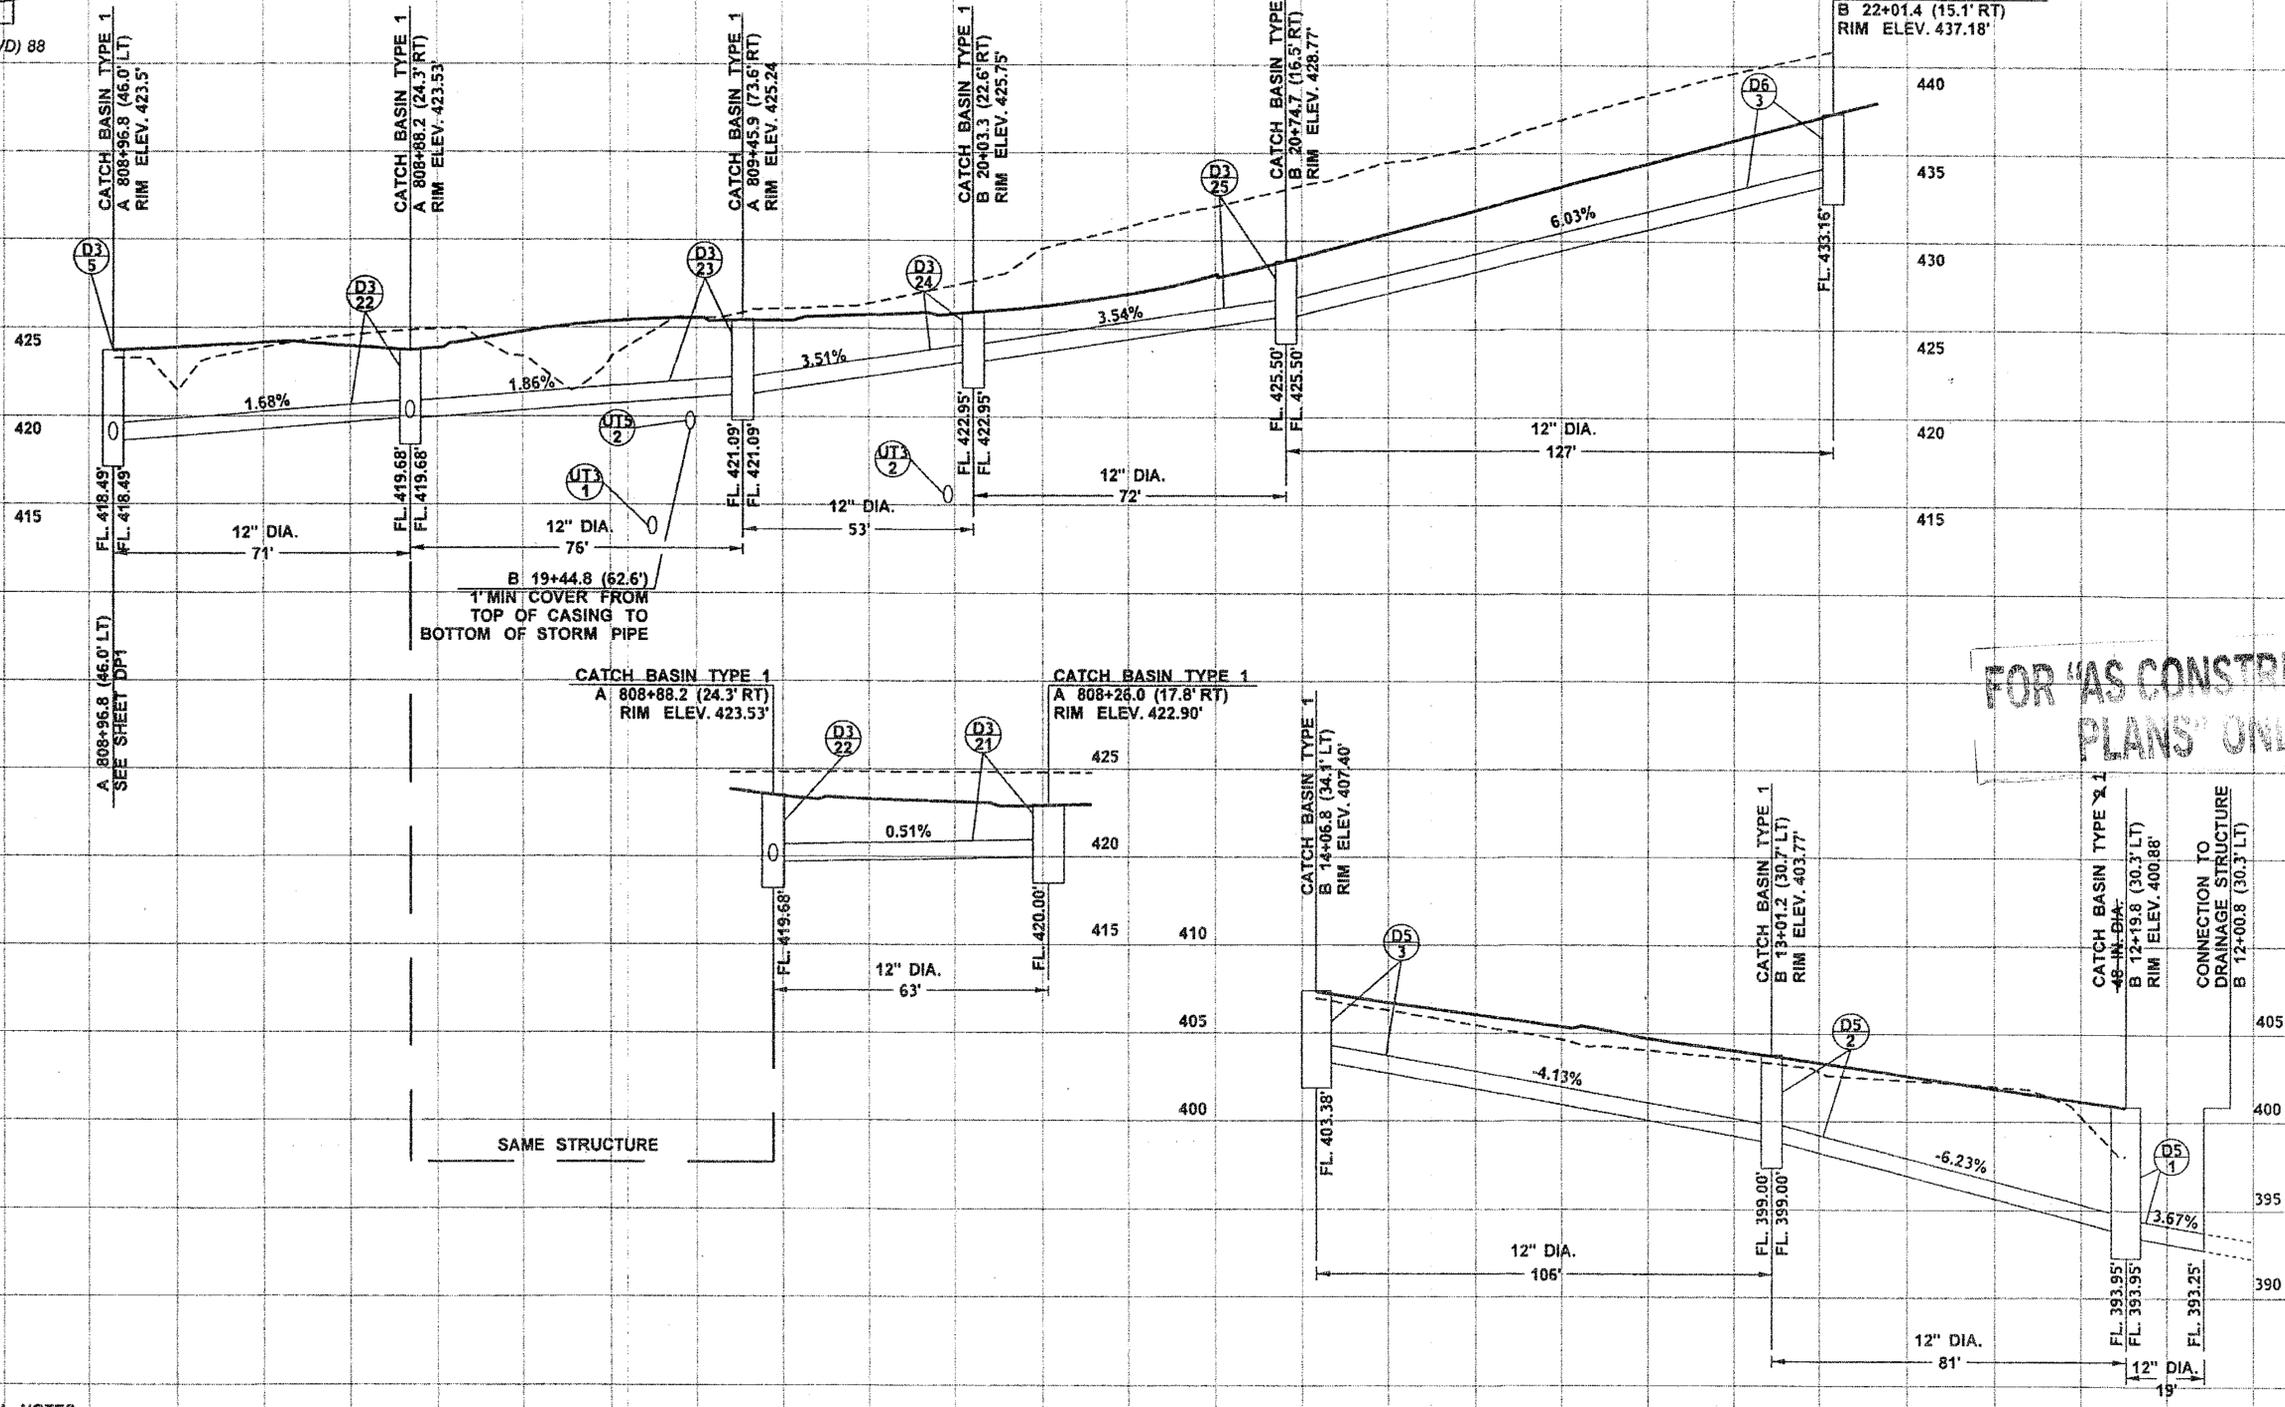

FOR "AS CONSTRUCTED
 PLANS" ONLY

B 19+44.8 (62.6')
 1' MIN COVER FROM
 TOP OF CASING TO
 BOTTOM OF STORM PIPE


SAME STRUCTURE

GENERAL NOTES:
 1. STATION AND OFFSET REFERS TO CENTER OF GRATE.

FILE NAME: I:\Projects\1325_SR9_SR531_172nd St NE In\CAD\PS&ESheets\1325_PS DRAINAGE_PROFILES.dgn		REGION NO. 10	STATE WASH	FED.AID PROJ.NO.			SR 9 SR 531/172ND ST NE & EAGLEFIELD DR INTERSECTION IMPROVEMENT & PAVING DRAINAGE PROFILE	Plot 2	
TIME: 8:57:36 AM	DATE: 9/20/2011	JOB NUMBER: 10A042	CONTRACT NO.	LOCATION NO.				DATE: 9/22/11	PLAN REF. NO. DP2
PLOTTED BY: solwolk	DESIGNED BY: M. GUNN	ENTERED BY: K. SOLWOLD	CHECKED BY: J. KORESKI	PROJ. ENGR: S. SPAHR	REGIONAL ADM: L. ENG	REVISION	DATE	BY	SHEET 75 OF 230 SHEETS



(NAVD) 88

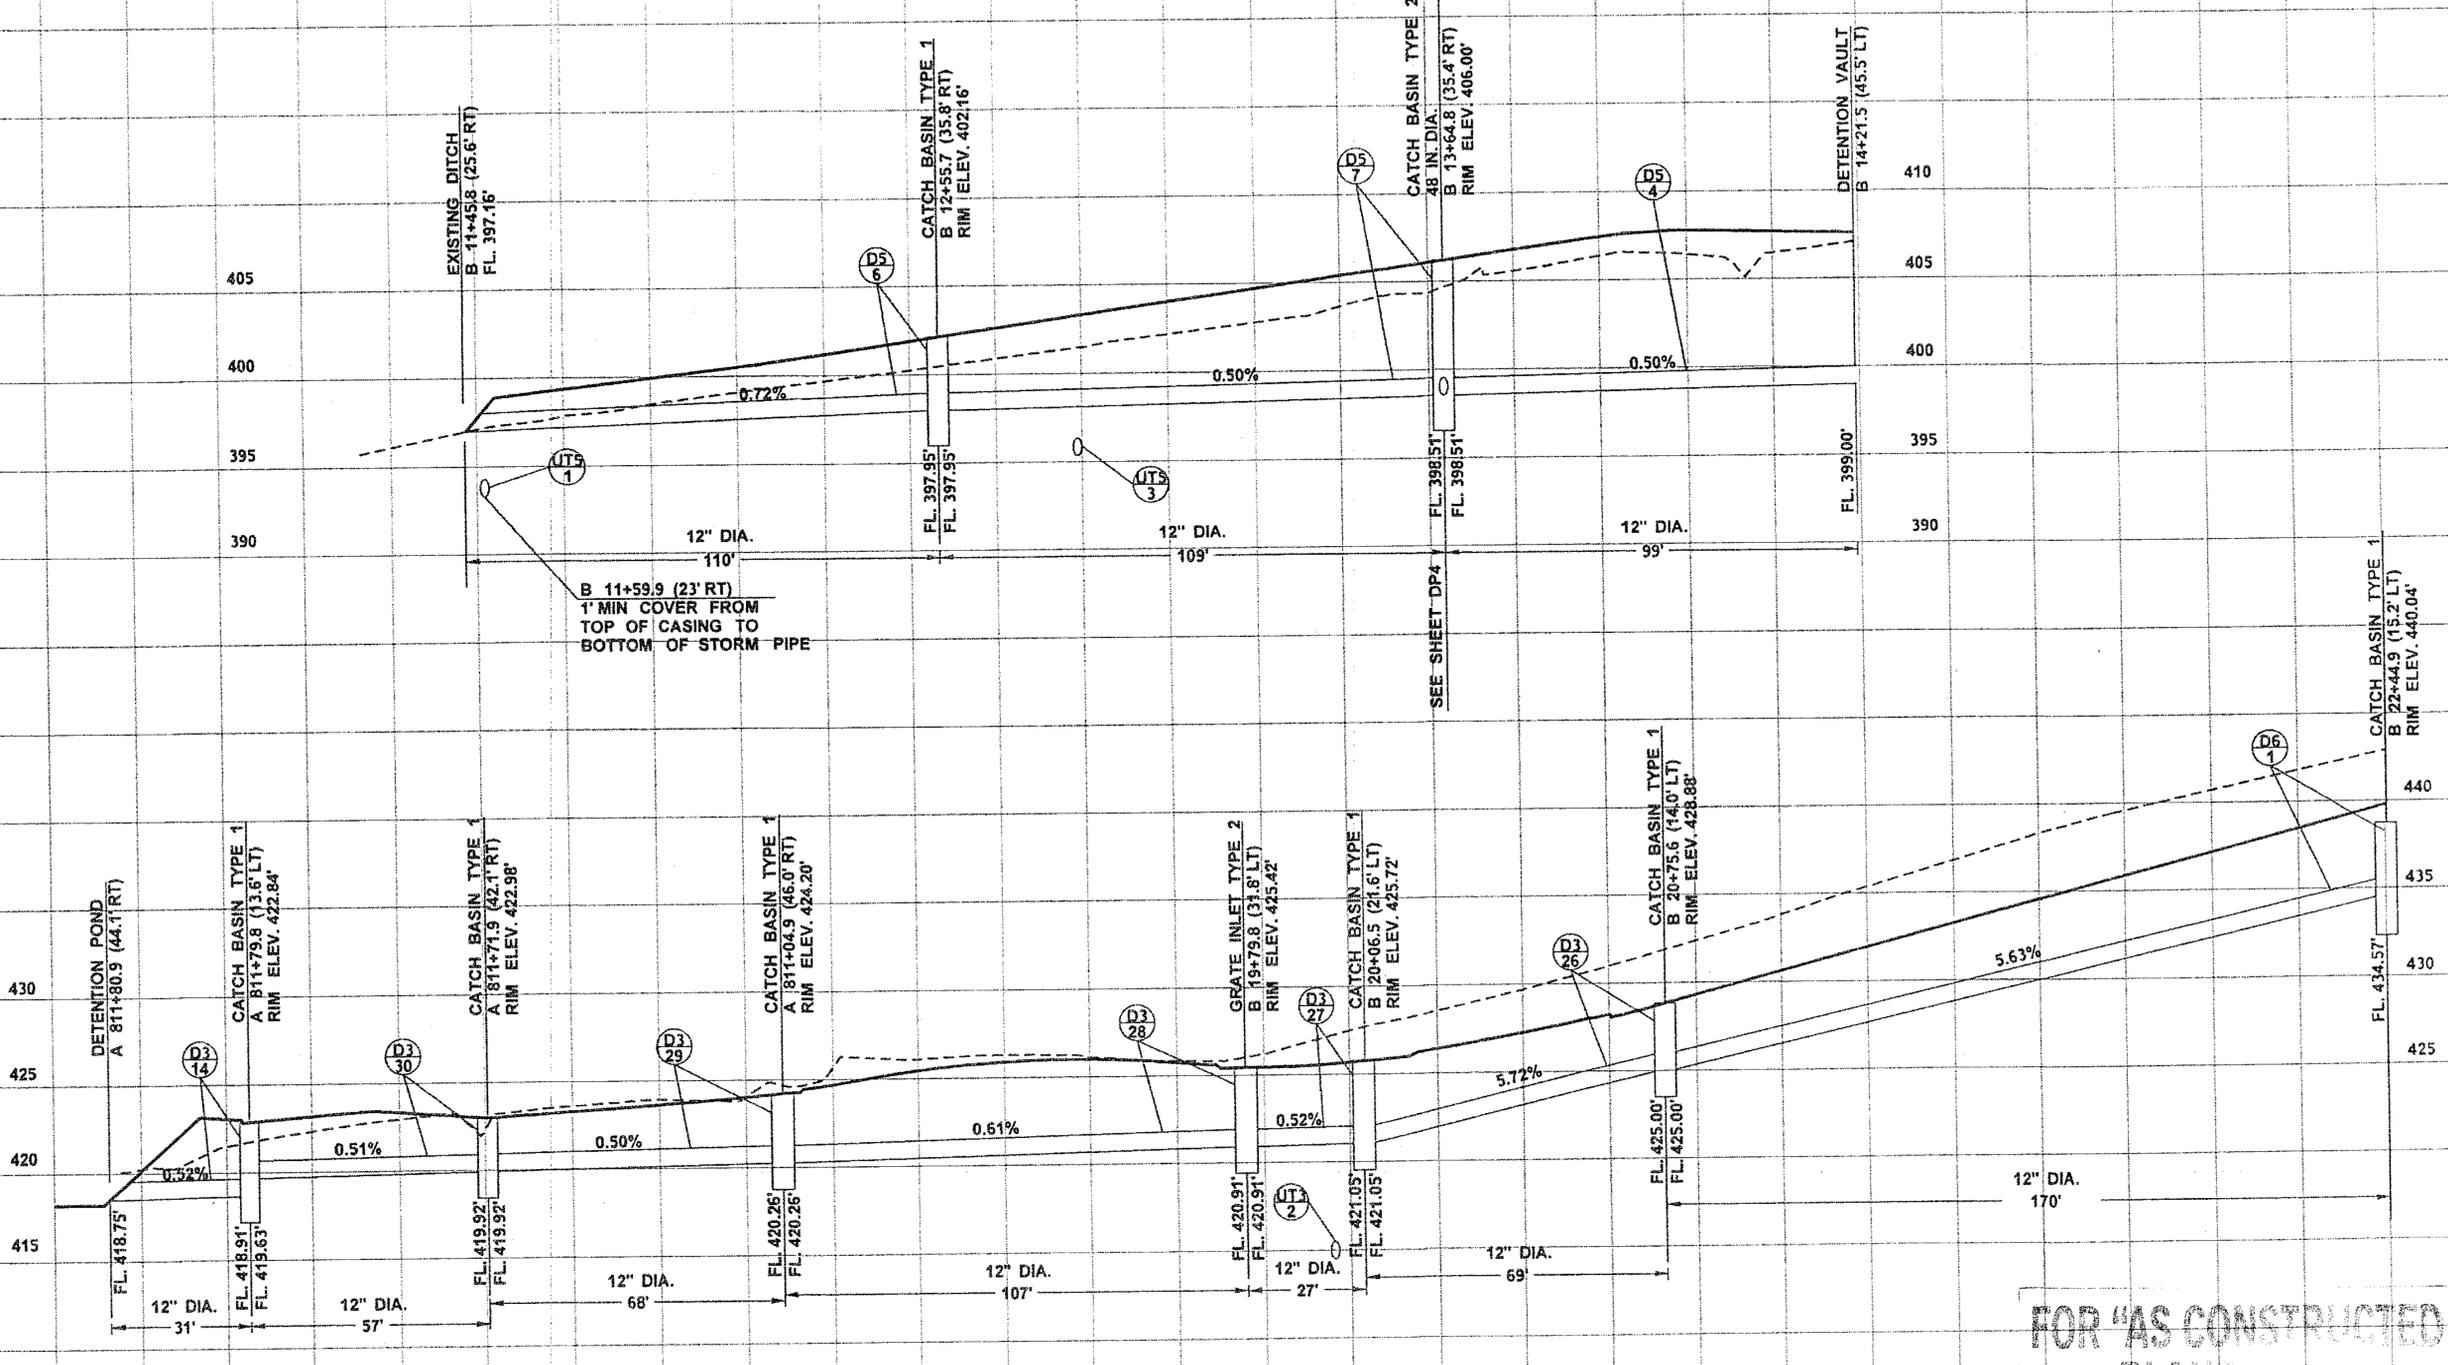

FOR "AS CONSTRUCTED
PLANS" ONLY

GENERAL NOTES:
1. STATION AND OFFSET REFERS TO CENTER OF GRATE.

FILE NAME	I:\Projects\XL3325 SR9 SR531 172nd St NE Int\CAD\PS&ESheets\XL3325_PS_DRAINAGE_PROFILES.dgn		
TIME	8:57:38 AM		
DATE	9/20/2011		
PLOTTED BY	solwolk		
DESIGNED BY	M. GUNN		
ENTERED BY	K.SOLWOLD		
CHECKED BY	J. KORESKI		
PROJ. ENGR.	S. SPAHR		
REGIONAL ADM.	L. ENG		
REVISION	DATE	BY	

REGION NO.	STATE	FED.AID PROJ.NO.
10	WASH	
JOB NUMBER	CONTRACT NO.	LOCATION NO.
10A042		

P.E. STAMP BOX


Washington State
 Department of Transportation

SR 9
 SR 531/172ND ST NE & EAGLEFIELD DR
 INTERSECTION IMPROVEMENT & PAVING
 DRAINAGE PROFILE

Plot 3
 PLAN REF. NO.
 DP3
 SHEET
 76
 OF
 230
 SHEETS



(NAVD) 88 450

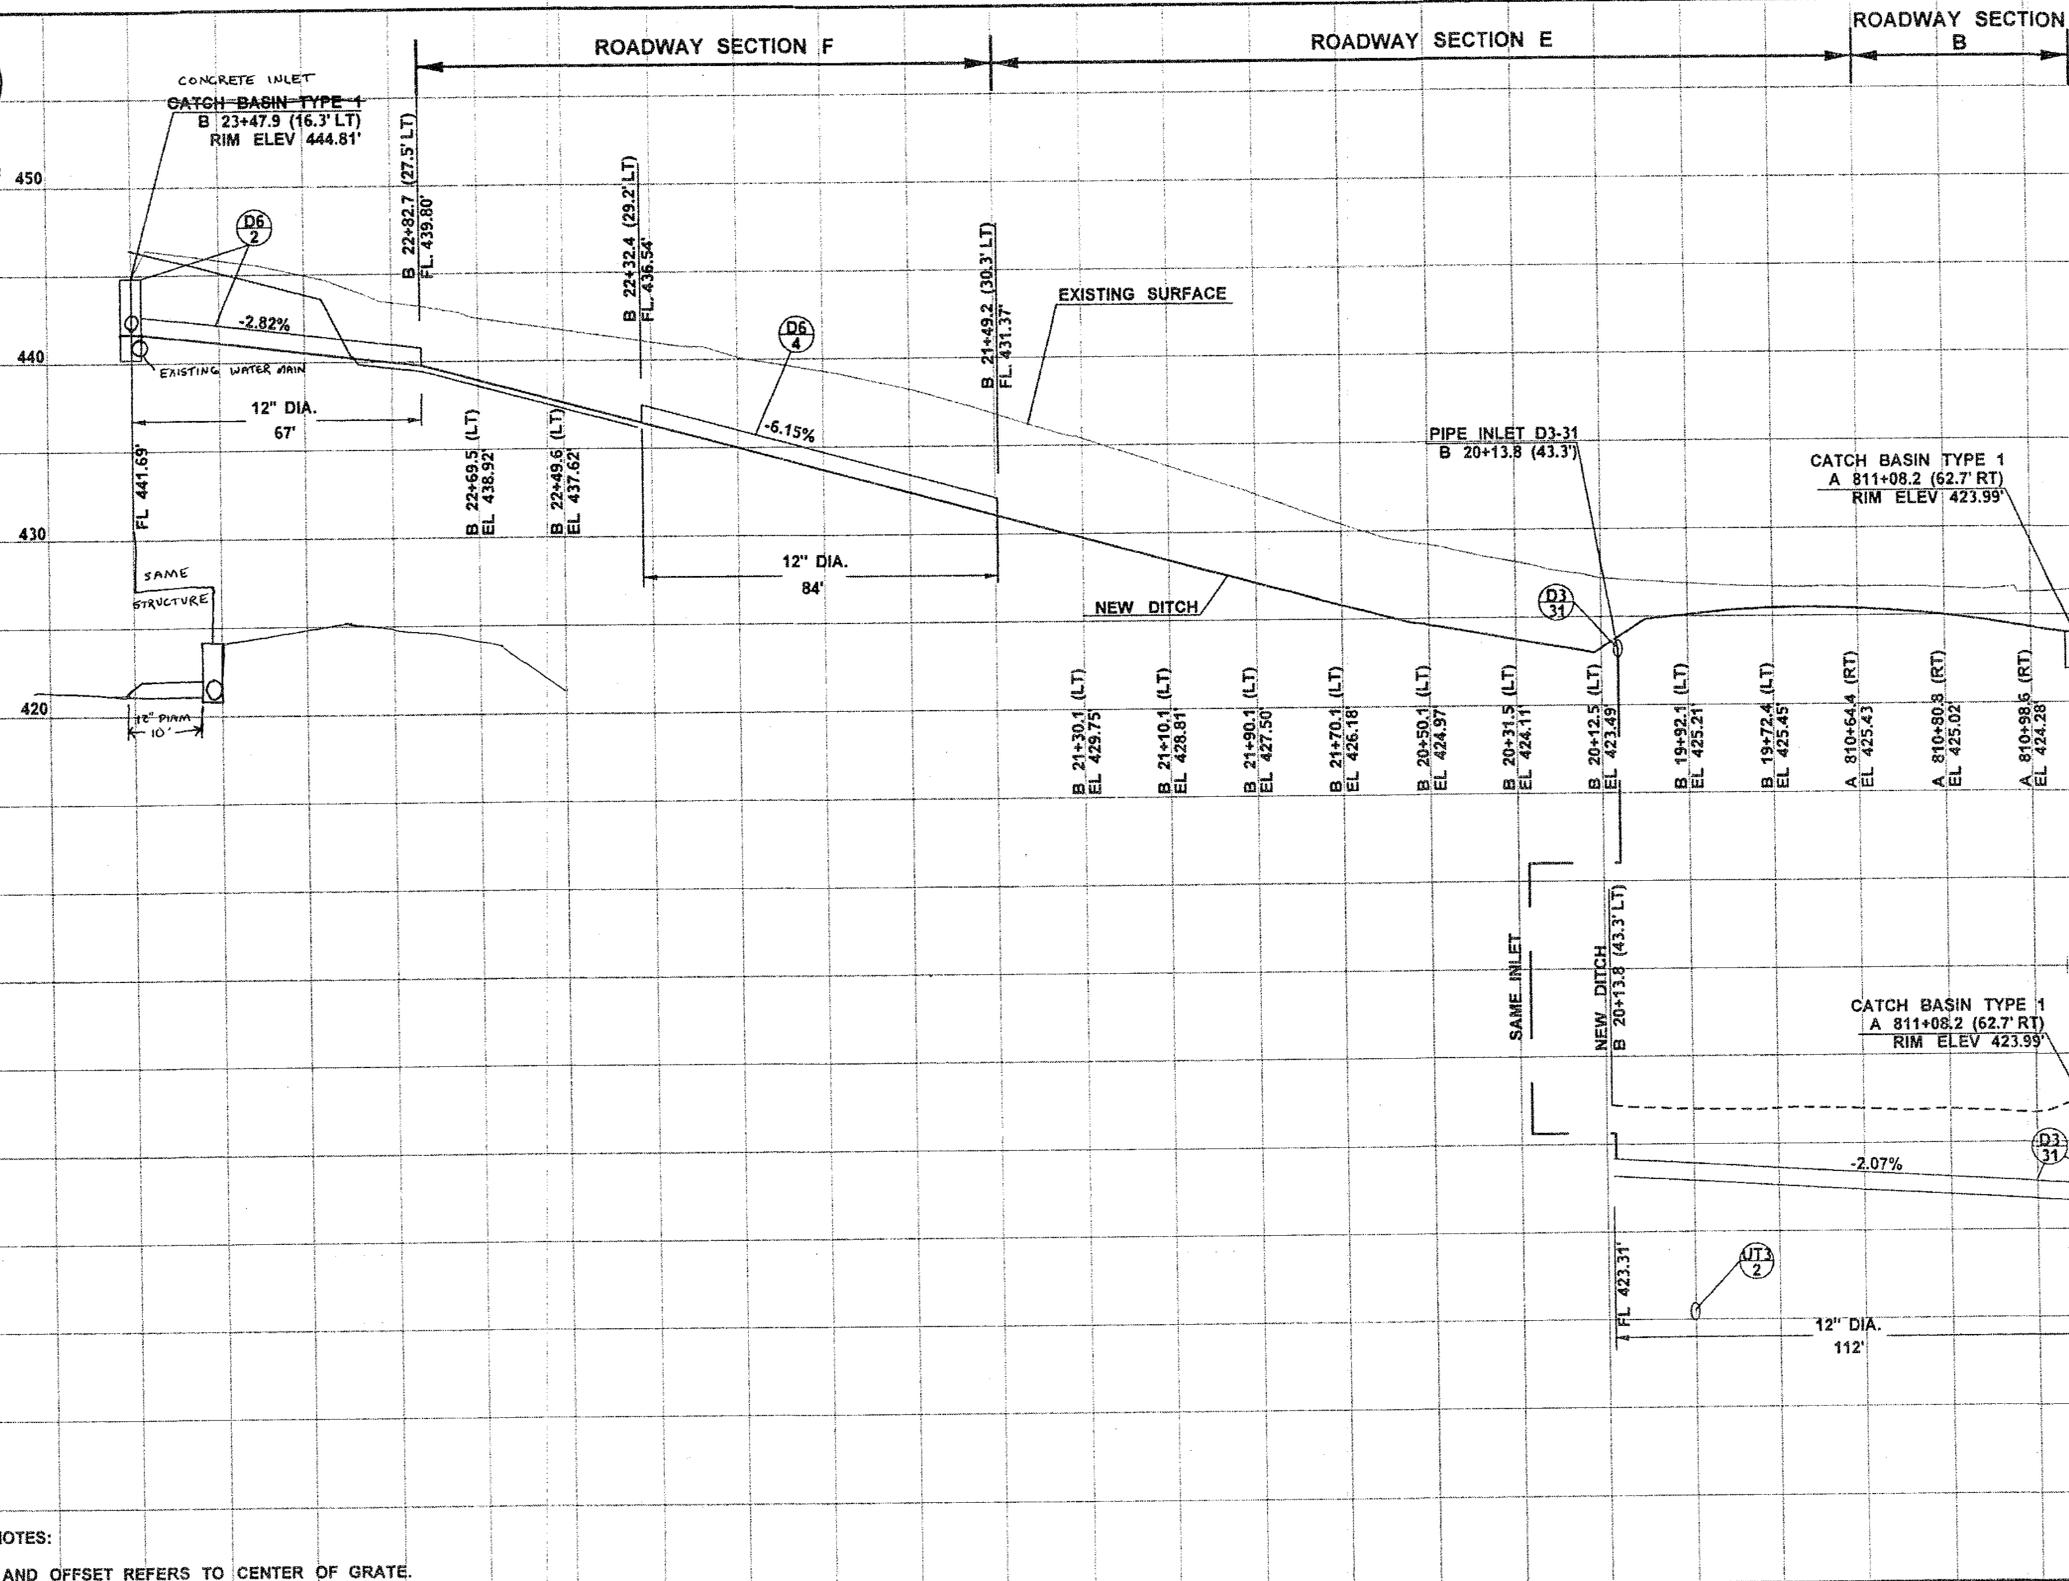


FOR "AS CONSTRUCTED" PLANS ONLY

GENERAL NOTES:
 1. STATION AND OFFSET REFERS TO CENTER OF GRATE.

FILE NAME	I:\Projects\XL3325_SR9 SR531 172nd St NE Int\CAD\PS&ESheets\XL3325_PS_DRAINAGE_PROFILES.dgn		
TIME	8:57:40 AM		
DATE	9/20/2011		
PLOTTED BY	solwolk		
DESIGNED BY	M. GUNN		
ENTERED BY	K. SOLWOLD		
CHECKED BY	J. KORESKE		
PROJ. ENGR.	S. SPAHR		
REGIONAL ADM.	L. ENG		
REVISION	DATE	BY	

REGION NO.	STATE	FED.AID PROJ.NO.
10	WASH	
JOB NUMBER	10A042	
CONTRACT NO.	LOCATION NO.	

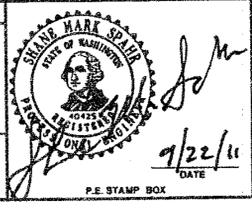



SR 9
 SR 531/172ND ST NE & EAGLEFIELD DR
 INTERSECTION IMPROVEMENT & PAVING
 DRAINAGE PROFILE

Plot 5
 PLAN REF. NO.
 DP5
 SHEET
 78
 OF
 230
 SHEETS



(NAVD) 88

ROADWAY SECTION B ROADWAY SECTION A

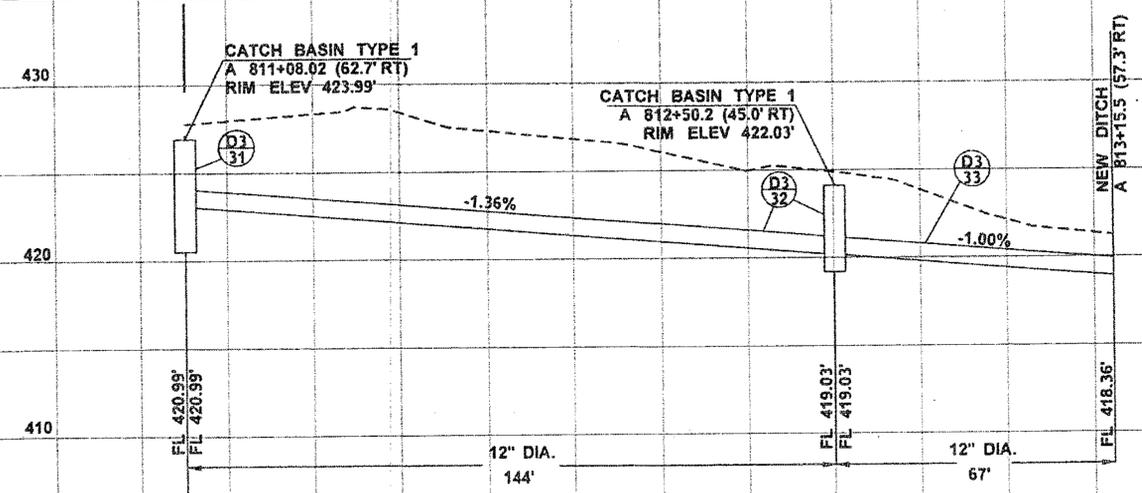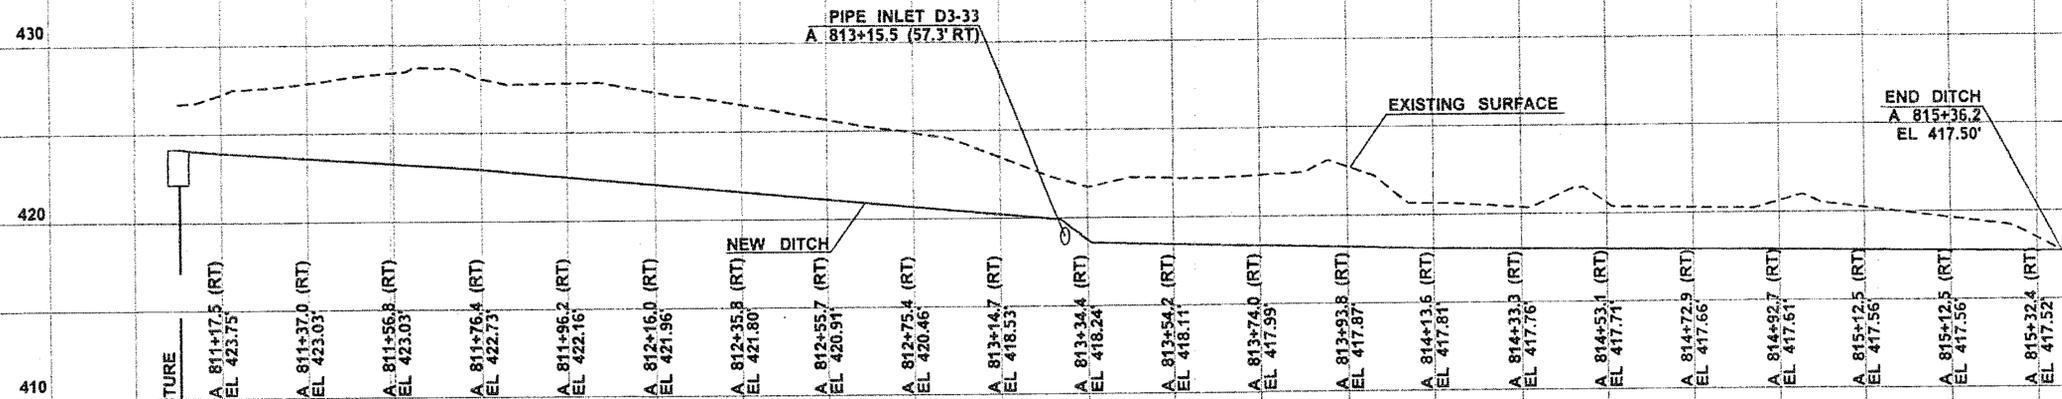

FOR 'AS CONSTRUCTED
PLANS ONLY


GENERAL NOTES:
1. STATION AND OFFSET REFERS TO CENTER OF GRATE.

FILE NAME I:\Projects\XL3325 SR9 SR531 172nd St NE Int\CAD\PS&ESheets\XL3325 PS DRAINAGE PROFILES.dgn		REGION NO. 10		STATE WASH	FED.AID PROJ.NO.			SR 9	SR 531/172ND ST NE & EAGLEFIELD DR	INTERSECTION IMPROVEMENT & PAVING	DRAINAGE PROFILE	Plot 6
TIME 8:57:41 AM	DATE 9/20/2011	JOB NUMBER 10A042	CONTRACT NO.	LOCATION NO.	DATE 9/22/11							PLAN REF. NO. DP6
PLOTTED BY solwalk	DESIGNED BY M. GUNN	ENTERED BY K.SOLWOLD	CHECKED BY J. KORESKI	PROJ. ENGR. S. SPAHR	REGIONAL ADM. L. ENG	REVISION	DATE	BY	SHEET 79	OF 230	SHEETS	




(NAVD) 88

ROADWAY SECTION A

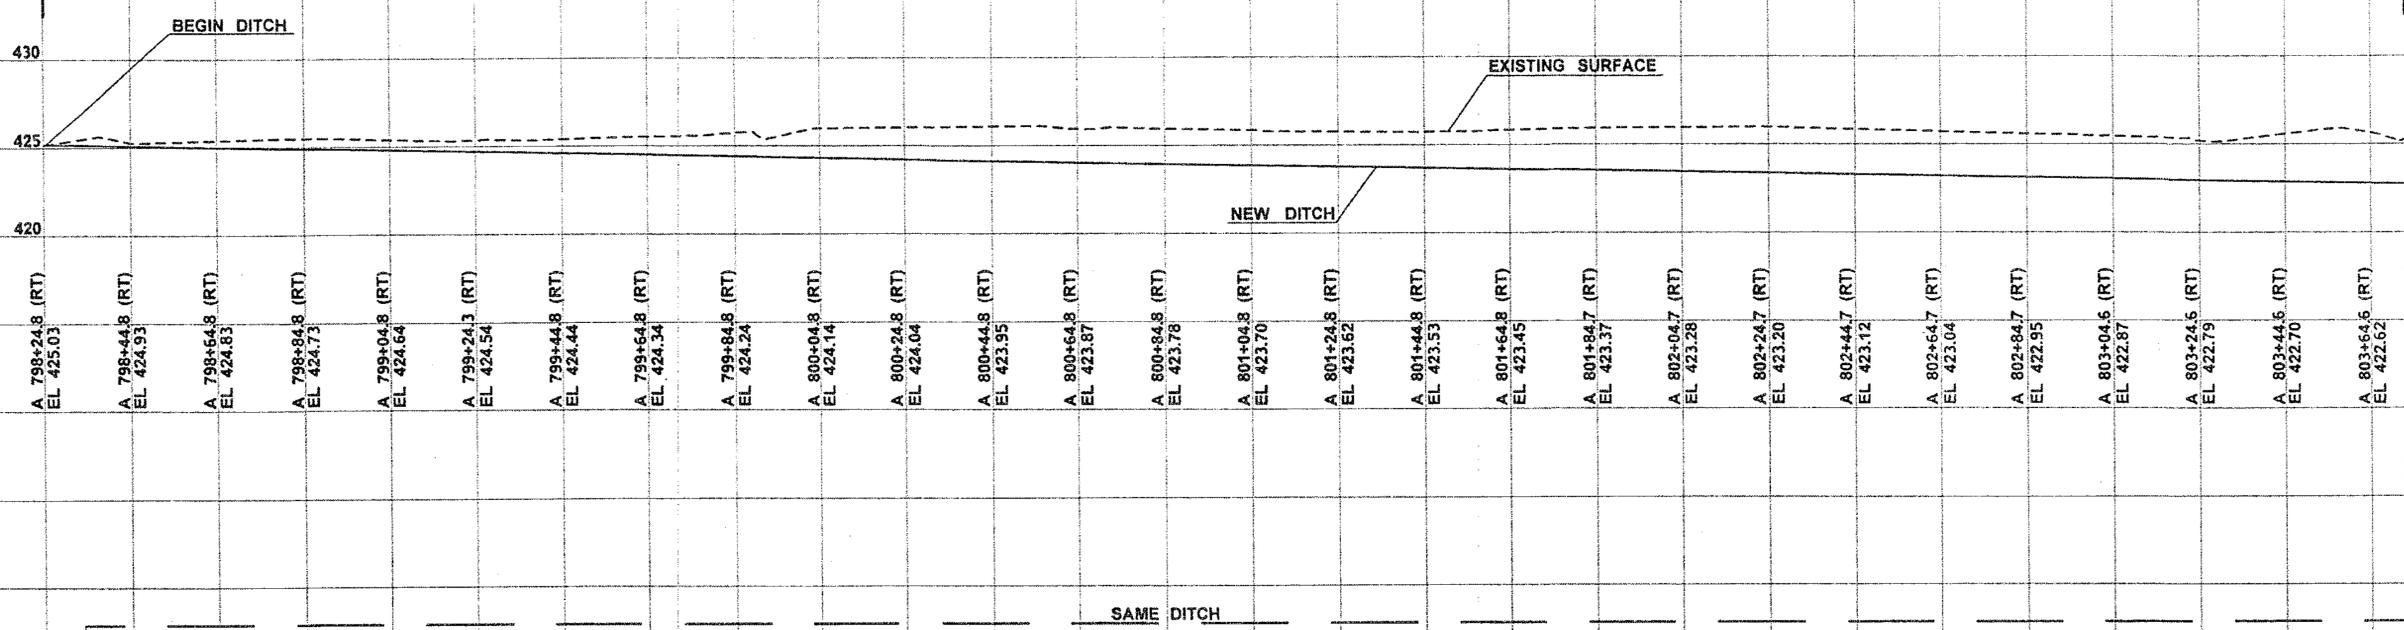

ROADWAY SECTION A

ROADWAY SECTION B

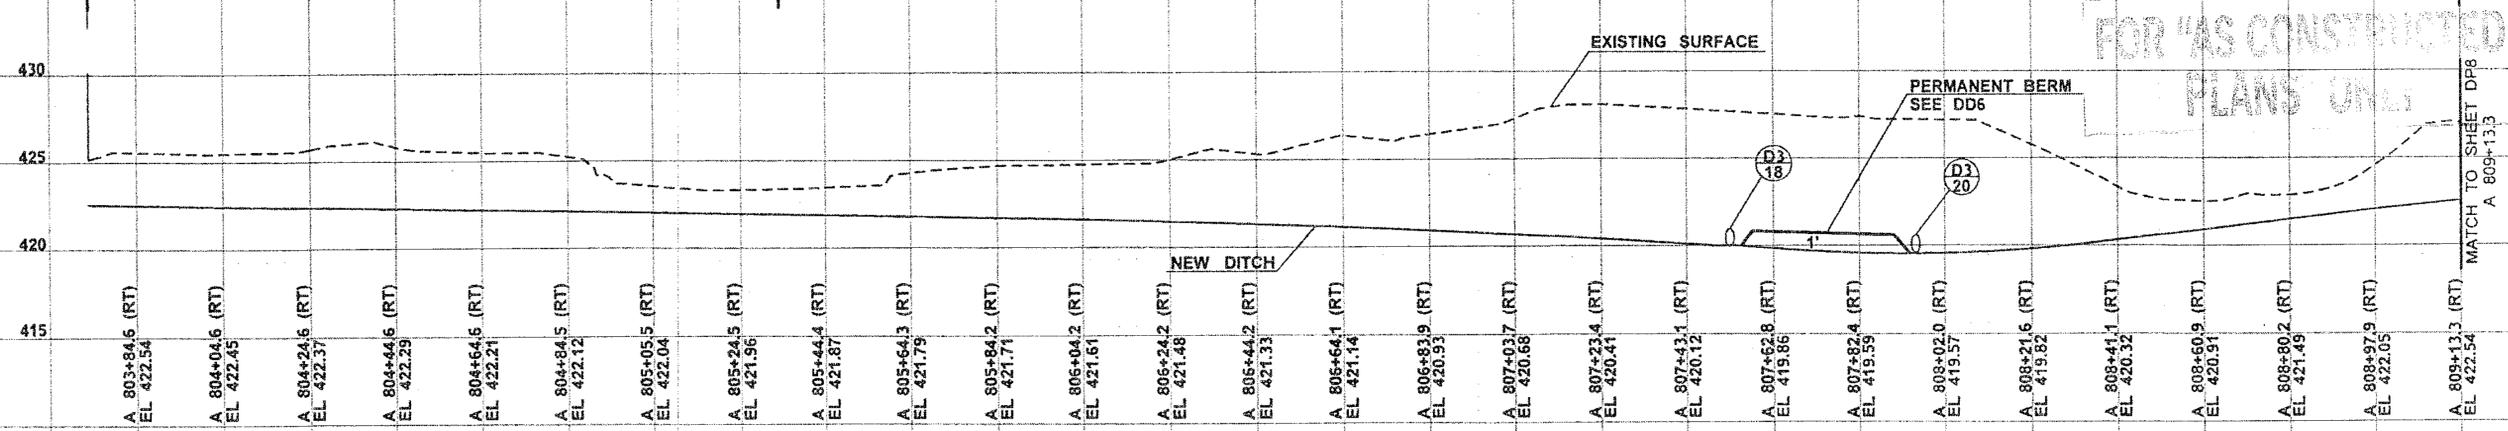

GENERAL NOTES:
 1. STATION AND OFFSET REFERS TO CENTER OF GRATE.

FILE NAME I:\Projects\XL3325 SR9 SR531 172nd St NE Int\CAD\PS&ESheets\XL3325_PS_DRAINAGE_PROFILES.dgn		REGION NO. STATE		FED.AID PROJ.NO.				SR 9 SR 531/172ND ST NE & EAGLEFIELD DR INTERSECTION IMPROVEMENT & PAVING DRAINAGE PROFILE	Plot 7 PLAN REF. NO. DP7 SHEET 80 OF 230 SHEETS
TIME 8:57:43 AM	DATE 9/20/2011	10	WASH						
PLOTTED BY solwolk	DESIGNED BY M. GUNN	JOB NUMBER 10A042		LOCATION NO.					
ENTERED BY K.SOLWOLD	CHECKED BY J. KORESKI	CONTRACT NO.		DATE					
PROJ. ENGR. S. SPAHR	REGIONAL ADM. L. ENG	REVISION	DATE	BY					



ROADWAY SECTION B

ROADWAY SECTION E

ROADWAY SECTION F

MATCH TO SHEET DP7
A 809+13.3

END DITCH
MATCH EXISTING DITCH
B 24+65.6 (13.5' RT)
EL. 453.31

EXISTING SURFACE


NEW DITCH

A 809+13.3 (RT) EL 422.54	B 19+66.9 (RT) EL 422.95	B 19+81.5 (RT) EL 423.28	B 19+98.3 (RT) EL 423.53	B 20+16.7 (RT) EL 423.92	B 20+36.7 (RT) EL 424.59	B 20+56.6 (RT) EL 425.55	B 20+76.5 (RT) EL 426.79	B 20+96.4 (RT) EL 428.15	B 21+16.3 (RT) EL 429.52	B 21+36.2 (RT) EL 430.88	B 21+56.2 (RT) EL 432.24	B 21+76.2 (RT) EL 433.59	B 21+96.2 (RT) EL 434.93	B 22+16.3 (RT) EL 436.27	B 22+36.5 (RT) EL 437.59	B 22+56.6 (RT) EL 438.90	B 22+76.7 (RT) EL 440.21	B 22+96.9 (RT) EL 441.50	B 23+17.0 (RT) EL 442.78	B 23+37.1 (RT) EL 444.06	B 23+57.1 (RT) EL 445.33	B 23+77.1 (RT) EL 446.60	B 23+97.0 (RT) EL 447.87	B 24+17.1 (RT) EL 449.46	B 24+37.0 (RT) EL 451.05	B 24+56.9 (RT) EL 452.64
------------------------------	-----------------------------	-----------------------------	

FOR "AS CONSTRUCTED
PLANS" ONLY

GENERAL NOTES:
1. STATION AND OFFSET REFERS TO CENTER OF GRATE.

FILE NAME	I:\Projects\X13325 SR9 SR531 172nd St NE Int\CAD\PS&ESheets\X13325_PS_DRAINAGE_PROFILES.dgn		
TIME	8:57:44 AM		
DATE	9/20/2011		
PLOTTED BY	solwoik		
DESIGNED BY	M. GUNN		
ENTERED BY	K.SOLWOLD		
CHECKED BY	J. KORESKI		
PROJ. ENGR.	S. SPAHR		
REGIONAL ADM.	L. ENG		
REVISION	DATE	BY	
REGION NO.	STATE	FED.AID PROJ.NO.	
10	WASH		
JOB NUMBER	10A042		
CONTRACT NO.	LOCATION NO.		

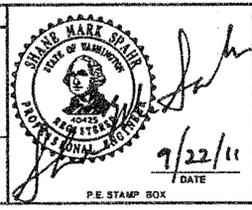


SR 9	Plot 8
SR 531/172ND ST NE & EAGLEFIELD DR	PLAN REF. NO
INTERSECTION IMPROVEMENT & PAVING	DP8
DRAINAGE PROFILE	SHEET 81 OF 230 SHEETS

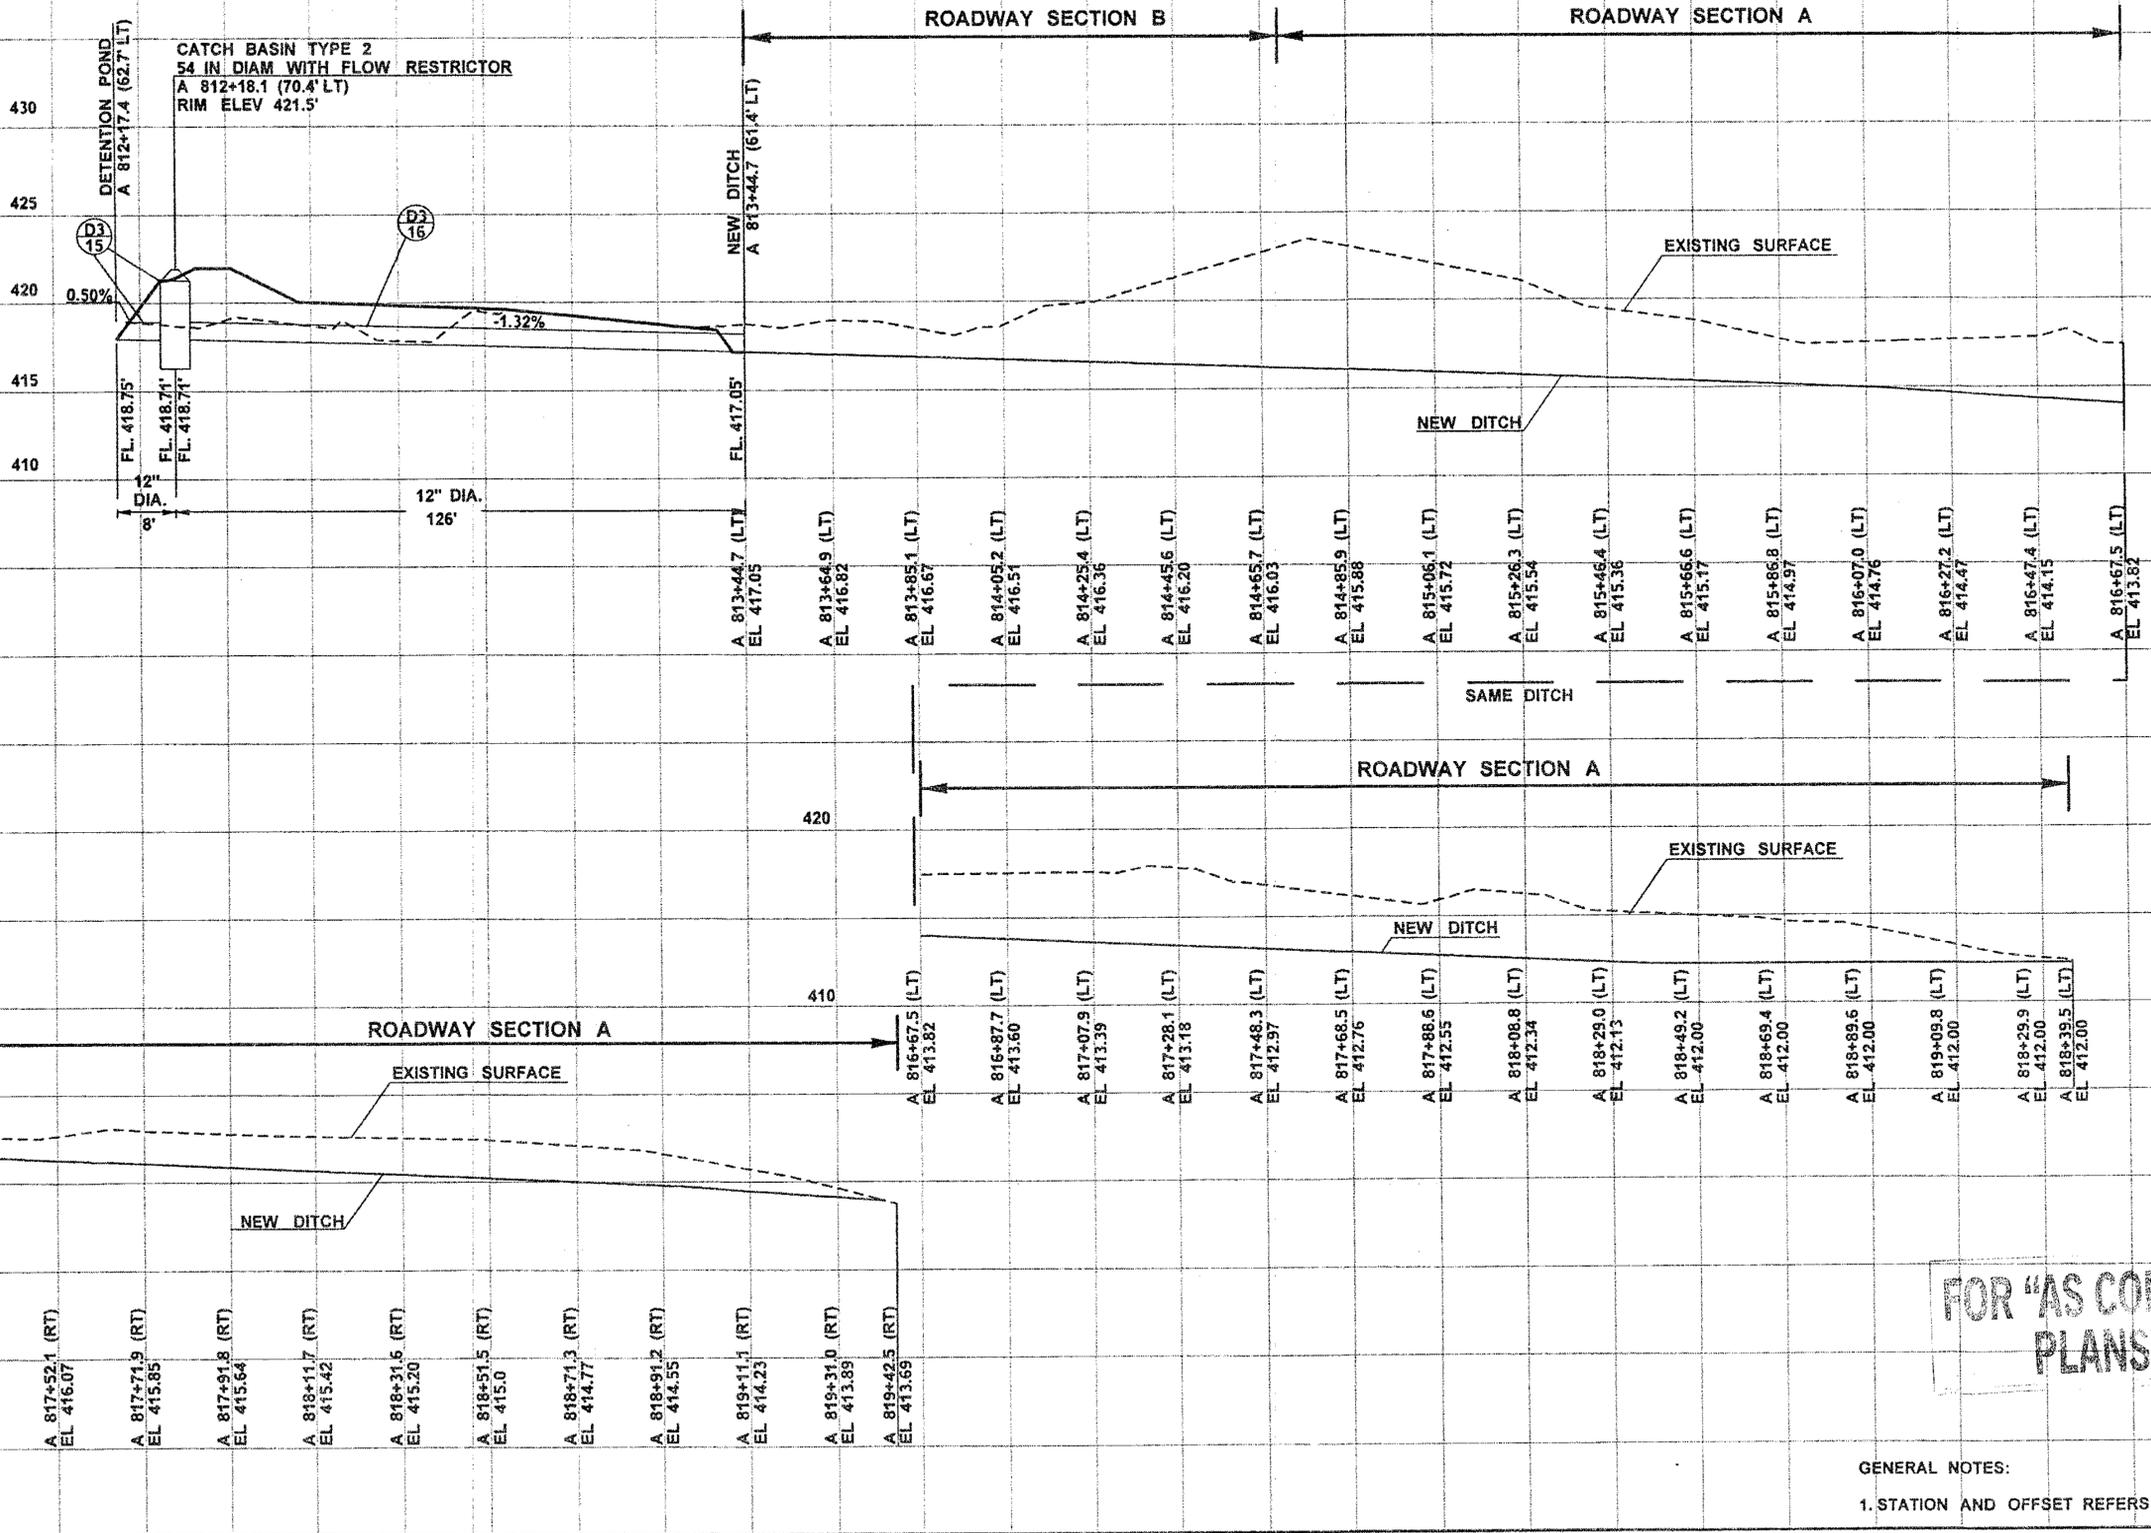

**FOR "AS CONSTRUCTED
PLANS" ONLY**


GENERAL NOTES:
1. STATION AND OFFSET REFERS TO CENTER OF GRATE.

FILE NAME I:\Projects\XL3325 SR9 SR531 172nd St NE IntCAD\PS&ESheets\XL3325 PS DRAINAGE PROFILES.dgn		REGION NO. 10		STATE WASH		FED.AID PROJ.NO.				SR 9		Plot 9
TIME 8:57:45 AM	DATE 9/20/2011		JOB NUMBER 10A042		LOCATION NO.		SR 531/172ND ST NE & EAGLEFIELD DR			PLAN REF. NO DP9		
PLOTTED BY solwolk	DESIGNED BY M. GUNN		CONTRACT NO.		DATE		INTERSECTION IMPROVEMENT & PAVING			SHEET 82		
ENTERED BY K.SOLWOLD	CHECKED BY J. KORESKI		REVISION		DATE		DRAINAGE PROFILE			OF 230		
PROJ. ENGR. S. SPAHR	REGIONAL ADM. L. ENG		BY		DATE				SHEETS			

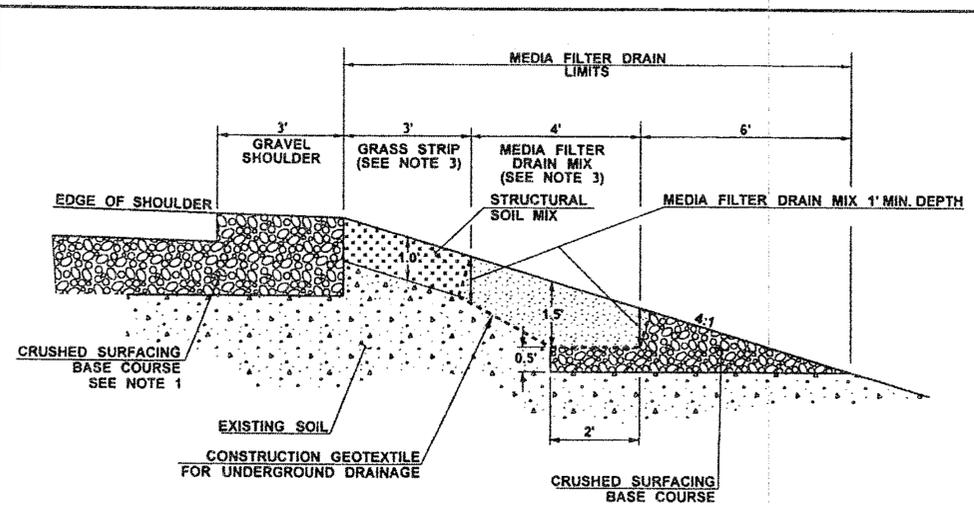


**MEDIA FILTER DRAIN TYPE 1
(WITHOUT UNDERDRAIN) (N.T.S.)**

STA. A 795+78.0 (RT) TO A 798+05.0 (RT)
 STA. A 795+78.0 (LT) TO A 802+50.0 (LT)
 STA. A 813+68.0 (LT) TO A 819+34.0 (LT)

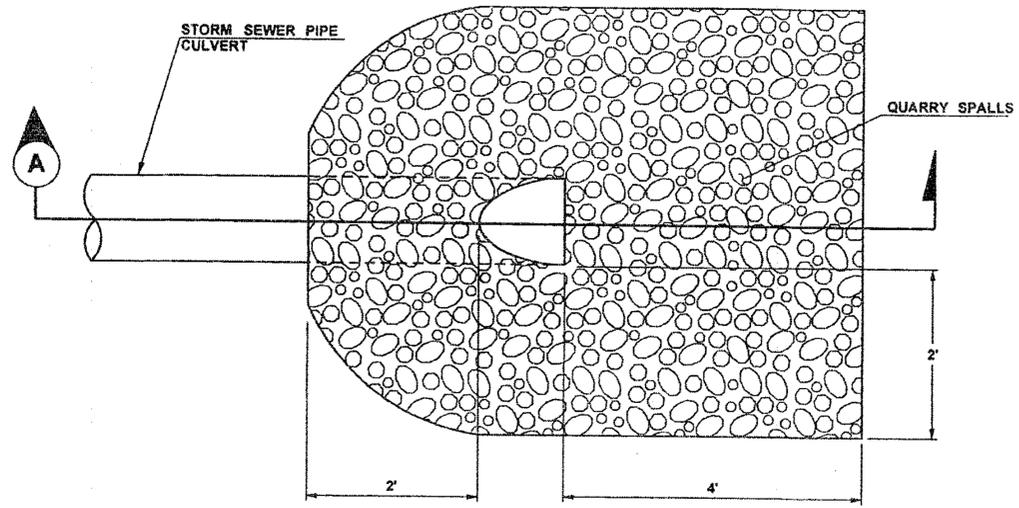


**TYPICAL STORM SEWER OUTLET PLAN VIEW & DETAIL
N.T.S.**

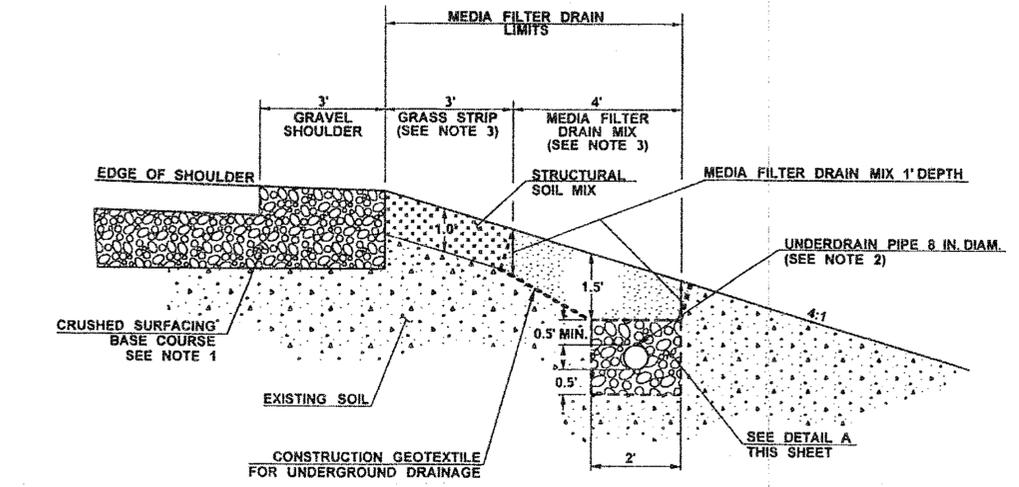


**MEDIA FILTER DRAIN TYPE 2
(WITH UNDERDRAIN) (N.T.S.)**

STA. A 798+05.0 (RT) TO A 807+50.0 (RT)
 STA. A 802+50.0 (LT) TO A 808+18.0 (LT)

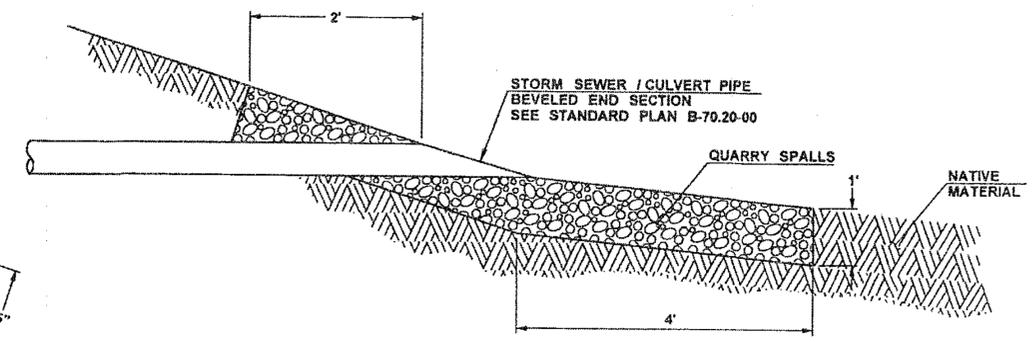

**SECTION A-A
N.T.S.**

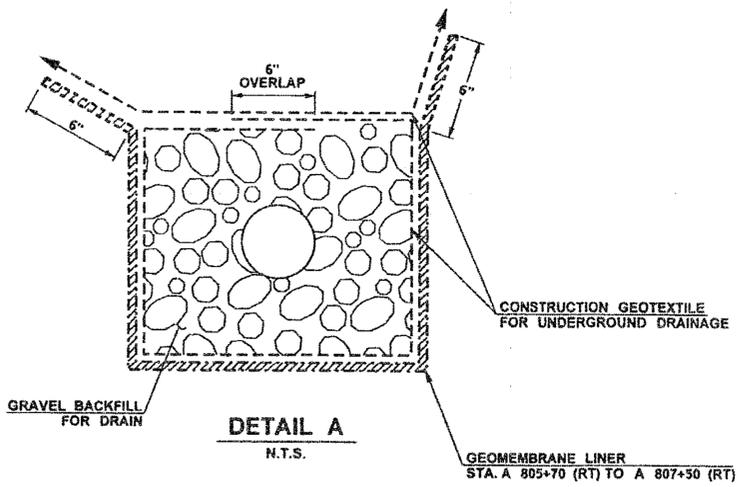


**DETAIL A
N.T.S.**


**FOR "AS CONSTRUCTED
PLANS" ONLY**

- GENERAL NOTES:**
1. REFER TO ROADWAY SECTIONS FOR MATERIAL DEPTHS.
 2. FOR UNDERDRAIN PIPE SEE SECTION 7-01.3(2)
 3. SEE SPECIAL PROVISION DRAINS FOR PAYMENT AND MEASUREMENT DETAILS.

FILE NAME: I:\Projects\XL3325 SR9 SR531 172nd St NE Int\CAD\PS&ESheets\XL3325 PS DRAINAGE DETAIL.dgn		REGION NO. 10	STATE WASH	FED.AID PROJ.NO.			SR 9 SR 531/172ND ST NE & EAGLEFIELD DR INTERSECTION IMPROVEMENT & PAVING	Plot 1	
TIME: 1:11:42 PM	DATE: 9/22/2011	JOB NUMBER: 10A042	CONTRACT NO.	LOCATION NO.				PLAN REF NO: DD1	
PLOTTED BY: lamaymp	DESIGNED BY: M. GUNN	ENTERED BY: K. SOLWOLD	CHECKED BY: J. KORESKI	PROJ. ENGR: S. SPAHR	REGIONAL ADM: L. ENG	REVISION	DATE	BY	SHEET 83 OF 230 SHEETS
							DRAINAGE DETAILS		

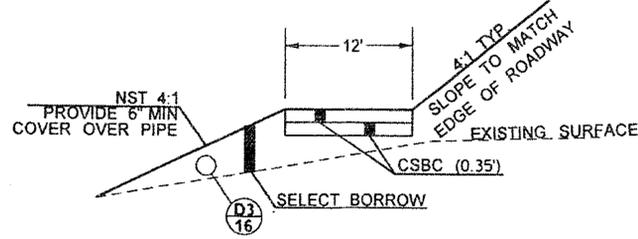

ACCESS ROAD DETAIL

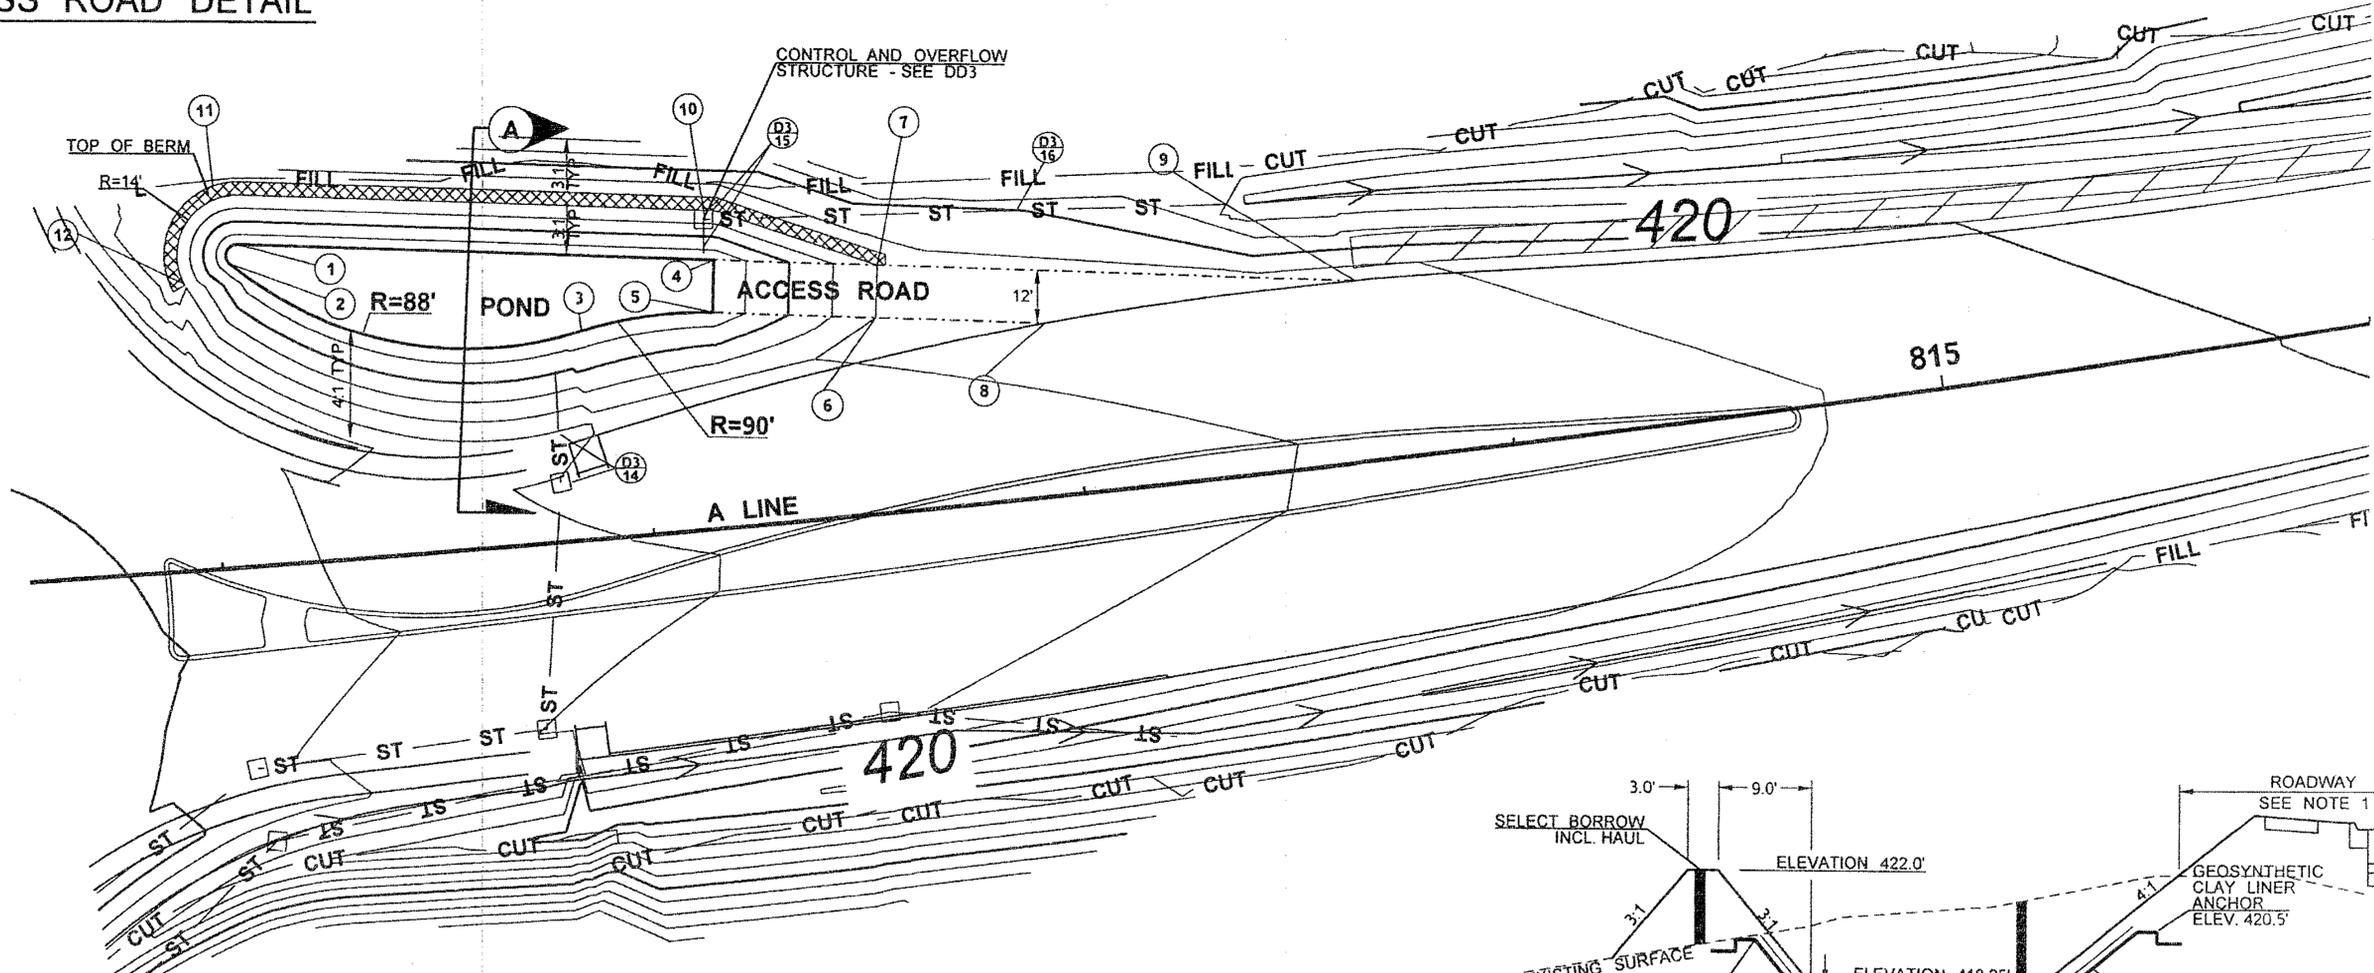


LEGEND

- BERM
- MEDIA FILTER DRAIN
- NEW DITCH
- WSDOT R/W
- NEW CURB
- NEW WHITE WIDE LINE
- NEW EDGE LINE
- NEW LINE LANE WHITE
- EXISTING LANE LINE
- EXISTING WHITE EDGE LINE
- EXISTING PAVED EDGE
- EXISTING GUARDRAIL
- EXISTING CURB

#	STATION	OFFSET	ELEVATION
1	A 811+08.7	73.3' LT	418.25'
2	A 811+06.7	69.0' LT	418.25'
3	A 811+87.8	47.6' LT	418.25'
4	A 812+19.7	61.0' LT	418.25'
5	A 812+18.2	49.1' LT	418.25'
6	A 812+55.7	44.5' LT	422.00'
7	A 812+57.3	56.4' LT	422.00'
8	A 812+95.0	39.4' LT	421.68'
9	A 813+68.0	41.2' LT	421.17'
10	A 812+20.2	72.3' LT	422.00'
11	A 811+09.9	84.5' LT	422.00'
12	A 810+96.3	64.2' LT	422.00'


GENERAL NOTES:

1. SEE PD4 AND ROADWAY SECTIONS FOR ROADWAY DETAILS.
2. SEE DD3 FOR OVERFLOW DETAILS.
3. SEE DD3 FOR GEOSYNTHETIC CLAY LINER ANCHOR DETAIL.

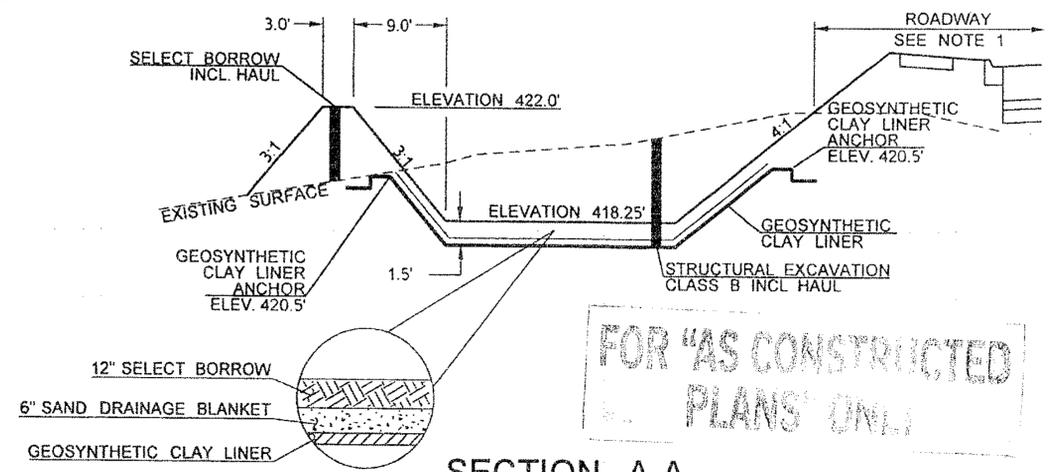


FOR "AS CONSTRUCTED PLANS" ONLY


SECTION A-A

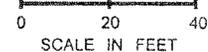



FILE NAME	I:\Projects\XL3325_SR9_SR531_172nd St_NE_Int\CAD\PS&ESheets\XL3325_PS_DRAINAGE_DETAIL.dgn	REGION NO.	STATE	FED.AID PROJ.NO.			SR 9 SR 531/172ND ST NE & EAGLEFIELD DR INTERSECTION IMPROVEMENT & PAVING	Plot 2
TIME	9:07:47 AM	10	WASH					PLAN REF NO DD2
DATE	9/20/2011	JOB NUMBER						SHEET 84
PLOTTED BY	gunnm	CONTRACT NO.						OF 230
DESIGNED BY	M. GUNN	LOCATION NO.						SHEETS
ENTERED BY	K. SOLWOLD							
CHECKED BY	J. KORESKE							
PROJ. ENGR.	S. SPAHR							
REGIONAL ADM.	L. ENG							
	REVISION	DATE	BY					

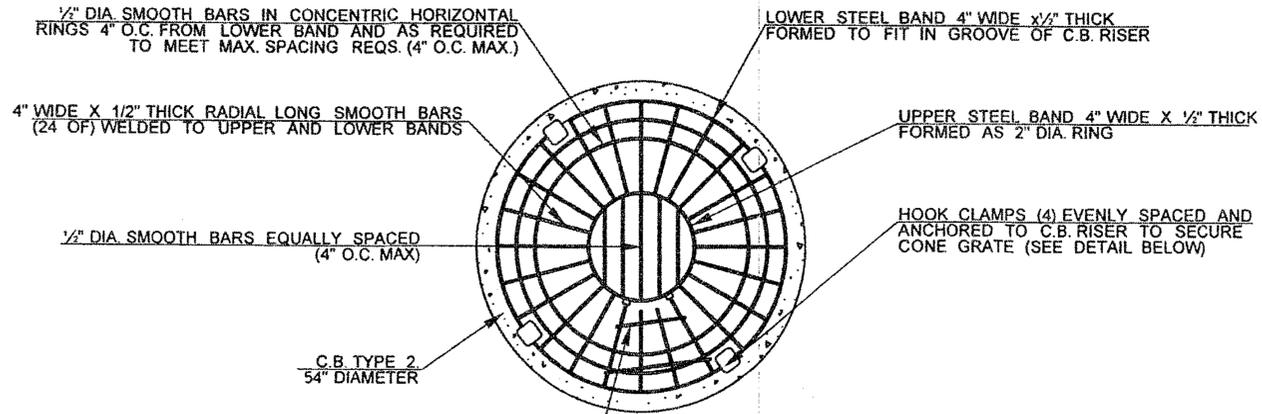

PROVIDE LOCKING HATCH MAINTENANCE ACCESS IN CONE GRATE TO BE LOCATED ABOVE STEPS.

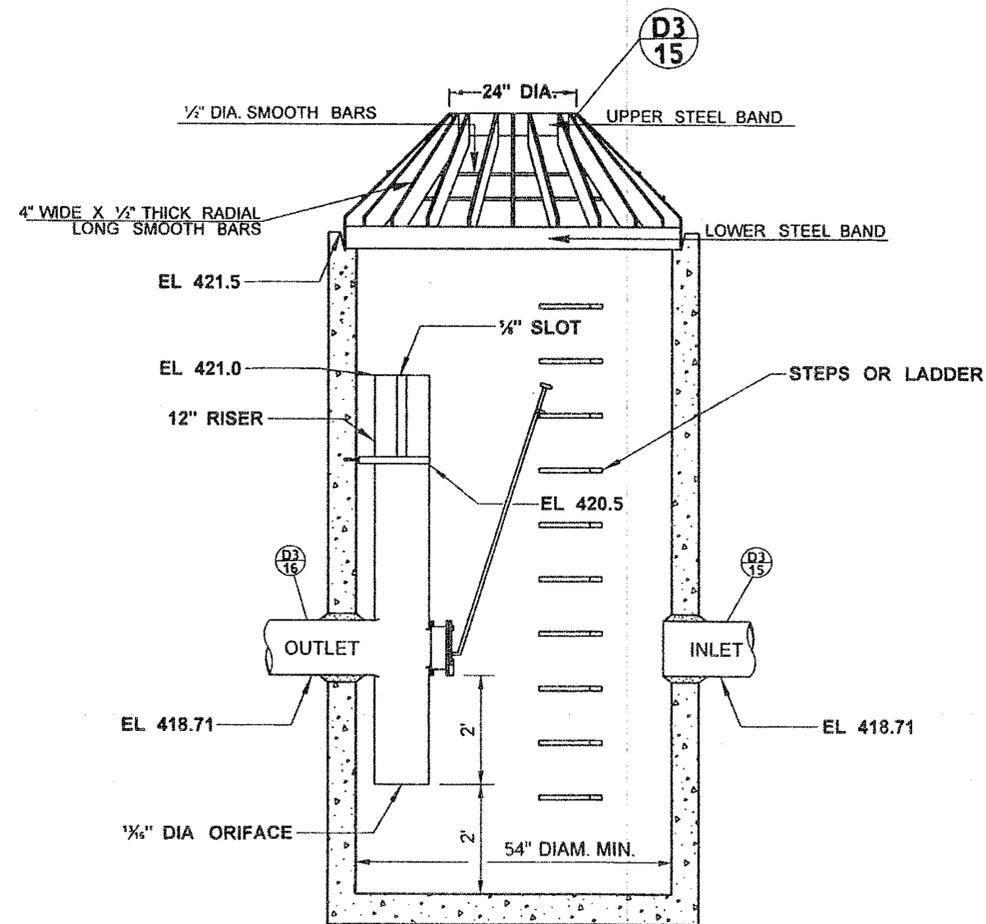


CONICAL OVERFLOW RACK DETAIL
NTS

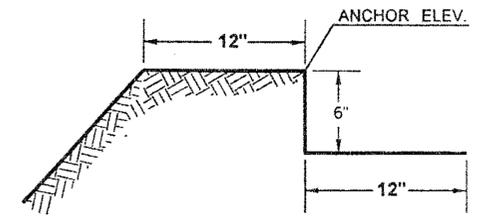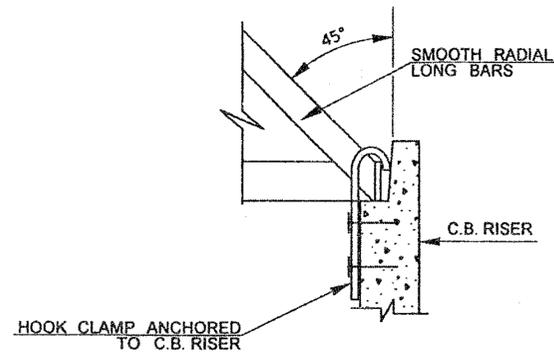

GEOSYNTHETIC CLAY LINER ANCHOR DETAIL
NTS



FOR "AS CONSTRUCTED PLANS" ONLY

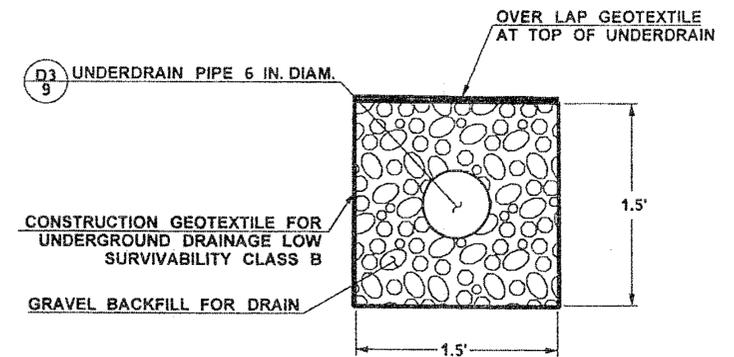

UNDERDRAIN DETAIL
N.T.S.

FILE NAME	I:\Projects\XL3325 SR9 SR531 172nd St NE Int\CAD\PS&ESheets\XL3325 PS_DRAINAGE_DETAIL.dgn			REGION NO.	STATE	FED.AID PROJ.NO.			SR 9 SR 531/172ND ST NE & EAGLEFIELD DR INTERSECTION IMPROVEMENT & PAVING	Plot 3
TIME	9:07:50 AM			10	WASH					PLAN REF NO
DATE	9/20/2011			JOB NUMBER					SHEET	
PLOTTED BY	gunnm			CONTRACT NO.					85	
DESIGNED BY	M. GUNN			LOCATION NO.					230	
ENTERED BY	K. SOLWOLD								SHEETS	
CHECKED BY	J. KORESKI									
PROJ. ENGR.	S. SPAHR									
REGIONAL ADM.	L. ENG									
	REVISION		DATE	BY						



DRAINAGE DETAILS

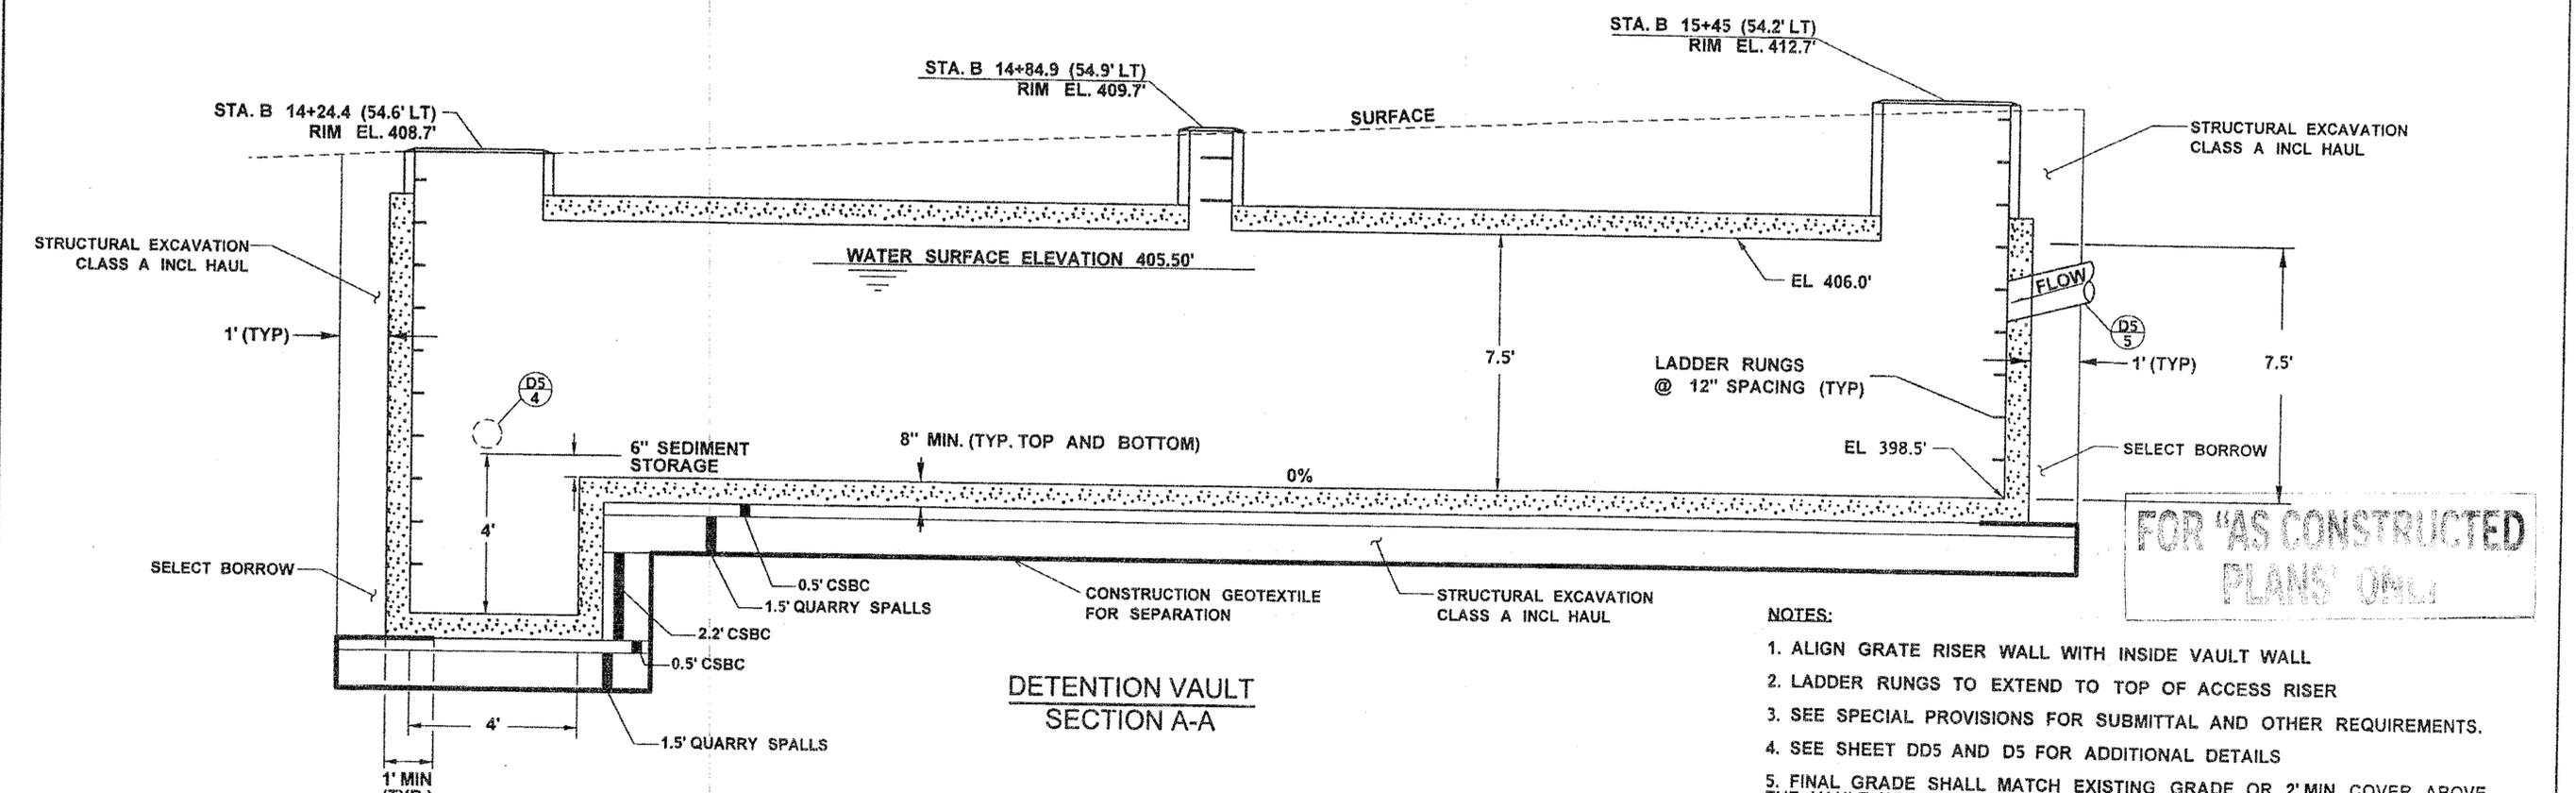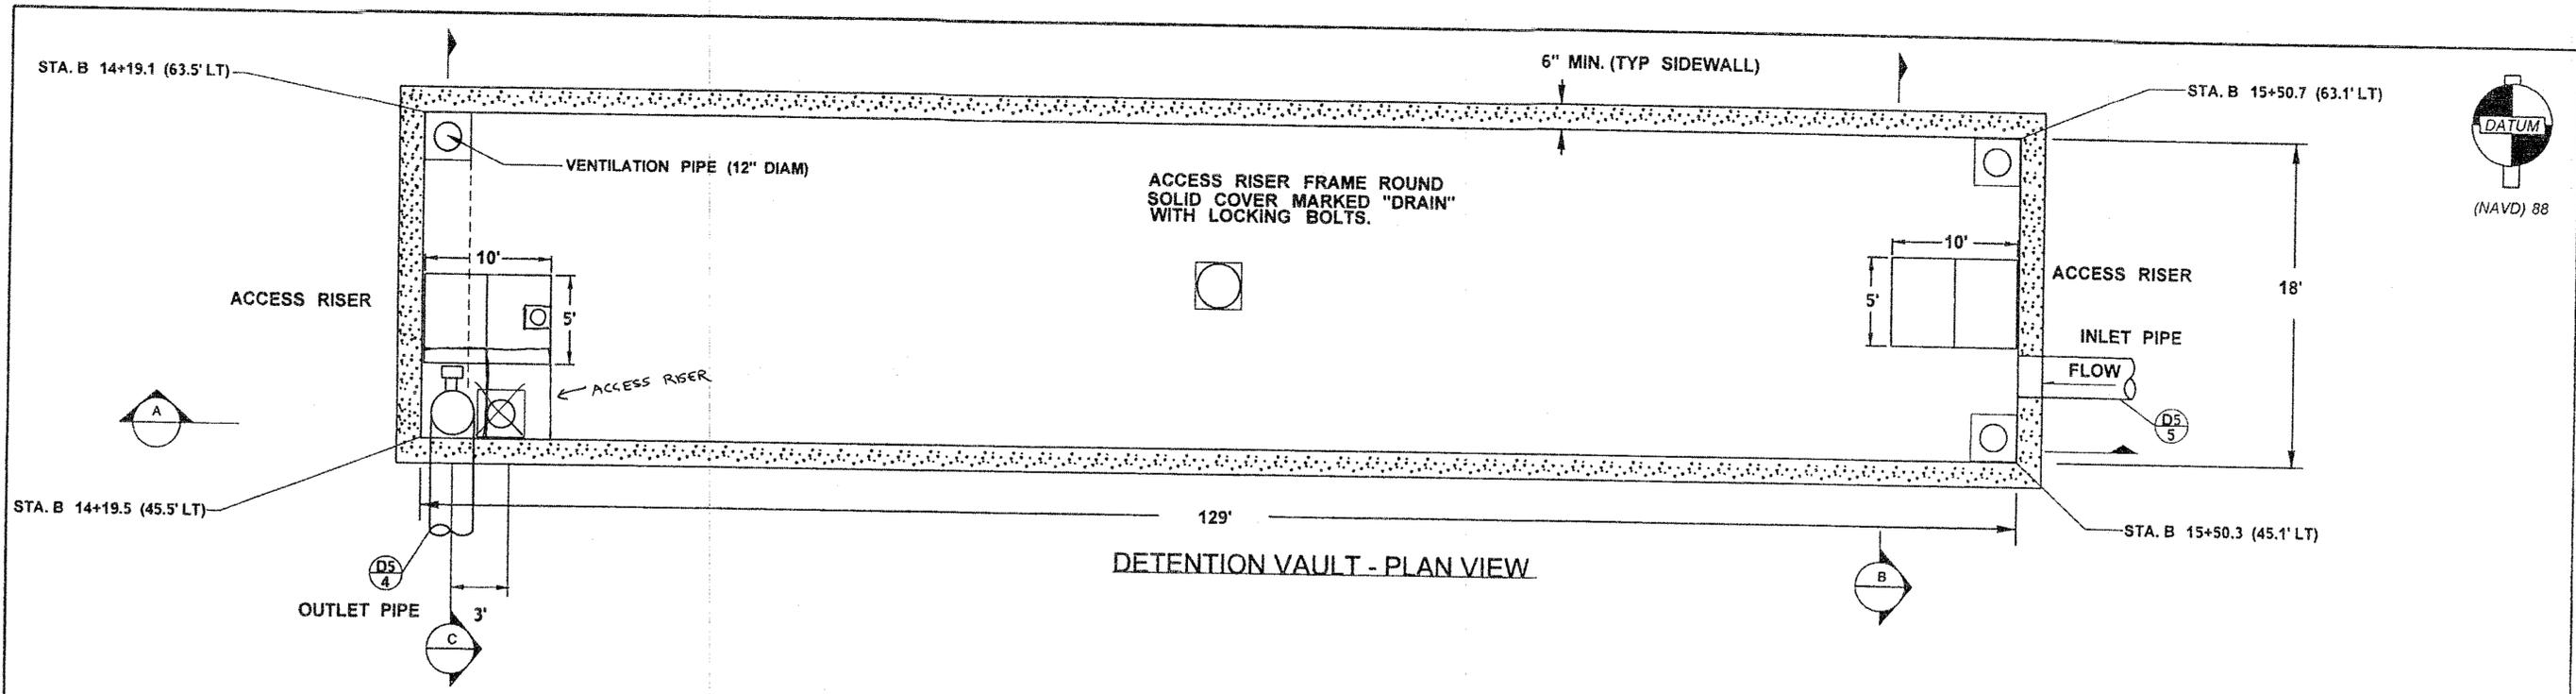


FOR "AS CONSTRUCTED PLANS" ONLY

- NOTES:**
1. ALIGN GRATE RISER WALL WITH INSIDE VAULT WALL
 2. LADDER RUNGS TO EXTEND TO TOP OF ACCESS RISER
 3. SEE SPECIAL PROVISIONS FOR SUBMITTAL AND OTHER REQUIREMENTS.
 4. SEE SHEET DD5 AND D5 FOR ADDITIONAL DETAILS
 5. FINAL GRADE SHALL MATCH EXISTING GRADE OR 2' MIN COVER ABOVE THE VAULT, WHICH EVER IS GREATER.
 6. WALL THICKNESS WAS CALCULATED TO OVERCOME THE VAULTS BOUYANCY AND SHALL NOT BE LESS THAN THE STATED MINIMUM THICKNESS.

FILE NAME	I:\Projects\XL3325_SR9_SR531_172nd St NE Int\CAD\PS&ESheets\XL3325_PS_DRAINAGE_DETAIL.dgn			REGION NO.	STATE	FED.AID PROJ.NO.			SR 9 SR 531/172ND ST NE & EAGLEFIELD DR INTERSECTION IMPROVEMENT & PAVING	Plot 4
TIME	12:41:03 PM			10	WASH	LOCATION NO.				DD4
DATE	9/22/2011			JOB NUMBER	10A042	DATE	9/22/11	DRAINAGE DETAILS	SHEET 86	
PLOTTED BY	gunnm			CONTRACT NO.					OF 230	
DESIGNED BY	M. GUNN			REVISION	DATE	BY			SHEETS	
ENTERED BY	K.SOLWOLD									
CHECKED BY	J. KORESKE									
PROJ. ENGR.	S. SPAHR									
REGIONAL ADM.	L. ENG									

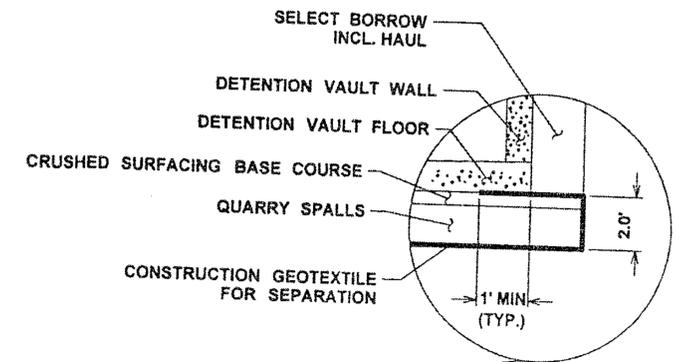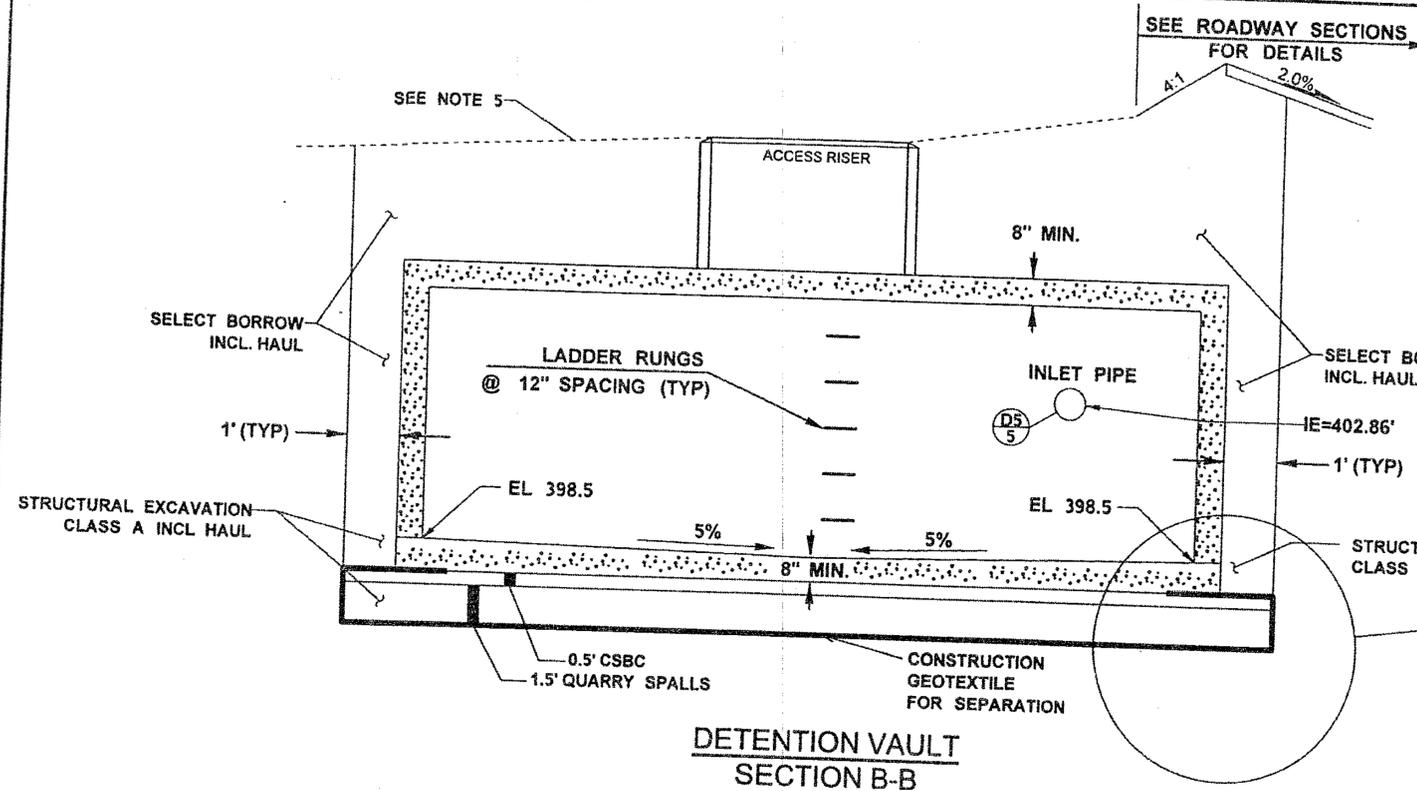

DETENTION VAULT SECTION B-B

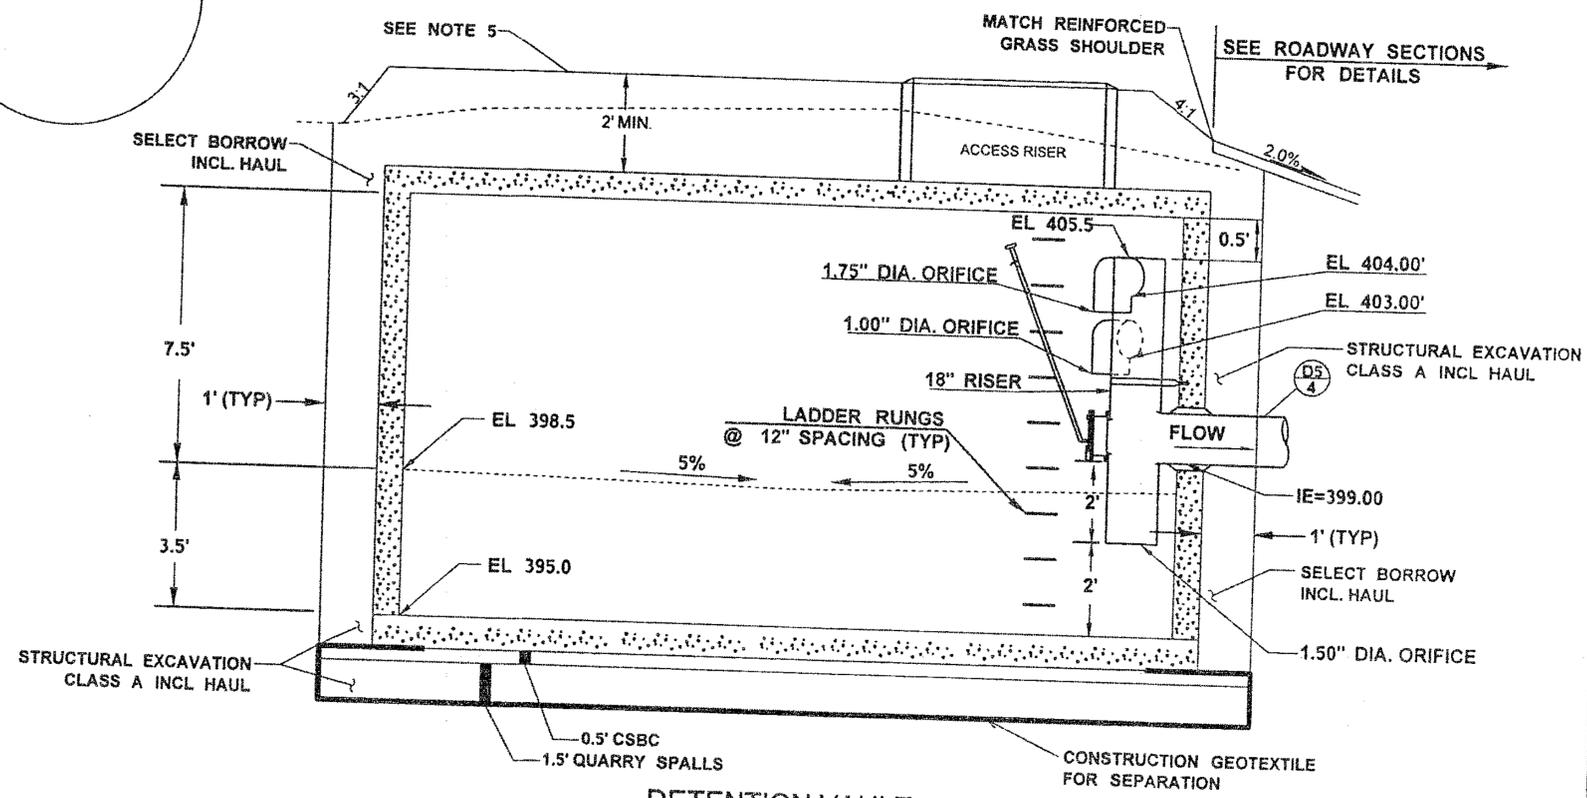

DETENTION VAULT SECTION C-C

FOR "AS CONSTRUCTED PLANS" ONLY

- NOTES:**
1. ALIGN GRATE RISER WALL WITH INSIDE VAULT WALL
 2. LADDER RUNGS TO EXTEND TO TOP OF ACCESS RISER
 3. SEE SPECIAL PROVISIONS FOR SUBMITTAL AND OTHER REQUIREMENTS.
 4. SEE SHEET DD4 AND D5 FOR ADDITIONAL DETAILS
 5. FINAL GRADE SHALL MATCH EXISTING GRADE OR 2' MIN COVER ABOVE THE VAULT, WHICH EVER IS GREATER.
 6. WALL THICKNESS WAS CALCULATED TO OVERCOME THE VAULTS BOUYANCY AND SHALL NOT BE LESS THAN THE STATED MINIMUM THICKNESS.

FILE NAME I:\Projects\XL3325_SR9_SR531_172nd_St_NE_Int\CADIPS&ESheets\XL3325_PS_DRAINAGE_DETAIL.dgn		REGION NO. 10	STATE WASH	FED.AID PROJ.NO.			SR 9 SR 531/172ND ST NE & EAGLEFIELD DR INTERSECTION IMPROVEMENT & PAVING	Plot 5
TIME 11:52:32 AM	DATE 9/21/2011	JOB NUMBER 10A042	CONTRACT NO.	LOCATION NO.				PLAN REF NO DD5
PLOTTED BY solwolk	DESIGNED BY M. GUNN	CHECKED BY J. KORESKE	PROJ. ENGR. S. SPAHR	REGIONAL ADM. L. ENG	REVISION	DATE	BY	SHEET 87 OF 230 SHEETS

STRUCTURE NOTES - UTILITIES

NOTE: THE FIRST NUMBER OF THE "CODE DESIGNATION" BELOW REFERS TO THE SHEET NO. OR THE SHEET REFERENCE NO. SHOWING THE DRAINAGE FEATURE. THE SECOND NUMBER REFERS TO THE DRAINAGE FEATURE FOUND ON THAT SHEET.		TESTING SEWER PIPE FOR AGREEMENT 01495	PVC SANITARY SEWER PIPE 12 IN. DIAM. FOR AGRMINT 01495	MANHOLE JOINT SEALING FOR AGREEMENT 01495	BANK RUN GRAVEL FOR TRENCH BACKFILL FOR AGMT 01495	GATE VALVE 8 IN. FOR AGREEMENT 01495	GATE VALVE 12 IN. FOR AGREEMENT 01495	BUTTERFLY VALVE 16 IN. FOR AGREEMENT 01495	BLOWOFF ASSEMBLY FOR AGREEMENT 01495	TAPPING SLEEVE AND VALVE ASSEMBLY 12 IN. FOR AGMT 01495	HYDRANT ASSEMBLY FOR AGREEMENT 01495	SERVICE CONNECTION 1 IN. DIAM. FOR AGREEMENT 01495	SEE GENERAL NOTES	GENERAL NOTES: * - Refer to sheets DSN1 - DSN6 and QTEC1 - QTEC2 for additional quantities.
CODE	LOCATION \ UNIT OF MEASURE	L.F.	L.F.	EACH	C.Y.	EACH	EACH	EACH	EACH	EACH	EACH	EACH		
UT2-1	B 17+83.1 (81.3' RT) TO B 20+00.7 (72.6' RT)	225	225	1	310								1, 2, 3, 8	1. SEE STANDARD PLAN B 15.20-00 MANHOLE TYPE 1. 2. SEE STANDARD PLAN B-30.70-01 CIRCULAR FRAME (RING) AND COVER. FRAME AND COVER SHALL BE TYPE 2. 3. SEE STANDARD PLAN B-30.90-01 MISCELLANEOUS DETAILS FOR DRAINAGE STRUCTURES. 4. SEE STANDARD PLAN B-90.10-00. HYDRANT SETTING TYPES A AND B. HYDRANT SETTING SHALL BE TYPE B. MINIMUM SETBACK SHALL BE 3 FEET FROM BACK OF SIDEWALK. HYDRANTS SHALL BE PAINTED WITH TWO COATS OF HIGH GLOSS EQUIPMENT YELLOW "RUST-OLEUM" TYPE PAINT. 5. SEE SERVICE MANIFOLD DETAIL ON SHEET UD4. 6. SEE CASING DETAIL ON SHEET UD2. 7. SEE STANDARD PLAN B-90.20-00 2 INCH BLOWOFF ASSEMBLY 8. SEE SHEETS DSN1-DSN4 AND SHEET DD5 FOR ADDITIONAL QUANTITIES OF "STRUCTURE EXCAVATION CLASS B INCL. HAUL" & "SHORING OR EXTRA EXCAVATION CLASS B" 9. SEE STANDARD PLAN B-90.40-00 AND B-90.50-00 FOR CONCRETE THRUST BLOCK DETAIL.
UT2-2	B 20+00.7 (72.6' RT) TO B 20+03.6 (74.4' LT)	147	147	1	285								1, 2, 3, 8	
UT2-3	B 20+03.6 (74.4' LT)			1	45								1, 2, 3, 8	
UT2-4	B 20+04.9 (61.7' RT) TO B 20+04.9 (33.7' RT)				10						1		4	
UT4-1	B 11+54.7 (25.1' RT) TO B 11+90.0 (61.0' RT)				20					1			9	
UT4-2	B 11+90.0 (61.0' RT) TO B 14+24.5 (73.7' RT)				600	1		5				3	5, 6, 9	
UT4-3	B 12+95.0 (60.9' RT) TO B 12+95.2 (45.6' LT)						1		1				6, 7, 9	
UT4-4	B 12+59.9 (71.9' RT) TO B 13+75.9 (71.7' RT)	116	116	1	170								1, 2, 3, 8	
UT4-5	B 13+75.9 (71.7' RT) TO B 17+83.1 (81.3' RT)	400	400	1	650								1, 2, 3, 8	
UT4-6	B 14+19.6 (60.7' RT) TO B 14+19.9 (73.7' RT)				5		1						7, 9	
UT4-7	B 14+19.9 (73.7' RT) TO B 14+24.5 (73.7' RT)				2						1		4	
UT5-1	B 22+58.9 (71.5' RT) TO B 23+03.7 (28.1' RT)									1			9	
UT5-2	B 22+80.5 (50.8' RT)				13							1		
SHEET TOTAL		888	888	5	2110	1	2	5	1	2	2	4		
PROJECT TOTAL		888	888	5	2110	1	2	5	1	2	2	4		

FOR 'AS CONSTRUCTED
PLANS ONLY

DESIGNED BY	M. LAMAY	10/14/10	10/25/11	AD1 - ADDED ITEM & QUANTITIES	SMS	REGION NO.	STATE	FED. AID PROJ. NO.	
ENTERED BY	M. LAMAY	10/14/10				10	WASH		Washington State Department of Transportation
CHECKED BY	M. GUNN	10/14/10				JOB NUMBER 10A042		SR 9	
PROJ. ENGR.	S. SPAHR	10/14/10				CONTRACT NO.		SR 531/172ND ST NE & EAGLEFIELD DR INTERSECTION IMPROVEMENT & PAVING	
REGION ADM.	L. ENG	10/14/10						STRUCTURE NOTES - UTILITIES	
		DATE	DATE	REVISION	BY				UTSN 1
									SHEET 89 OF 230 SHEETS

STRUCTURE NOTES - UTILITIES

NOTE: THE FIRST NUMBER OF THE "CODE DESIGNATION" BELOW REFERS TO THE SHEET NO. OR THE SHEET REFERENCE NO. SHOWING THE DRAINAGE FEATURE. THE SECOND NUMBER REFERS TO THE DRAINAGE FEATURE FOUND ON THAT SHEET.		DUCTILE IRON PIPE FOR WATER MAIN 6 IN. DIAM. - 01495	DUCTILE IRON PIPE FOR WATER MAIN 8 IN. DIAM. - 01495	DUCTILE IRON PIPE FOR WATER MAIN 12 IN. DIAM. - 01495	DUCTILE IRON PIPE FOR WATER MAIN 16 IN. DIAM. - 01495	STEEL CASING 24 IN. DIAM. FOR AGREEMENT 01495	STRUCTURE EXCAVATION CLASS B INCL. HAUL FOR AGRMT 01495	SHORING OR EXTRA EXCAVATION TRENCH FOR AGRMT 01495	SHORING OR EXTRA EXCAVATION CLASS B FOR AGRMT 01495	MANHOLE 60 IN. DIAM. TYPE 1 FOR AGREEMENT 01495	MANHOLE ADDITIONAL HEIGHT 60 IN. DIAM. TYPE 1 - 01495	SEE GENERAL NOTES	GENERAL NOTES:
CODE	LOCATION & UNIT OF MEASURE	L.F.	L.F.	L.F.	L.F.	L.F.	C.Y.	S.F.	S.F.	EACH	L.F.		
UT2-1	B 17+83.1 (81.3' RT) TO B 20+00.7 (72.6' RT)						406		2980	1	2	1, 2, 3, 8	1. SEE STANDARD PLAN B 15.20-00 MANHOLE TYPE 1. 2. SEE STANDARD PLAN B-30.70-01 CIRCULAR FRAME (RING) AND COVER. FRAME AND COVER SHALL BE TYPE 2. 3. SEE STANDARD PLAN B-30.90-01 MISCELLANEOUS DETAILS FOR DRAINAGE STRUCTURES. 4. SEE STANDARD PLAN B-90.10-00. HYDRANT SETTING TYPES A AND B. HYDRANT SETTING SHALL BE TYPE B. MINIMUM SETBACK SHALL BE 3 FEET FROM BACK OF SIDEWALK. HYDRANTS SHALL BE PAINTED WITH TWO COATS OF HIGH GLOSS EQUIPMENT YELLOW "RUST-OLEUM" TYPE PAINT. 5. SEE SERVICE MANIFOLD DETAIL ON SHEET UD4. 6. SEE CASING DETAIL ON SHEET UD2. 7. SEE STANDARD PLAN B-90.20-00 2 INCH BLOWOFF ASSEMBLY 8. SEE SHEETS DSN1-DSN4 AND SHEET DD5 FOR ADDITIONAL QUANTITIES OF "STRUCTURE EXCAVATION CLASS B INCL. HAUL" & "SHORING OR EXTRA EXCAVATION CLASS B" 9. SEE STANDARD PLAN B-90.40-00 AND B-90.50-00 FOR CONCRETE THRUST BLOCK DETAIL.
UT2-2	B 20+00.7 (72.6' RT) TO B 20+03.6 (74.4' LT)						280		1990	1	5	1, 2, 3, 8	
UT2-3	B 20+03.6 (74.4' LT)						21		250	1	4	1, 2, 3, 8	
UT2-4	B 20+04.9 (61.7' RT) TO B 20+04.9 (33.7' RT)	28										4	
UT4-1	B 11+54.7 (25.1' RT) TO B 11+90.0 (61.0' RT)			50			32	250				9	
UT4-2	B 11+90.0 (61.0' RT) TO B 14+24.5 (73.7' RT)	20	20		1070	238	910	6420				5, 6, 9	
UT4-3	B 12+95.0 (60.9' RT) TO B 12+95.2 (45.6' LT)			100		83	67	515				6, 7, 9	
UT4-4	B 12+59.9 (71.9' RT) TO B 13+75.9 (71.7' RT)						212		1480	1	2	1, 2, 3, 8	
UT4-5	B 13+75.9 (71.7' RT) TO B 17+83.1 (81.3' RT)						667		4990	1	3	1, 2, 3, 8	
UT4-6	B 14+19.6 (60.7' RT) TO B 14+19.9 (73.7' RT)			15								7, 9	
UT4-7	B 14+19.9 (73.7' RT) TO B 14+24.5 (73.7' RT)	5										4	
UT5-1	B 22+58.9 (71.5' RT) TO B 23+03.7 (28.1' RT)			62			40	310				9	
UT5-2	B 22+80.5 (50.8' RT)												
SHEET TOTAL		53	20	227	1070	321	2635	7495	11690	5	16		
PROJECT TOTAL		53	20	227	1070	321	2635	7495	11690	5	16		

FOR "AS CONSTRUCTED"
PLANS ONLY



SR 9
SR 531/172ND ST NE & EAGLEFIELD DR
INTERSECTION IMPROVEMENT & PAVING

DESIGNED BY	M. LAMAY	10/14/10
ENTERED BY	M. LAMAY	10/14/10
CHECKED BY	M. GUNN	10/14/10
PROJ. ENGR.	S. SPAHR	10/14/10
REGION ADM.	L. ENG	10/14/10

REGION NO.	STATE	FED. AID PROJ. NO.
10	WASH	
JOB NUMBER		
10A042		
CONTRACT NO.		


STRUCTURE NOTES - UTILITIES

UTSN 2
SHEET
90
OF
230
SHEETS

T. 31N. R. 5E. W.M.




LEGEND			
	WSDOT R/W		EXISTING GASLINE
	WSDOT LIMITED ACCESS		EXISTING STORM SEWER
	WETLAND BOUNDARY		EXISTING OVERHEAD TV CABLE
	WETLAND BUFFER		EXISTING BURIED TELEPHONE
	WETLAND SYMBOL		EXISTING BURIED FIBER
	NEW WATER LINE		EXISTING WATER LINE
	NEW SANITARY SEWER		EXISTING OVERHEAD POWER
	EXISTING PAVED EDGE		EXISTING BURIED POWER
	EXISTING DITCH		LIGHT STANDARD METAL
	EXISTING CULVERT		NEW FIRE HYDRANT
			EXISTING FIRE HYDRANT
			NEW WATER METER
			EXISTING WATER METER
			NEW WATER VALVE
			EXISTING WATER VALVE
			NEW SANITARY SEWER MANHOLE
			EXISTING CATCH BASIN
			UTILITY STRUCTURE NOTE
			EXISTING ELECTRICAL BOX
			UNKNOWN CABINET
			EXISTING UNKNOWN JUNCTION BOX
			EXISTING SIGNAL LOOP
			EXISTING TELEPHONE BOX
			EXISTING TELEPHONE POLE
			EXISTING POWER POLE
			EXISTING SIGNAL POLE
			EXISTING GUY ANCHOR

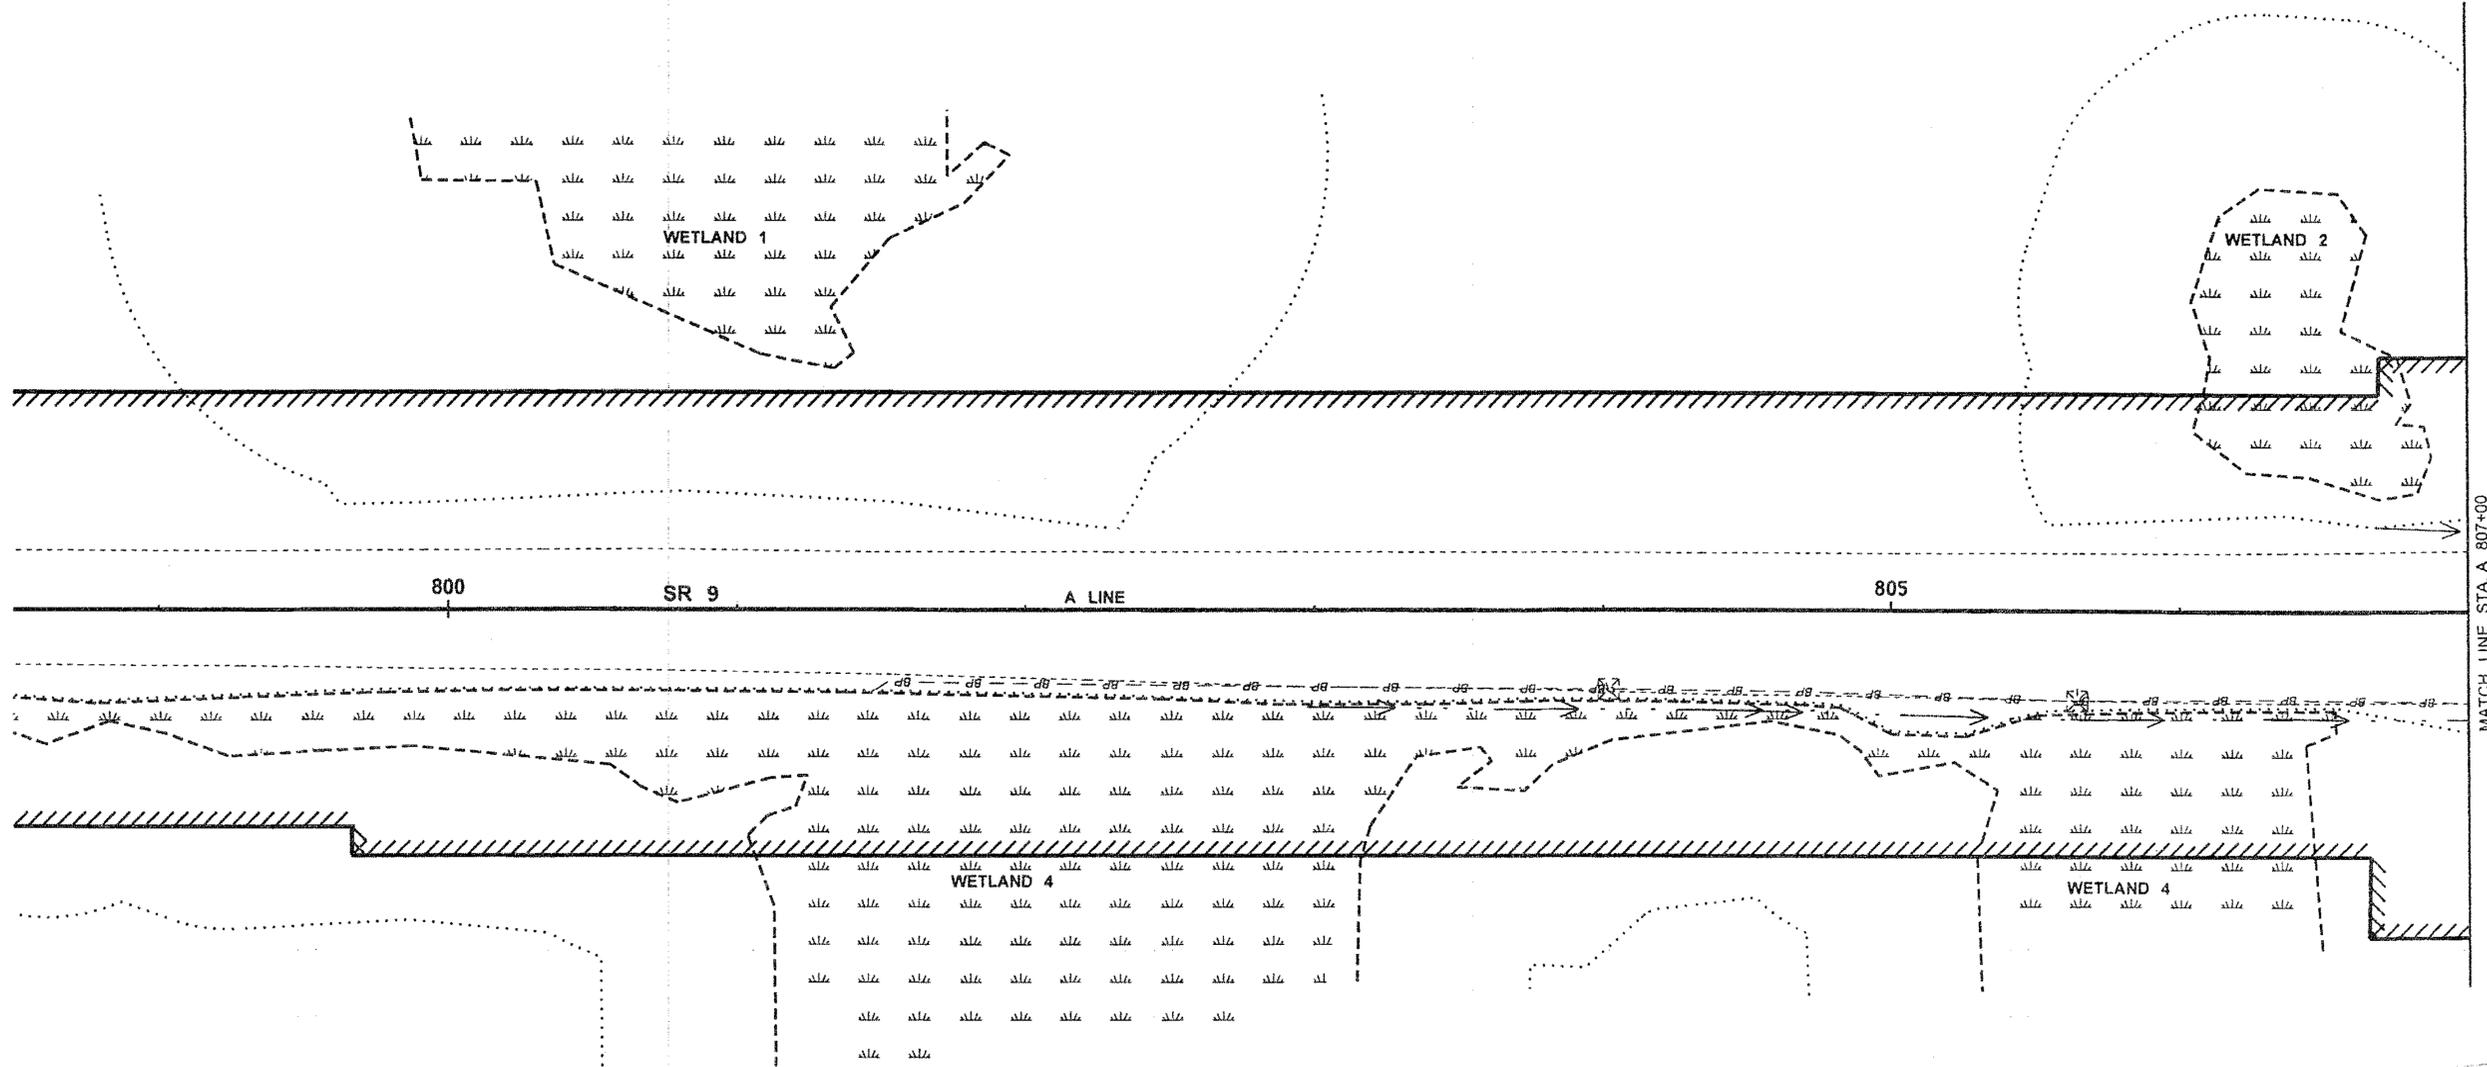

GENERAL NOTES:

- SEE SHEETS UTSN1-UTSN2 FOR UTILITY STRUCTURE NOTES.
- USE CONCRETE THRUST BLOCKING ON WATER MAIN IN ACCORDANCE WITH STANDARD PLAN B-90.40-00 AND B-90.50-00 AT ALL APPLICABLE LOCATIONS.
- REFER TO DIVISION 7 OF THE SPECIAL PROVISIONS FOR ADDITIONAL WATER MAIN AND SANITARY SEWER INFORMATION.

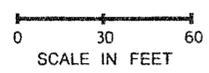


FOR "AS CONSTRUCTED" PLANS ONLY

FILE NAME I:\Projects\XL3325_SR9_SR531_172nd_St_NE_Int\CAD\PS&ESheets\XL3325_PS_UTILITIES.dgn		REGION NO. 10	STATE WASH	FED.AID PROJ.NO.			SR 9 SR 531/172ND ST NE & EAGLEFIELD DR INTERSECTION IMPROVEMENT & PAVING	Plot 2	
TIME 1:37:50 PM	DATE 9/22/2011	JOB NUMBER 10A042	CONTRACT NO.	LOCATION NO.				PLAN REF NO UT1	
PLOTTED BY lamaymp	DESIGNED BY M. GUNN	ENTERED BY K. SOLWOLD	CHECKED BY J. KORESKE	PROJ. ENGR. S. SPAHR	REGIONAL ADM. L. ENG	REVISION	DATE	BY	SHEET 91 OF 230 SHEETS


T. 31N. R. 5E. W.M.

LEGEND			
	WSDOT R/W		EXISTING ELECTRICAL BOX
	WSDOT LIMITED ACCESS		UNKNOWN CABINET
	WETLAND BOUNDARY		EXISTING UNKNOWN JUNCTION BOX
	WETLAND BUFFER		EXISTING SIGNAL LOOP
	WETLAND SYMBOL		EXISTING TELEPHONE BOX
- W -	NEW WATER LINE		EXISTING TELEPHONE POLE
- S -	NEW SANITARY SEWER		EXISTING POWER POLE
- - - - -	EXISTING PAVED EDGE		EXISTING SIGNAL POLE
- - - - -	EXISTING DITCH		EXISTING GUY ANCHOR
- - - - -	EXISTING CULVERT		NEW FIRE HYDRANT
- ST -	EXISTING STORM SEWER		EXISTING FIRE HYDRANT
- G -	EXISTING GASLINE		NEW WATER METER
- OTV -	EXISTING OVERHEAD TV CABLE		EXISTING WATER METER
- BT -	EXISTING BURIED TELEPHONE		NEW WATER VALVE
- BF -	EXISTING BURIED FIBER		EXISTING WATER VALVE
- W -	EXISTING WATER LINE		NEW SANITARY SEWER MANHOLE
- OP -	EXISTING OVERHEAD POWER		EXISTING CATCH BASIN
- BP -	EXISTING BURIED POWER		UTILITY STRUCTURE NOTE
	LIGHT STANDARD METAL		

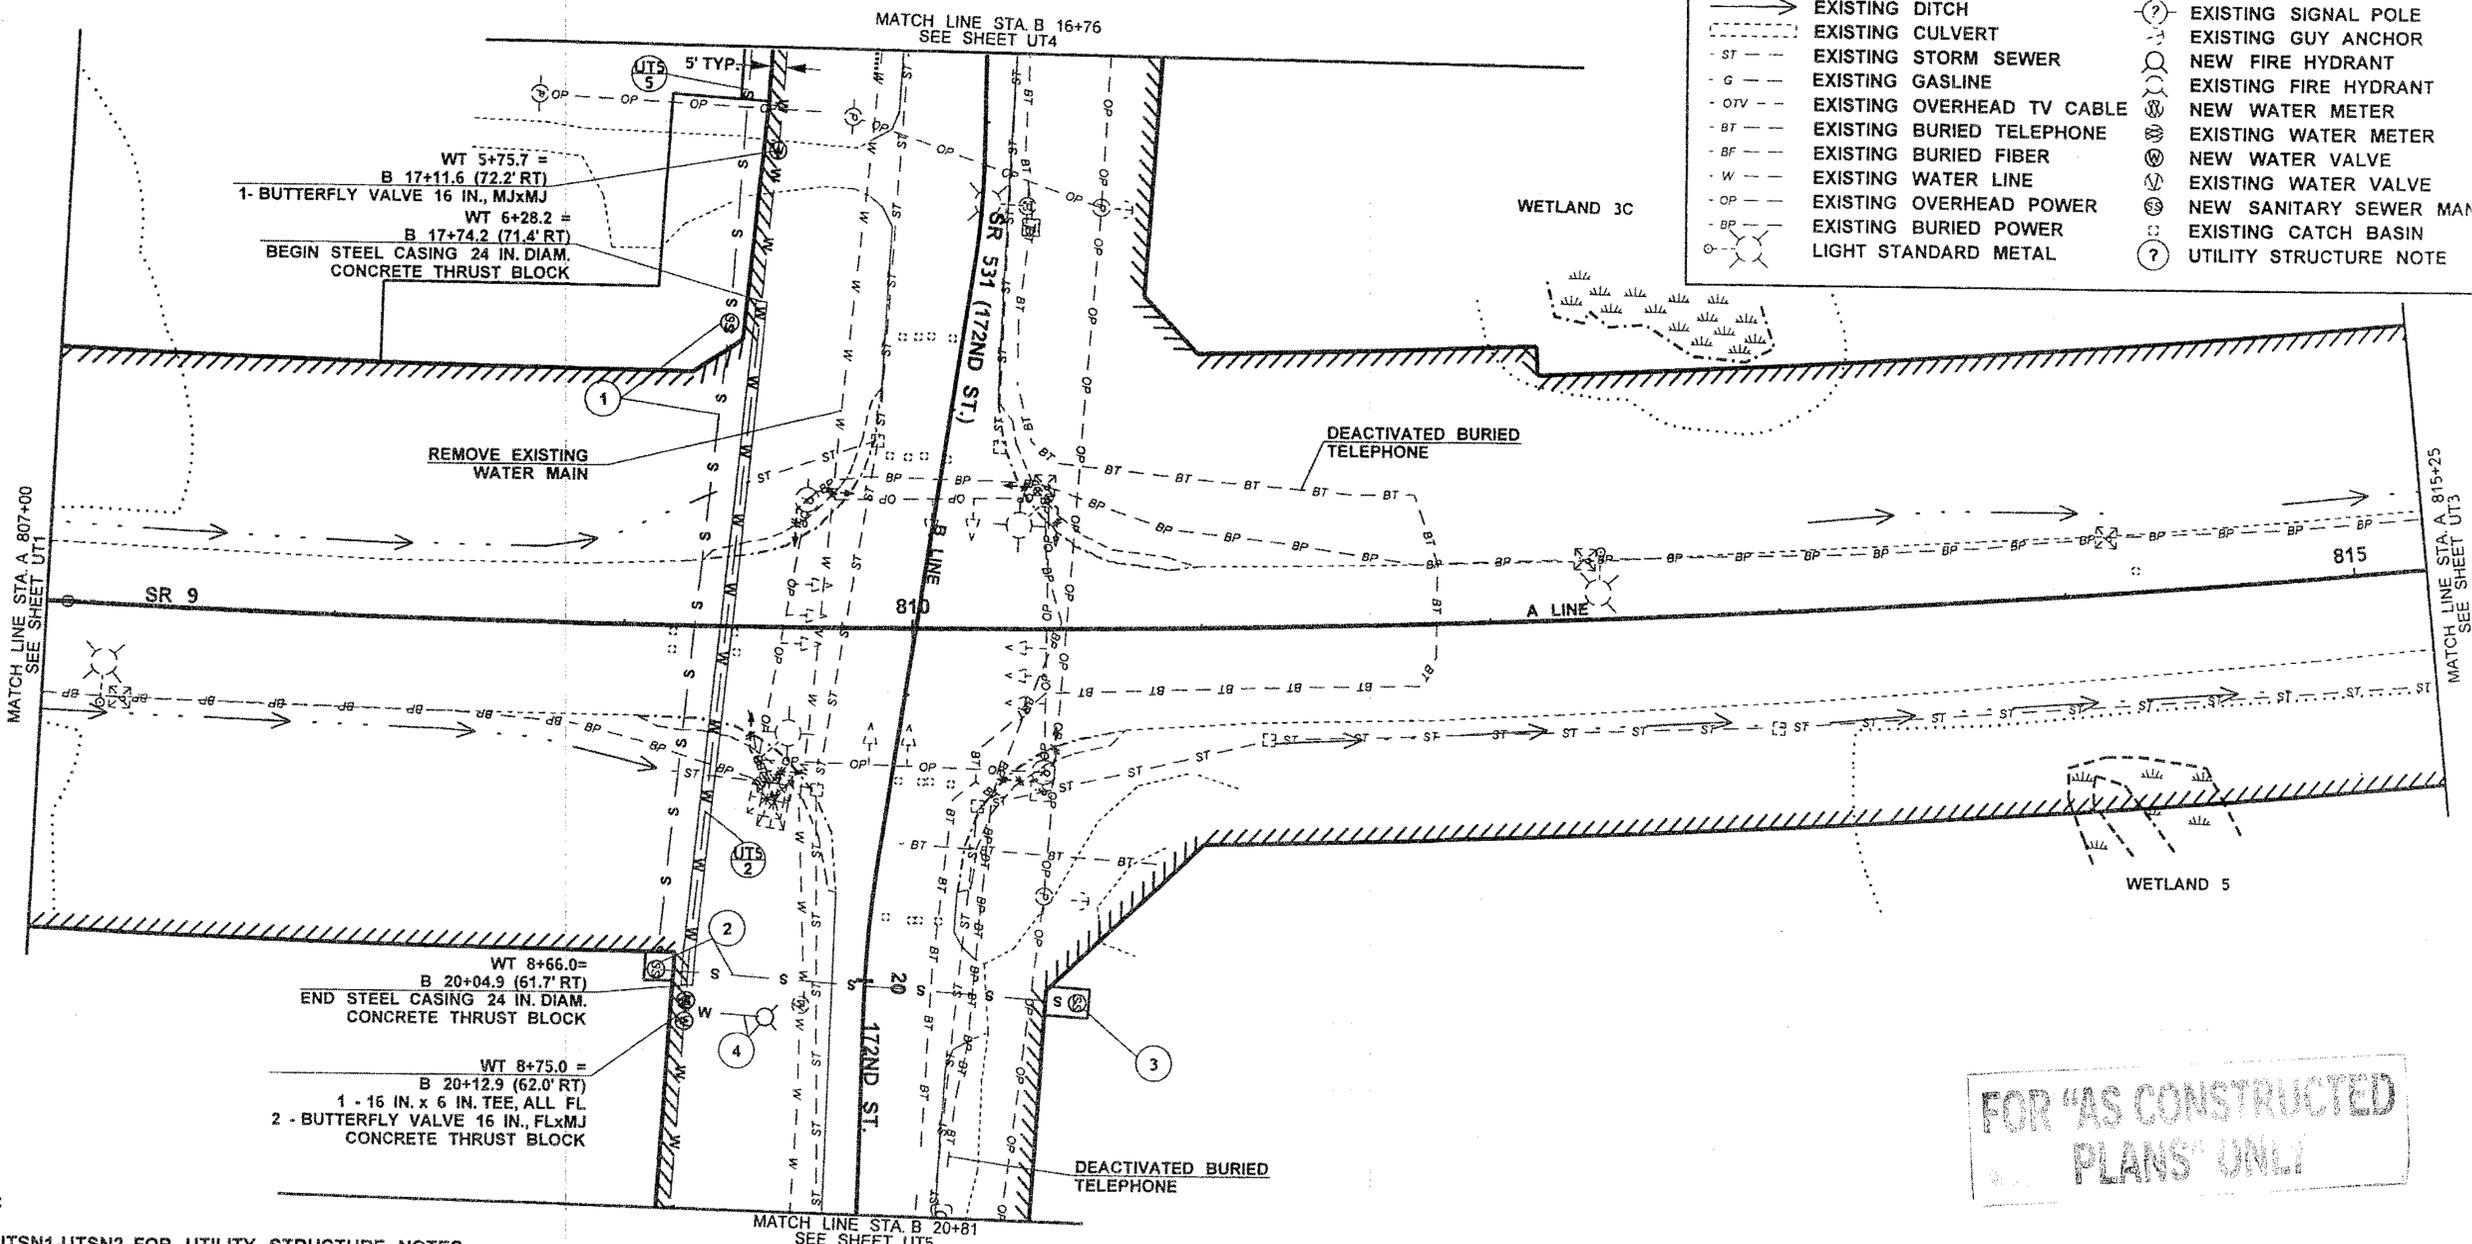

GENERAL NOTES:


1. SEE SHEETS UTSN1-UTSN2 FOR UTILITY STRUCTURE NOTES.
2. USE CONCRETE THRUST BLOCKING ON WATER MAIN IN ACCORDANCE WITH STANDARD PLAN B-90.40-00 AND B-90.50-00 AT ALL APPLICABLE LOCATIONS.
3. REFER TO DIVISION 7 OF THE SPECIAL PROVISIONS FOR ADDITIONAL WATER MAIN AND SANITARY SEWER INFORMATION.

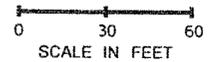

FOR "AS CONSTRUCTED PLANS" ONLY

FILE NAME	I:\Projects\XL3325_SR9_SR531_172nd_St_NE_IntiCADIPS&ESheets\XL3325_PS_UTILITIES.dgn			REGION NO.	STATE	FED.AID PROJ.NO.			SR 9 SR 531/172ND ST NE & EAGLEFIELD DR INTERSECTION IMPROVEMENT & PAVING	Plot 3
TIME	3:48:10 PM			10	WASH					UT2
DATE	9/28/2011			JOB NUMBER						SHEET 92 OF 230 SHEETS
PLOTTED BY	gunnm			CONTRACT NO.						
DESIGNED BY	M. GUNN			LOCATION NO.						
ENTERED BY	K. SOLWOLD									
CHECKED BY	J. KORESKE									
PROJ. ENGR.	S. SPAHR									
REGIONAL ADM.	L. ENG									
	REVISION	DATE	BY							

T. 31N. R. 5E. W.M.

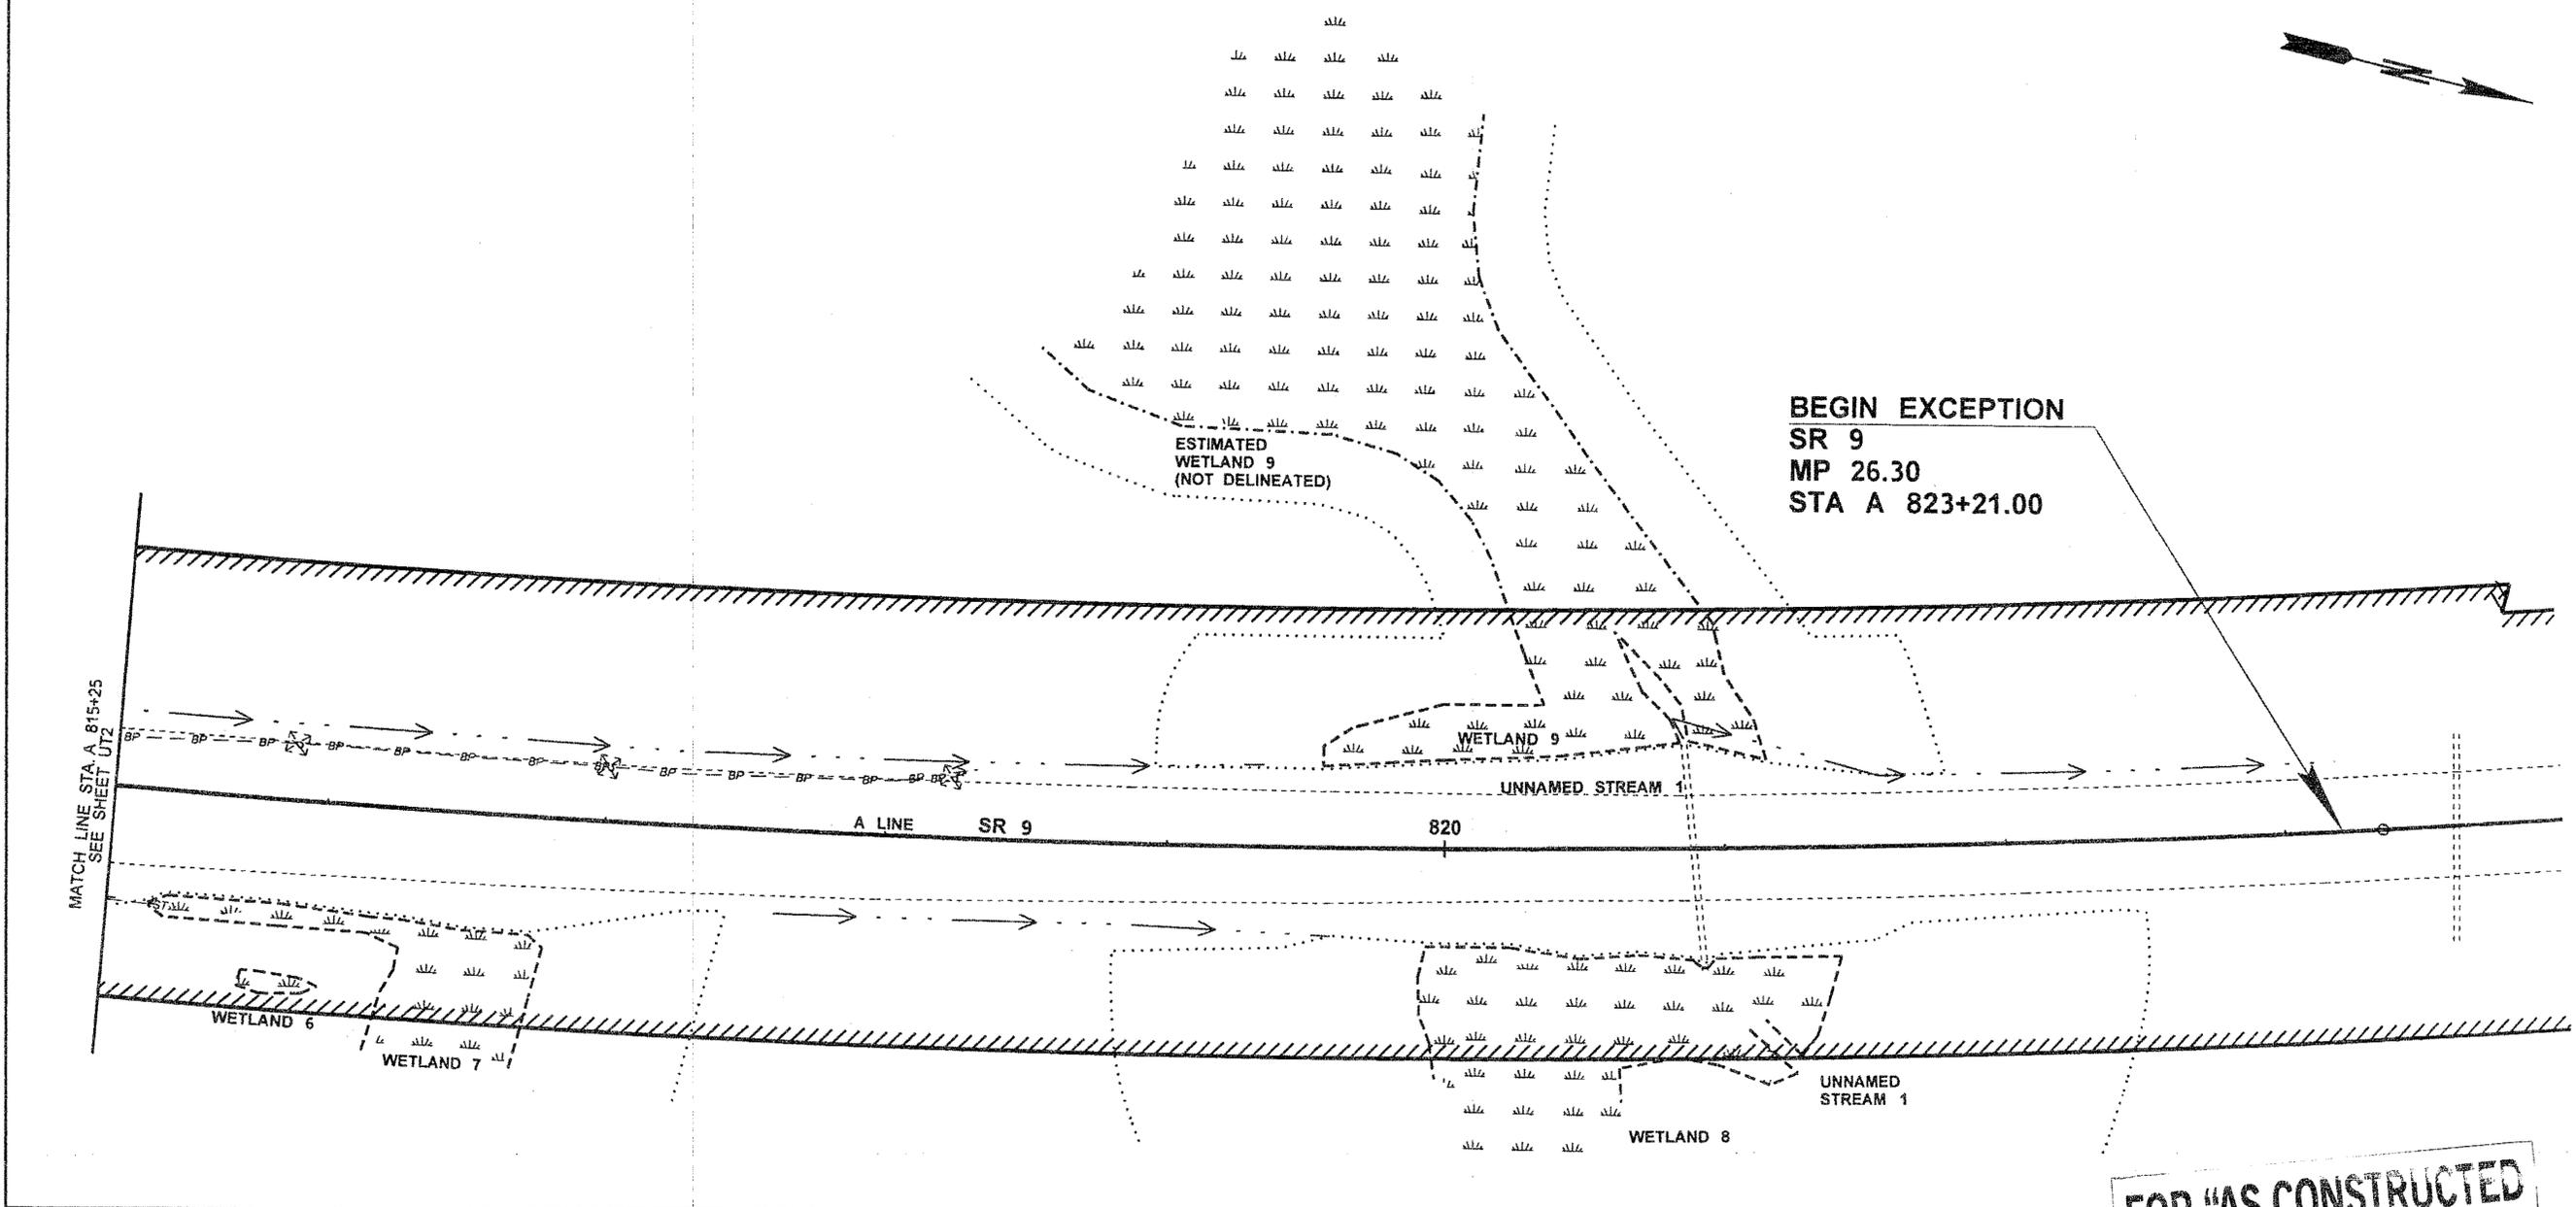


FOR "AS CONSTRUCTED PLANS" ONLY

LEGEND	
— WSDOT R/W	- G - - - EXISTING GASLINE
//// WSDOT LIMITED ACCESS	- ST - - - EXISTING STORM SEWER
- - - WETLAND BOUNDARY	- OTV - - - EXISTING OVERHEAD TV CABLE
..... WETLAND BUFFER	- BT - - - EXISTING BURIED TELEPHONE
WETLAND SYMBOL	- BF - - - EXISTING BURIED FIBER
- W - - - NEW WATER LINE	- W - - - EXISTING WATER LINE
- S - - - NEW SANITARY SEWER	- OP - - - EXISTING OVERHEAD POWER
- - - EXISTING PAVED EDGE	- BP - - - EXISTING BURIED POWER
- - - EXISTING DITCH	○ LIGHT STANDARD METAL
- - - EXISTING CULVERT	○ NEW FIRE HYDRANT
	○ EXISTING FIRE HYDRANT
	○ NEW WATER METER
	○ EXISTING WATER METER
	○ NEW WATER VALVE
	○ EXISTING WATER VALVE
	○ NEW SANITARY SEWER MANHOLE
	○ EXISTING CATCH BASIN
	○ UTILITY STRUCTURE NOTE
	□ EXISTING ELECTRICAL BOX
	□ UNKNOWN CABINET
	□ EXISTING UNKNOWN JUNCTION BOX
	□ EXISTING SIGNAL LOOP
	□ EXISTING TELEPHONE BOX
	□ EXISTING TELEPHONE POLE
	□ EXISTING POWER POLE
	□ EXISTING SIGNAL POLE
	□ EXISTING GUY ANCHOR

GENERAL NOTES:

- SEE SHEETS UTSN1-UTSN2 FOR UTILITY STRUCTURE NOTES.
- USE CONCRETE THRUST BLOCKING ON WATER MAIN IN ACCORDANCE WITH STANDARD PLAN B-90.40-00 AND B-90.50-00 AT ALL APPLICABLE LOCATIONS.
- REFER TO DIVISION 7 OF THE SPECIAL PROVISIONS FOR ADDITIONAL WATER MAIN AND SANITARY SEWER INFORMATION.

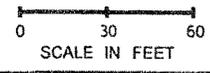


FILE NAME: I:\Projects\XL3325_SR9_SR531_172nd St_NE_In\CAD\PS&ESheets\XL3325_PS_UTILITIES.dgn		REGION NO. 10	STATE WASH	FED.AID PROJ.NO.		DATE: 9/22/11 P.E. STAMP BOX		SR 9 SR 531/172ND ST NE & EAGLEFIELD DR INTERSECTION IMPROVEMENT & PAVING	Plot 4
TIME: 1:37:52 PM	DATE: 9/22/2011	JOB NUMBER: 10A042	CONTRACT NO.	LOCATION NO.					DATE
PLOTTED BY: lamaymp	DESIGNED BY: M. GUNN	ENTERED BY: K. SOLWOLD	CHECKED BY: J. KORESKE	PROJ. ENGR.: S. SPAHR	REGIONAL ADM.: L. ENG	REVISION	DATE	BY	SHEET 93 OF 230 SHEETS
								UTILITY PLAN	

T. 31N. R. 5E. W.M.



LEGEND			
— WSDOT R/W	- G - - EXISTING GASLINE	⊗ NEW FIRE HYDRANT	⊞ EXISTING ELECTRICAL BOX
//// WSDOT LIMITED ACCESS	- ST - - EXISTING STORM SEWER	⊗ EXISTING FIRE HYDRANT	⊞ UNKNOWN CABINET
- - - WETLAND BOUNDARY	- OTV - - EXISTING OVERHEAD TV CABLE	⊗ NEW WATER METER	⊞ EXISTING UNKNOWN JUNCTION BOX
... WETLAND BUFFER	- BT - - EXISTING BURIED TELEPHONE	⊗ EXISTING WATER METER	⊞ EXISTING SIGNAL LOOP
WETLAND SYMBOL	- BF - - EXISTING BURIED FIBER	⊗ NEW WATER VALVE	⊞ EXISTING TELEPHONE BOX
- W - - NEW WATER LINE	- W - - EXISTING WATER LINE	⊗ EXISTING WATER VALVE	⊞ EXISTING TELEPHONE POLE
- S - - NEW SANITARY SEWER	- OP - - EXISTING OVERHEAD POWER	⊗ NEW SANITARY SEWER MANHOLE	⊞ EXISTING POWER POLE
--- EXISTING PAVED EDGE	- BP - - EXISTING BURIED POWER	⊗ EXISTING CATCH BASIN	⊞ EXISTING SIGNAL POLE
→ EXISTING DITCH	⊗ LIGHT STANDARD METAL	⊗ UTILITY STRUCTURE NOTE	⊞ EXISTING GUY ANCHOR
--- EXISTING CULVERT			


BEGIN CONSTRUCTION
SR 531
MP 9.73
STA B 10+53.80

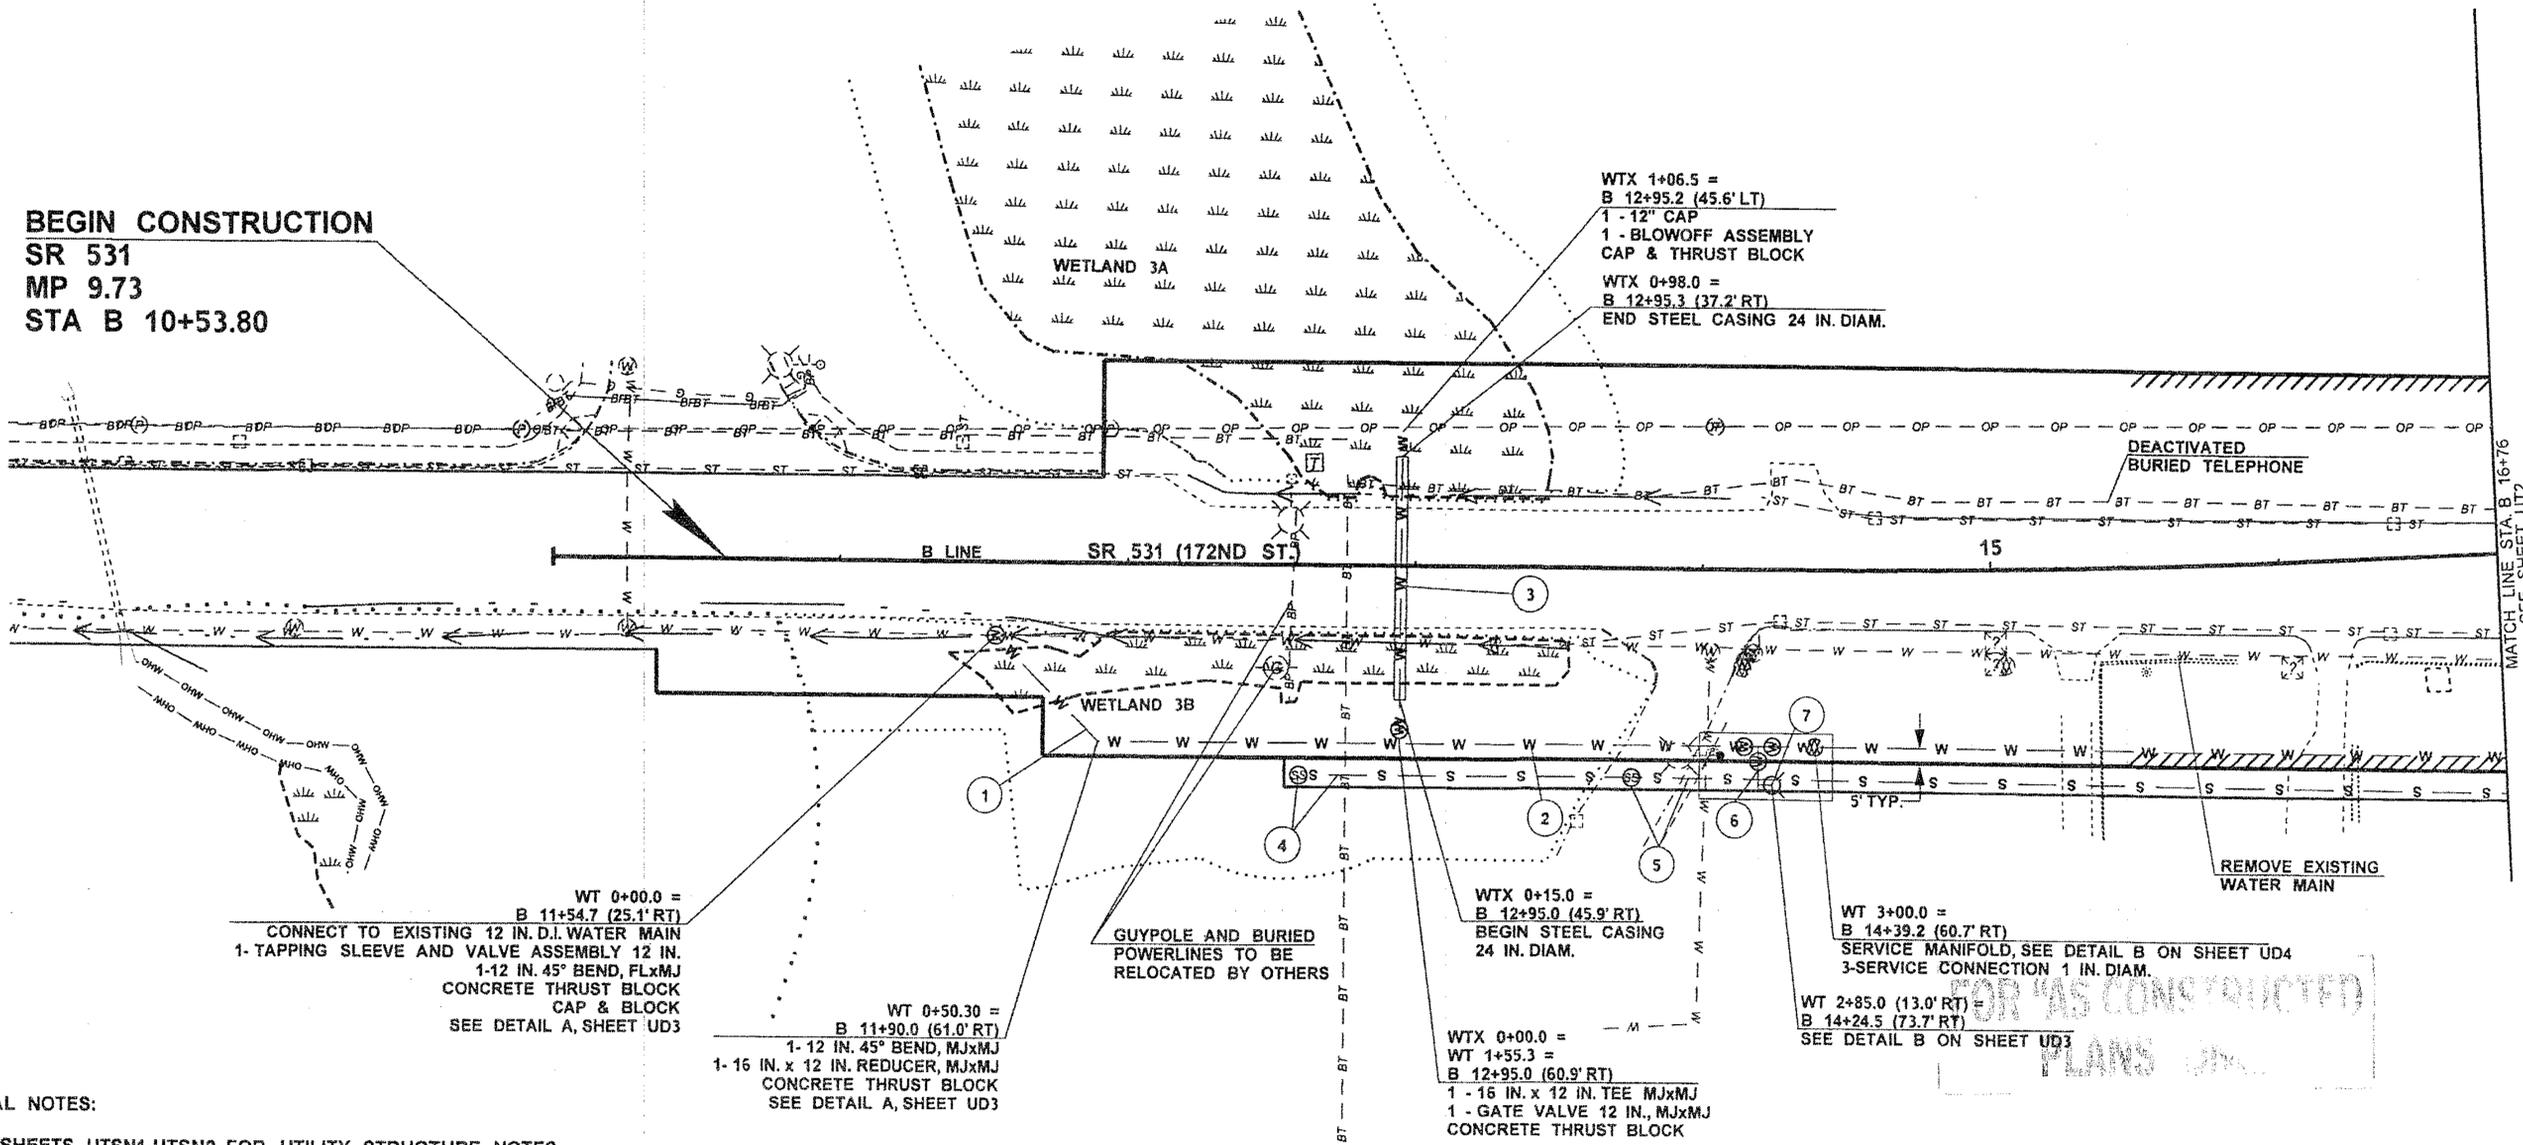

MATCH LINE STA. B 16+76
SEE SHEET UT2

GENERAL NOTES:

1. SEE SHEETS UTSN1-UTSN2 FOR UTILITY STRUCTURE NOTES.
2. USE CONCRETE THRUST BLOCKING ON WATER MAIN IN ACCORDANCE WITH STANDARD PLAN B-90.40-00 AND B-90.50-00 AT ALL APPLICABLE LOCATIONS.
3. REFER TO DIVISION 7 OF THE SPECIAL PROVISIONS FOR ADDITIONAL WATER MAIN AND SANITARY SEWER INFORMATION.

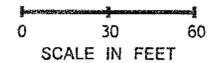


FILE NAME: I:\Projects\XL3325 SR9 SR531 172nd St NE Int\CAD\PS&ESheets\XL3325 PS UTILITIES.dgn		REGION NO. 10	STATE WASH	FED.AID PROJ.NO.			SR 9 SR 531/172ND ST NE & EAGLEFIELD DR INTERSECTION IMPROVEMENT & PAVING	Plot 5
TIME: 1:37:54 PM	DATE: 9/22/2011	JOB NUMBER: 10A042	CONTRACT NO.	LOCATION NO.				DATE: 9/22/11
PLOTTED BY: lamaymp	DESIGNED BY: M. GUNN	ENTERED BY: K. SOLWOLD	CHECKED BY: J. KORESKE	PROJ. ENGR.: S. SPAHR	REGIONAL ADM.: L. ENG	REVISION	DATE	BY
UTILITY PLAN								SHEET 94 OF 230 SHEETS

T. 31N. R. 5E. W.M.




LEGEND

—— WSDOT R/W	- G - - - EXISTING GASLINE	⊙ NEW FIRE HYDRANT	⊞ EXISTING ELECTRICAL BOX
//// WSDOT LIMITED ACCESS	- ST - - - EXISTING STORM SEWER	⊞ EXISTING FIRE HYDRANT	⊞ UNKNOWN CABINET
- - - - WETLAND BOUNDARY	- OTV - - - EXISTING OVERHEAD TV CABLE	⊞ NEW WATER METER	⊞ EXISTING UNKNOWN JUNCTION BOX
⋯ WETLAND BUFFER	- BT - - - EXISTING BURIED TELEPHONE	⊞ EXISTING WATER METER	⊞ EXISTING SIGNAL LOOP
⊞ WETLAND SYMBOL	- BF - - - EXISTING BURIED FIBER	⊞ NEW WATER VALVE	⊞ EXISTING TELEPHONE BOX
- W - - - NEW WATER LINE	- W - - - EXISTING WATER LINE	⊞ EXISTING WATER VALVE	⊞ EXISTING TELEPHONE POLE
- S - - - NEW SANITARY SEWER	- OP - - - EXISTING OVERHEAD POWER	⊞ NEW SANITARY SEWER MANHOLE	⊞ EXISTING POWER POLE
⊞ EXISTING PAVED EDGE	- BP - - - EXISTING BURIED POWER	⊞ EXISTING CATCH BASIN	⊞ EXISTING SIGNAL POLE
→ EXISTING DITCH	⊞ LIGHT STANDARD METAL	⊞ UTILITY STRUCTURE NOTE	⊞ EXISTING GUY ANCHOR
- - - - EXISTING CULVERT			

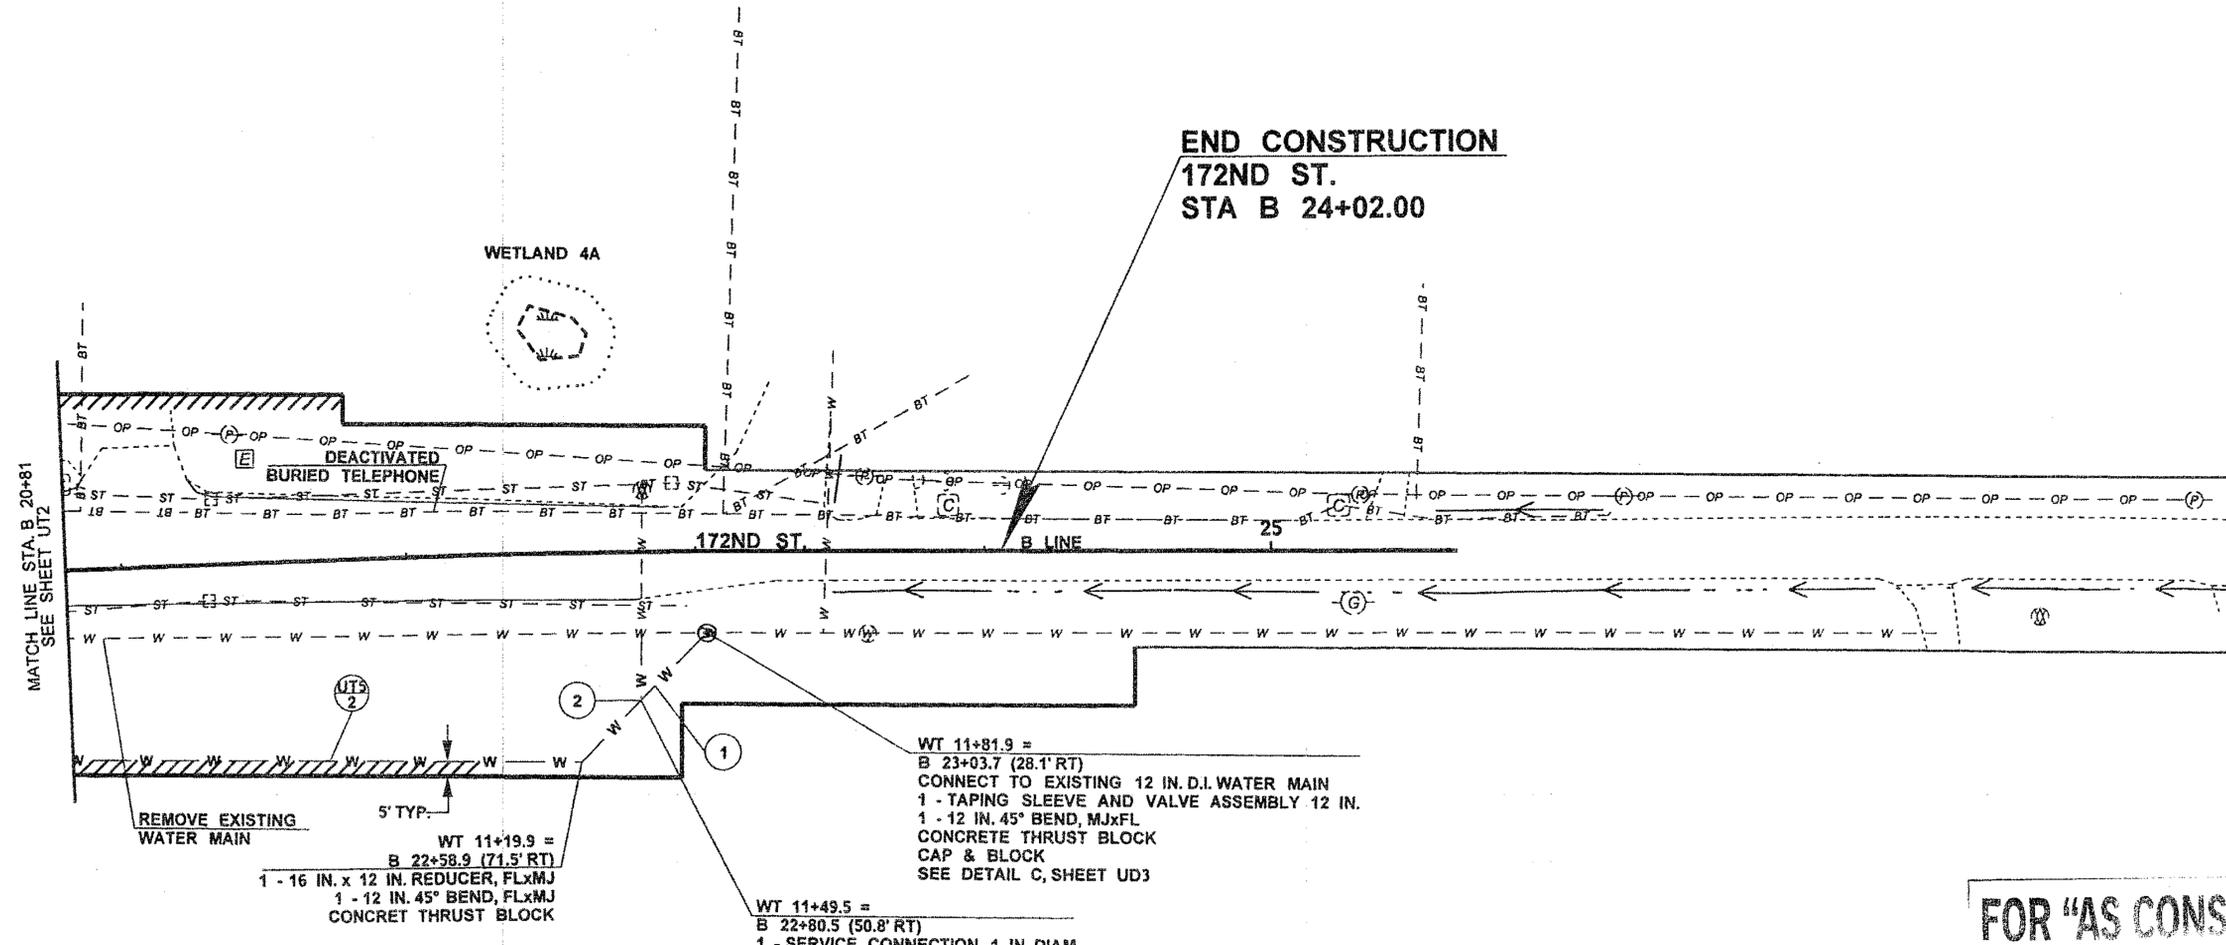

GENERAL NOTES:

1. SEE SHEETS UTSN1-UTSN2 FOR UTILITY STRUCTURE NOTES.
2. USE CONCRETE THRUST BLOCKING ON WATER MAIN IN ACCORDANCE WITH STANDARD PLAN B-90.40-00 AND B-90.50-00 AT ALL APPLICABLE LOCATIONS.
3. REFER TO DIVISION 7 OF THE SPECIAL PROVISIONS FOR ADDITIONAL WATER MAIN AND SANITARY SEWER INFORMATION.

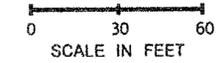



FOR "AS CONSTRUCTED PLANS" ONLY

FILE NAME	I:\Projects\XL3325 SR9 SR531 172nd St NE Int\CAD\PS&ESheets\XL3325 PS UTILITIES.dgn	REGION NO.	STATE	FED.AID PROJ.NO.			SR 9	Plot 6
TIME	1:37:55 PM	10	WASH				SR 531/172ND ST NE & EAGLEFIELD DR	UT5
DATE	9/22/2011	JOB NUMBER	10A042	LOCATION NO.		INTERSECTION IMPROVEMENT & PAVING	SHEET 95 OF 230 SHEETS	
PLOTTED BY	lamaymp	CONTRACT NO.				UTILITY PLAN		
DESIGNED BY	M.GUNN							
ENTERED BY	K.SOLWOLD							
CHECKED BY	J.KORESKE							
PROJ. ENGR.	S.SPAHR							
REGIONAL ADM.	LENG	REVISION	DATE	BY				

T. 31N. R. 5E. W.M.



LEGEND			
—— WSDOT R/W	- G - - EXISTING GASLINE	⊕ NEW FIRE HYDRANT	⊞ EXISTING ELECTRICAL BOX
//// WSDOT LIMITED ACCESS	- ST - - EXISTING STORM SEWER	⊕ EXISTING FIRE HYDRANT	⊞ UNKNOWN CABINET
- - - WETLAND BOUNDARY	- OTV - - EXISTING OVERHEAD TV CABLE	⊕ NEW WATER METER	⊞ EXISTING UNKNOWN JUNCTION BOX
⋯ WETLAND BUFFER	- BT - - EXISTING BURIED TELEPHONE	⊕ EXISTING WATER METER	⊞ EXISTING SIGNAL LOOP
⊞ WETLAND SYMBOL	- BF - - EXISTING BURIED FIBER	⊕ NEW WATER VALVE	⊞ EXISTING TELEPHONE BOX
- W - - NEW WATER LINE	- W - - EXISTING WATER LINE	⊕ EXISTING WATER VALVE	⊞ EXISTING TELEPHONE POLE
- S - - NEW SANITARY SEWER	- OP - - EXISTING OVERHEAD POWER	⊕ NEW SANITARY SEWER MANHOLE	⊞ EXISTING POWER POLE
—— EXISTING PAVED EDGE	- BP - - EXISTING BURIED POWER	⊕ EXISTING CATCH BASIN	⊞ EXISTING SIGNAL POLE
→ EXISTING DITCH	⊕ LIGHT STANDARD METAL	⊕ UTILITY STRUCTURE NOTE	⊞ EXISTING GUY ANCHOR
—— EXISTING CULVERT			

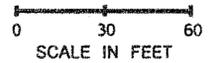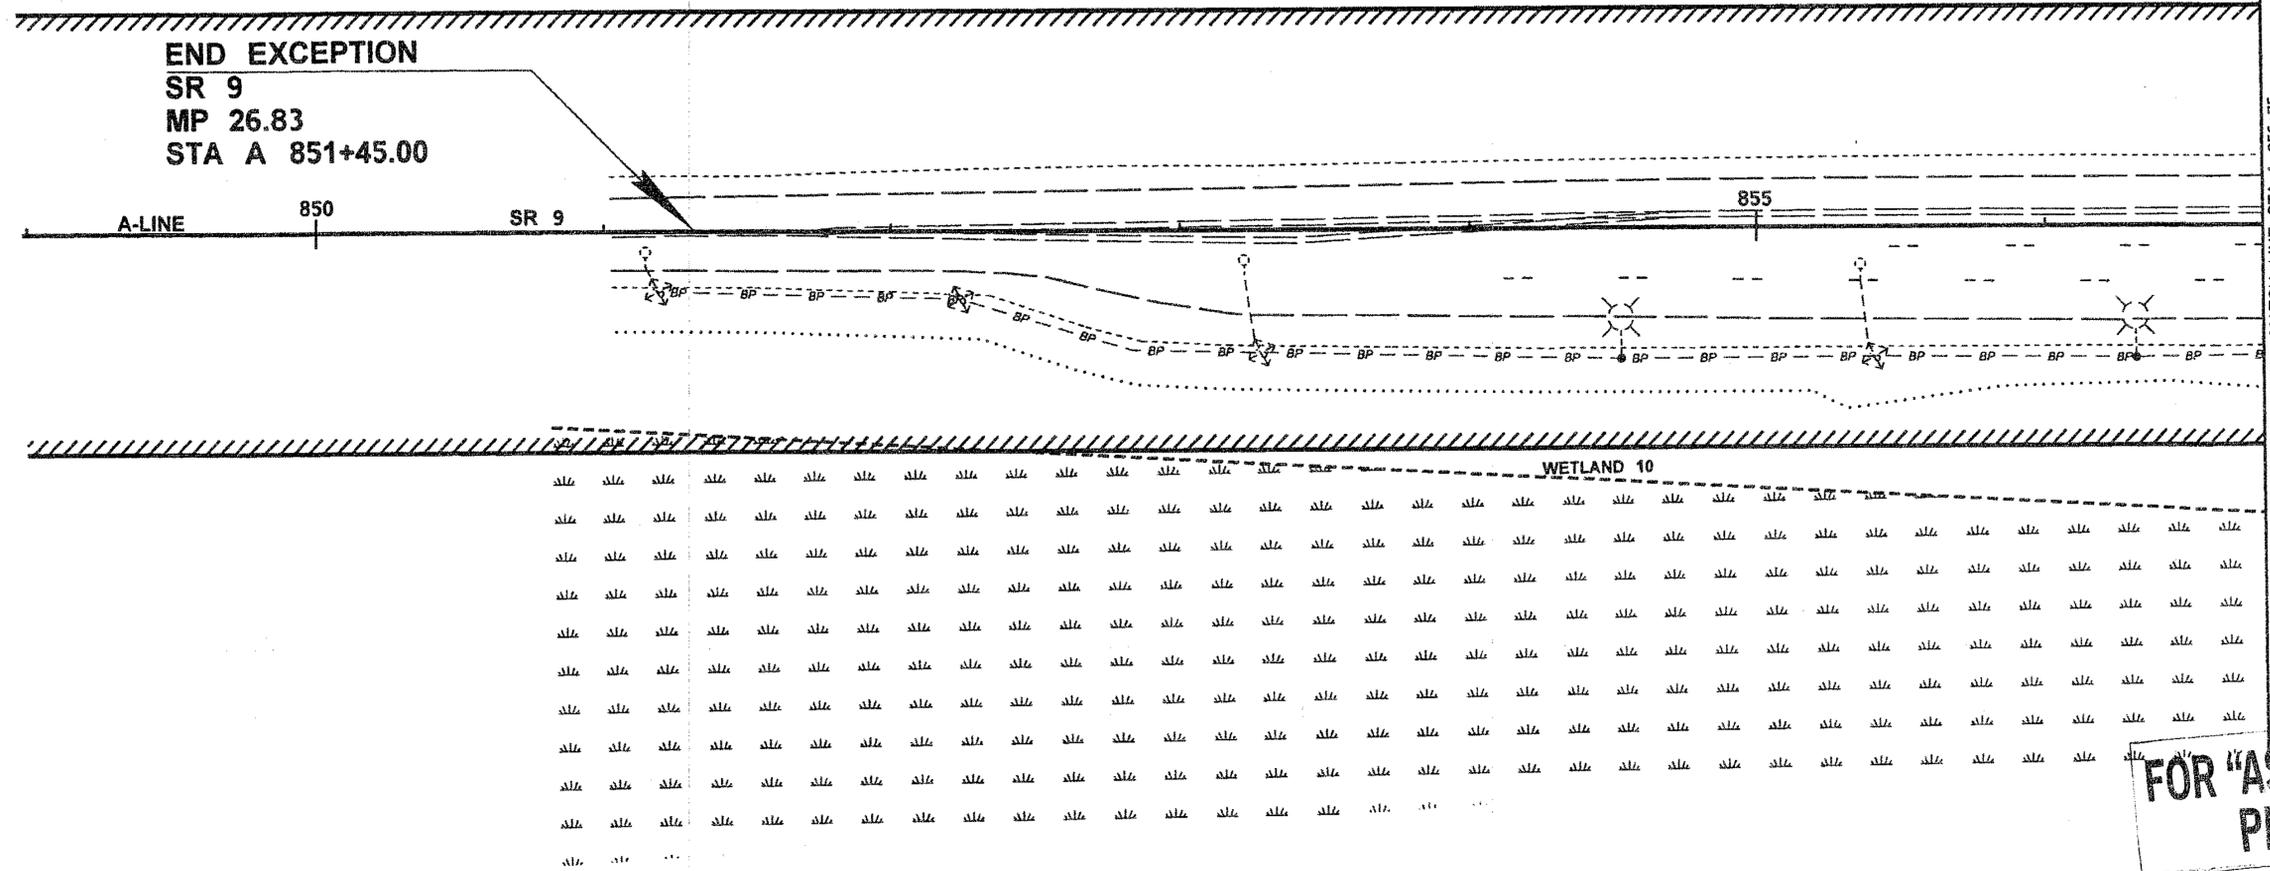


FILE NAME I:\Projects\XL3325 SR9 SR531 172nd St NE Int\CAD\PS&ESheets\XL3325 PS UTILITIES.dgn		REGION NO. 10	STATE WASH	FED.AID PROJ.NO.			SR 9 SR 531/172ND ST NE & EAGLEFIELD DR INTERSECTION IMPROVEMENT & PAVING	Plot 7
TIME 10:40:38 AM	DATE 9/22/2011	JOB NUMBER 10A042	CONTRACT NO.	LOCATION NO.				DATE 9/22/11
PLOTTED BY solwoik	DESIGNED BY M.GUNN	CHECKED BY J.KORESKE	PROJ. ENGR. S.SPAHR	REGIONAL ADM. LENG	REVISION	DATE	BY	SHEET 96 OF 230 SHEETS
UTILITY PLAN								


T. 31N. R. 5E. W.M.



LEGEND			
—— WSDOT R/W	- G - - - EXISTING GASLINE	⊗ NEW FIRE HYDRANT	⊞ EXISTING ELECTRICAL BOX
//// WSDOT LIMITED ACCESS	- ST - - - EXISTING STORM SEWER	⊗ EXISTING FIRE HYDRANT	⊞ UNKNOWN CABINET
- - - WETLAND BOUNDARY	- OTV - - - EXISTING OVERHEAD TV CABLE	⊗ NEW WATER METER	⊞ EXISTING UNKNOWN JUNCTION BOX
..... WETLAND BUFFER	- BT - - - EXISTING BURIED TELEPHONE	⊗ EXISTING WATER METER	⊞ EXISTING SIGNAL LOOP
WETLAND SYMBOL	- BF - - - EXISTING BURIED FIBER	⊗ NEW WATER VALVE	⊞ EXISTING TELEPHONE BOX
- w - - - NEW WATER LINE	- W - - - EXISTING WATER LINE	⊗ EXISTING WATER VALVE	⊞ EXISTING TELEPHONE POLE
- s - - - NEW SANITARY SEWER	- OP - - - EXISTING OVERHEAD POWER	⊗ NEW SANITARY SEWER MANHOLE	⊞ EXISTING POWER POLE
—— EXISTING PAVED EDGE	- BP - - - EXISTING BURIED POWER	⊗ EXISTING CATCH BASIN	⊞ EXISTING SIGNAL POLE
——> EXISTING DITCH	⊗ LIGHT STANDARD METAL	⊗ UTILITY STRUCTURE NOTE	⊞ EXISTING GUY ANCHOR
—— EXISTING CULVERT			

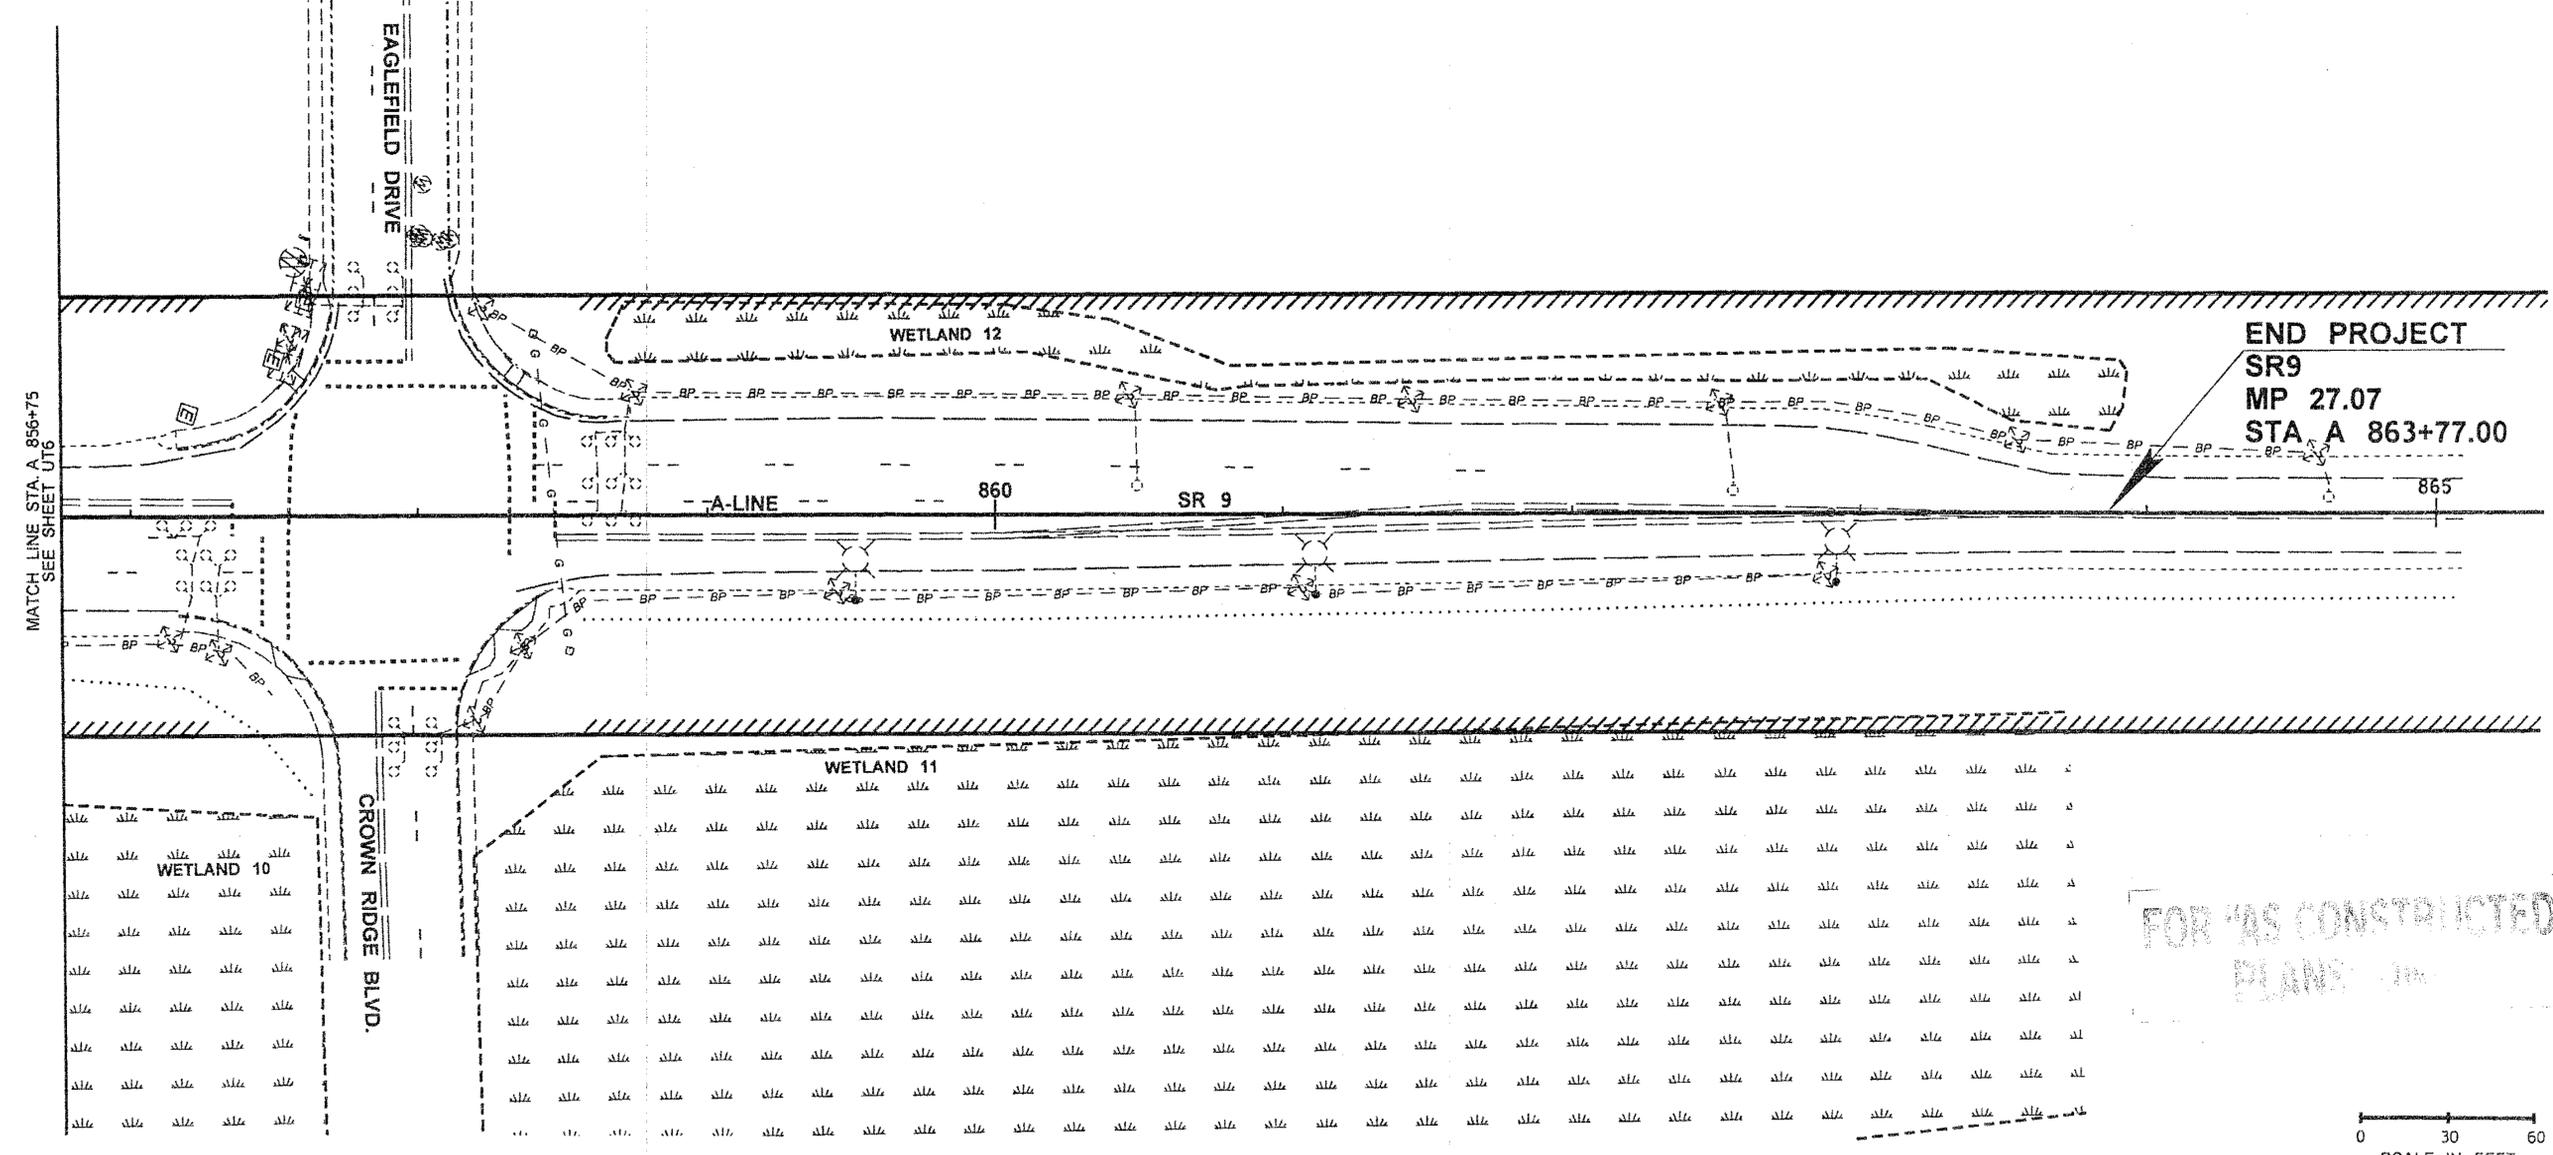


FOR 'AS CONSTRUCTED' PLANS

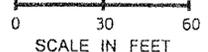

FILE NAME I:\Projects\XL3325_SR9_SR531_172nd_St_NE_Int\CADIPS&ESheets\XL3325_PS_UTILITIES.dgn		REGION NO. STATE		FED.AID PROJ.NO.				SR 9 SR 531/172ND ST NE & EAGLEFIELD DR INTERSECTION IMPROVEMENT & PAVING	Plot 8 PLAN REF NO UT7
TIME 1:59:32 PM	DATE 9/27/2011	10 WASH							
PLOTTED BY lamaymp	DESIGNED BY M.GUNN	JOB NUMBER 10A042	CONTRACT NO.	LOCATION NO.	DATE 9/28/11	P.E. STAMP BOX	DATE	UTILITY PLAN	
ENTERED BY K.SOLWOLD	CHECKED BY J.KORESKE	REVISION	DATE	BY					
PROJ. ENGR. S. SPAHR	REGIONAL ADM. L.ENG								




WATERLINE PROFILE (WT - LINE)

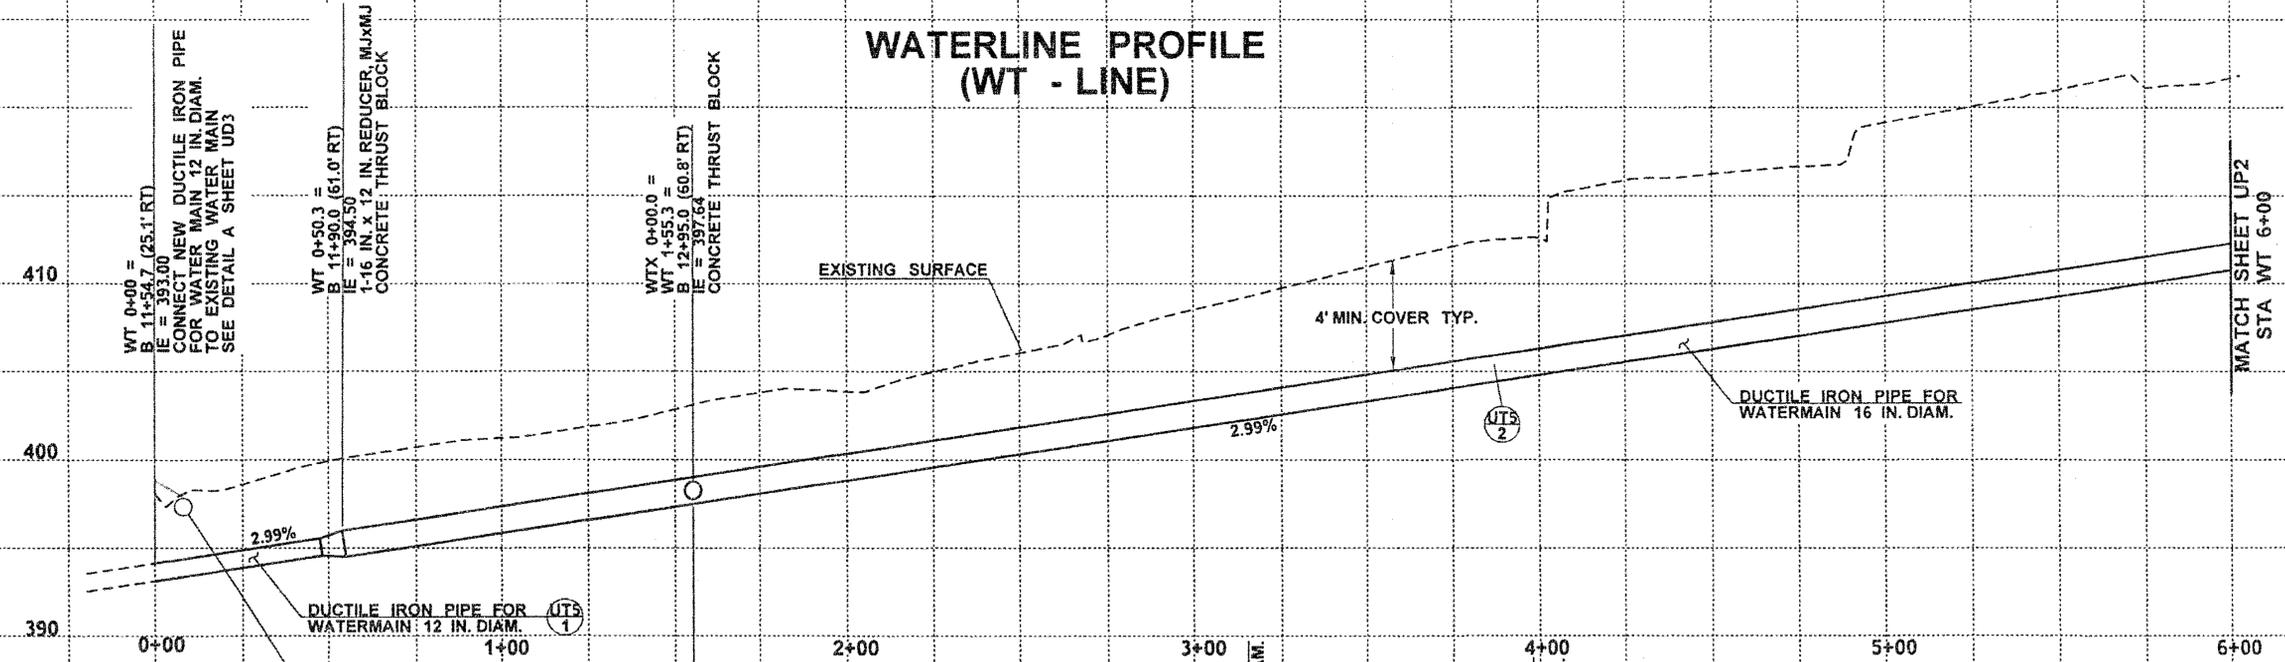


GENERAL NOTES:

1. INVERT ELEVATIONS OF WATERLINE MAY BE ADJUSTED TO MEET MINIMUM VERTICAL CLEARANCE REQUIREMENTS.
2. DEFLECT PIPE JOINTS AS NECESSARY. PIPE DEFLECTION MAY NOT EXCEED 1/2 OF THE MANUFACTURER'S ALLOWABLE DEFLECTION.
3. INVERT ELEVATIONS AT CONNECTIONS HAVE NOT BEEN VERIFIED. CONTRACTOR SHALL VERIFY THE ACTUAL INVERT AND ADJUST ADJACENT SEGMENTS OF NEW PIPE AS NECESSARY.
4. USE CONCRETE THRUST BLOCKING ON WATER MAIN IN ACCORDANCE WITH STANDARD PLANS B-90.40-00 AND B-90.50-00 AT ALL APPLICABLE LOCATIONS.

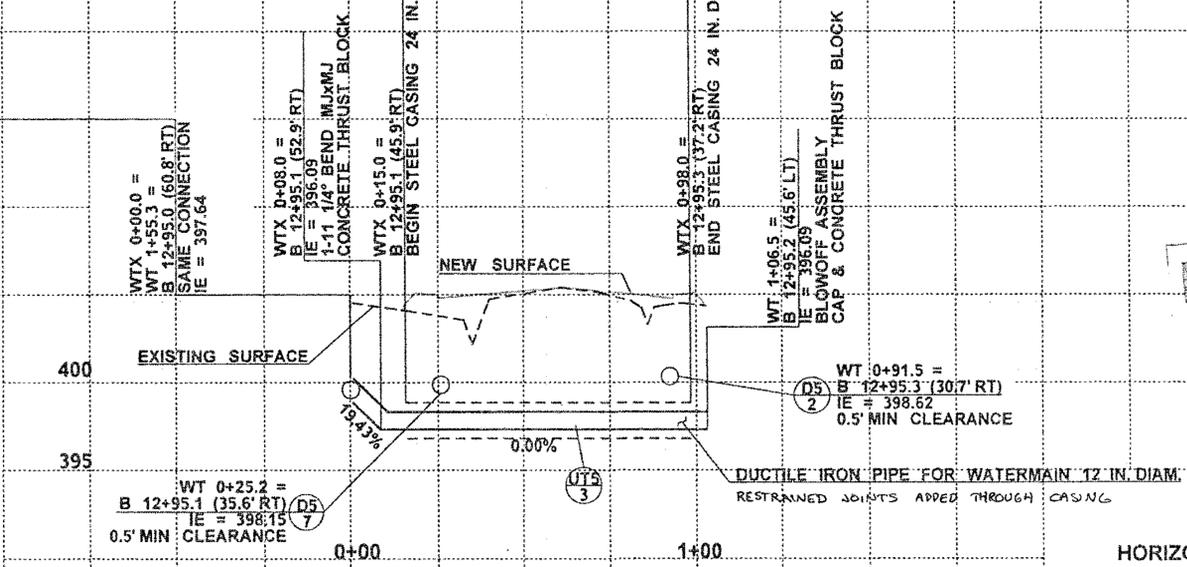

WATERLINE PROFILE (WTX - LINE)

FOR "AS CONSTRUCTED" PLANS

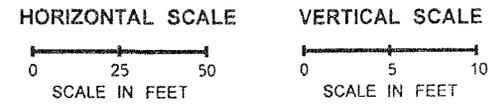


FILE NAME	I:\Projects\XL3325_SR9_SR531_172nd_St_NE_IntCAD\PS&ESheets\XL3325_PS_UTILITIES.dgn		
TIME	10:01:23 AM		
DATE	9/19/2011		
PLOTTED BY	gunnm		
DESIGNED BY	M. LAMAY		
ENTERED BY	K. SOLWOLD		
CHECKED BY	J. KORESKI		
PROJ. ENGR.	S. SPAHR		
REGIONAL ADM.	L. ENG		
REVISION	DATE	BY	

REGION NO.	STATE	FED.AID PROJ.NO.
10	WASH	
JOB NUMBER	CONTRACT NO.	LOCATION NO.
10A042		



SR 9
SR 531/172ND ST NE & EAGLEFIELD DR
INTERSECTION IMPROVEMENT & PAVING
UTILITY PROFILE


Plot 21
PLAN REF. NO.
UP1
SHEET 98 OF 230 SHEETS

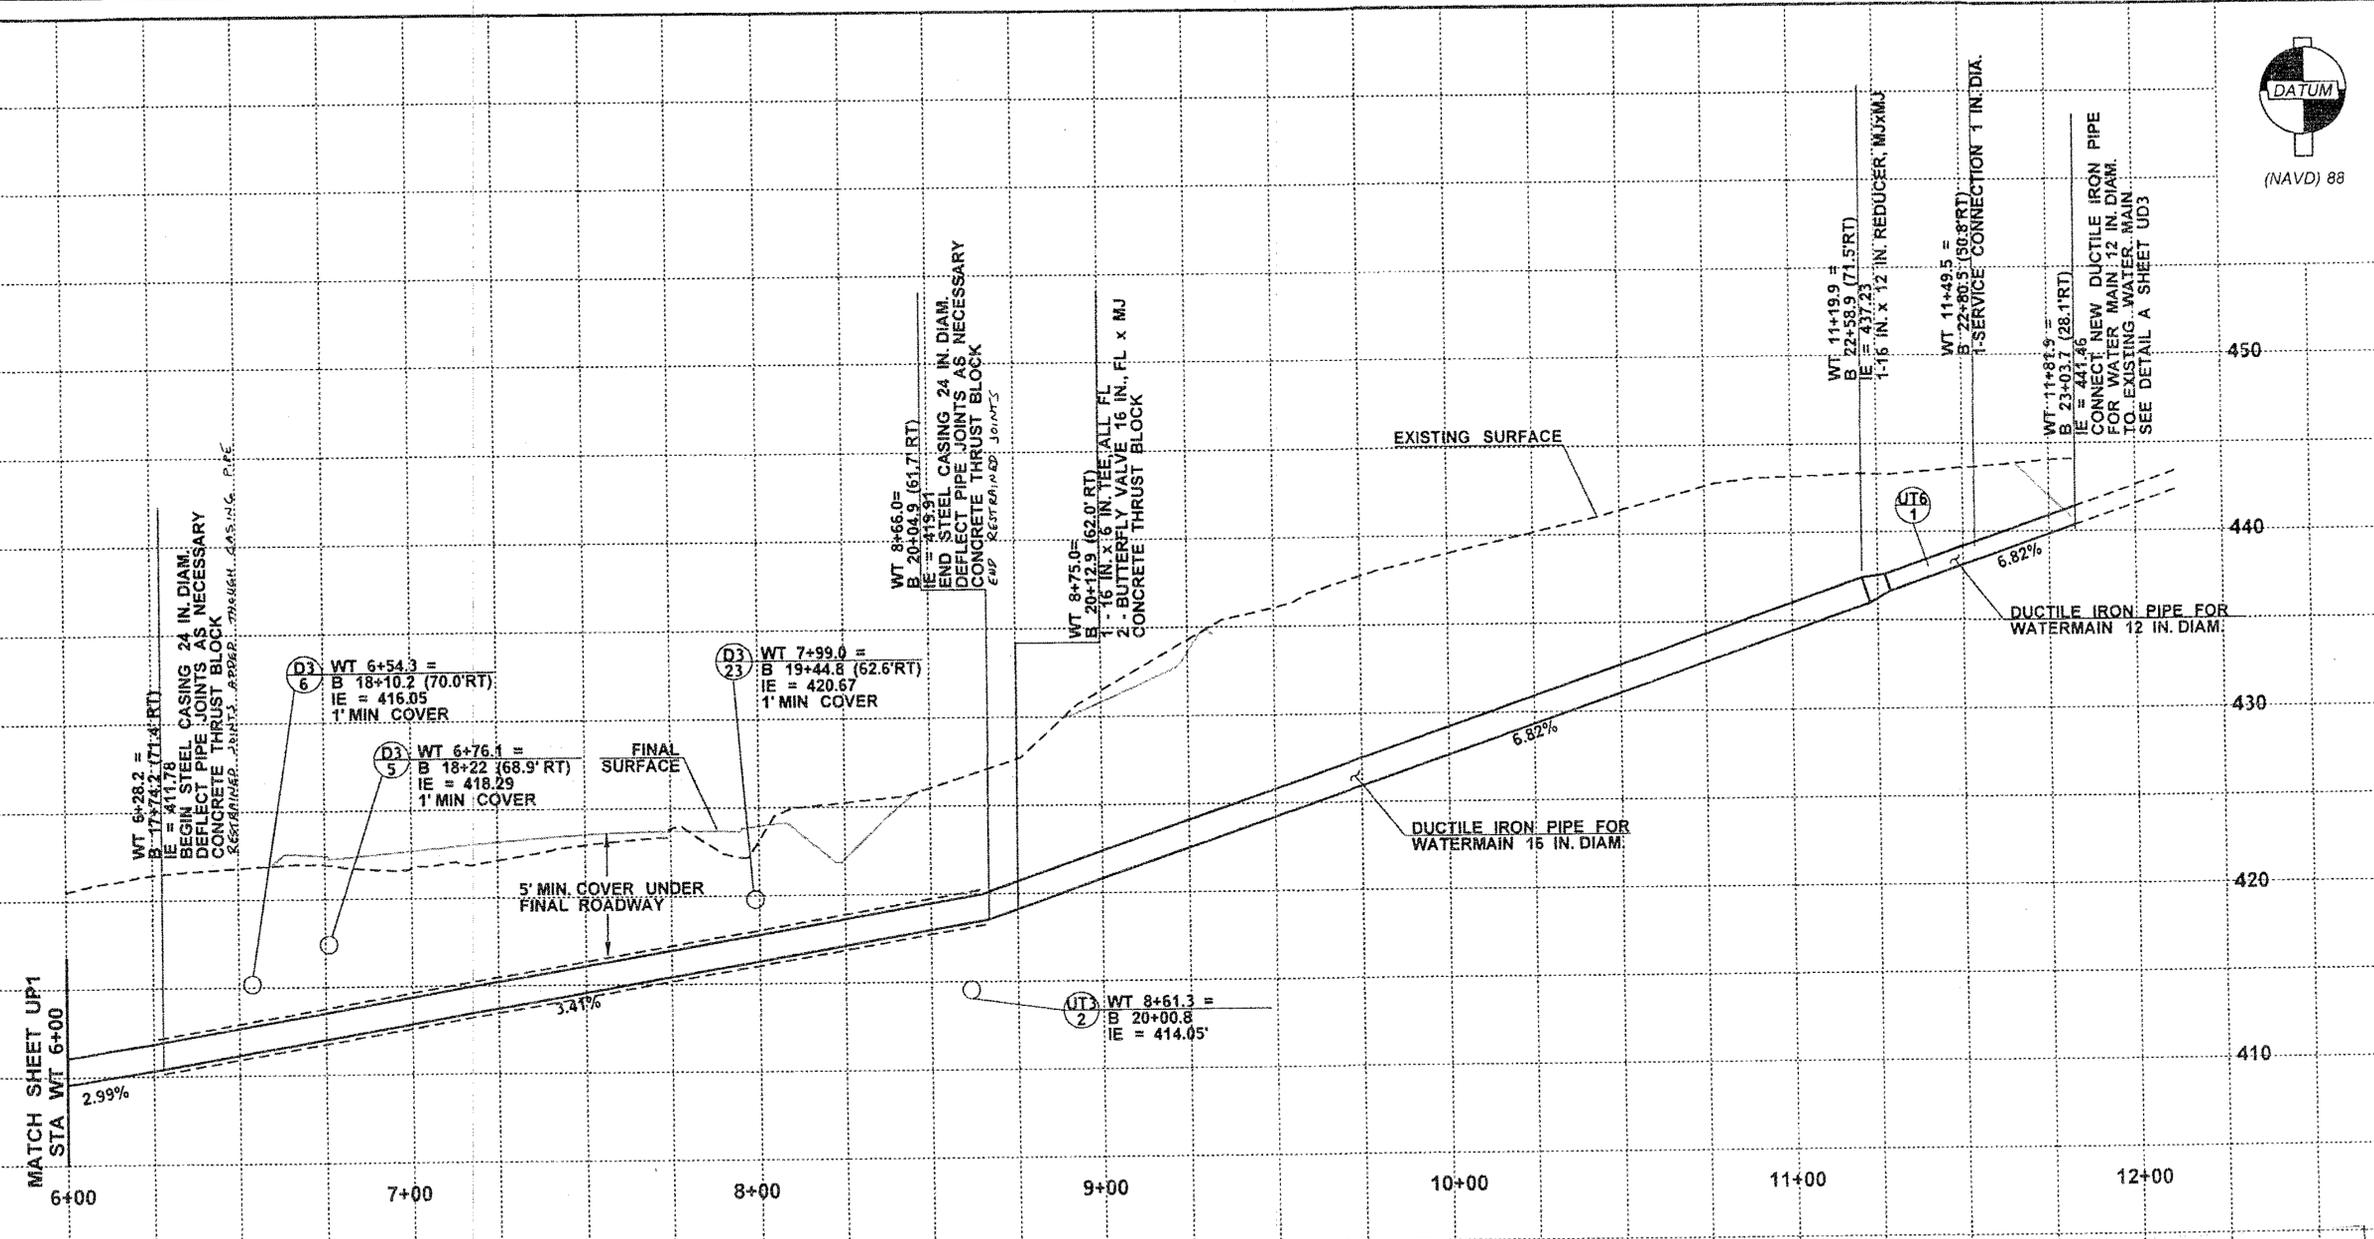

WATERLINE PROFILE (WT - LINE)

FOR "AS CONSTRUCTED" PLANS ONLY

- GENERAL NOTES:**
1. INVERT ELEVATIONS OF WATERLINE MAY BE ADJUSTED TO MEET MINIMUM VERTICAL CLEARANCE REQUIREMENTS.
 2. DEFLECT PIPE JOINTS AS NECESSARY. PIPE DEFLECTION MAY NOT EXCEED 1/2 OF THE MANUFACTURER'S ALLOWABLE DEFLECTION.
 3. INVERT ELEVATIONS AT CONNECTIONS HAVE NOT BEEN VERIFIED. CONTRACTOR SHALL VERIFY THE ACTUAL INVERT AND ADJUST ADJACENT SEGMENTS OF NEW PIPE AS NECESSARY.
 4. USE CONCRETE THRUST BLOCKING ON WATER MAIN IN ACCORDANCE WITH STANDARD PLANS B-90.40-00 AND B-90.50-00 AT ALL APPLICABLE LOCATIONS.

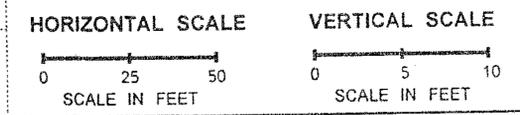

FILE NAME	I:\Projects\XL3325 SR9 SR531 172nd St NE IntCADIPS&ESheets\XL3325 PS UTILITIES.dgn		
TIME	10:01:26 AM		
DATE	9/19/2011		
PLOTTED BY	gunnm		
DESIGNED BY	M. LAMAY		
ENTERED BY	K. SOLWOLD		
CHECKED BY	J. KORESKI		
PROJ. ENGR.	S. SPAHR		
REGIONAL ADM.	L. ENG		
REVISION	DATE	BY	

REGION NO.	STATE	FED.AID PROJ.NO.
10	WASH	
JOB NUMBER	CONTRACT NO.	LOCATION NO.
10A042		

SEAL
 STATE OF WASHINGTON
 PROFESSIONAL ENGINEER
 DATE 9/22/11
 P.E. STAMP BOX

Washington State
 Department of Transportation


SR 9
SR 531/172ND ST NE & EAGLEFIELD DR
INTERSECTION IMPROVEMENT & PAVING
UTILITY PROFILE

Plot 22
 PLAN REF. NO. UP2
 SHEET 99 OF 230 SHEETS




(NAVD) 88

UTILITY CROSSING DATA TABLE			
STRUCTURE #	B STA.	SS STATION	UTILITY I.E. AT CROSSING
D3 27	20+02.4(23.3' LT)	0+51.1	421.05
D3 24	20+01.5(23.3' RT)	0+97.7	422.95
UTS 2	20+00.9(61.6' RT)	1+36.2	419.10
D3 23	19+39.5(73.5' RT)	2+15.6	420.50
D3 4	18+27.6(79.1' RT)	3+27.6	418.65
D3 6	18+03.5(80.3' RT)	3+51.7	416.18

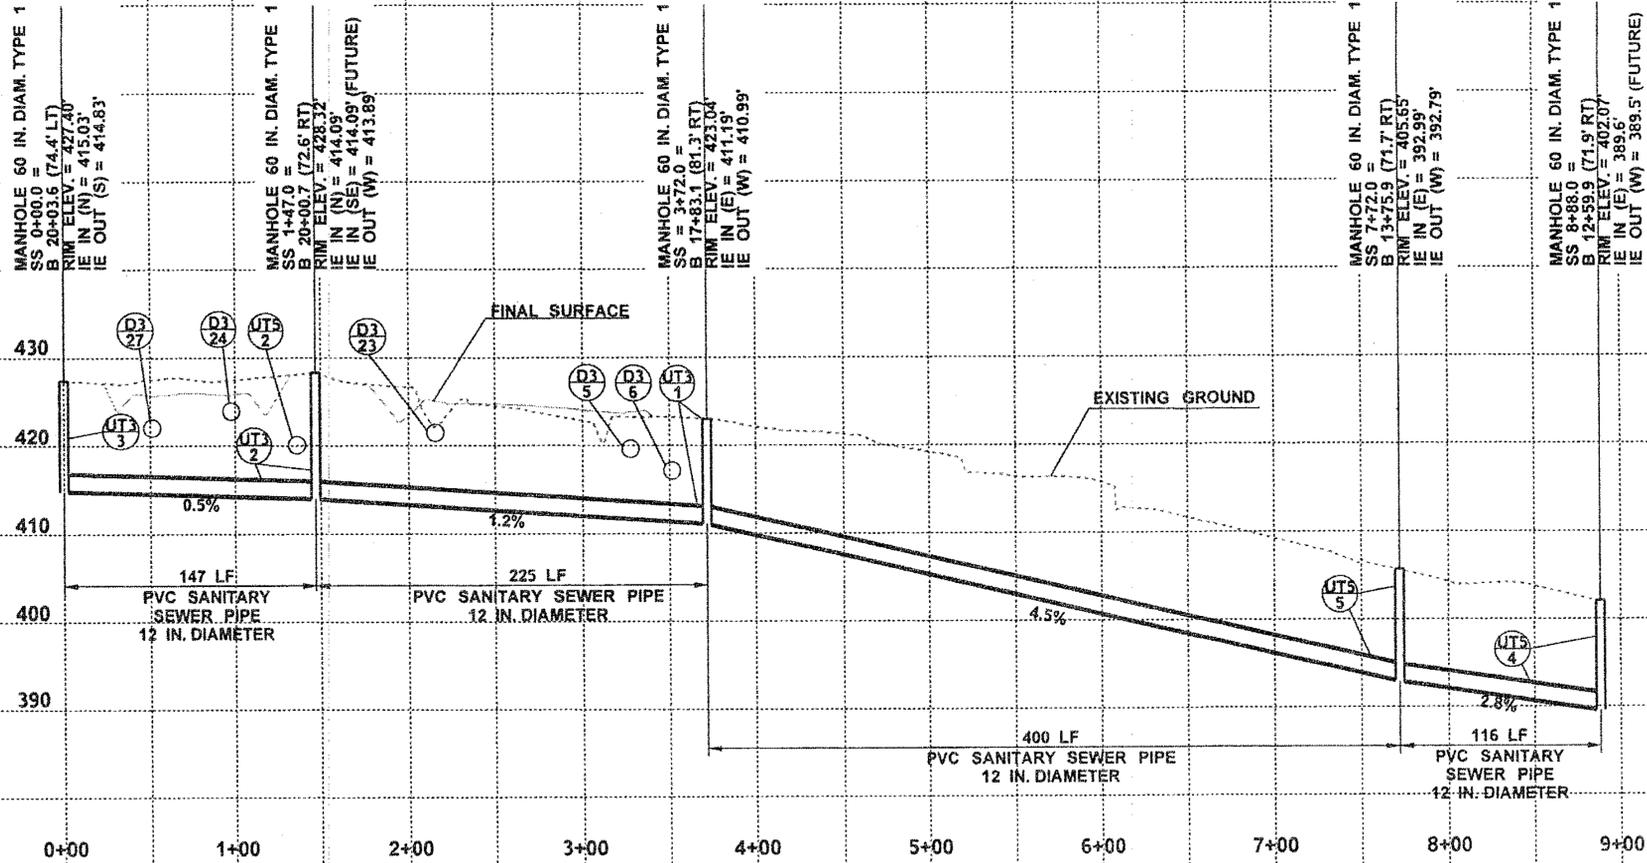

SANITARY SEWER PROFILE (SS)

FOR 'AS CONSTRUCTED'
PLANS

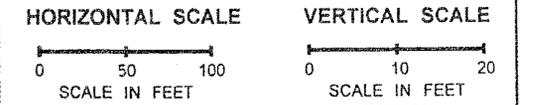


FILE NAME	I:\Projects\XL3325 SR9 SR531 172nd St NE Int\CAD\PS&ESheets\XL3325_PS_UTILITIES.dgn		
TIME	11:31:25 AM		
DATE	9/21/2011		
PLOTTED BY	lamaymp		
DESIGNED BY	M. LAMAY		
ENTERED BY	K. SOLWOLD		
CHECKED BY	J. KORESKI		
PROJ. ENGR.	S. SPAHR		
REGIONAL ADM.	L. ENG	REVISION	DATE BY

REGION NO.	STATE	FED.AID PROJ.NO.
10	WASH	
JOB NUMBER	10A042	
CONTRACT NO.	LOCATION NO.	



SR 9
SR 531/172ND ST NE & EAGLEFIELD DR
INTERSECTION IMPROVEMENT & PAVING
UTILITY PROFILE


Plot 23
PLAN REF. NO.
UP3
SHEET 100 OF 230 SHEETS

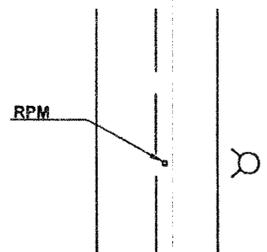

ON-ROAD HYDRANT MARKER DETAIL
 OFFSET RAISED PAVEMENT MARKER (RPM) TO INDICATE WHICH SIDE OF STREET HYDRANT IS ON. MARKER TO BE PLACED 4" TO 6" OFF OF CENTERLINE. ALL COSTS FOR MARKER SHALL BE INCLUDED IN THE HYDRANT ASSEMBLY.


NOTE:
 1. RPM SHALL BE TYPE 2 AND BLUE IN COLOR.

NTS

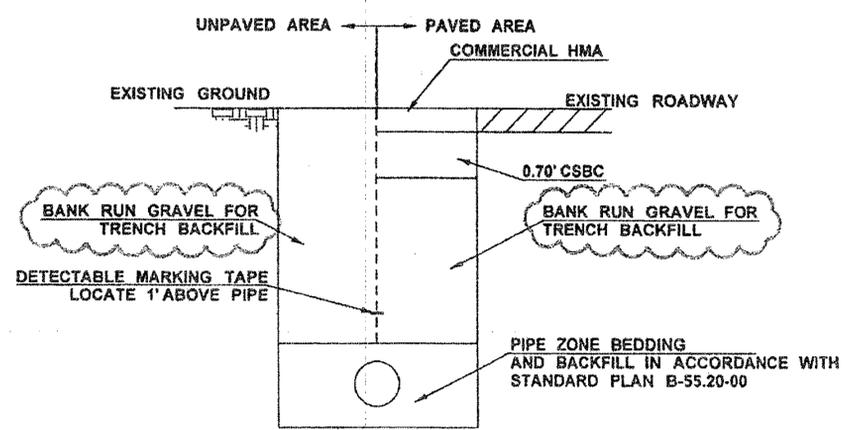


**TYPICAL TRENCH DETAIL
 UNPAVED AND PAVED AREAS**

NTS

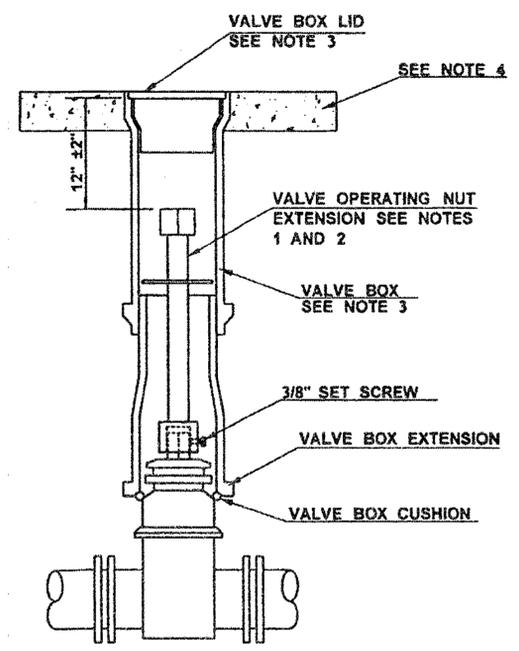

VALVE BOX AND EXTENSION

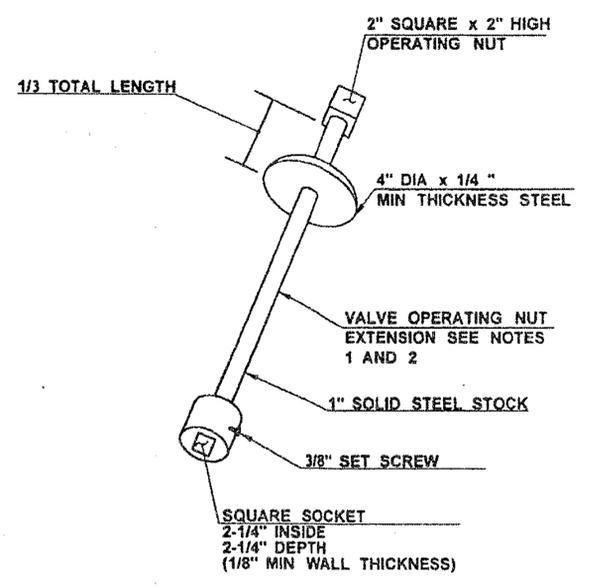


VALVE OPERATING NUT EXTENSION

**FOR "AS CONSTRUCTED
 PLANS USE"**


- NOTES:
- VALVE OPERATING NUT EXTENSIONS ARE REQUIRED WHEN THE VALVE NUT IS MORE THAN THREE (3) FEET BELOW FINISHED GRADE. EXTENSIONS ARE TO BE A MINIMUM OF ONE (1) FOOT LONG ONLY ONE EXTENSION WILL BE ALLOWED PER VALVE.
 - ALL VALVE OPERATING NUT EXTENSIONS ARE TO BE MADE OF STEEL, SIZED AS NOTED, AND PAINTED WITH TWO (2) COATS OF METAL PAINT.
 - VALVE BOXES SHALL BE CAST IRON, TWO PIECE UNITS, DESIGNED WITH DEEP SKIRT (2") LIDS W/LUGS.
 - 4" THICK CONCRETE PAD AROUND VALVE BOXES OUTSIDE OF PAVED AREAS. 2'x2' SQUARE AROUND SINGLE VALVE BOXES AND 4'x4' AROUND MULTIPLE VALVE BOXES.

NTS

FILE NAME: I:\Projects\XL3325_SR9_SR531_172nd St NE Int\CAD\PS&ESheets\XL3325_PS_UTILITIES.dgn				REGION NO. 10		STATE WASH		FED.AID PROJ.NO.		Plot 3	
TIME: 10:51:00 AM	AD1 - DETAIL MODIFICATION			DATE: 10/25/2011	SMS					PLAN REF NO. UD1	
DATE: 10/26/2011										SHEET 101 OF 230 SHEETS	
PLOTTED BY: lamaymp											
DESIGNED BY: M. LAMAY											
ENTERED BY: K. SOLWOLD											
CHECKED BY: J. KORESKE											
PROJ. ENGR. S. SPAHR											
REGIONAL ADM. L. ENG											
REVISION	DATE	BY									

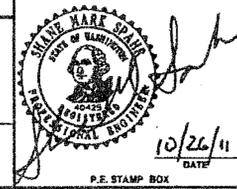

SR 9
 SR 531/172ND ST NE & EAGLEFIELD DR
 INTERSECTION IMPROVEMENT & PAVING
 UTILITY DETAILS

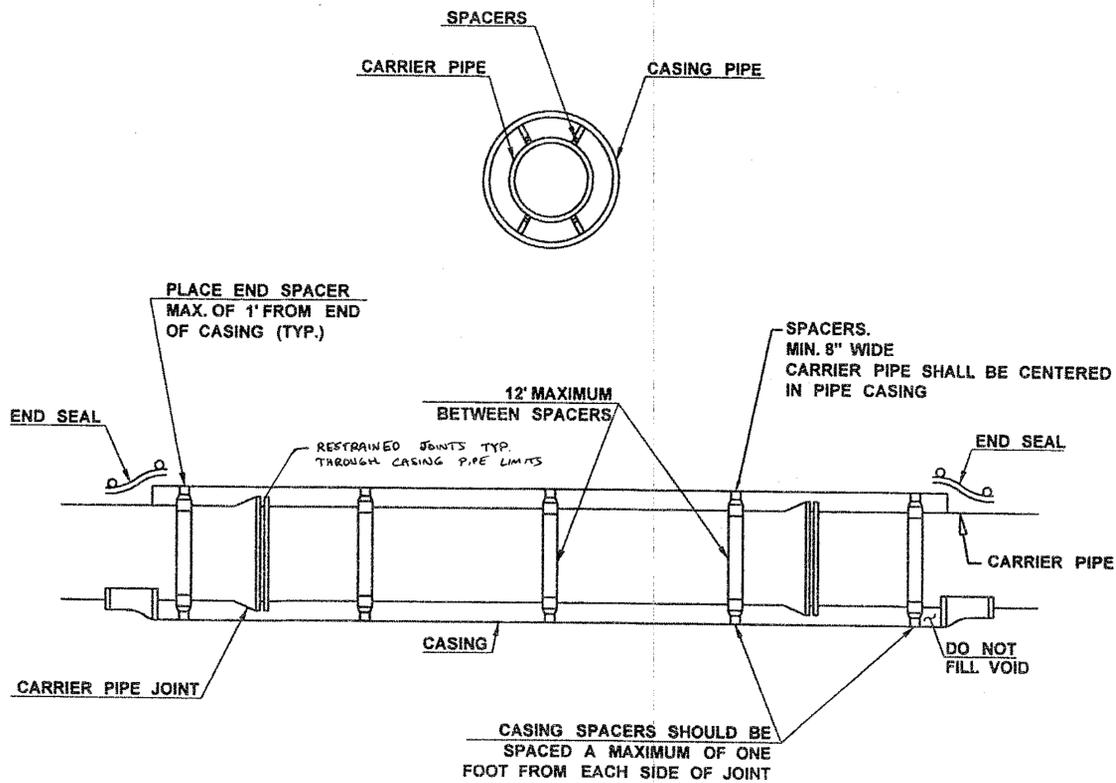


STEEL CASING

NOTES:

1. ANY PROPOSED VARIATION TO THIS DETAIL SHALL BE SUBMITTED TO THE ENGINEER FOR REVIEW AND APPROVAL.
2. CASING SHALL BE SEALED AT BOTH ENDS.
3. PIPE CASINGS SHALL EXTEND 6 FEET BEYOND THE EDGE OF PAVEMENT. IF THE RIGHT-OF-WAY IS NOT OWNED BY CITY OF ARLINGTON, PIPE CASING SHALL EXTEND 6 FEET BEYOND RIGHT-OF-WAY.

NTS

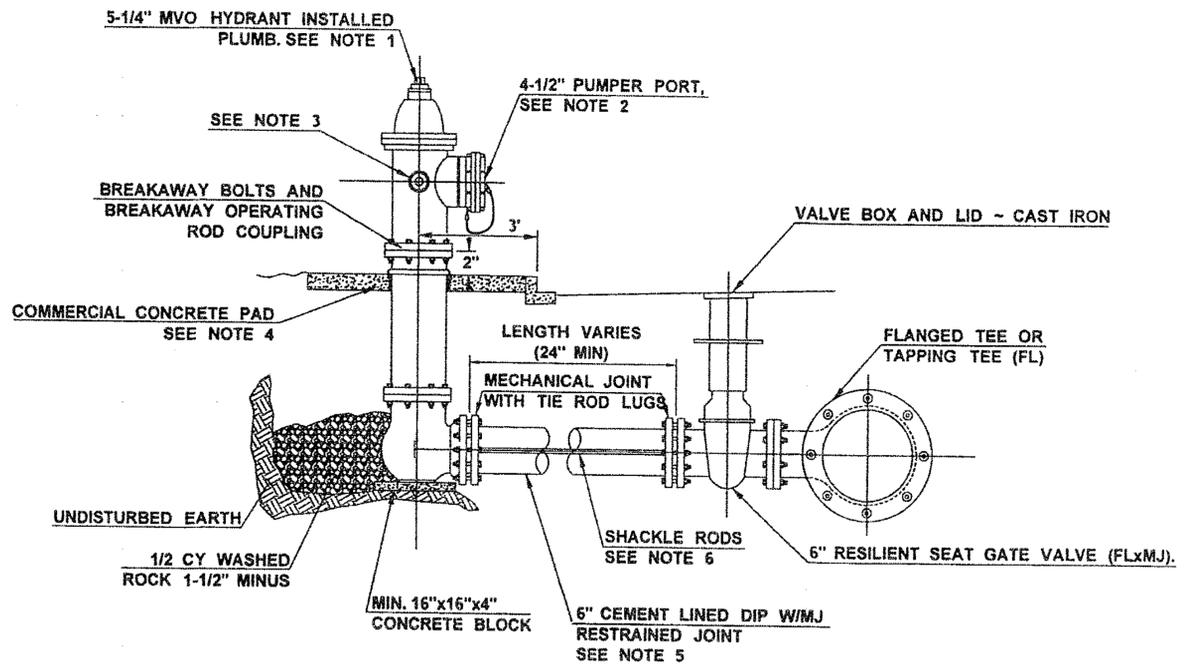


HYDRANT ASSEMBLY

NOTES:


1. HYDRANTS AND ALL MATERIALS SHALL CONFORM TO AWWA STANDARDS AND SHALL BE OF STANDARD MANUFACTURE (M&H RELIANT OR MUELLER SUPER CENTURION 250 ONLY).
2. ONE 5" TO 4-1/2" PUMPER PORT W/N.S.T. AND STORZ ADAPTER ASSEMBLY. PUMPER PORT TO BE FACING STREET OR ROADWAY FOR THE FIRE ENGINE ACCESS.
3. TWO 2-1/2" HOSE PORTS W/N.S.T. AND 1-1/4" OPERATING NUTS.
4. INSTALL 3'x3'x4" CONCRETE PAD (3000 PSI) AROUND HYDRANT IN UNPAVED AREAS INCLUDING PLANTER STRIPS. COMPLETELY SURROUND HYDRANT W/FULL DEPTH OF CONCRETE PAD WITH 1/4" JOINT MATERIAL BEFORE PLACING CONCRETE.
5. HYDRANT RUN TO BE 6" DUCTILE IRON PIPE CLASS 52 WITH RESTRAINED JOINTS.
6. 3/4" GALV. SHACKLE RODS WITH THE EYE BOLTS AT BOTH ENDS REQUIRED FROM VALVE TO HYDRANT.
7. FIRE HYDRANTS SHALL BE PAINTED WITH TWO COATS OF HIGH GLOSS EQUIPMENT YELLOW PAINT.
8. INSTALL 24"x24"x4" CONCRETE PAD (3000 PSI) AROUND VALVE BOX AND 48"x48"x4" FOR MULTIPLE VALVE BOXES IN UNPAVED AREA.

NTS



FILE NAME I:\Projects\XL3325 SR9 SR531 172nd St NE Int\CAD\PS&ESheets\XL3325 PS UTILITIES.dgn		REGION NO. 10	STATE WASH	FED.AID PROJ.NO.			SR 9 SR 531/172ND ST NE & EAGLEFIELD DR INTERSECTION IMPROVEMENT & PAVING	Plot 4
TIME 11:31:41 AM	DATE 9/21/2011	JOB NUMBER 10A042	LOCATION NO.	UD2				
PLOTTED BY lamaymp	DESIGNED BY M. LAMAY	CONTRACT NO.					SHEET 102 OF 230 SHEETS	
ENTERED BY K.SOLWOLD	CHECKED BY J. KORESKI							
PROJ. ENGR. S. SPAHR	REGIONAL ADM. L. ENG	REVISION	DATE	BY			UTILITY DETAILS	

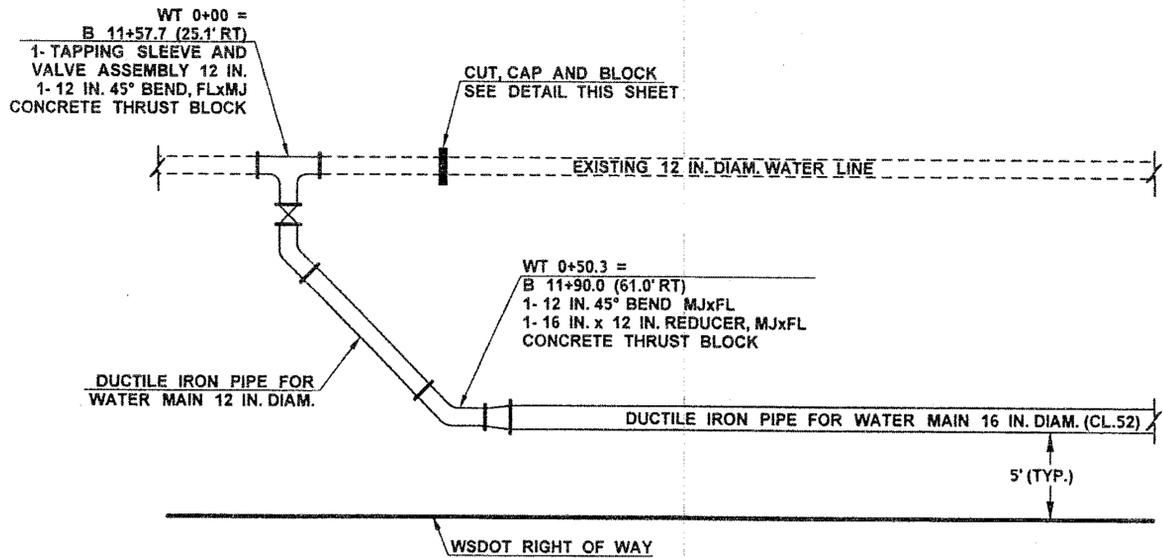


DETAIL A
N.T.S.

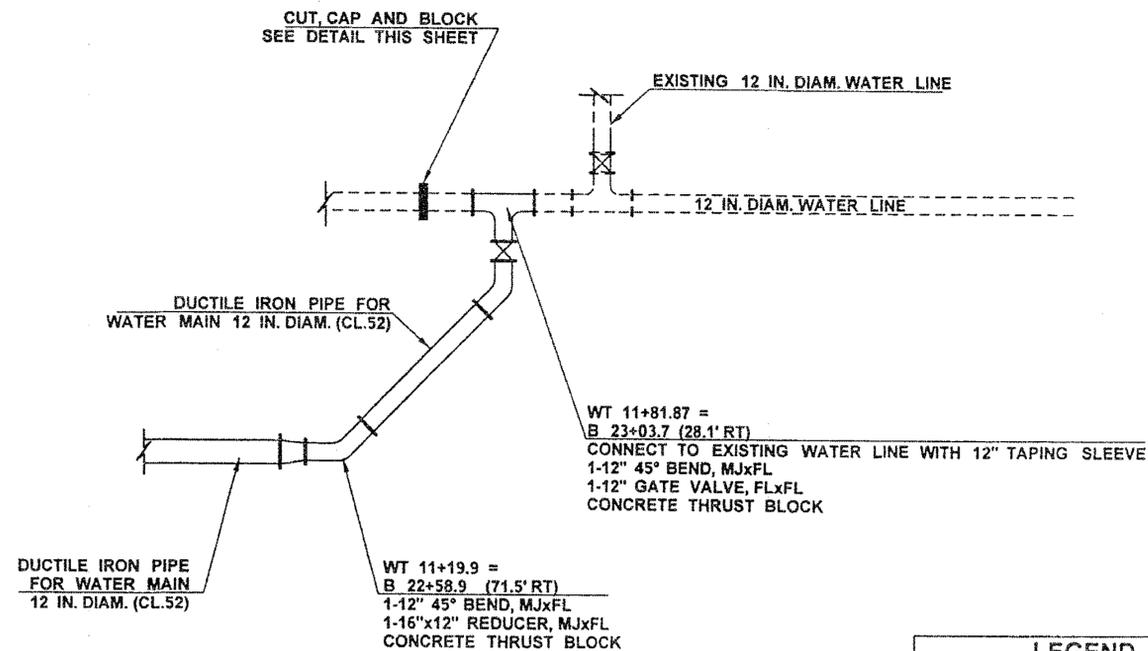

DETAIL C
N.T.S.

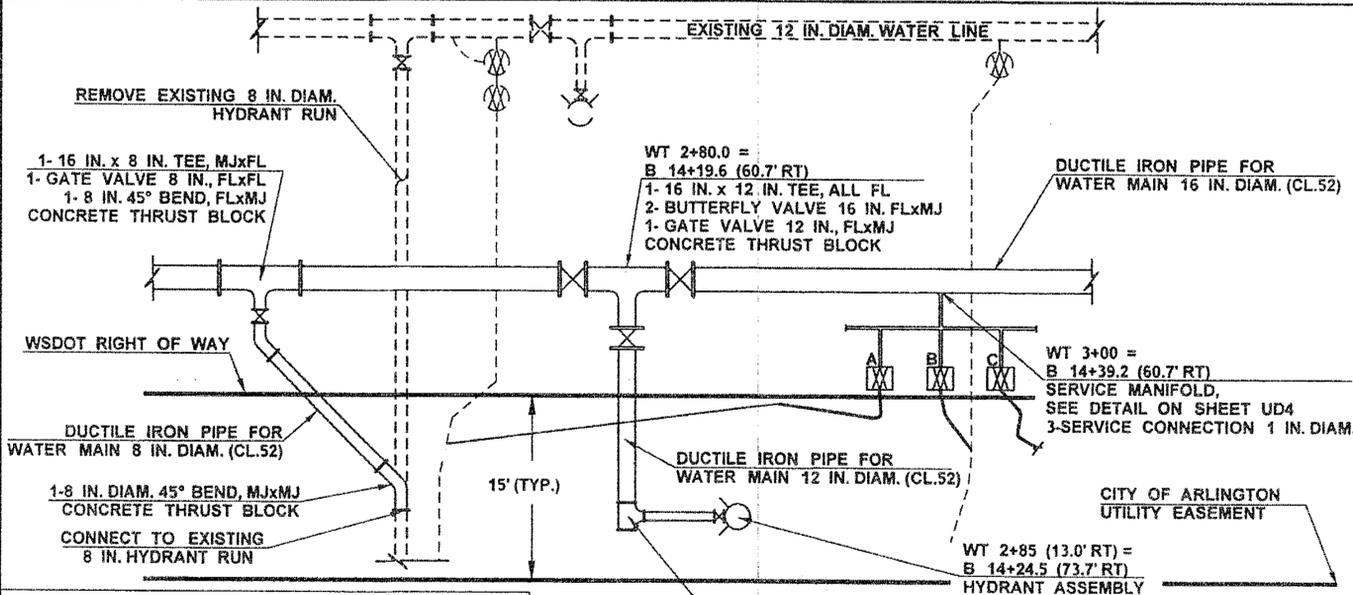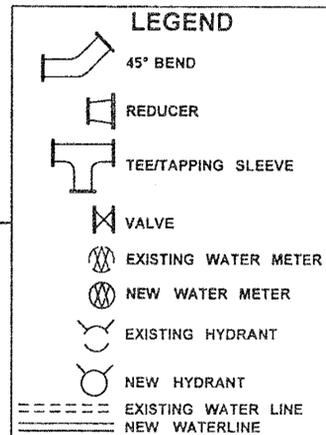

DETAIL B
N.T.S.

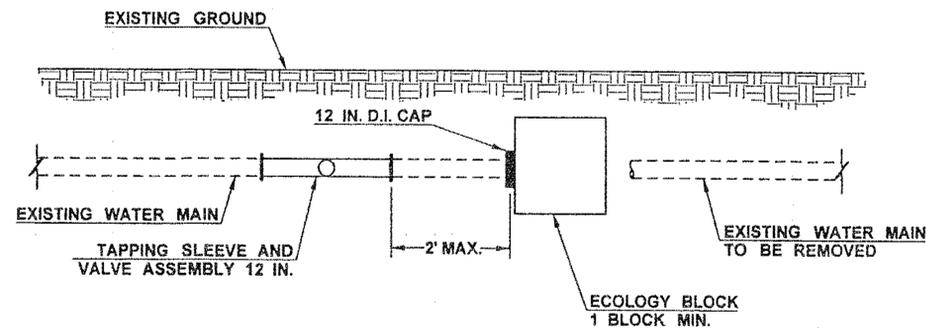

CAP AND BLOCK DETAIL
N.T.S.

FOR "AS CONSTRUCTED"
PLANS

SERVICE CONNECTION SCHEDULE		
SERVICE	CUSTOMER	PHYSICAL ADDRESS
A	NORPOINT GUN RANGE	8620 172ND ST NE
B	VACANT	8620 172ND ST NE
C	NA	STUB FOR FUTURE USE


FILE NAME	I:\Projects\XL3325_SR9_SR531_172nd_St_NE_Int\CAD\PS&ESheets\XL3325_PS_UTILITIES.dgn		
TIME	11:31:42 AM		
DATE	9/21/2011		
PLOTTED BY	lamaymp		
DESIGNED BY	M. LAMAY		
ENTERED BY	K. SOLWOLD		
CHECKED BY	J. KORESKE		
PROJ. ENGR.	S. SPAHR		
REGIONAL ADM.	L. ENG		
REVISION	DATE	BY	

REGION NO.	STATE	FED. AID PROJ. NO.
10	WASH	
JOB NUMBER	10A042	
CONTRACT NO.	LOCATION NO.	



SR 9
SR 531/172ND ST NE & EAGLEFIELD DR
INTERSECTION IMPROVEMENT & PAVING
UTILITY DETAILS


Plot 5
PLAN REF NO
UD3
SHEET
103
OF
230
SHEETS

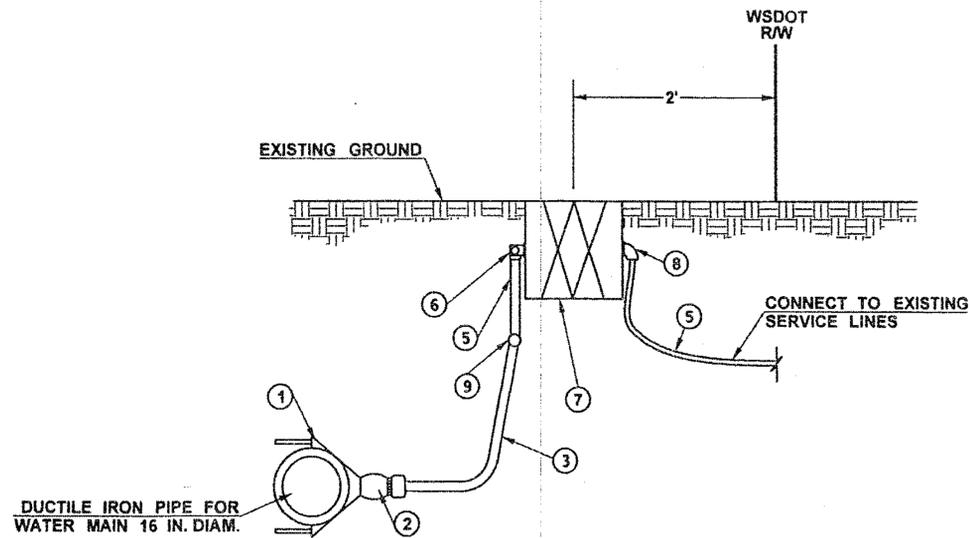

SECTION A-A
N.T.S.

GENERAL NOTES AND MATERIALS

- ① 2" CC SERVICE SADDLE.
- ② 2" BALL VALVE CORP. STOP X COMPRESSION CONNECTION
- ③ 2" HDPE CTS CLASS 200 HIGH SERVICE PIPE (200 PSI RATING) WITH STAINLESS STEEL STIFFENER AND 10 GAUGE COATED COPPER TRACER WIRE WRAPPED AROUND THE PIPE AND ATTACHED ON BOTH ENDS.
- ④ 2" BRASS PIPE.
- ⑤ 1" HDPE CTS POLY PIPE CLASS 200 HIGH SERVICE PIPE (200 PSI RATING) WITH STAINLESS STEEL STIFFENER AND 10 GAUGE COATED COPPER TRACER WIRE WRAPPED AROUND THE PIPE AND ATTACHED ON BOTH ENDS.
- ⑥ 1"x5/8" ANGLE METER BALL VALVE.
- ⑦ 5/8" METER TO BE INSTALLED BY CITY UTILITY DIVISION. CONTRACTOR TO PROVIDE METER LENGTH BLANK STUB.
- ⑧ 3/4" ANGLE METER CHECK COUPLING WITH A 3/4" MIPT x 1" COMPRESSION ADAPTER.
- ⑨ 2" BRASS CROSS.
- ⑩ 2"x1" BRASS T
- ⑪ 2"x1" REDUCER.
- ⑫ 2" BRASS CAP.

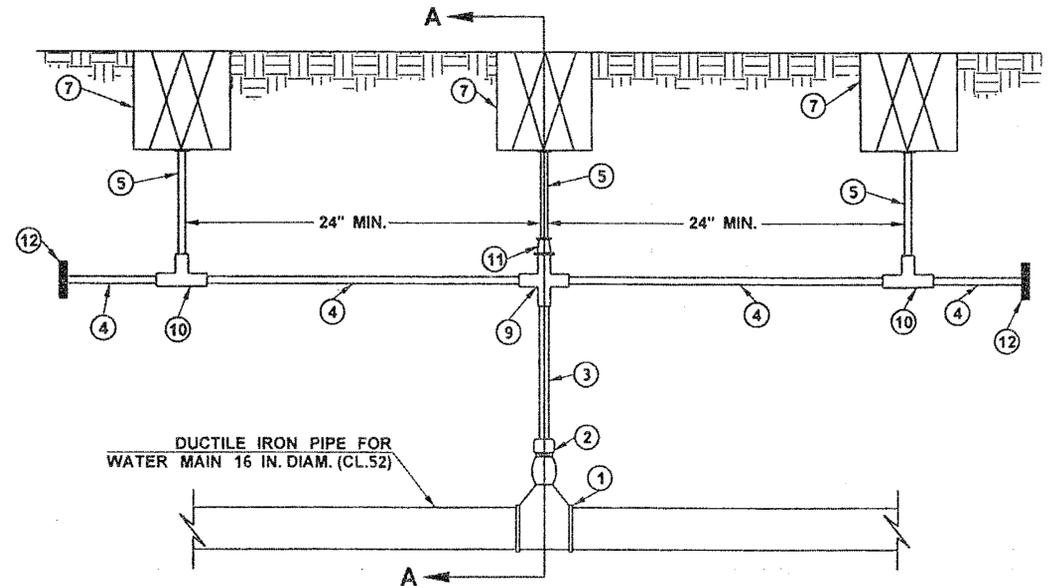

SERVICE MANIFOLD DETAIL
N.T.S.

FOR "AS CONSTRUCTED
PLANS" ONLY

FILE NAME I:\Projects\XL3325_SR9_SR531_172nd_St_NE_Int\CAD\PS&ESheets\XL3325_PS_UTILITIES.dgn		REGION NO. 10 STATE WASH		FED.AID PROJ.NO.				SR 9 SR 531/172ND ST NE & EAGLEFIELD DR INTERSECTION IMPROVEMENT & PAVING	Plot 6
TIME 10:01:21 AM	DATE 9/19/2011	JOB NUMBER 10A042		LOCATION NO.					PLAN REF NO UD4
PLOTTED BY gunnm	DESIGNED BY M. LAMAY	CONTRACT NO.		DATE 9/22/11		Washington State Department of Transportation	SR 9 SR 531/172ND ST NE & EAGLEFIELD DR INTERSECTION IMPROVEMENT & PAVING	SHEET 104	
ENTERED BY K.SOLWOLD	CHECKED BY J. KORESKI	REVISION		DATE				OF 230	
PROJ. ENGR. S. SPAHR	REGIONAL ADM. L. ENG	DATE		BY		UTILITY DETAILS		SHEETS	

T. 31N. R. 5E. W.M.



QUANTITY TAB - THIS SHEET ONLY				
SYMBOL	ITEM	QUANTITY		
MIX W - 4' O.C.		W1		
	SALMONBERRY	115		
	SCOULER'S WILLOW			
	SLOUGH SEDGE (NOTE 2)	149		
MIX B - 4' O.C.		B1		
	WESTERN RED CEDAR	2		
	INDIAN PLUM	4		
	SALMONBERRY	12		
MIX F - 4' O.C.		F1	F2	
	BITTER CHERRY	36		
	WESTERN RED CEDAR	36		
	INDIAN PLUM	128	57	
	RED ELDERBERRY	128	57	
	RED-OSIER DOGWOOD	92	38	
	SALMONBERRY	92	38	
	SOIL AMENDMENT (CY)	75	28	
	COMPOST BLANKET (SY)	227	30	
	BARK OR WOOD CHIP MULCH (CY)	19	3	75
			28	

NOTES:

1. INSTALL TREES NO CLOSER THAN 8 FT. O.C.
2. INSTALL THREE PLANTS PER PLANTING LOCATION. SEE DETAIL, SHEET PLD2.
3. SEEDING, FERTILIZING AND MULCHING SHALL BE APPLIED TO ALL AREAS OF DISTURBED SOIL NOT DESIGNATED AS PLANTING AREAS. (ESTIMATED QUANTITY 0.14 AC. THIS SHEET).

LEGEND

- WETLAND
- WETLAND BUFFER
- ORDINARY HIGH WATER LINE
- STREAM BUFFER
- LIMITED ACCESS RIGHT OF WAY
- EDGE OF SHOULDER
- DITCH
- EXISTING VEGETATION - SAVE & PROTECT
- PLANTING AREA LAYOUT POINTS - SEE SHEET PLD1 FOR TABLE OF STATIONS AND OFFSETS

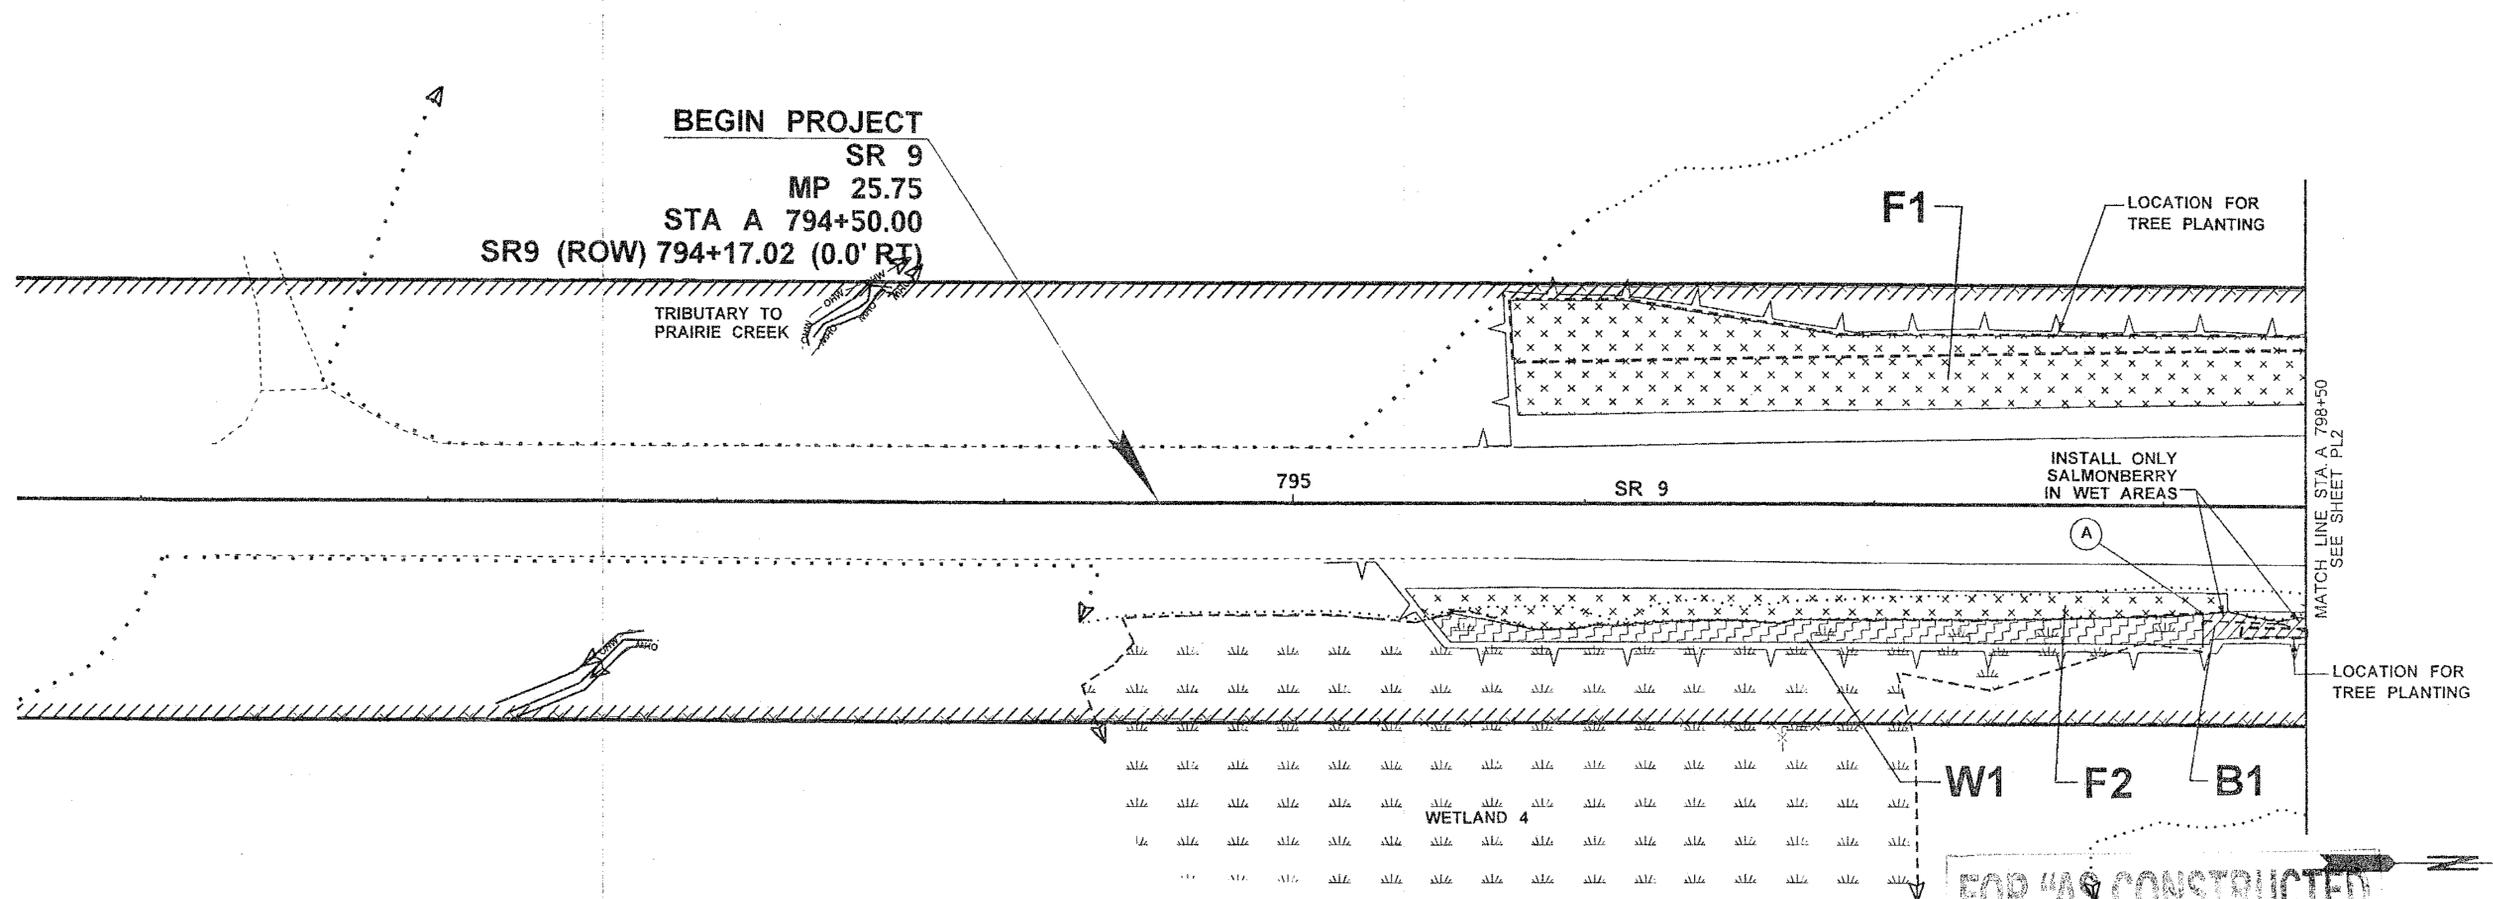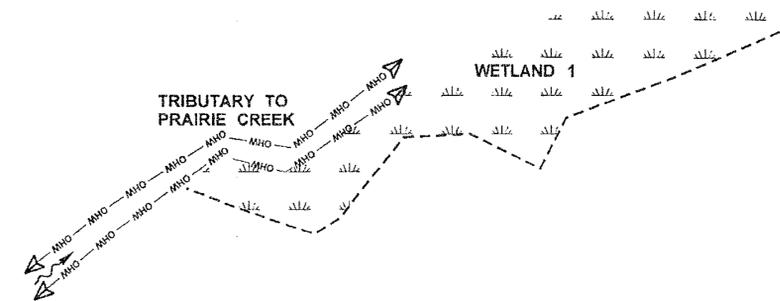

FOR "AS CONSTRUCTED" PLANS

SCALE IN FEET
0 30 60


FILE NAME	T:\412006\XL3325 SR 9 & SR 531 I-CICADIPS&ESheets\Ad copy\XL3325 PS LA Ad.dgn			REGION NO.	STATE	FED.AID PROJ.NO.			SR9 SR531/172ND ST NE & EAGLEFIELD DR INTERSECTION IMPROVEMENT & PAVING	Plot 1
TIME	5:52:10 PM			10	WASH					PLAN REF NO
DATE	9/28/2011			JOB NUMBER	10A042	LOCATION NO.			SHEET	105
PLOTTED BY	french			CONTRACT NO.					OF	230
DESIGNED BY	L.FRENCH								SHEETS	
ENTERED BY	K.McLEAN									
CHECKED BY	J. HARTWIG									
PROJ. ENGR.	S.SPAHR									
REGIONAL ADM.	L. ENG	REVISION	DATE	BY						

T. 31N. R. 5E. W.M.

LEGEND

- WETLAND
- WETLAND BUFFER
- ORDINARY HIGH WATER LINE
- STREAM BUFFER
- LIMITED ACCESS RIGHT OF WAY
- EDGE OF SHOULDER
- DITCH
- EXISTING VEGETATION - SAVE & PROTECT

(A) PLANTING AREA LAYOUT POINTS - SEE SHEET PLD1 FOR TABLE OF STATIONS AND OFFSETS

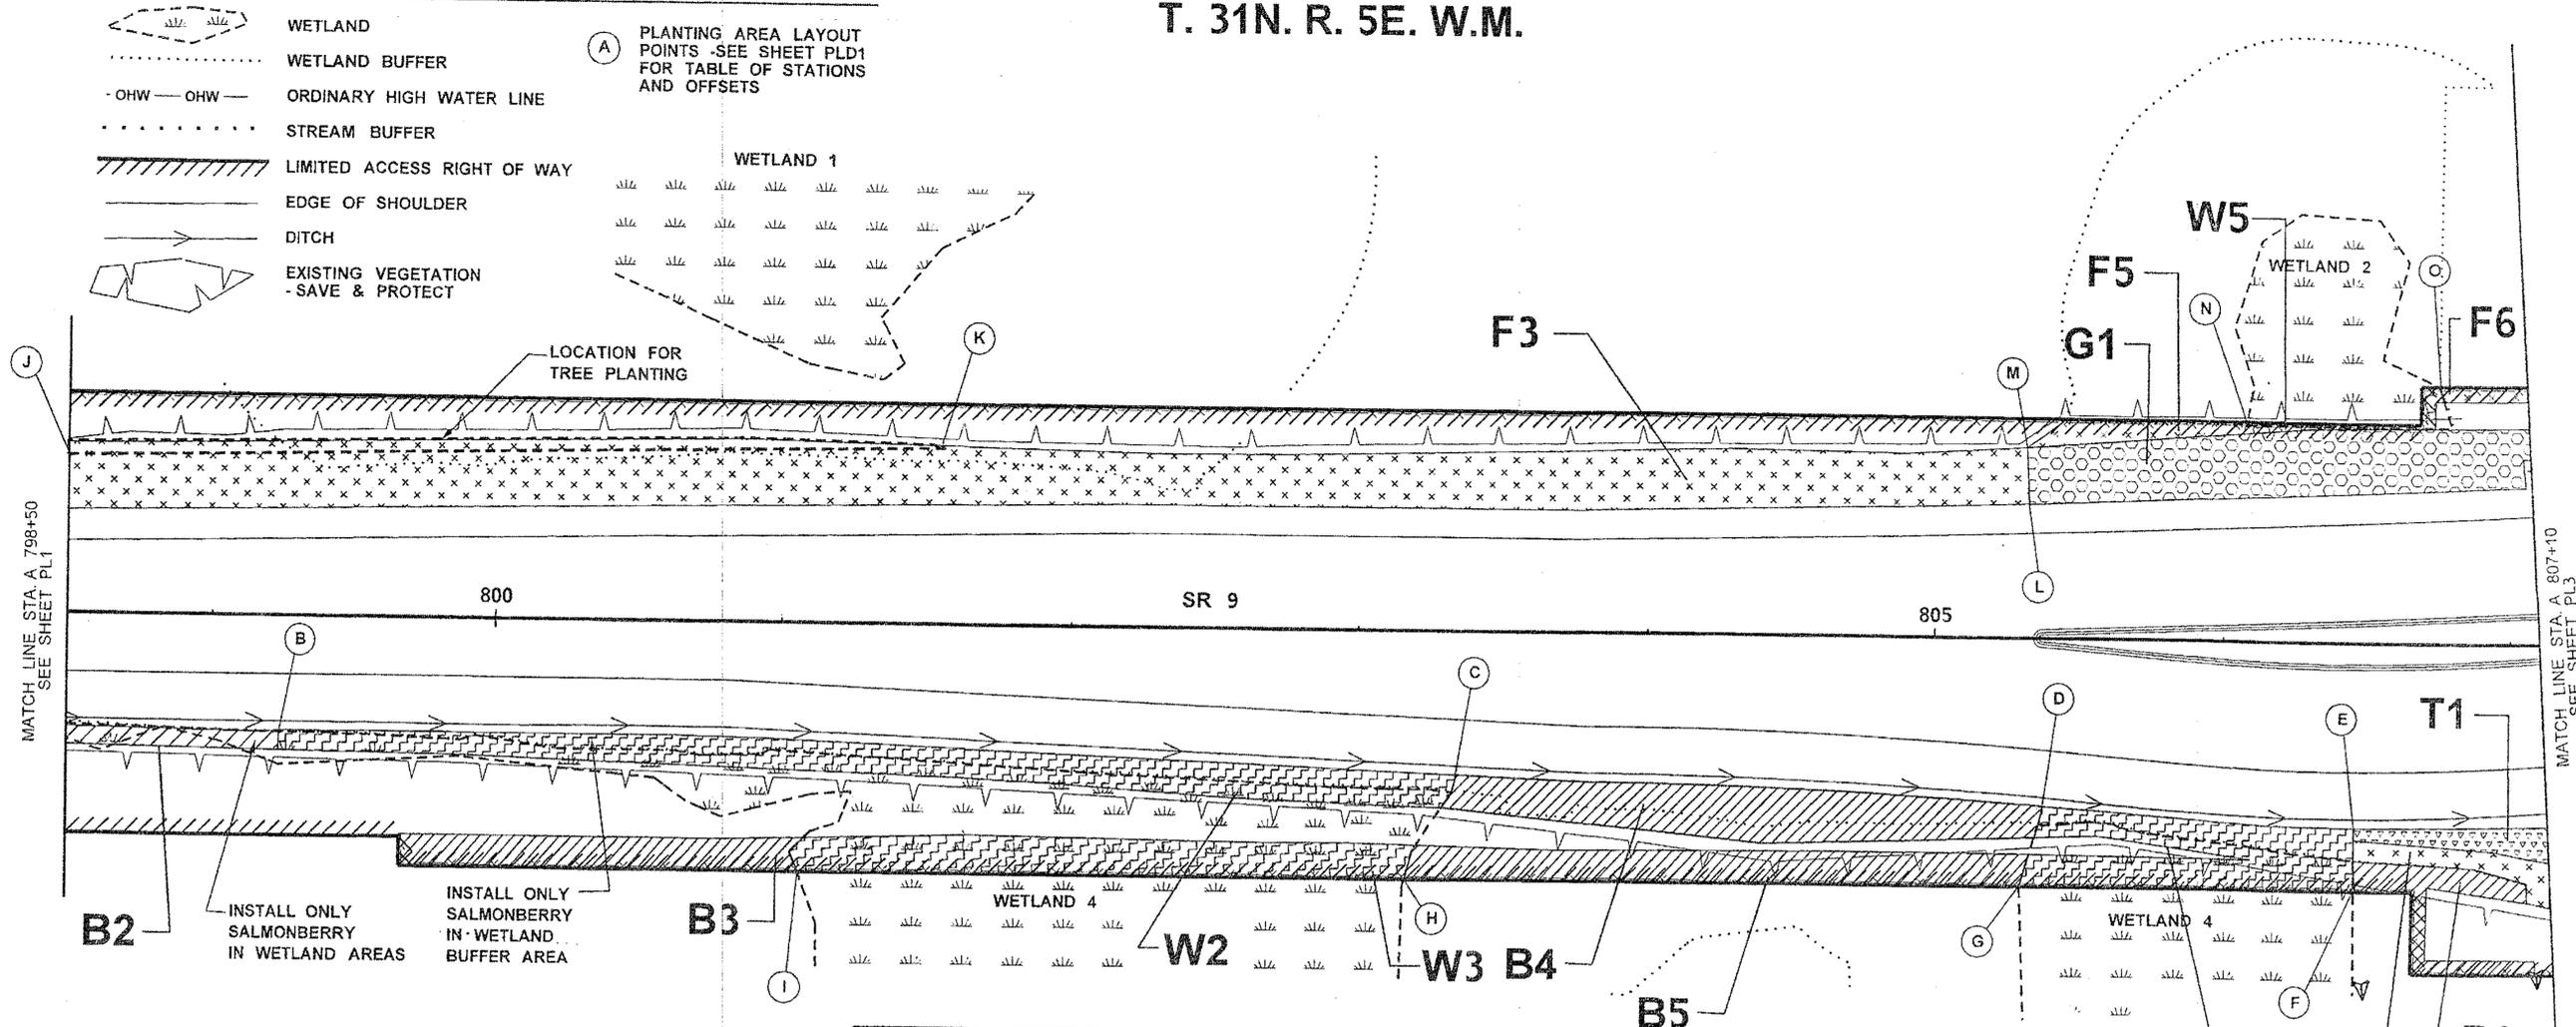


SYMBOL	ITEM	QUANTITY							
MIX W - 4' O.C. (SEE NOTE 4,5)		W2	W3	W4	W5				
	SALMONBERRY	117	75	106	11				
	SCOULER'S WILLOW								
	SLOUGH SEDGE (NOTE 2)	150	96	135	14				
MIX F - 4' O.C. (SEE NOTE 4)						F3	F4	F5	F6
	BITTER CHERRY					8	2	2	1
	WESTERN RED CEDAR					25	2	2	1
	INDIAN PLUM					280	12	10	3
	RED ELDERBERRY					187	8	7	2
	RED-OSIER DOGWOOD					120	4	3	1
	SALMONBERRY					280	12	10	3
	SOIL AMENDMENT (CY)					131			
	COMPOST BLANKET (SY)	453		144	24	61	51		
	BARK OR WOOD CHIP MULCH (CY)	38	3	16	1	131	5	4	1

SYMBOL	ITEM	QUANTITY						
MIX T - 2' O.C. (SEE NOTE 6)		T1						
	SALAL	102						
	WESTERN SWORD FERN	36						
MIX G - 4' O.C. (SEE NOTE 5)			G1					
	WESTERN RED CEDAR		27					
	BEAKED HAZELNUT		67					
	RED ELDERBERRY		27					
	SALAL (NOTE 2)		81					
	SCOULER'S WILLOW		67					
	VINE MAPLE		54					
MIX B - 4' O.C. (SEE NOTE 4,5)			B2	B3	B4	B5	B6	
	WESTERN RED CEDAR			7	23	11	5	
	INDIAN PLUM		6	14	46	21	10	
	SALMONBERRY		13	48	160	74	33	
	SOIL AMENDMENT (CY)		35					
	COMPOST BLANKET (SY)	56	51		353	49		
	BARK OR WOOD CHIP MULCH (CY)	5	35	4	2	29	3	5

NOTES:

- INSTALL TREES NO CLOSER THAN 8 FT. O.C.
- INSTALL THREE PLANTS PER PLANTING LOCATION. SEE DETAIL, SHEET PLD2.
- SEEDING, FERTILIZING AND MULCHING SHALL BE APPLIED TO ALL AREAS OF DISTURBED SOIL NOT DESIGNATED AS PLANTING AREAS. (ESTIMATED QUANTITY 0.57 AC. THIS SHEET).
- PLANTING AREAS B3, W3, B5, W5, F6, F7, AND PORTIONS OF W4 AND B6 SHALL BE PLANTED AMONGST EXISTING DESIRABLE VEGETATION, SPACING IS APPROXIMATE AND MULCH RINGS SHALL BE INSTALLED IN A 2' DIA. AROUND EACH PLANT.
- IN PLANTING AREAS G1, B2 AND W2, NO TREES SHALL BE PLANTED IN THE FIRST TWO ROWS CLOSEST TO ROADWAY. SEE PLANT LIST ON DETAIL SHEET PLD1.
- PLANT SALAL AT 2' O.C. SPACING; WESTERN SWORD FERN AT 4' O.C. SPACING.

FOR AS CONSTRUCTED PLANS

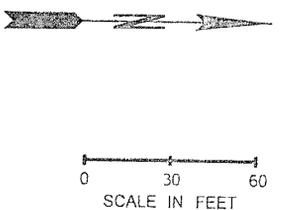

FILE NAME	T:\412006\XL3325 SR 9 & SR 531 I-CADIPS&ESheets\Ad copy\XL3325_PS_LA Ad.dgn
TIME	9:26:55 AM
DATE	9/22/2011
PLOTTED BY	frenchl
DESIGNED BY	L.FRENCH
ENTERED BY	K.McLEAN
CHECKED BY	J.HARTWIG
PROJ. ENGR.	S.SPAHR
REGIONAL ADM.	L. ENG

REGION NO.	STATE	FED.AID PROJ.NO.
10	WASH	
JOB NUMBER		
10A042		
CONTRACT NO.	LOCATION NO.	

STATE OF WASHINGTON
REGISTERED
LANDSCAPE ARCHITECT

DAVID S. PETERSON
CERTIFICATE NO. 4116
DATE: 09/22/11
EXPIRES: 02/04/2013

Washington State
Department of Transportation

SR9
SR531/172ND ST NE & EAGLEFIELD DR
INTERSECTION IMPROVEMENT & PAVING

PLANTING PLAN

Plot 2
PLAN REF NO
PL2
SHEET
106
OF
230
SHEETS


- NOTES:
1. INSTALL TREES NO CLOSER THAN 8 FT. O.C.
 2. INSTALL THREE PLANTS PER PLANTING LOCATION. SEE DETAIL, SHEET PLD2.
 3. SEEDING, FERTILIZING AND MULCHING SHALL BE APPLIED TO ALL AREAS OF DISTURBED SOIL NOT DESIGNATED AS PLANTING AREAS. (ESTIMATED QUANTITY 0.41 AC. THIS SHEET).
 4. LOCATIONS TO BE STAKED IN THE FIELD BY ENGINEER.
 5. PLANTING AREAS OUTSIDE OF CLEARING AND GRUBBING LIMITS SHALL RECEIVE WEED CONTROL PRIOR TO PLANTING, IN ACCORDANCE WITH THE SPECIAL PROVISION PLANTING AREA WEED CONTROL.

T. 31N. R. 5E. W.M.

LEGEND

- WETLAND
- WETLAND BUFFER
- ORDINARY HIGH WATER LINE
- STREAM BUFFER
- LIMITED ACCESS RIGHT OF WAY
- EDGE OF SHOULDER
- DITCH
- EXISTING VEGETATION - SAVE & PROTECT

(A) PLANTING AREA LAYOUT POINTS - SEE SHEET PLD1 FOR TABLE OF STATIONS AND OFFSETS

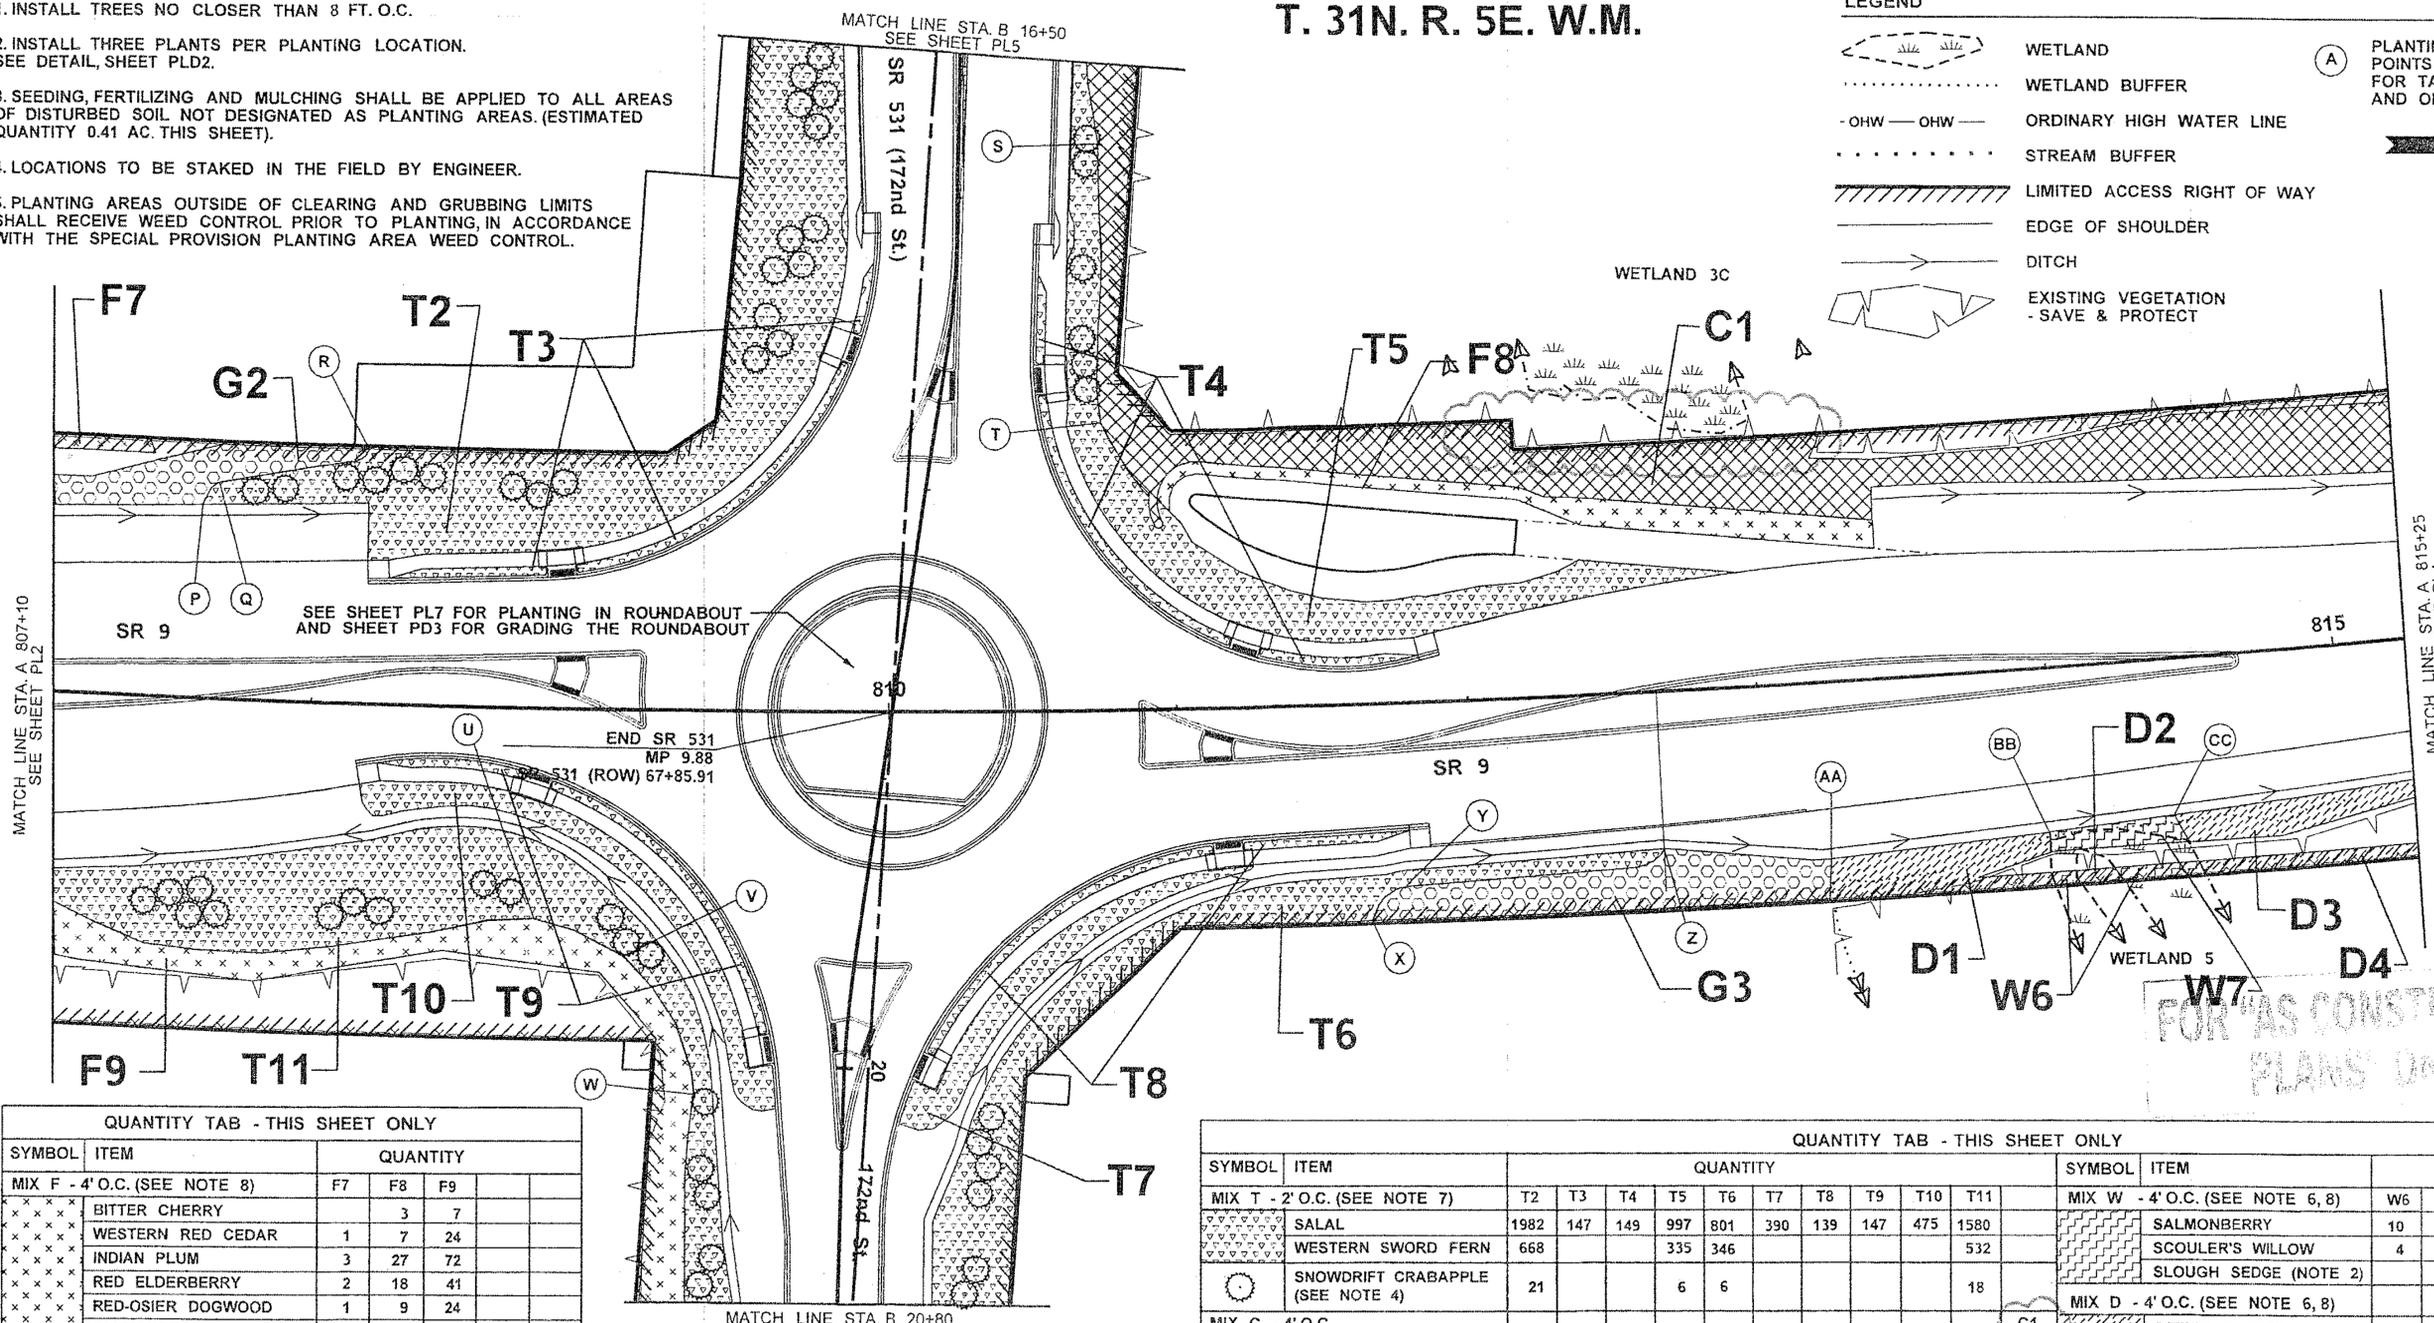

QUANTITY TAB - THIS SHEET ONLY

SYMBOL	ITEM	QUANTITY			
		F7	F8	F9	
MIX F - 4' O.C. (SEE NOTE 8)					
	BITTER CHERRY		3	7	
	WESTERN RED CEDAR	1	7	24	
	INDIAN PLUM	3	27	72	
	RED ELDERBERRY	2	18	41	
	RED-OSIER DOGWOOD	1	9	24	
	SALMONBERRY	3	27	72	
MIX G - 4' O.C.					G2 G3
	WESTERN RED CEDAR				7
	BEAKED HAZELNUT				14 25
	RED ELDERBERRY				7 15
	SALAL (NOTE 2)				127 124
	SCOULER'S WILLOW				28 33
	VINE MAPLE				42 51
	SOIL AMENDMENT (CY)		16		18 21
	COMPOST BLANKET (SY)			400	
	BARK OR WOOD CHIP MULCH (CY)	1	16	33	18 21


- NOTES, CONTINUED:
6. IN PLANTING AREAS D1, D3 AND W7, NO TREES SHALL BE PLANTED IN THE FIRST TWO ROWS CLOSEST TO ROADWAY. SEE PLANT LIST ON DETAIL SHEET PLD1.
 7. PLANT SALAL AT 2' O.C. AND WESTERN SWORD FERN AT 4' O.C.
 8. PLANTING AREAS F7, D2, D4, W6 AND PORTIONS OF D1 AND C1 SHALL BE PLANTED AMONGST EXISTING DESIRABLE VEGETATION. O.C. SPACING IS APPROXIMATE AND MULCH RINGS SHALL BE INSTALLED IN A 2' DIA. AROUND EACH PLANT.

QUANTITY TAB - THIS SHEET ONLY

SYMBOL	ITEM	QUANTITY										
		T2	T3	T4	T5	T6	T7	T8	T9	T10	T11	
MIX T - 2' O.C. (SEE NOTE 7)												
	SALAL	1982	147	149	997	801	390	139	147	475	1580	
	WESTERN SWORD FERN	668			335	346					532	
	SNOWDRIFT CRABAPPLE (SEE NOTE 4)	21			6	6					18	
MIX C - 4' O.C.												C1
	WESTERN RED CEDAR											83
	INDIAN PLUM											173
	RED ELDERBERRY											69
	VINE MAPLE											173
	WESTERN CRABAPPLE											69
	THIMBLEBERRY											125
	SOIL AMENDMENT (CY)	85	5	5	38	37	13	4	5	15	68	85
	BARK OR WOOD CHIP MULCH (CY)	85	5	5	38	37	13	4	5	15	68	85

QUANTITY TAB - THIS SHEET ONLY

SYMBOL	ITEM	QUANTITY			
		W6	W7		
MIX W - 4' O.C. (SEE NOTE 6, 8)					
	SALMONBERRY	10	19		
	SCOULER'S WILLOW	4	8		
	SLOUGH SEDGE (NOTE 2)				
MIX D - 4' O.C. (SEE NOTE 6, 8)				D1	D2 D3 D4
	BITTER CHERRY			4	3 1
	CASCARA			4	1 3 1
	INDIAN PLUM			22	2 18 6
	SALAL (NOTE 2)			87	6 72 23
	VINE MAPLE			15	1 12 4
	COMPOST BLANKET (SY)			43	112 93
	BARK OR WOOD CHIP MULCH (CY)	1	4	9	8 1

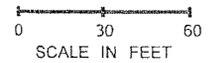

FILE NAME	T:\412006\XL3325 SR 9 & SR 531 I-CICADIPS&ESheets\Addendum\XL3325_PS_LA Ad.dgn			REGION NO.	STATE	FED.AID PROJ.NO.
TIME	8:42:53 AM			10	WASH	
DATE	10/24/2011			REVISED PLANTING AREA C1	10/24/11	LF
PLOTTED BY	frenchi			JOB NUMBER	10A042	
DESIGNED BY	L.FRENCH			CONTRACT NO.		
ENTERED BY	K.McLEAN			LOCATION NO.		
CHECKED BY	J.HARTWIG					
PROJ. ENGR.	S.SPAHR					
REGIONAL ADM.	L.ENG			REVISION	DATE	BY

STATE OF WASHINGTON
REGISTERED
LANDSCAPE ARCHITECT

DEBORAH K. PETERS
CERTIFICATE NO. 969
DATE: 10/24/11
For Changes

Washington State
Department of Transportation

SR9
SR531/172ND ST NE & EAGLEFIELD DR
INTERSECTION IMPROVEMENT & PAVING


PLANTING PLAN

Plot 3
PLAN REF NO
PL3
SHEET
107
OF
230
SHEETS

QUANTITY TAB - THIS SHEET ONLY

SYMBOL	ITEM	QUANTITY								
MIX W - 4' O.C. (SEE NOTE 4)		W8	W9							
	SALMONBERRY	9	47							
	SCOULER'S WILLOW	4	20							
	SLOUGH SEDGE (NOTE 2)									
MIX D - 4' O.C. (SEE NOTE 4)				D5	D6	D7	D8			
	BITTER CHERRY			1		2	1			
	CASCARA			1		2	1			
	INDIAN PLUM			8	24	14	5			
	SALAL (NOTE 2)			30	87	58	19			
	VINE MAPLE			5	20	10	3			
MIX C - 4' O.C. (SEE NOTE 5, 6)								C2	C3	C4
	WESTERN RED CEDAR							58	22	7
	INDIAN PLUM							120	45	3
	RED ELDERBERRY							48	18	7
	VINE MAPLE							120	45	3
	WESTERN CRABAPPLE							48	18	3
	THIMBLEBERRY							87	32	5
	COMPOST BLANKET (SY)		103		112	86				302
	SOIL AMENDMENT (CY)							940	25	
	BARK OR WOOD CHIP MULCH (CY)	9	1	7	7	1	78			1

T. 31N. R. 5E. W.M.

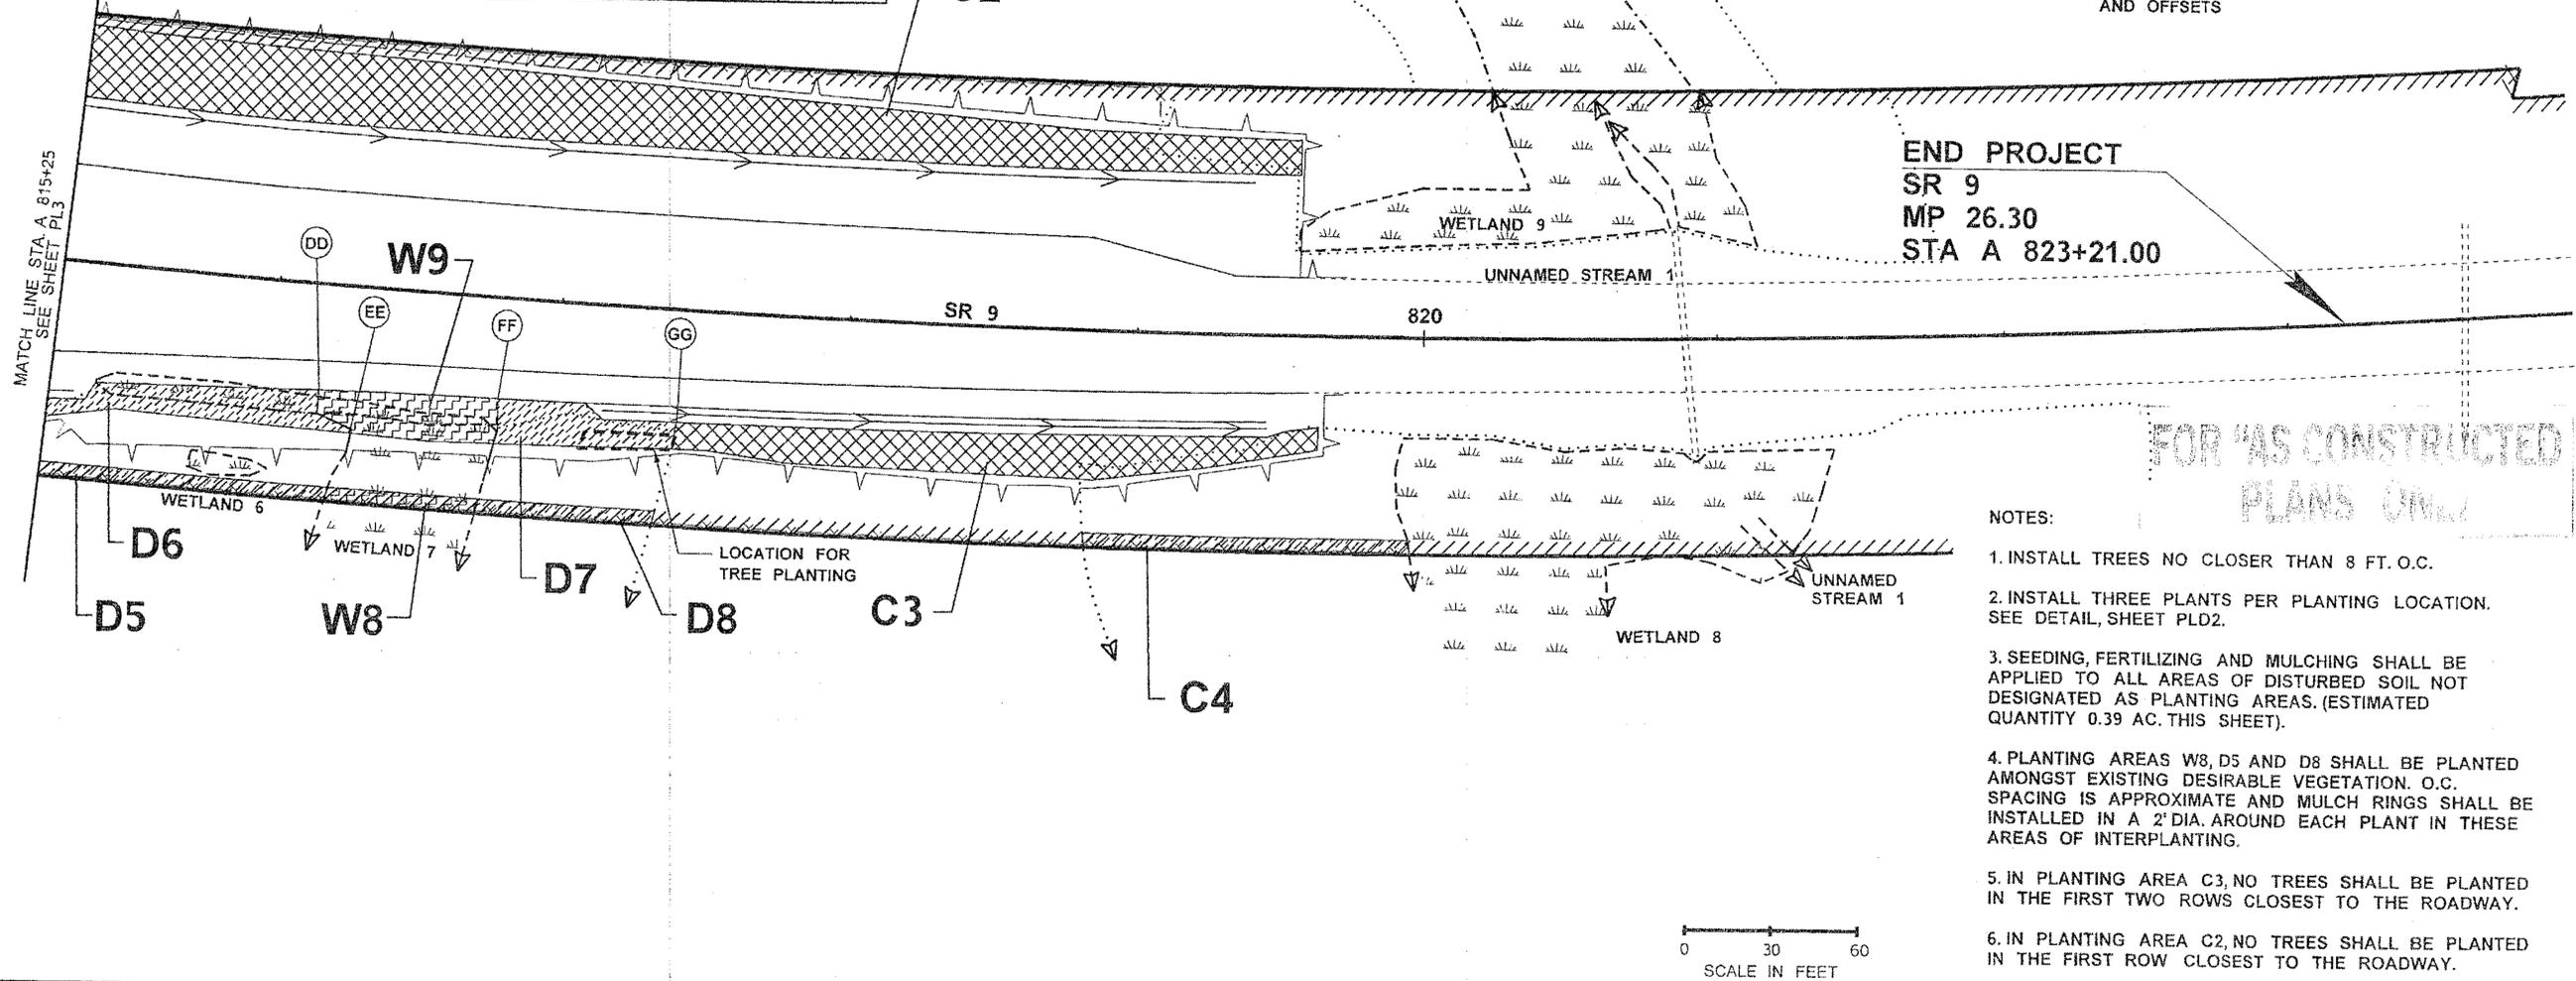

LEGEND

- WETLAND
- WETLAND BUFFER
- ORDINARY HIGH WATER LINE
- STREAM BUFFER
- LIMITED ACCESS RIGHT OF WAY
- EDGE OF SHOULDER
- DITCH
- EXISTING VEGETATION - SAVE & PROTECT
- PLANTING AREA LAYOUT POINTS - SEE SHEET PLD1 FOR TABLE OF STATIONS AND OFFSETS

- NOTES:**
- INSTALL TREES NO CLOSER THAN 8 FT. O.C.
 - INSTALL THREE PLANTS PER PLANTING LOCATION. SEE DETAIL, SHEET PLD2.
 - SEEDING, FERTILIZING AND MULCHING SHALL BE APPLIED TO ALL AREAS OF DISTURBED SOIL NOT DESIGNATED AS PLANTING AREAS. (ESTIMATED QUANTITY 0.39 AC. THIS SHEET).
 - PLANTING AREAS W8, D5 AND D8 SHALL BE PLANTED AMONGST EXISTING DESIRABLE VEGETATION. O.C. SPACING IS APPROXIMATE AND MULCH RINGS SHALL BE INSTALLED IN A 2' DIA. AROUND EACH PLANT IN THESE AREAS OF INTERPLANTING.
 - IN PLANTING AREA C3, NO TREES SHALL BE PLANTED IN THE FIRST TWO ROWS CLOSEST TO THE ROADWAY.
 - IN PLANTING AREA C2, NO TREES SHALL BE PLANTED IN THE FIRST ROW CLOSEST TO THE ROADWAY.

FILE NAME	T:\412006\XL3325 SR 9 & SR 531 I-CICADIPS&ESheets\Ad copy\XL3325_PS_LA Ad.dgn
TIME	9:27:01 AM
DATE	9/22/2011
PLOTTED BY	frenchl
DESIGNED BY	L.FRENCH
ENTERED BY	K.McLEAN
CHECKED BY	J.HARTWIG
PROJ. ENGR.	S.SPAHR
REGIONAL ADM.	L.ENG

REGION NO.	STATE	FED.AID PROJ.NO.
10	WASH	
JOB NUMBER	CONTRACT NO.	LOCATION NO.
10A042		

STATE OF WASHINGTON
REGISTERED
LANDSCAPE ARCHITECT
David S. Peterson
DAVID S. PETERSON
CERTIFICATE NO. 176
DATE: 09/22/11
EXPIRES: 02/04/2013

Washington State
Department of Transportation

SR9
SR531/172ND ST NE & EAGLEFIELD DR
INTERSECTION IMPROVEMENT & PAVING
PLANTING PLAN


Plot 4
PLAN REF NO
PL4
SHEET
108
OF
230
SHEETS

T. 31N. R. 5E. W.M.

QUANTITY TAB - THIS SHEET ONLY			
SYMBOL	ITEM	QUANTITY	
MIX X - 4' O.C.		X1	
	DOUGLAS SPIREA	88	
MIX V - 3' O.C.		V1	
	NOOTKA ROSE	160	
	SNOWBERRY	106	
MIX C - 4' O.C.			C5
	WESTERN RED CEDAR		16
	INDIAN PLUM		33
	RED ELDERBERRY		13
	VINE MAPLE		33
	WESTERN CRABAPPLE		13
	THIMBLEBERRY		24
	COMPOST BLANKET (SY)	143	230
	BARK OR WOOD CHIP MULCH (CY)	12	19

QUANTITY TAB - THIS SHEET ONLY			
SYMBOL	ITEM	QUANTITY	
MIX G - 4' O.C.		G4	
	WESTERN RED CEDAR	14	
	BEAKED HAZELNUT	9	
	RED ELDERBERRY	4	
	SALAL (NOTE 2)	81	
	SCOULER'S WILLOW	18	
	VINE MAPLE	27	
MIX T - 2' O.C. (SEE NOTE 6)		T12	T13
	SALAL	132	811
	WESTERN SWORD FERN	45	274
	SNOWDRIFT CRABAPPLE (SEE NOTE 4)	3	9
	SOIL AMENDMENT (CY)	13	9
	COMPOST BLANKET (SY)		35
	BARK OR WOOD CHIP MULCH (CY)	13	9

BEGIN CONSTRUCTION
 SR 531
 MP 9.72
 STA B 10+53.8 =
 SR 531 (ROW) 59+09.79 (1.31'RT)

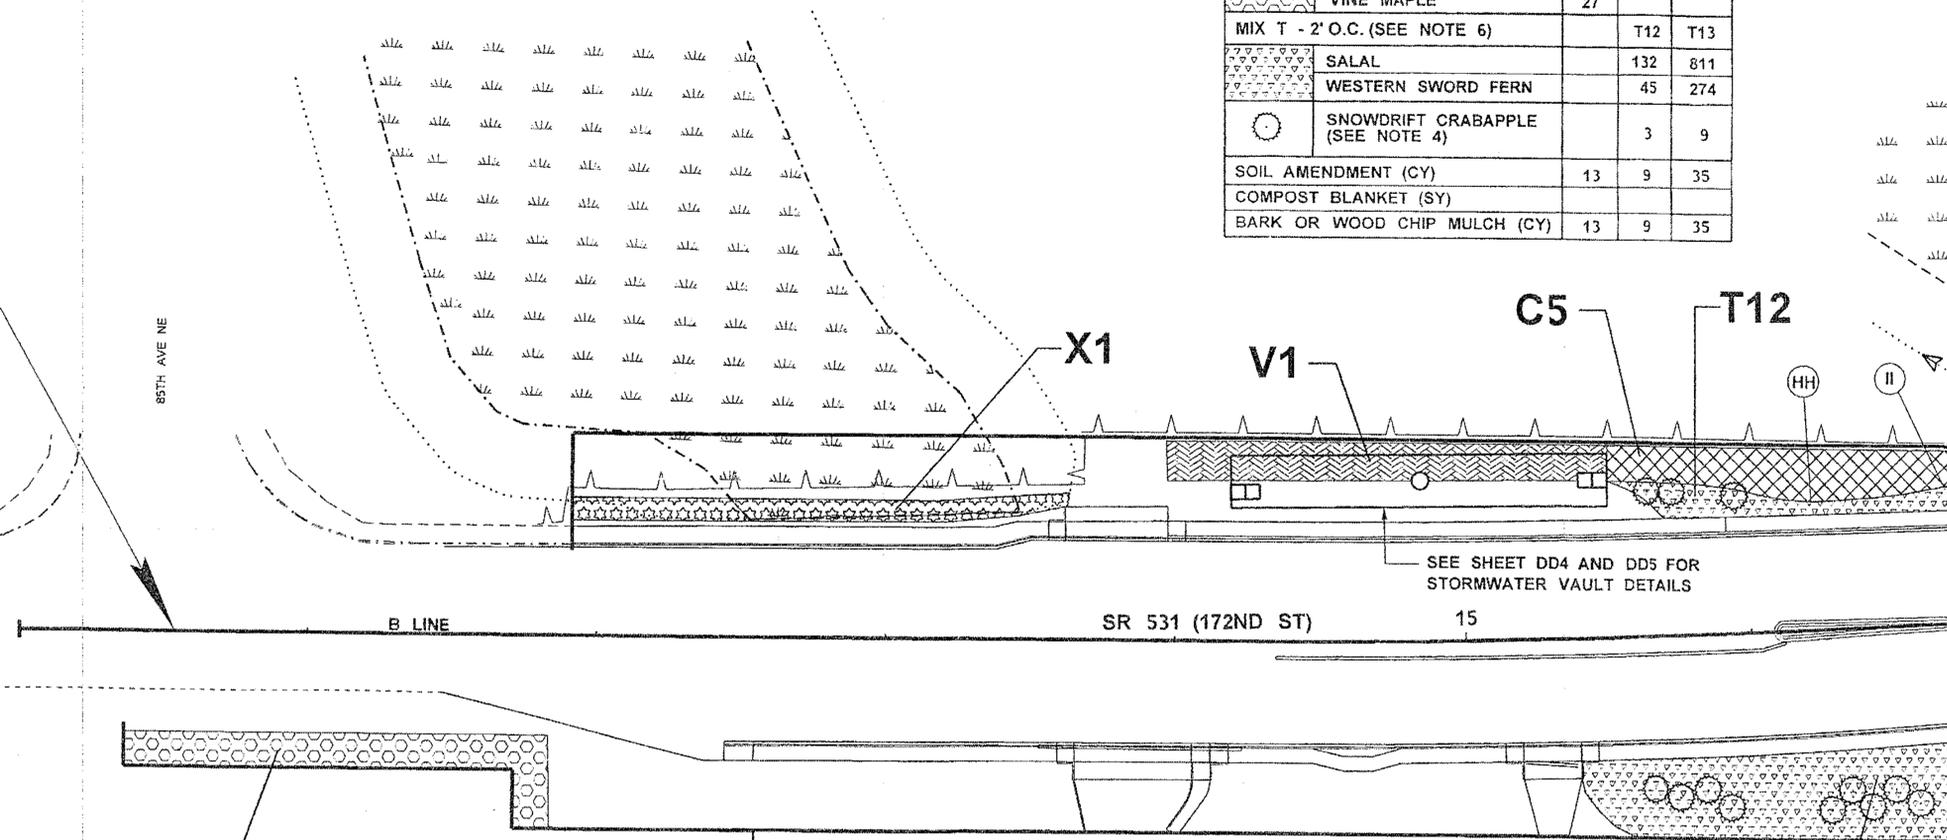


NOTES:

1. INSTALL TREES NO CLOSER THAN 8 FT. O.C.
2. INSTALL THREE PLANTS PER PLANTING LOCATION. SEE DETAIL, SHEET PLD2.
3. SEEDING, FERTILIZING AND MULCHING SHALL BE APPLIED TO ALL AREAS OF DISTURBED SOIL NOT DESIGNATED AS PLANTING AREAS. (ESTIMATED QUANTITY 0.16 AC. THIS SHEET).
4. LOCATIONS TO BE STAKED IN THE FIELD BY ENGINEER.
5. PLANTING AREAS OUTSIDE OF CLEARING AND GRUBBING LIMITS SHALL RECEIVE WEED CONTROL PRIOR TO PLANTING, IN ACCORDANCE WITH THE SPECIAL PROVISION PLANTING AREA WEED CONTROL.
6. SALAL SHALL BE SPACED AT 2' O.C. AND WESTERN SWORD FERN SHALL BE SPACED AT 4' O.C.

G4

LEGEND

- WETLAND
- WETLAND BUFFER
- ORDINARY HIGH WATER LINE
- STREAM BUFFER
- LIMITED ACCESS RIGHT OF WAY
- EDGE OF SHOULDER
- DITCH
- EXISTING VEGETATION - SAVE & PROTECT
- PLANTING AREA LAYOUT POINTS - SEE SHEET PLD1 FOR TABLE OF STATIONS AND OFFSETS

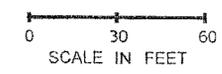


FOR "AS CONSTRUCTED PLANS" ONLY

FILE NAME T:\412006\XL3325 SR 9 & SR 531 J-CICADIPS&ESheets\Ad copy\XL3325_PS_LA_Ad.dgn		REGION NO. 10 STATE WASH		FED.AID PROJ.NO.		STATE OF WASHINGTON REGISTERED LANDSCAPE ARCHITECT		SR9		Plot 5	
TIME 5:52:11 PM		JOB NUMBER 10A042		CONTRACT NO.		DAVID S. PETERSON CERTIFICATE NO. 476 DATE: 09/28/11 EXPIRES: 02/04/2013		SR531/172ND ST NE & EAGLEFIELD DR INTERSECTION IMPROVEMENT & PAVING		PLAN REF NO PL5	
DATE 9/29/2011		LOCATION NO.		Washington State Department of Transportation		PLANTING PLAN		SHEET 109 OF 230 SHEETS			
PLOTTED BY frenchl											
DESIGNED BY L.FRENCH											
ENTERED BY K.McLEAN											
CHECKED BY J.HARTWIG											
PROJ. ENGR. S.SPAHR											
REGIONAL ADM. L. ENG		REVISION		DATE		BY					

QUANTITY TAB - THIS SHEET ONLY					
SYMBOL	ITEM	QUANTITY			
MIX F - 4' O.C.		F10			
x x x x	WESTERN RED CEDAR	67			
x x x x	BITTER CHERRY	22			
x x x x	INDIAN PLUM	67			
x x x x	RED ELDERBERRY	67			
x x x x	RED-OSIER DOGWOOD	90			
x x x x	SALMONBERRY	134			
MIX C - 4' O.C.		C6	C7		
▨	WESTERN RED CEDAR	13	9		
▨	INDIAN PLUM	28	20		
▨	RED ELDERBERRY	11	8		
▨	VINE MAPLE	28	20		
▨	WESTERN CRABAPPLE	11	8		
▨	THIMBLEBERRY	20	14		
MIX T - 2' O.C.				T14	T15
▨	SALAL			237	561
▨	WESTERN SWORD FERN			101	190
○	SNOWDRIFT CRABAPPLE			5	9
SOIL AMENDMENT (CY)				11	
COMPOST BLANKET (SY)		690	136	121	293
BARK OR WOOD CHIP MULCH (CY)		57	11	10	11
				24	

NOTES:


1. INSTALL TREES NO CLOSER THAN 8 FT. O.C.
2. IN AREAS OF EXISTING VEGETATION TO SAVE AND PROTECT, OUTER LIMITS OF PLANTING AREAS SHALL MATCH LIMITS OF CLEARING AND GRUBBING.
3. SEEDING, FERTILIZING AND MULCHING SHALL BE APPLIED TO ALL AREAS OF DISTURBED SOIL NOT DESIGNATED AS PLANTING AREAS. (ESTIMATED QUANTITY 0.16 AC. THIS SHEET).
4. LOCATIONS TO BE STAKED IN THE FIELD BY ENGINEER.
5. PLANTING AREAS OUTSIDE OF CLEARING AND GRUBBING LIMITS SHALL RECEIVE WEED CONTROL PRIOR TO PLANTING, IN ACCORDANCE WITH THE SPECIAL PROVISION PLANTING AREA WEED CONTROL.
6. PLANT SALAL AT 2' O.C. AND WESTERN SWORD FERN AT 4' O.C.

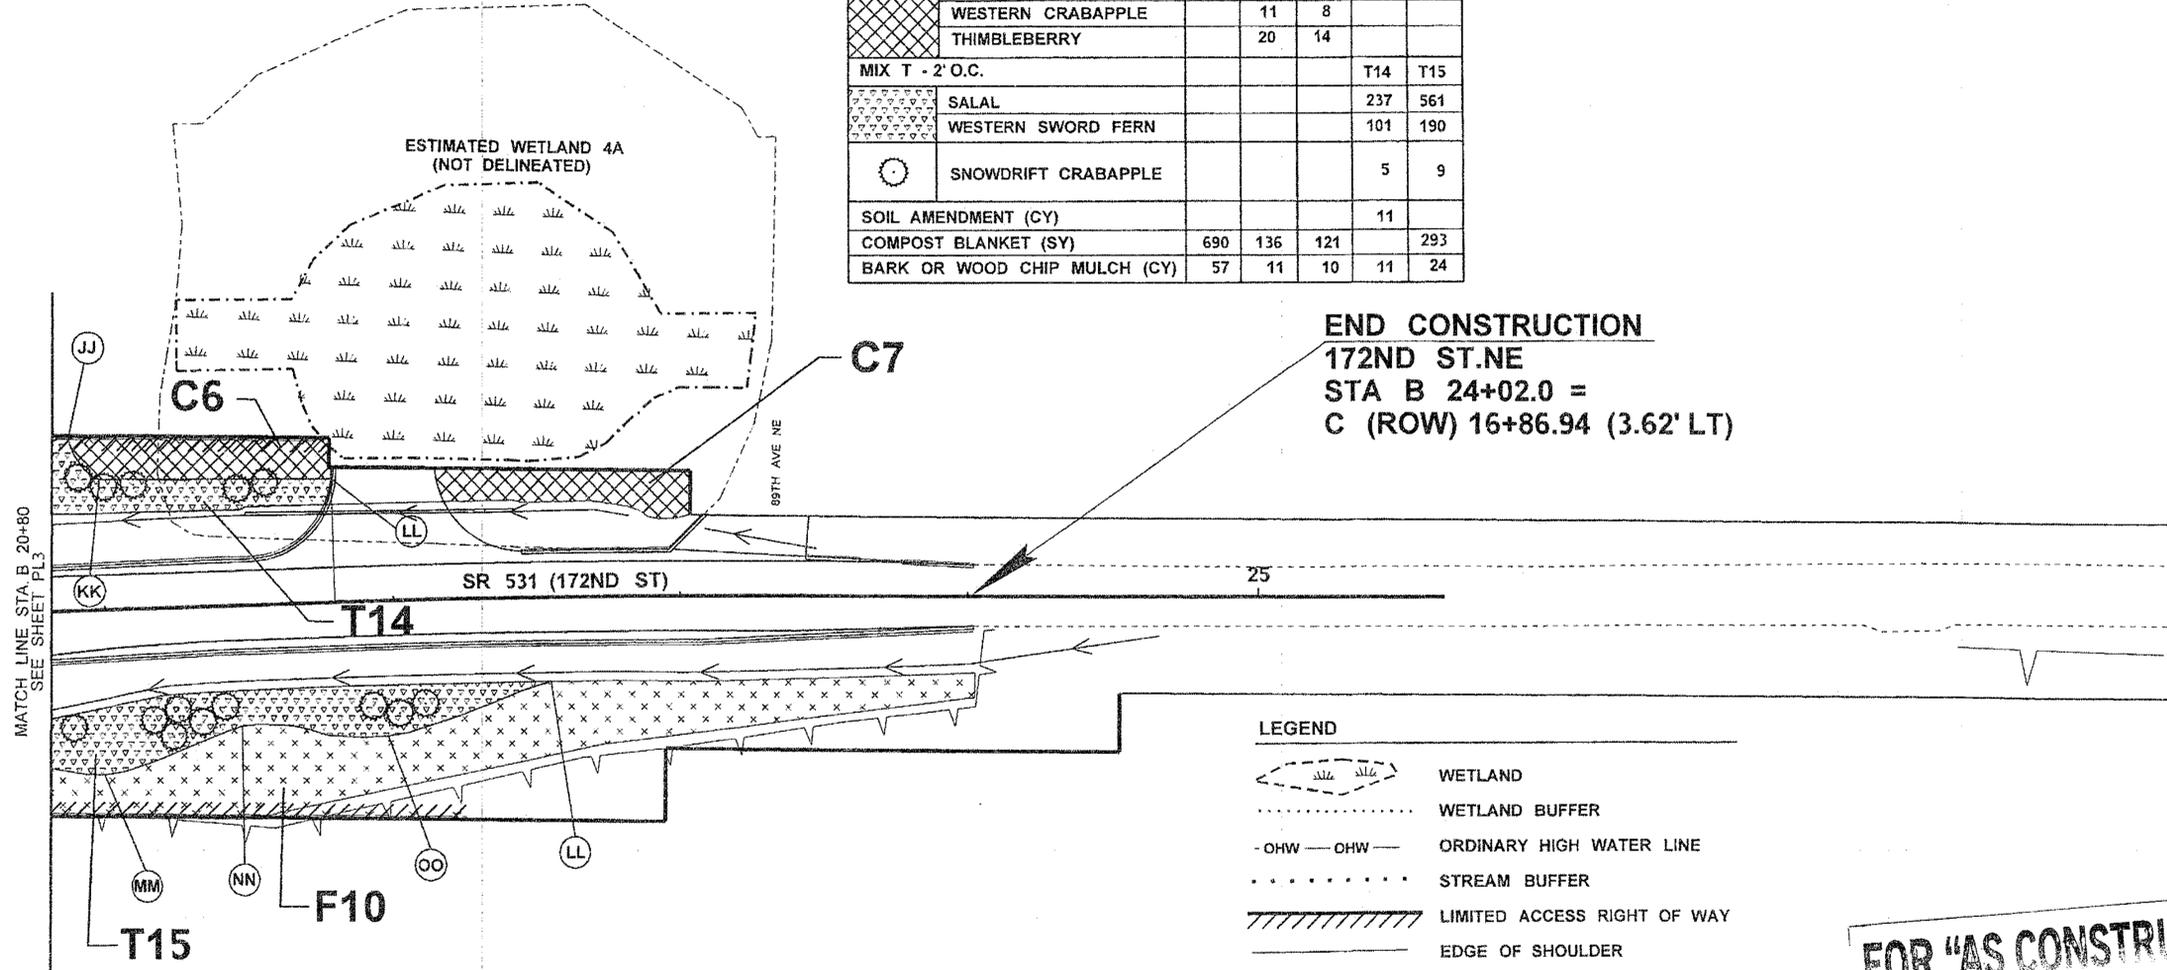

LEGEND

- WETLAND
- WETLAND BUFFER
- ORDINARY HIGH WATER LINE
- STREAM BUFFER
- LIMITED ACCESS RIGHT OF WAY
- EDGE OF SHOULDER
- DITCH
- EXISTING VEGETATION - SAVE & PROTECT
- PLANTING AREA LAYOUT POINTS - SEE SHEET PLD1 FOR TABLE OF STATIONS AND OFFSETS

FOR "AS CONSTRUCTED PLANS" ONLY

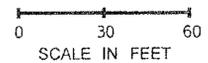

FILE NAME	T:\412006\XL3325 SR 9 & SR 531 I-CICADIPS&ESheets\Ad copy\XL3325 PS LA Ad.dgn		
TIME	5:52:13 PM		
DATE	9/28/2011		
PLOTTED BY	frenchj		
DESIGNED BY	L.FRENCH		
ENTERED BY	K.MCLEAN		
CHECKED BY	J.HARTWIG		
PROJ. ENGR.	S.SPAHR		
REGIONAL ADM.	L.ENG		
REVISION	DATE	BY	
REGION NO.	STATE	FED.AID PROJ.NO.	
10	WASH		
JOB NUMBER	CONTRACT NO.		
10A042			
	LOCATION NO.		

STATE OF WASHINGTON
REGISTERED
LANDSCAPE ARCHITECT

DAVID S. PETERSON
CERTIFICATE NO. 176
DATE: 09/28/11
EXPIRES: 02/04/2013

Washington State
Department of Transportation

SR9
SR531/172ND ST NE & EAGLEFIELD DR
INTERSECTION IMPROVEMENT & PAVING

PLANTING PLAN

Plot 6
PLAN REF NO PL6
SHEET 110 OF 230 SHEETS




QUANTITY TAB - THIS SHEET ONLY		
SYMBOL	ITEM	QUANTITY
	MIX L - 2' O.C.	L1
	SALAL	817
	MIX M - 2' O.C. (SEE NOTE 2)	M1
	SALAL	415
	VINE MAPLE	115
	WESTERN SWORD FERN	45
TREES		
	WESTERN HEMLOCK	4
	WESTERN RED CEDAR	4
	SNOWDRIFT CRABAPPLE	14
	COMPOST BLANKET (SY)	2844
	BARK OR WOOD CHIP MULCH (CY)	236


- NOTE:
1. TREES TO BE SPACED NO CLOSER THAN 8 FT. O.C.
 2. PLANT SALAL AT 2' O.C., WESTERN SWORD FERN AT A MINIMUM OF 4' O.C. AND VINE MAPLE AT A MINIMUM OF 8 O.C.
 3. LOCATIONS OF TREES TO BE STAKED IN THE FIELD BY ENGINEER.
 4. PLANTING AREA LIMITS TO BE LAID OUT IN THE FIELD BY ENGINEER.
 5. SEE SHEET PLD3 FOR THE ROUNDABOUT CONTOUR GRADING PLAN

LEGEND

	WETLAND
	WETLAND BUFFER
	ORDINARY HIGH WATER LINE
	STREAM BUFFER
	LIMITED ACCESS RIGHT OF WAY
	EDGE OF SHOULDER
	EXISTING VEGETATION - SAVE & PROTECT

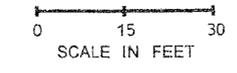

FOR "AS CONSTRUCTED"
PLANS

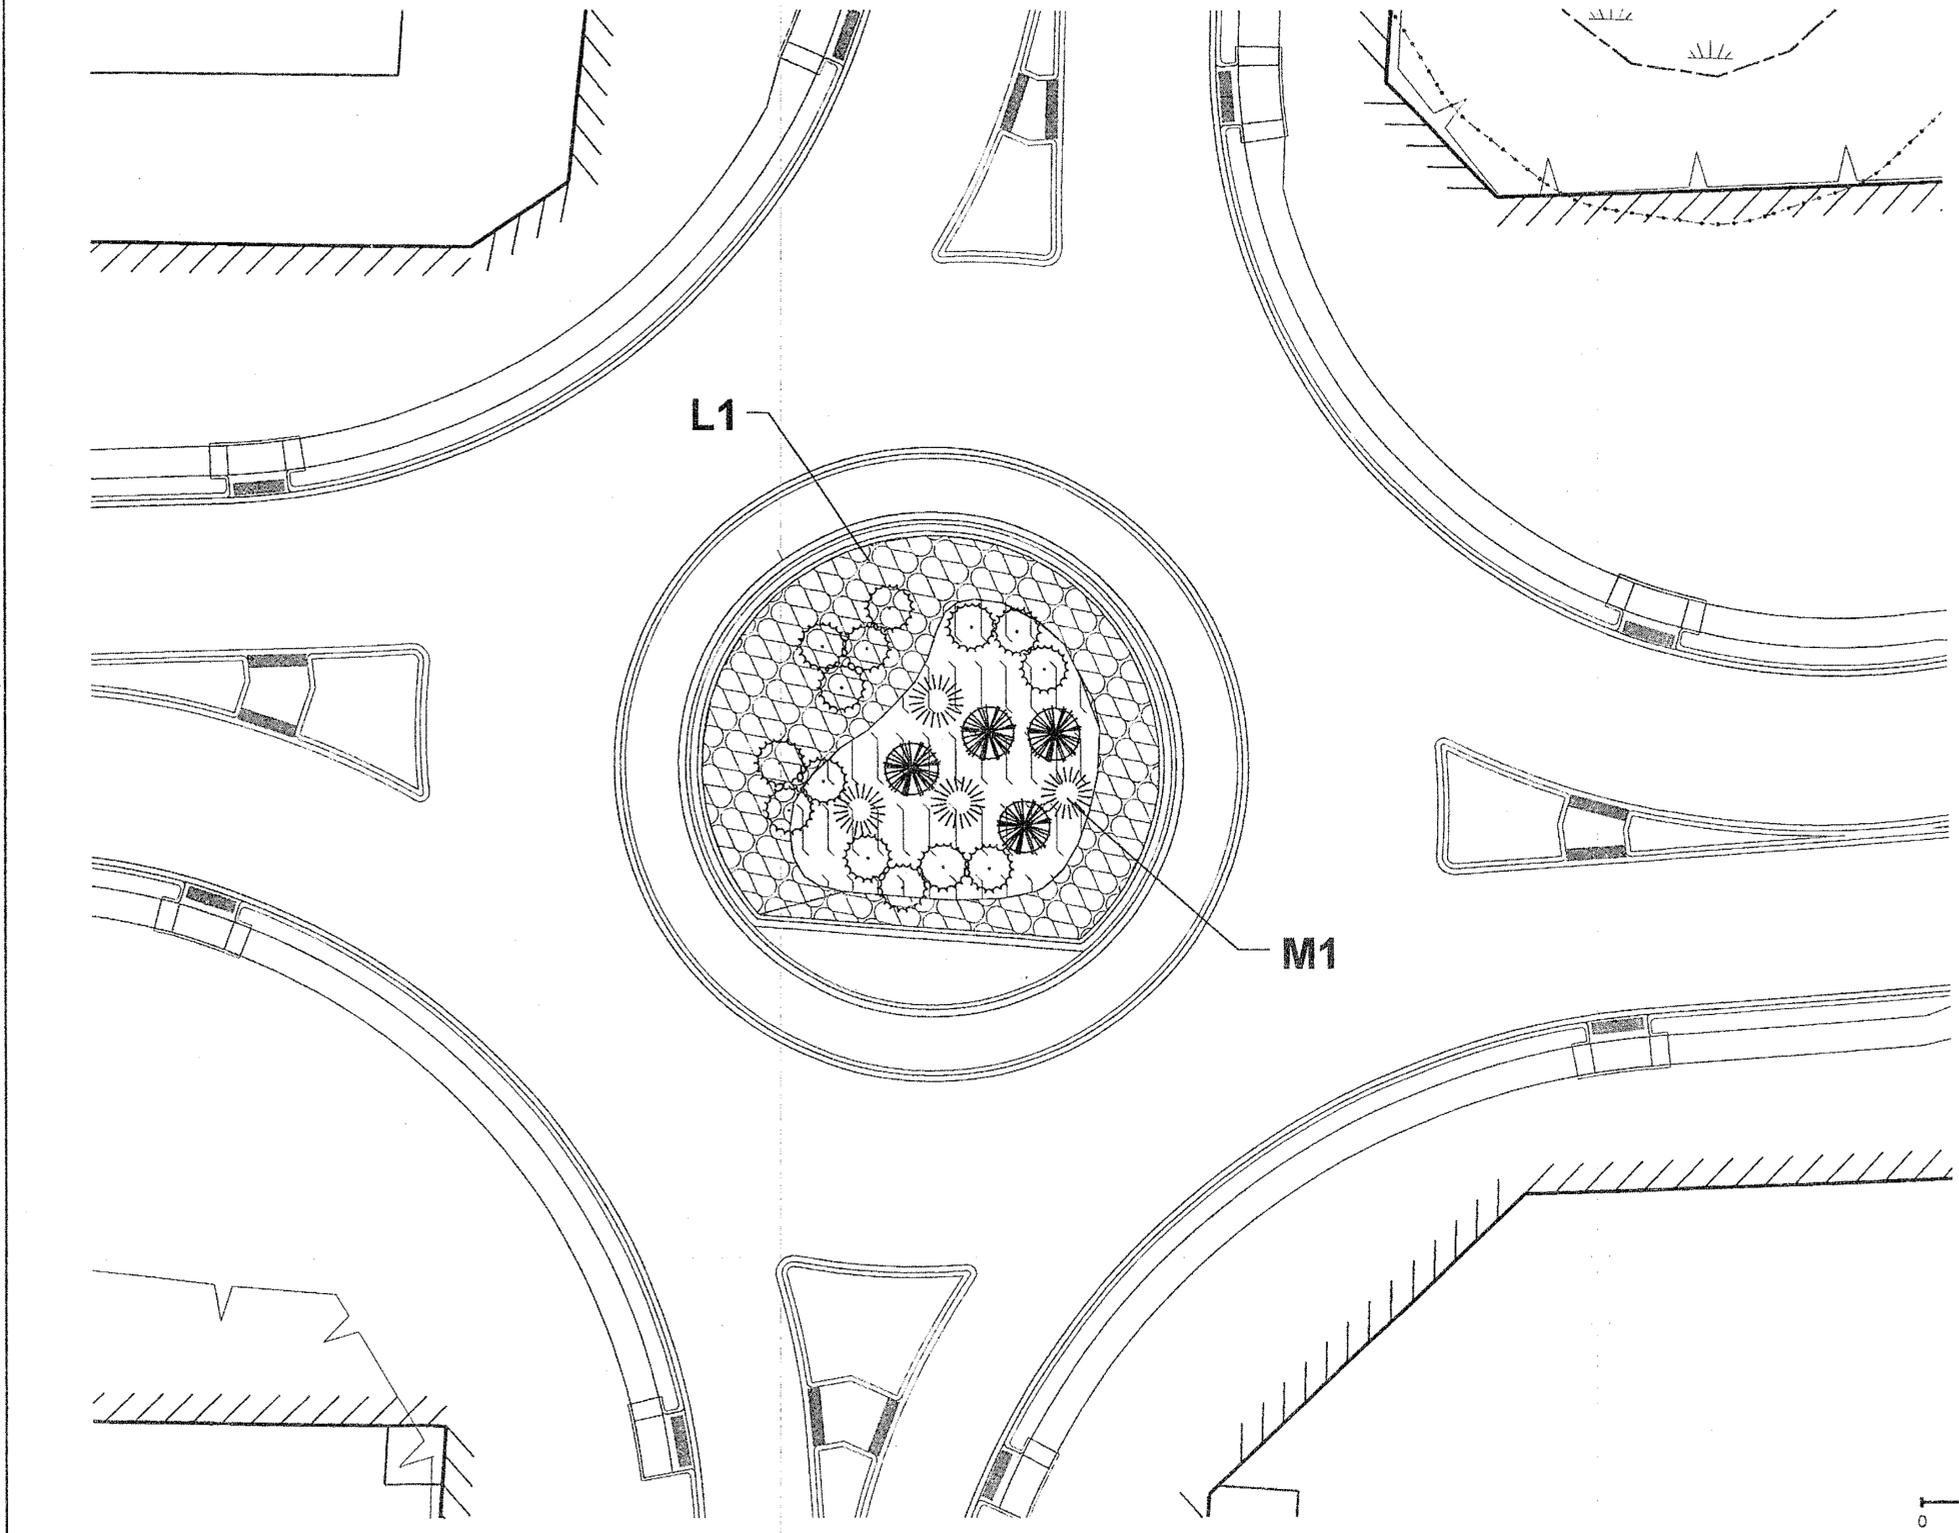

FILE NAME	T:\412006\XL3325 SR 9 & SR 531 I-CICADIPS&ESheets\Ad copy\XL3325_PS_LA_Ad.dgn		
TIME	9:27:06 AM		
DATE	9/22/2011		
PLOTTED BY	frenchl		
DESIGNED BY	L.FRENCH		
ENTERED BY	K.MCLEAN		
CHECKED BY	J.HARTWIG		
PROJ. ENGR.	S.SPAHR		
REGIONAL ADM.	L.ENG		
REVISION	DATE	BY	

REGION NO.	STATE	FED.AID PROJ.NO.
10	WASH	
JOB NUMBER	CONTRACT NO.	LOCATION NO.
10A042		

STATE OF WASHINGTON
REGISTERED
LANDSCAPE ARCHITECT

DAVID S. PETERSON
CERTIFICATE NO. 476
DATE: 09/22/11
EXPIRES: 02/04/2013

Washington State
Department of Transportation

SR9	Plot 7
SR531/172ND ST NE & EAGLEFIELD DR	PLAN REF NO PL7
INTERSECTION IMPROVEMENT & PAVING	SHEET 111 OF 230 SHEETS
PLANTING PLAN	

PLANT MATERIAL LIST

COMMON NAME	BOTANICAL NAME	QUANTITY	SIZE	ROOT CONDITION	REMARKS
TREES					
BITTER CHERRY	PRUNUS EMARGINATA	93	12 IN. HT.	NO. 1 CONT.	
WESTERN HEMLOCK	TSUGA HETEROPHYLLA	4	6 FT. HT.	BALL & BURLAP	NATURAL FORM, NO SHEARED TREES
SNOWDRIFT CRABAPPLE	MALUS 'SNOWDRIFT'	91	2 IN. CAL.	BALL & BURLAP	
WESTERN CRABAPPLE	MALUS FUSCA	170	12 IN. HT.	NO. 1 CONT.	
WESTERN REDCEDAR	THUJA PLICTA	4	6 FT. HT.	BALL & BURLAP	NATURAL FORM, NO SHEARED TREES
WESTERN REDCEDAR	THUJA PLICTA	471	18 IN. HT.	NO. 2 CONT.	NATURAL FORM, NO SHEARED TREES
SHRUBS					
BEAKED HAZELNUT	CORYLUS CORNUA	110	12 IN. HT.	NO. 1 CONT.	2 CANES MIN.
CASCARA	RHAMNUS PURSHIANA	13	12 IN. HT.	NO. 1 CONT.	2 CANES MIN.
DOUGLAS SPIRAEA	SPIRAEA DOUGLASII	88	12 IN. HT.	NO. 1 CONT.	2 CANES MIN.
INDIAN PLUM	OEMLERIA CERASIFORMIS	1285	12 IN. HT.	NO. 1 CONT.	2 CANES MIN.
NOOTKA ROSE	ROSA NUTKANA	160	12 IN. HT.	NO. 1 CONT.	2 CANES MIN.
RED ELDERBERRY	SAMBUCUS RACEMOSA	737	12 IN. HT.	NO. 1 CONT.	2 GROWTH POINTS MIN.
RED-OSIER DOGWOOD	CORNUS SERICEA	382	12 IN. HT.	NO. 1 CONT.	2 CANES MIN.
SALAL	GAULTHERIA SHALLON	10550	6 IN. SPREAD	NO. 1 CONT.	3 BRANCHES MIN.
SALMONBERRY	RUBUS SPECTABILIS	1520	12 IN. HT.	NO. 1 CONT.	2 CANES MIN.
SCOULER'S WILLOW	SALIX SCLOUERI	172	15 IN. HT.	NO. 1 CONT.	2 CANES MIN.
SNOWBERRY	SYMPHORICARPOS ALBUS	106	10 IN. HT.	NO. 1 CONT.	2 CANES MIN.
THIMBLEBERRY	RUBUS PARVIFOLUS	307	12 IN. HT.	NO. 1 CONT.	2 CANES MIN.
VINE MAPLE	ACER CIRCINATUM	695	12 IN. HT.	NO. 1 CONT.	3 FRONDS MIN.
WESTERN SWORD FERN	POLYSTICHUM MUNITUM	2642	6 IN. SPREAD		
EMERGENTS					
SLOUGH SEDGE	CAREX OBNUPTA	544		BARE ROOT OR PLUG	

NOTES:

- IF A CONFLICT OCCURS BETWEEN THE AMERICAN STANDARD FOR NURSERY STOCK AND THESE SPECIFICATIONS THEN THESE SPECIFICATIONS SHALL APPLY.
- SPECIFICATIONS FOR SIZE AND CONDITION ARE MINIMUM.
- ALL PLANT MATERIALS SHALL BE NURSERY GROWN STOCK.
- PLANTS SHALL BE RANDOMLY MIXED THROUGHOUT EACH PLANTING ZONE AS APPROVED BY THE ENGINEER. SEE SCHEDULE FOR MIN. GROUPINGS OF EACH SPECIES.
- ALL TREES REQUIRING STAKING SHALL BE STAKED AND SECURED WITHIN 48 HOURS AFTER PLANTING.
- ALL TREE/SHRUB PLANTINGS SHALL BE SETBACK A MIN. OF 5 FEET FROM ALL PAVEMENT EDGES, EXCEPT WHERE NOTED. (SEE SETBACK CHART)

PLANTING AREA LAYOUT POINTS

POINT	SR	STATION	OFFSET	POINT	SR	STATION	OFFSET	POINT	SR	STATION	OFFSET
SHT. PL1				SHT. PL3				SHT. PL4			
A	9	A 798+14.15	36.59' RT.	P	9	A 807+59.50	66.29' LT.	DD	9	A 816+16.37	36.42' RT.
SHT. PL2				Q	9	A 807+65.07	73.89' LT.	EE	9	A 816+28.32	49.23' RT.
B	9	A 799+24.62	39.34' RT.	R	9	A 808+17.74	87.14' LT.	FF	9	A 816+79.40	35.09' RT.
C	9	A 803+33.58	49.98' RT.	S	531	B 16+80.95	47.95' LT.	GG	9	A 817+41.40	38.97' RT.
D	9	A 805+37.67	57.01' RT.	T	531	B 17+68.00	56.45' LT.	SHT. PL5			
E	9	A 806+46.66	63.06' RT.	U	9	A 808+78.80	72.12' RT.	HH	531	B 16+22.48	44.79' LT.
F	9	A 806+46.66	84.89' RT.	V	9	A 809+09.11	84.11' RT.	II	531	B 16+68.86	47.27' LT.
G	9	A 805+29.87	85.30' RT.	W	531	B 20+05.88	51.97' RT.	SHT. PL6			
H	9	A 803+16.25	84.96' RT.	X	9	A 811+64.60	75.30' RT.	JJ	531	B 20+88.54	65.02' LT.
I	9	A 801+06.18	84.96' RT.	Y	9	A 811+76.42	63.07' RT.	KK	531	B 21+00.00	44.80' LT.
J	9	A 798+50.00	53.85' LT.	Z	9	A 812+65.11	53.95' RT.	LL	531	B 21+79.83	42.19' LT.
K	9	A 801+54.42	59.93' LT.	AA	9	A 813+22.52	60.61' RT.	MM	531	B 20+98.00	56.50' RT.
L	9	A 805+32.90	45.88' LT.	BB	9	A 813+96.78	55.99' RT.	NN	531	B 21+46.11	41.05' RT.
M	9	A 805+32.01	65.45' LT.	CC	9	A 814+39.78	53.50' RT.	OO	531	B 21+96.80	46.37' RT.
N	9	A 806+07.63	75.00' LT.					PP	531	B 22+54.82	29.01' RT.
O	9	A 806+75.15	88.00' LT.								


PLANT MATERIAL SETBACK CHART

THIS CHART SUPPLEMENTS SECTION 8.02.3(7) OF THE STANDARD SPECIFICATIONS

	GUARDRAIL BARRIER	EDGE OF ROADWAY	WALL	FENCE	SIGNS	EXISTING TREE, TRUNK	EXISTING VEGETATION MASS
EVERGREEN TREE	10'	10'	10'	10'	15'	8'	8'
DECIDUOUS TREE	10'	10'	10'	10'	15'	8'	8'
SHRUB	5'	10'	5'	5'	6'	4'	4'

TYPICAL SETBACKS FOR PLANT MATERIAL UNLESS OTHERWISE ADJUSTED BY THE ENGINEER DURING LAYOUT AND STAKING OF PLANT LOCATIONS. DISTANCE NOTED IS TO STEM OR TRUNK OF PLANT.

FOR "AS CONSTRUCTED" PLANTING

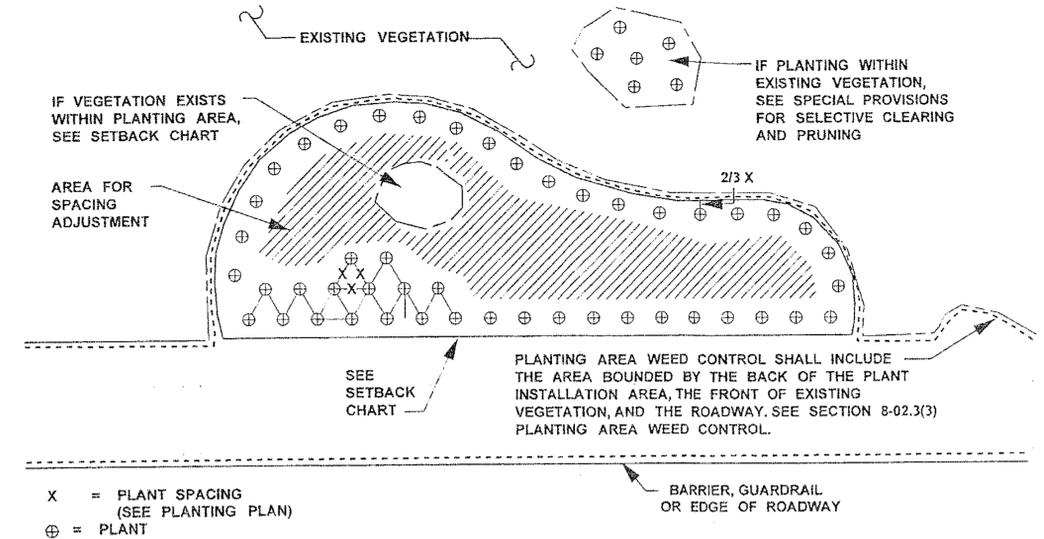

PLANTING AREA LAYOUT, SETBACK, AND WEED CONTROL

NOT TO SCALE

FILE NAME T:\412006\XL3325 SR 9 & SR 531 I-CICADIPS&ESheets\Addendum\XL3325 PS LA DET.dgn

TIME 8:44:23 AM

DATE 10/24/2011

PLOTTED BY frenchl

DESIGNED BY L. FRENCH

ENTERED BY K. McLEAN

CHECKED BY J. HARTWIG

PROJ. ENGR. S. SPAHR

REGIONAL ADM. L. ENG

REVISED PLANT QUANTITY LIST

10/24/11

LF

REGION NO. 10 STATE WASH

JOB NUMBER 10A042

CONTRACT NO.

FED. AID PROJ. NO.

LOCATION NO.

REVISION

DATE

BY



STATE OF WASHINGTON REGISTERED LANDSCAPE ARCHITECT
 DEBORAH K. PETERS
 CERTIFICATE NO. 969
 DATE: 10/24/11
 For Changes

Washington State Department of Transportation

SR 9 SR531/172ND ST NE & EAGLEFIELD DR INTERSECTION IMPROVEMENT & PAVING


PLANTING DETAILS

Plot 1

PLAN REF NO

PLD1

SHEET 112 OF 230 SHEETS

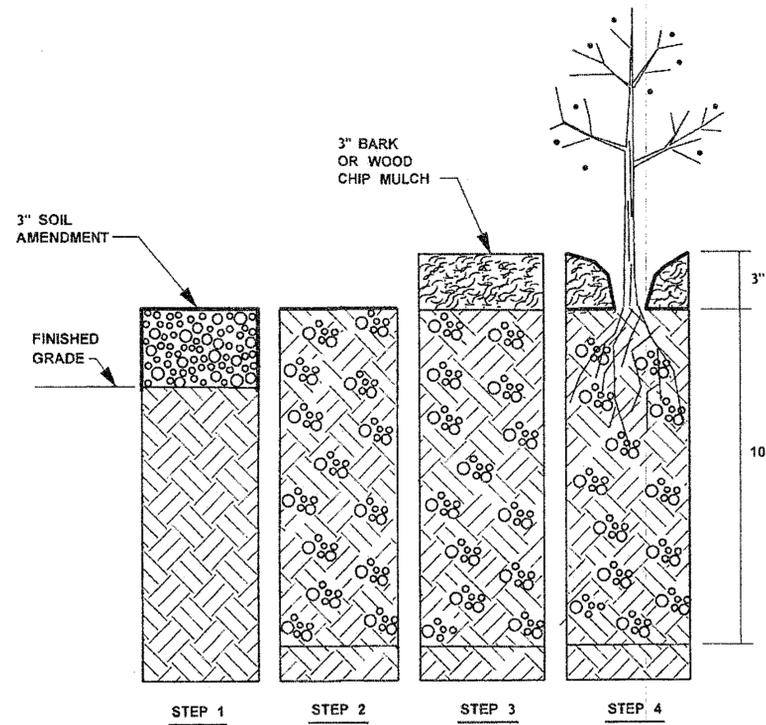

PLANTING AREA PREPARATION
(SEE SECTION 8-02.3(5) IN THE
SPECIAL PROVISIONS)

STEP 1

PLACE 3" SOIL AMENDMENT

STEP 2


INCORPORATE SOIL AMENDMENT
TO 10" DEPTH ACCORDING TO
SECTION 8-02.3(6), SOIL AMENDMENT
IN THE SPECIAL PROVISIONS

STEP 3

INSTALL BARK OR WOOD
CHIP MULCH 3" DEEP
(SEE PLANTING DETAIL)

STEP 4

INSTALL PLANT
(SEE PLANTING DETAIL)

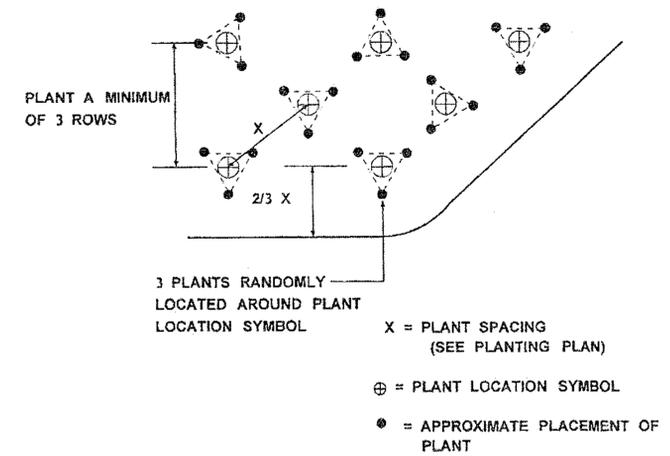

**SALAL, AND SLOUGH SEDGE
PLANT LAYOUT**


NOT TO SCALE





PLANTING AREA SOIL PREPARATION - SEQUENCE OF WORK

SECTION VIEW


NOT TO SCALE

**FOR "AS CONSTRUCTED
PLANS" ONLY**

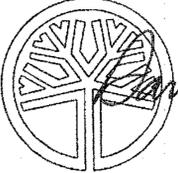
FILE NAME T:\412006\XL3325 SR 9 & SR 531 I-CICADIPS&ESheets\Ad copy\XL3325 PS LA DET Proof.dgn				REGION NO. STATE		FED.AID PROJ.NO.		 STATE OF WASHINGTON REGISTERED LANDSCAPE ARCHITECT <i>David S. Peterson</i> DAVID S. PETERSON CERTIFICATE NO. 916 DATE: 09/22/11 EXPIRES: 02/04/2013	 Washington State Department of Transportation	SR 9		Plot 2
TIME	9:13:14 AM			10	WASH		SR531/172ND ST NE & EAGLEFIELD DR			PLAN REF NO PLD2		
DATE	9/22/2011			JOB NUMBER	10A042		INTERSECTION IMPROVEMENT & PAVING			SHEET 113 OF 230 SHEETS		
PLOTTED BY	frenchl			CONTRACT NO.		LOCATION NO.				PLANTING DETAILS		
DESIGNED BY	L. FRENCH											
ENTERED BY	K.McLEAN											
CHECKED BY	L.GRANT											
PROJ. ENGR.	S.SPAHR											
REGIONAL ADM.	L.ENG			REVISION		DATE	BY					

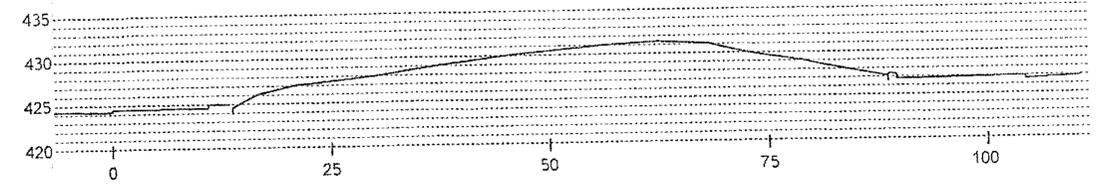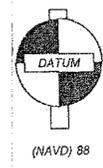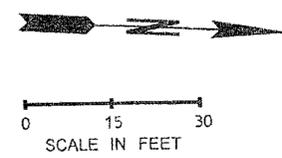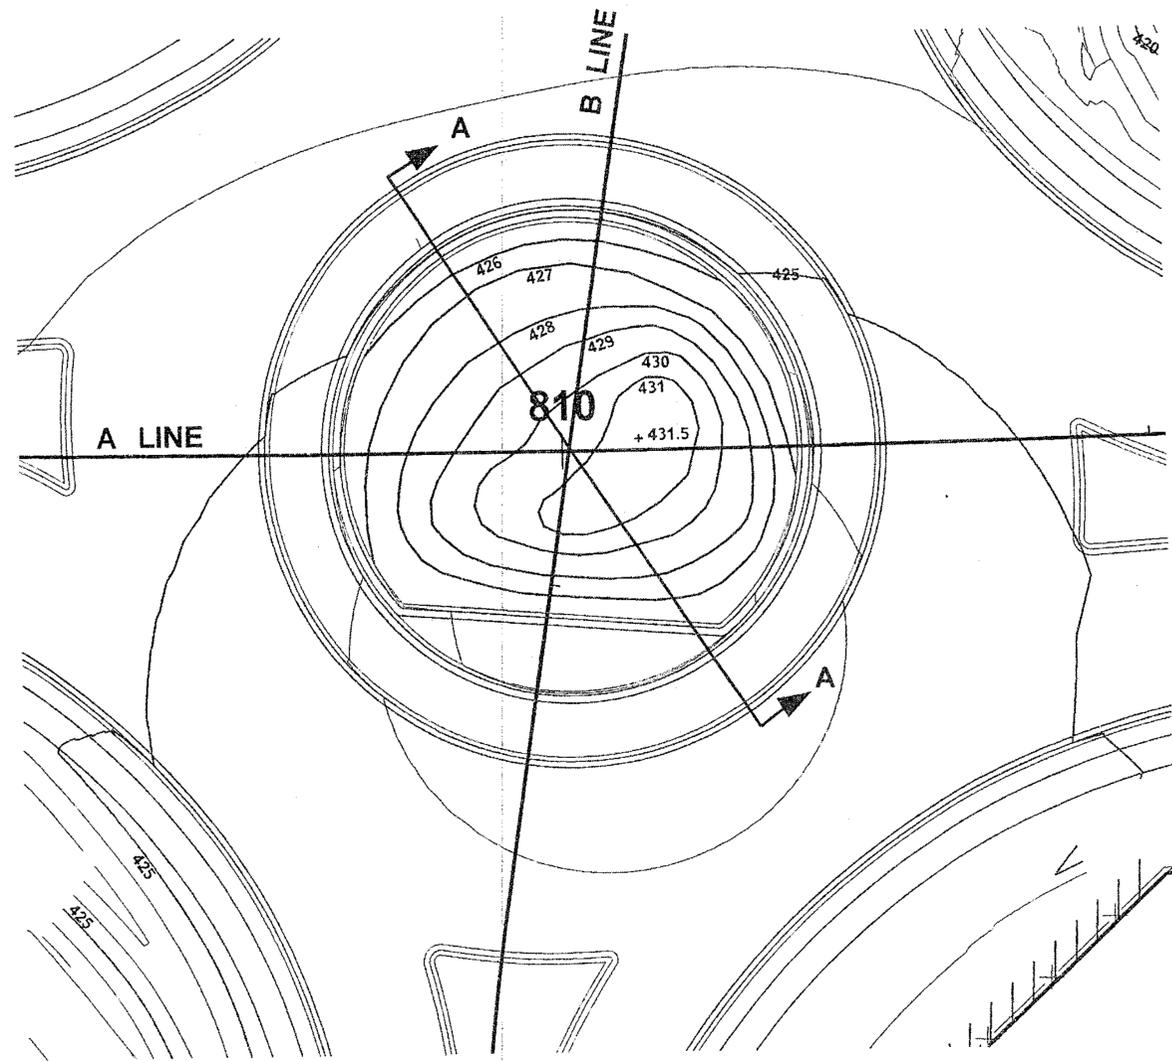

SECTION A-A

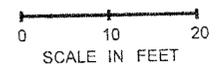

FOR "AS CONSTRUCTED PLANS"

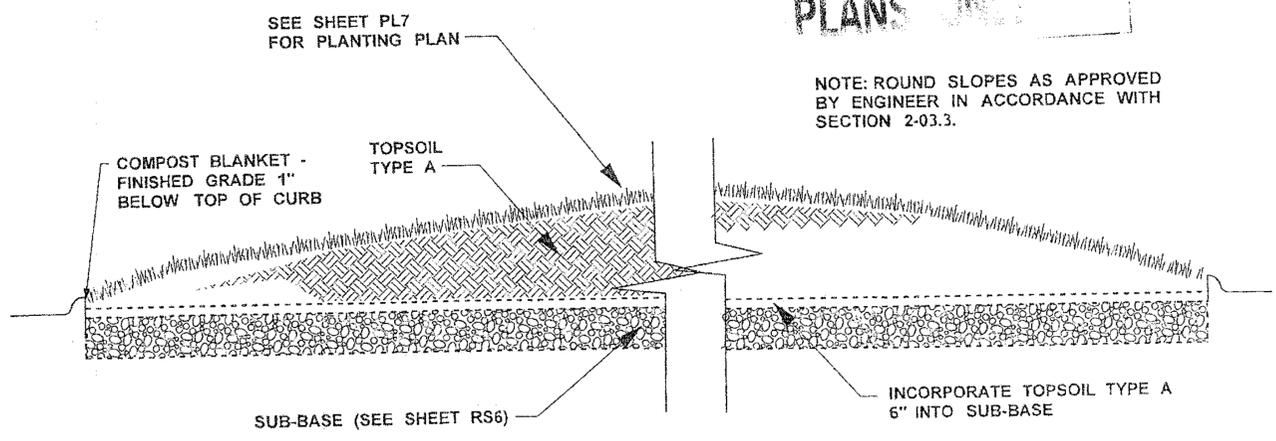

NOTE: ROUND SLOPES AS APPROVED BY ENGINEER IN ACCORDANCE WITH SECTION 2-03.3.

CENTER ISLAND SOIL PREPARATION - SECTION VIEW

NOT TO SCALE

FILE NAME	T:\412006\XL3325 SR 9 & SR 531 I-CICADIPS&ESheets\Ad copy\XL3325_PS_LA_Ad.dgn		
TIME	9:27:08 AM		
DATE	9/22/2011		
PLOTTED BY	frenchl		
DESIGNED BY	L.FRENCH		
ENTERED BY	K.MCLEAN		
CHECKED BY	J.HARTWIG		
PROJ. ENGR.	S.SPAHR		
REGIONAL ADM.	LENG		
REVISION	DATE	BY	
REGION NO.	STATE	FED.AID PROJ.NO.	
10	WASH		
JOB NUMBER		LOCATION NO.	
10A042			
CONTRACT NO.			

STATE OF WASHINGTON
REGISTERED
LANDSCAPE ARCHITECT
David S. Peterson
DAVID S. PETERSON
CERTIFICATE NO. 176
DATE: 09/22/11
EXPIRES: 02/04/2013

Washington State
Department of Transportation

SR9
SR531/172ND ST NE & EAGLEFIELD DR
INTERSECTION IMPROVEMENT & PAVING
PLANTING DETAILS

Plot 8
PLAN REF NO
PLD3
SHEET
114
OF
2