
			_				
AutoCad Drawing Date: 9/1/05	AutoCad As-built Drawn By: Fred Rapelyea	Inspected By: Henry Spencer	Date Inspected: 01/05/60	Lot Number: NA	Development Name: NA	Permit Number: 18	Property Address 115 N French

## FILE COPY

Z

4" Concrete pipe installed at 2% No further information provided by inspector

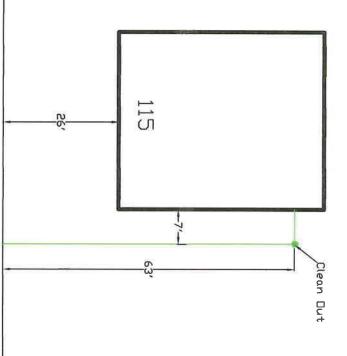

N French Street