
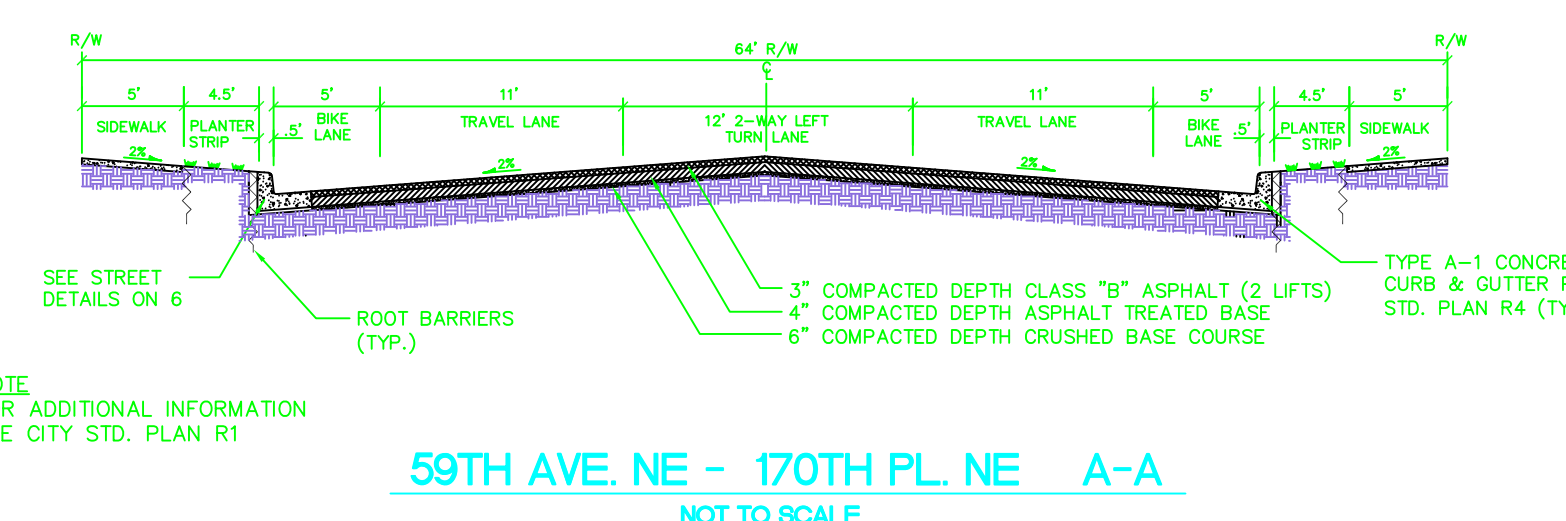
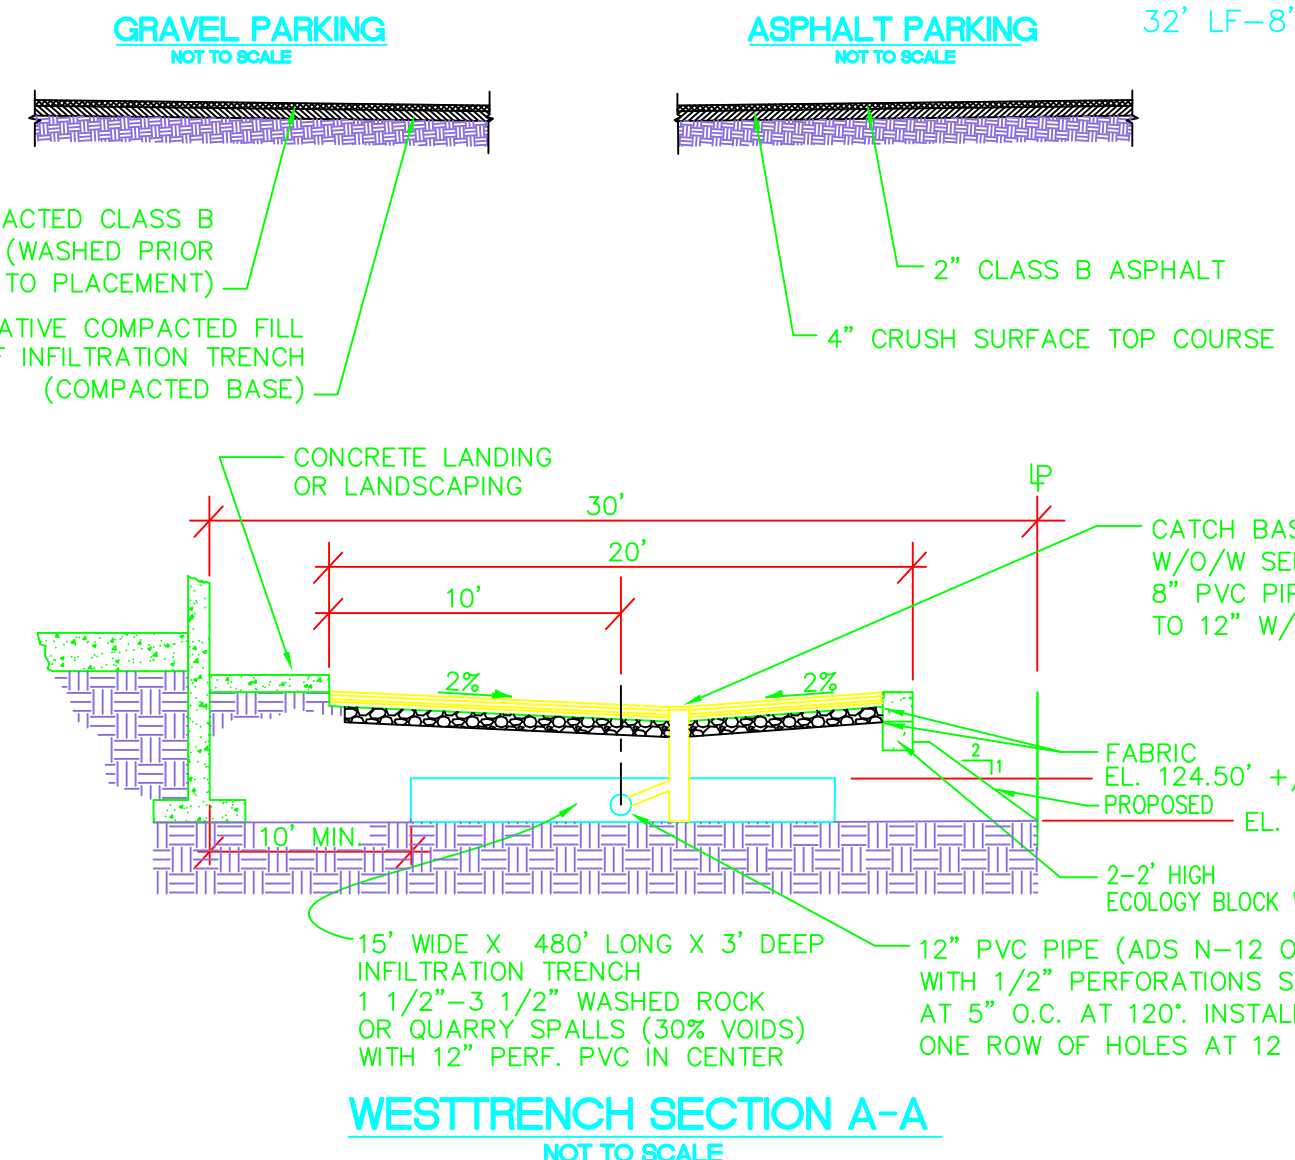


NOTE:
ALL PIPE SHALL BE
PVC, ADS N-12, CPEP OR
OTHER APPROVED EQUAL.

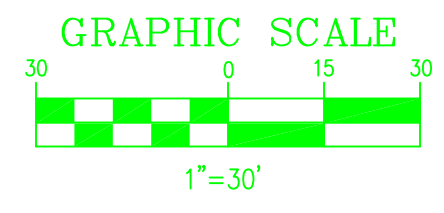

CITY OF ARLINGTON
AS-BUILT CONSTRUCTION DRAWING REVIEW
ACKNOWLEDGEMENT

THIS AS-BUILT PLAN SHEET HAS BEEN REVIEWED AND ACCEPTED AS A RECORD DRAWING. THE LICENSED DESIGN ENGINEER WHOSE STAMP AND SIGNATURE APPEAR ON THIS SHEET ASSUMES FULL AND COMPLETE RESPONSIBILITY FOR THE ACCURACY THEREIN.

By: _____
Date: _____

CONSTRUCTION DRAWING REVIEW
ACKNOWLEDGEMENT

THIS PLAN SHEET HAS BEEN REVIEWED AND EVALUATED FOR GENERAL COMPLIANCE WITH THE CITY OF ARLINGTON ORDINANCES AND REGULATIONS. CONFORMANCE WITH THIS DESIGN WITH ALL APPLICABLE LAWS AND REGULATIONS IS THE FULL AND COMPLETE RESPONSIBILITY OF THE LICENSED DESIGN ENGINEER WHOSE STAMP AND SIGNATURE APPEAR ON THIS SHEET. ACKNOWLEDGEMENT OF CONSTRUCTION DRAWING REVIEW DOES NOT IMPLY CITY APPROVAL FOR CONSTRUCTION ACTIVITIES THAT REQUIRE OTHER COUNTY, STATE OR FEDERAL PERMIT REVIEW AND APPROVAL. THE PROPERTY OWNER AND LICENSED DESIGN ENGINEER SHALL BE RESPONSIBLE FOR THE ACQUISITION AND COMPLIANCE OF ALL APPLICABLE PERMITS AND/OR AUTHORIZATIONS WHICH MAY INCLUDE, BUT ARE NOT LIMITED TO, NEIGHBORHOOD PROJECT APPROVAL (NPA), INSIDE NOTICE OF INTENT (NOI), ANY CORP. OF ENGINEERS FILL PERMITS AND THE REQUIREMENTS OF THE ENDANGERED SPECIES ACT.

By: _____
Date: _____

DATE OF FIELD SURVEY:	
FIELD BOOK NO.:	
DATE:	11-07-06
DRAWN BY:	JPP
CHECKED BY:	TWT
JOB NO.:	04-005

TREPANIER ENGINEERING
PROFESSIONAL CIVIL ENGINEERING

1601 BROADWAY
EVERETT, WA, 98201
PHONE: (425) 259-5556
FAX: (425) 259-5558

GRADING AND DRAINAGE: AS-BUILTS

4-T DEVELOPMENT
59TH AVE. NE DEVELOPMENT
ARLINGTON, WASHINGTON
SNOHOMISH COUNTY