


**FILE COPY**

Property Address: 1010 East 5th Street
Permit Number: 111
Development Name: NA
Lot Number: NA
Date Inspected: 01/07/60
Inspected By: Henry Spencer
AutoCad As-built Drawn By: Fred Rapelyea
AutoCad Drawing Date: 1/22/07

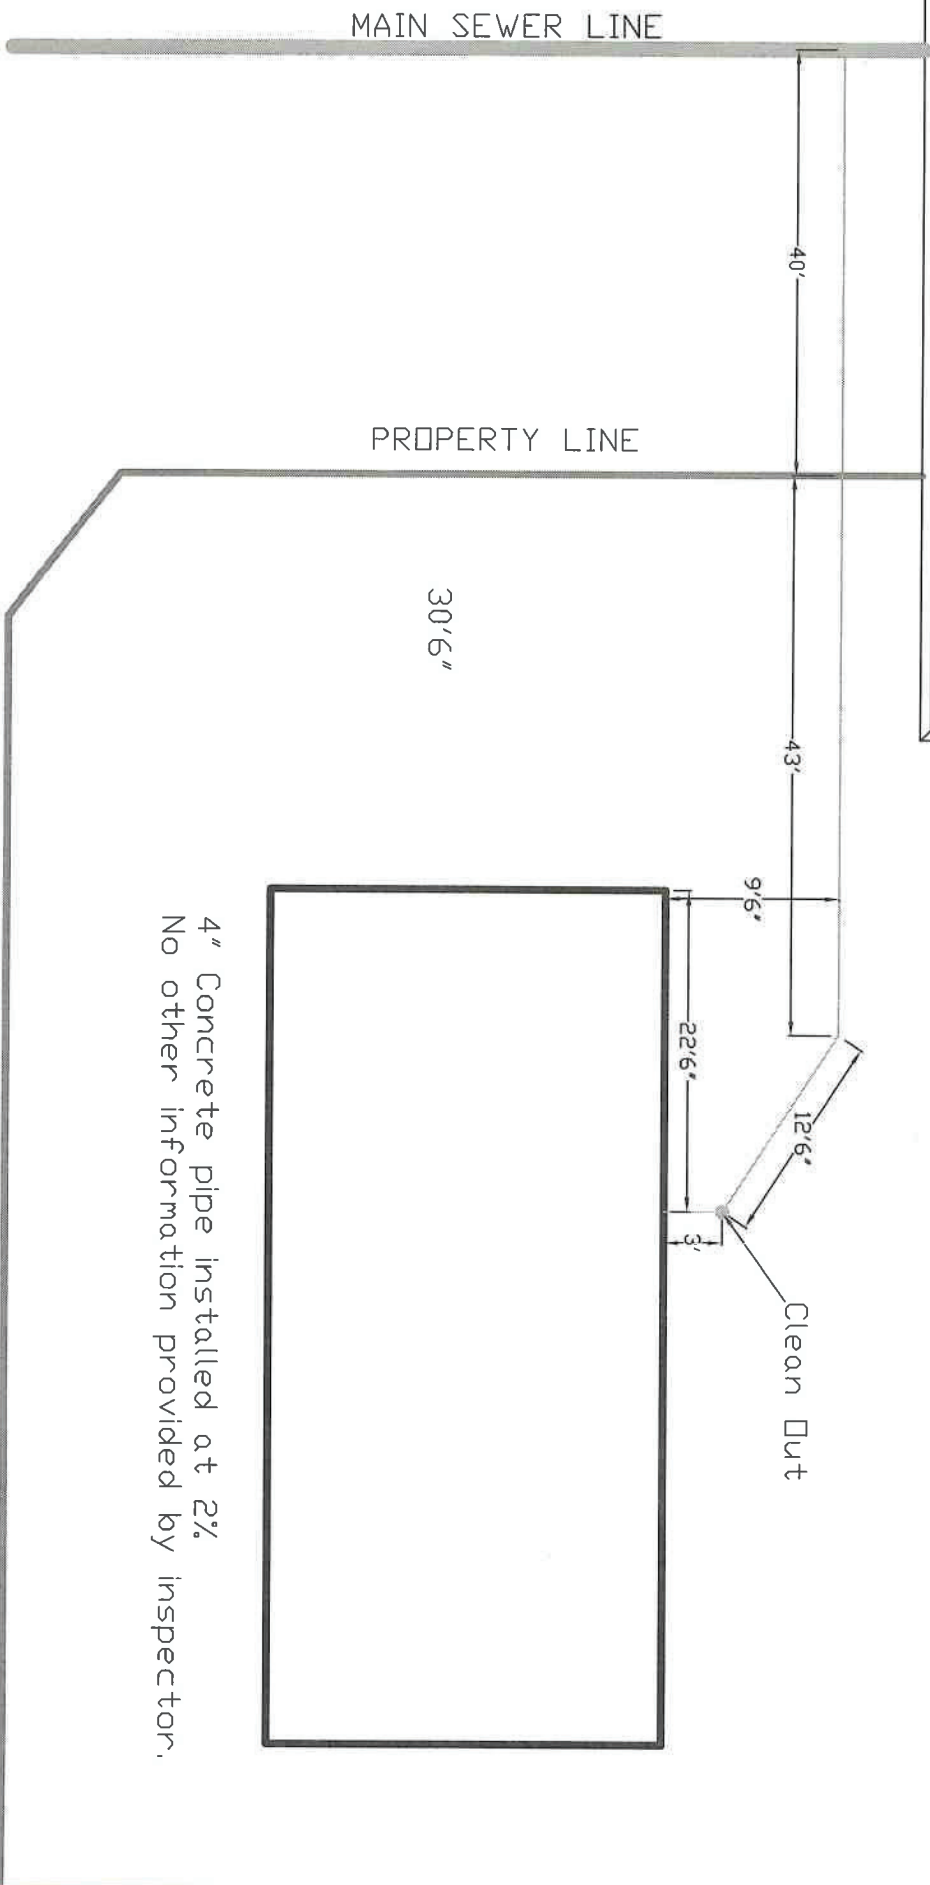

4" Concrete pipe installed at 2%  
No other information provided by inspector.