


FILE COPY

Property Address:	101 South Stillaguamish
Permit Number:	98
Development Name:	NA
Lot Number:	NA
Date Inspected:	01/5/60
Inspected By:	Henry Spencer
AutoCad As-built Drawn By:	Fred Rapelyea
AutoCad Drawing Date:	1/04/06



*4" Concrete pipe installed at 2%.
Pipe connection at house is 16" deep.

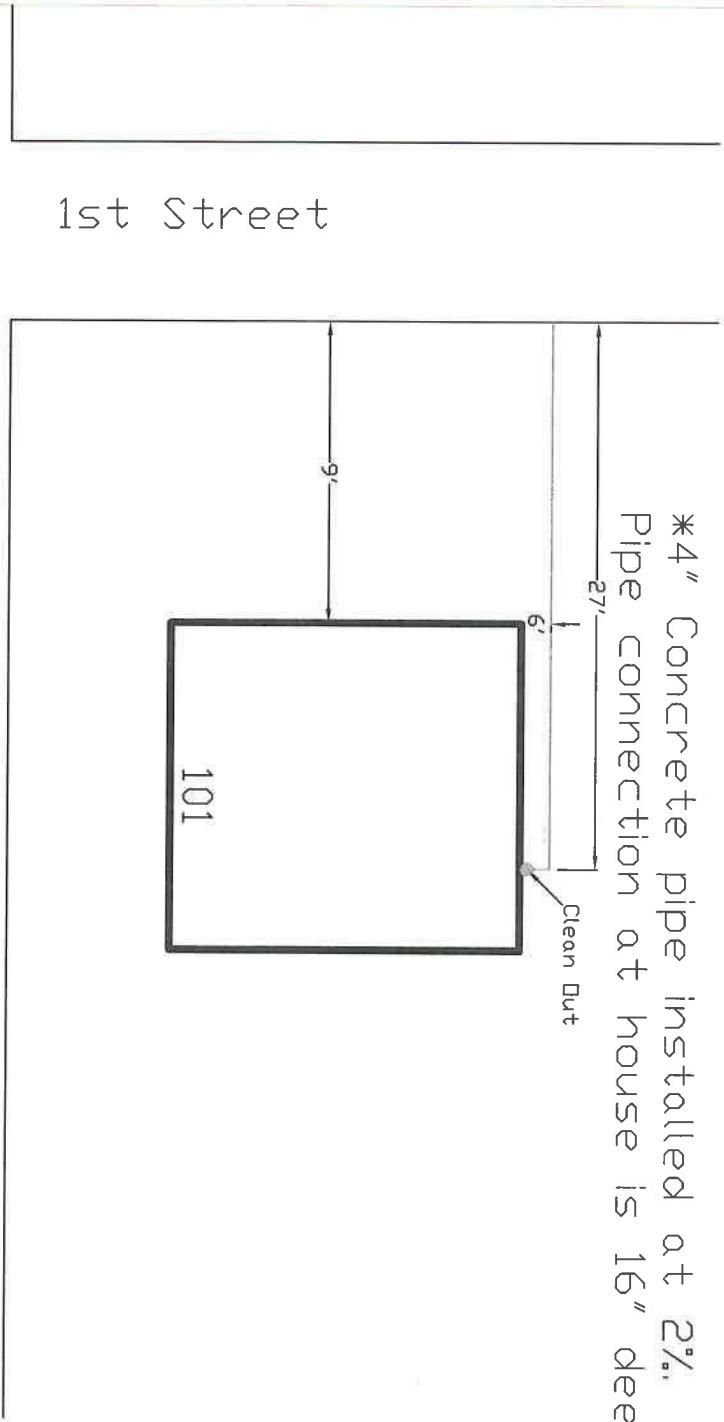

South Stillaguamish