

THE TOWN OF ARLINGTON

SEWER DEPARTMENT


Side Street Plat
(PREPARE IN DUPLICATE)

Permit No. 49

4590

Owner's Name Charles W. Dunham
 Owner's Mailing Address 102 - S. Dunham
 Legal Description of Premises Lot 3 Leo S. 12' Block 8 Arlington Add.
 Address of Property 102 - S. Dunham
 Side Sewer Contractor Dunham and Sons Co.
 Mailing Address 4608 - 36th S.W., Seattle

S-Dunham

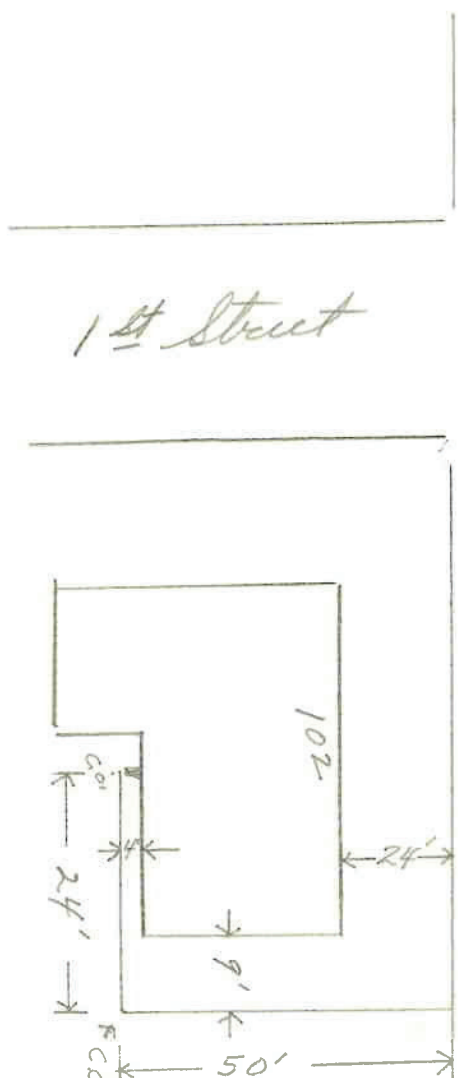

06-1700.0

1. Commercial..... Single Residence..... Multiple Dwelling..... Joint Use.....
2. Distance from property line to sewer line.....
3. Distance from house building line to property line..... From property line to bldg. 24'
4. Min. grade from main to property line.....
5. Distance from M. H. No.
6. Depth: Sewer main..... Basement connection..... (Reference to first floor)
7. Basement.....
8. Depth of pipe at house connection..... Vitrified Clay..... Asbestos-Cement..... Size.....
9. Type of pipe: Concrete.....
10. Remarks:

COMMERCIAL ONLY

1. Name
2. Type
3. Sq. Ft. Floor Space
4. No. of Floors
5. Remarks:

SPECIAL AGREEMENTS

1. Grade Release
2. High Grade Release
3. Non-Profiting Agmt.
4. Easement
5. Permission to Connect
6. Special

I hereby certify that the above connection has been made as shown:
 Inspector Henry J. Boller Date 1/14/40
 Date Permit Issued..... Permit No. 49