



SIDE SEWER INSPECTION FORM

Department of Public Works • Utilities Division



City of Arlington • 154 W. Cox Street • Arlington, WA 98223 • Phone (360) 403-3526

Site Address: 103 N Dunham
 Project Name: Iris Ingram
 Permit #: 178
 Completed By: _____
 Requested By: Kevin Burke
 Firm/Developer: _____
 Contact Person: Kevin Burke

Sewer Permit #: 367
 Lot #: _____
 Phase: _____
 Side Sewer #: _____
 Inspector: Rock Talbot
 Contractor: Oso Plumbing
 Phone: 360-631-1313

Staff Comments: OSD PLUMBING HAD NOT CONNECTED 4" c/o to home AT TIME OF INSPECTION.

Final inspection complete 12-17-13

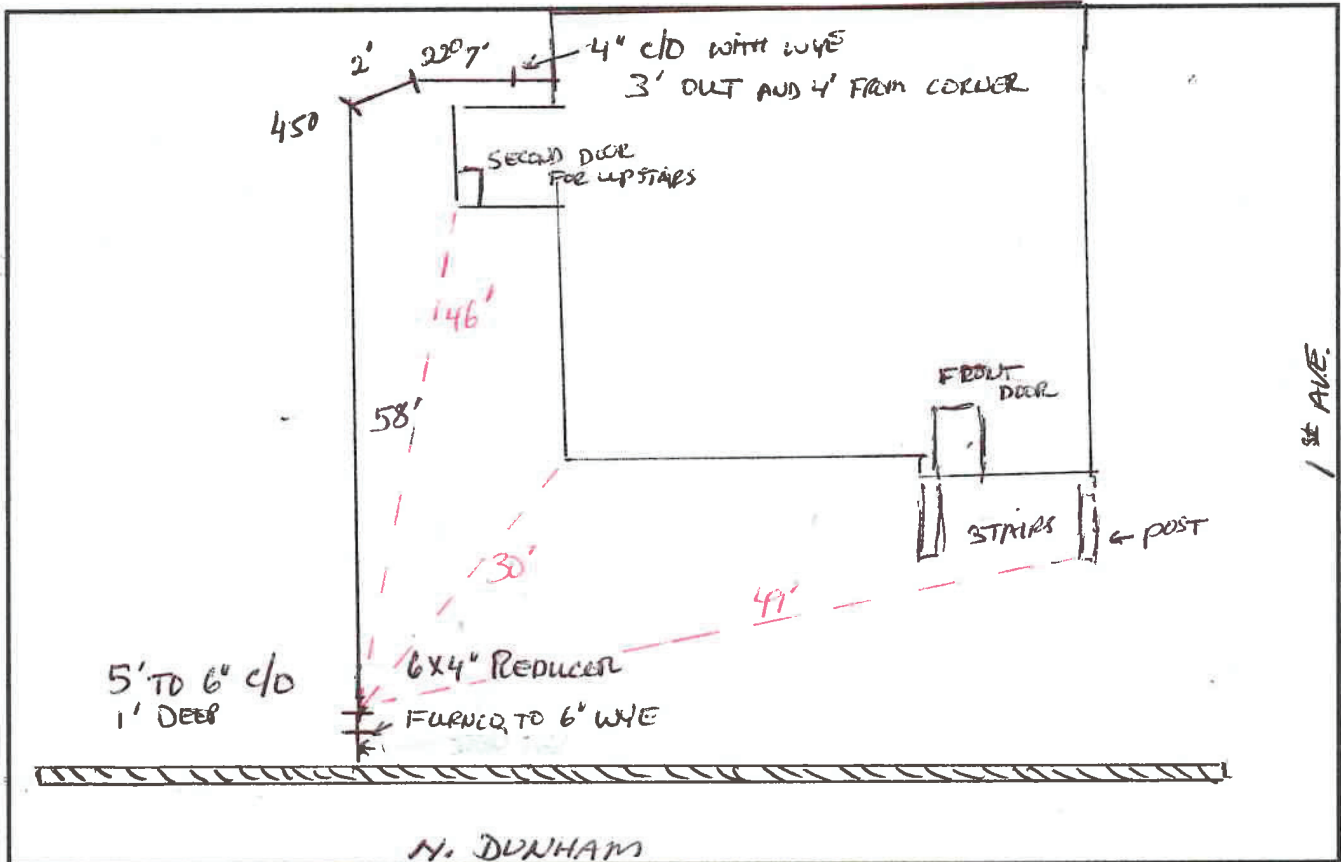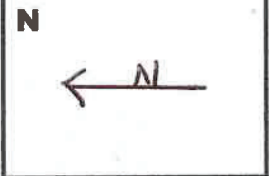

Side Sewer Repair