

THE TOWN OF ARLINGTON

SEWER DEPARTMENT


Side Sewer Plat
(PREPARE IN DUPLICATE)

Permit No. 467

Owner's Name Henry J. Stehman
 Owner's Mailing Address 104 Oak Arlington Road
 Legal Description of Premises Lot 1-7 Block 4 - Miller City Subd - 1st 1-2-3-4-5-6-7

Address of Property 104 Oak Arlington Road
 Side Sewer Contractor Self
 Mailing Address Self

02.6900.0

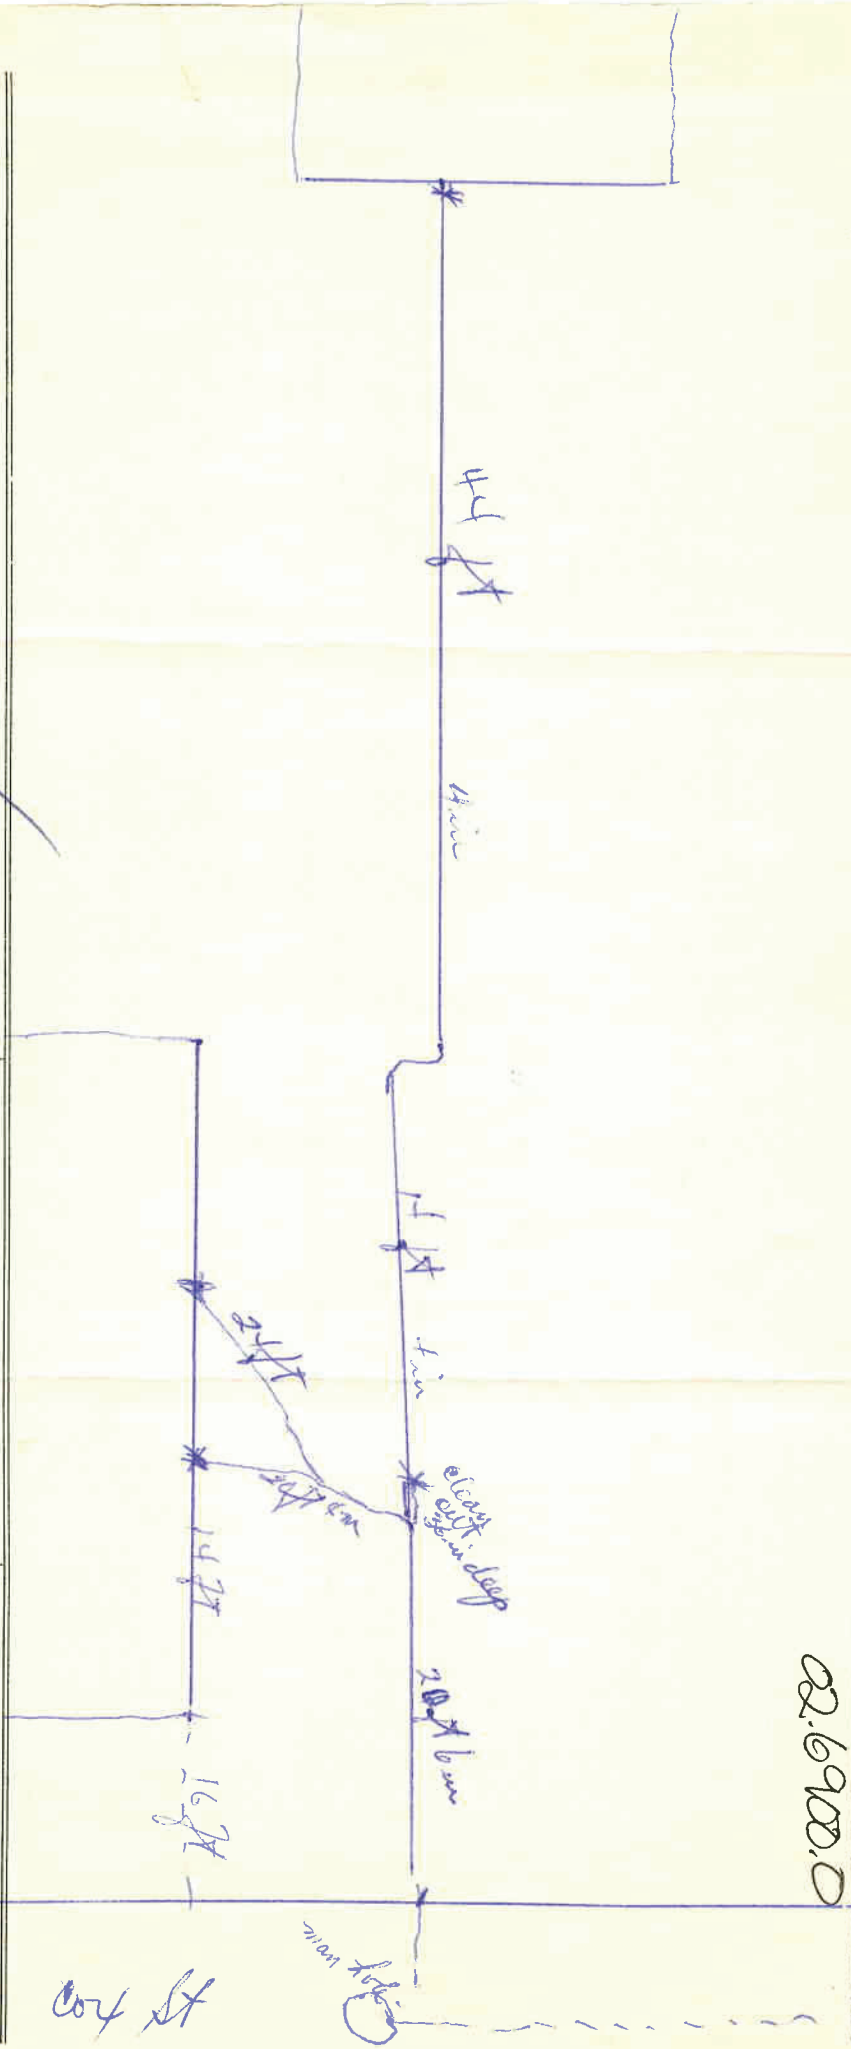

- 1. Commercial..... Single Residence..... Multiple Dwelling..... Joint Use.....
- 2. Distance from property line to sewer line.....
- 3. Distance from house building line to property line..... From property line to bldg. 14 to 17
- 4. Min. grade from main to property line.....
- 5. Distance from M. H. No.....
- 6. Depth: Sewer main..... Basement connection 20
- 7. Basement..... (Reference to first floor)
- 8. Depth of pipe at house connection.....
- 9. Type of pipe: Concrete..... Vitrified Clay ✓..... Asbestos-Cement.....
- 10. Remarks:.....

- COMMERCIAL ONLY
- 1. Name.....
 - 2. Type.....
 - 3. Sq. Ft. Floor Space.....
 - 4. No. of Floors.....
 - 5. Remarks:.....

- SPECIAL AGREEMENTS
- 1. Grade Release.....
 - 2. High Grade Release.....
 - 3. Non-Protecting Agmt.
 - 4. Easement.....
 - 5. Permission to Connect.....
 - 6. Special.....

I hereby certify that the above connection has been made as shown:
 Inspector Henry J. Stehman Date 11/16/60
 Date Permit Issued..... Permit No. 467