


Property Address: 104 French
Permit Number: 13
Development Name: NA
Lot Number: NA
Date Inspected: 01/07/60
Inspected By: Henry Spencer
AutoCad As-built Drawn By: Fred Rapelyea
AutoCad Drawing Date: 08/29/05

FILE COPY



French

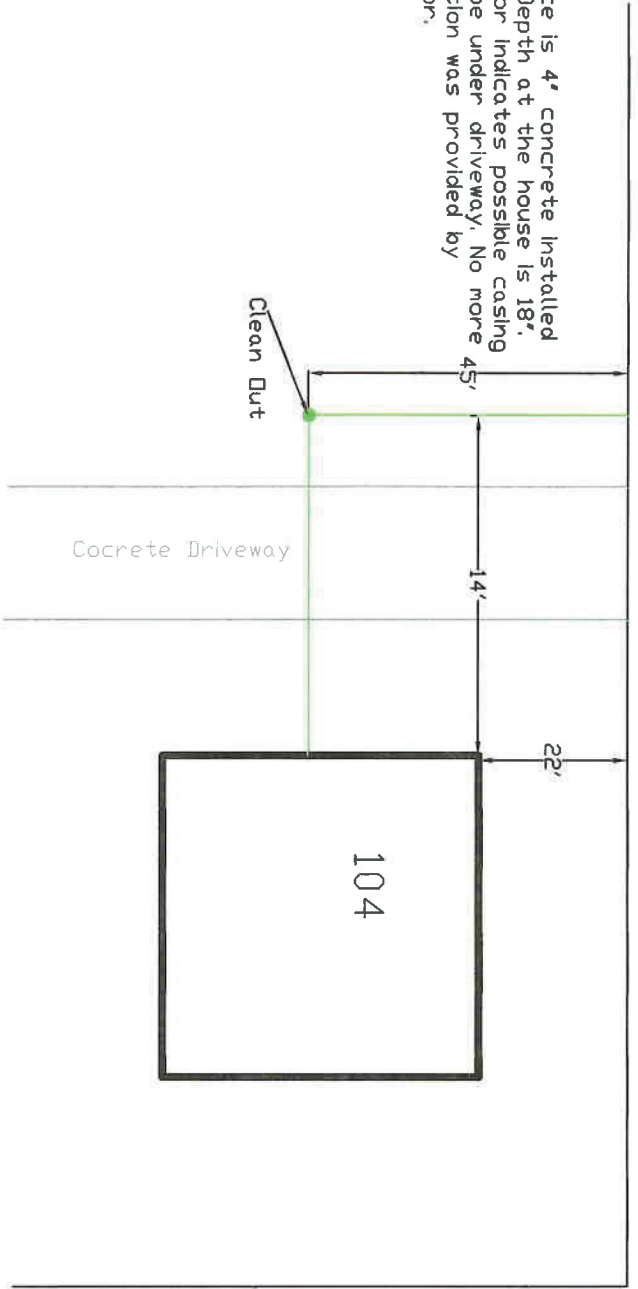

* Service is 4' concrete installed at 2%. Depth at the house is 18". Inspector indicates possible casing over pipe under driveway. No more information was provided by Inspector.

1st Street