

# THE TOWN OF ARLINGTON SEWER DEPARTMENT


Side /er Plat  
(PREPARE IN DUPLICATE)

Permit No. 2511

Owner's Name Forrester, William  
 Owner's Mailing Address 107-57th St  
 Legal Description of Premises Site 11x12 Block 1

Address of Property 107-57th St  
 Side Sewer Contractor Forrester, William  
 Mailing Address 107-57th St

## Side Sewer Repair

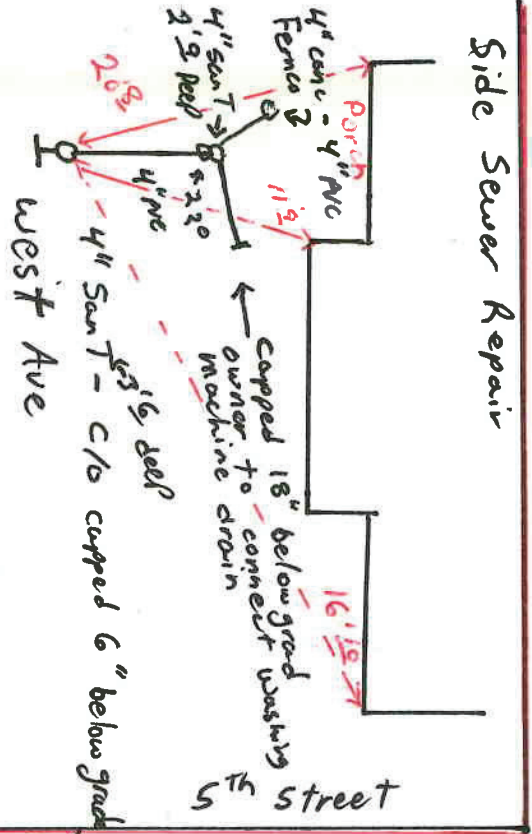

West Ave

5th Street

02-98000

1. Commercial..... Single Residence..... Multiple Dwelling..... Joint Use.....
2. Distance from property line to sewer line.....
3. Distance from house building line to property line..... From property line to bldg.....
4. Min. Grade from main to property line.....
5. Distance from M. H. No.....
6. Depth: Sewer main..... Basement connection.....
7. Basement.....
8. Depth of pipe at house connection..... (Reference to first floor)
9. Type of pipe: Concrete..... Vitrified Clay..... Asbestos-Cement..... Size.....
10. Remarks:.....

### COMMERCIAL ONLY

1. Name.....
2. Type.....
3. Sq. Ft. Floor Space.....
4. No. of Floors.....
5. Remarks:.....

### SPECIAL AGREEMENTS

1. Grade Release.....
2. High Grade Release.....
3. Non-Protecting Assmt.....
4. Easement.....
5. Permission to Connect.....
6. Special.....

I hereby certify that the above connection has been made as shown:

Inspector Henry Spencer Date 11/16/11  
 Date Permit Issued..... Permit No. 02-98000