


**FILE COPY**

Property Address:	109 French Ave
Permit Number:	14
Development Name:	NA
Lot Number:	NA
Date Inspected:	01/07/60
Inspected By:	Henry Spencer
AutoCad As-built Drawn By:	Fred Rapelyea
AutoCad Drawing Date:	8/29/05



4" Concrete pipe installed at 2%  
\* No further information provided by inspector

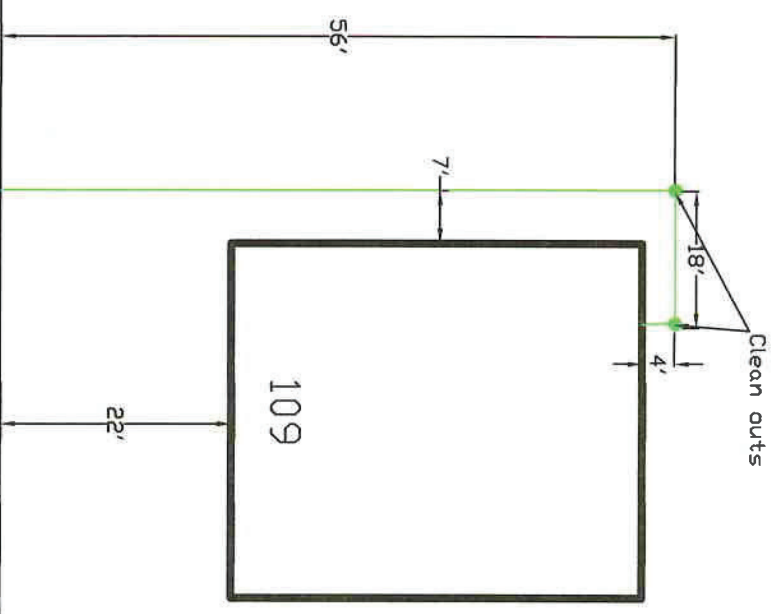

French Ave