

# THE TOWN OF ARLINGTON

## SEWER DEPARTMENT


Side Sewer Plat  
(PREPARE IN DUPLICATE)

Permit No. 257

3840

3840

Owner's Name Newton Field  
 Owner's Mailing Address 1101 E 5th St.  
 Legal Description of Premises lot 13 Victor Heights Addition  
 Address of Property 1101 E 5th St  
 Side Sewer Contractor \_\_\_\_\_  
 Mailing Address \_\_\_\_\_

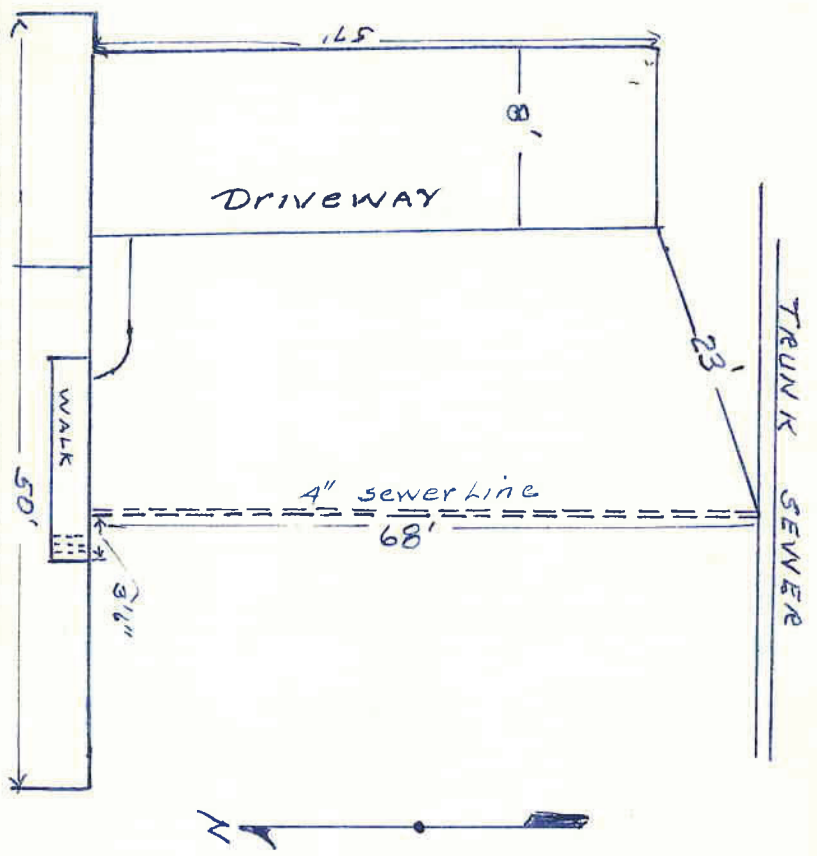

Not Drawn to Scale  
 05-1500, 0

- 1. Commercial..... Single Residence  Multiple Dwelling..... Joint Use.....
- 2. Distance from property line to sewer line.....
- 3. Distance from house building line to property line..... From property line to bldg. 20'
- 4. Min. grade from main to property line.....
- 5. Distance from M. H. No. ....
- 6. Depth: Sewer main..... Basement connection..... (Reference to first floor)
- 7. Basement.....
- 8. Depth of pipe at house connection..... Vitrified Clay  Asbestos-Cement..... Size 4"
- 9. Type of pipe: Concrete.....
- 10. Remarks: .....

COMMERCIAL ONLY		SPECIAL AGREEMENTS	
1. Name .....	1. Grade Release .....	2. High Grade Release .....	2. Special .....
2. Type .....	3. Non-Protecting Agmt. ....	3. Non-Protecting Agmt. ....	3. Special .....
3. Sq. Ft. Floor Space .....	4. Easement .....	4. Easement .....	4. Special .....
4. No. of Floors .....	5. Permission to Connect .....	5. Permission to Connect .....	5. Special .....
5. Remarks: .....	6. Special .....	6. Special .....	6. Special .....

I hereby certify that the above connection has been made as shown:  
 Inspector Wayne Spomer Date 11/16/69  
 Date Permit Issued \_\_\_\_\_ Permit No. 257