




107 S. HAMLIN HOUSE

111 S. HAMLIN HOUSE

Permit #502  
AND #503  
CAR PORT

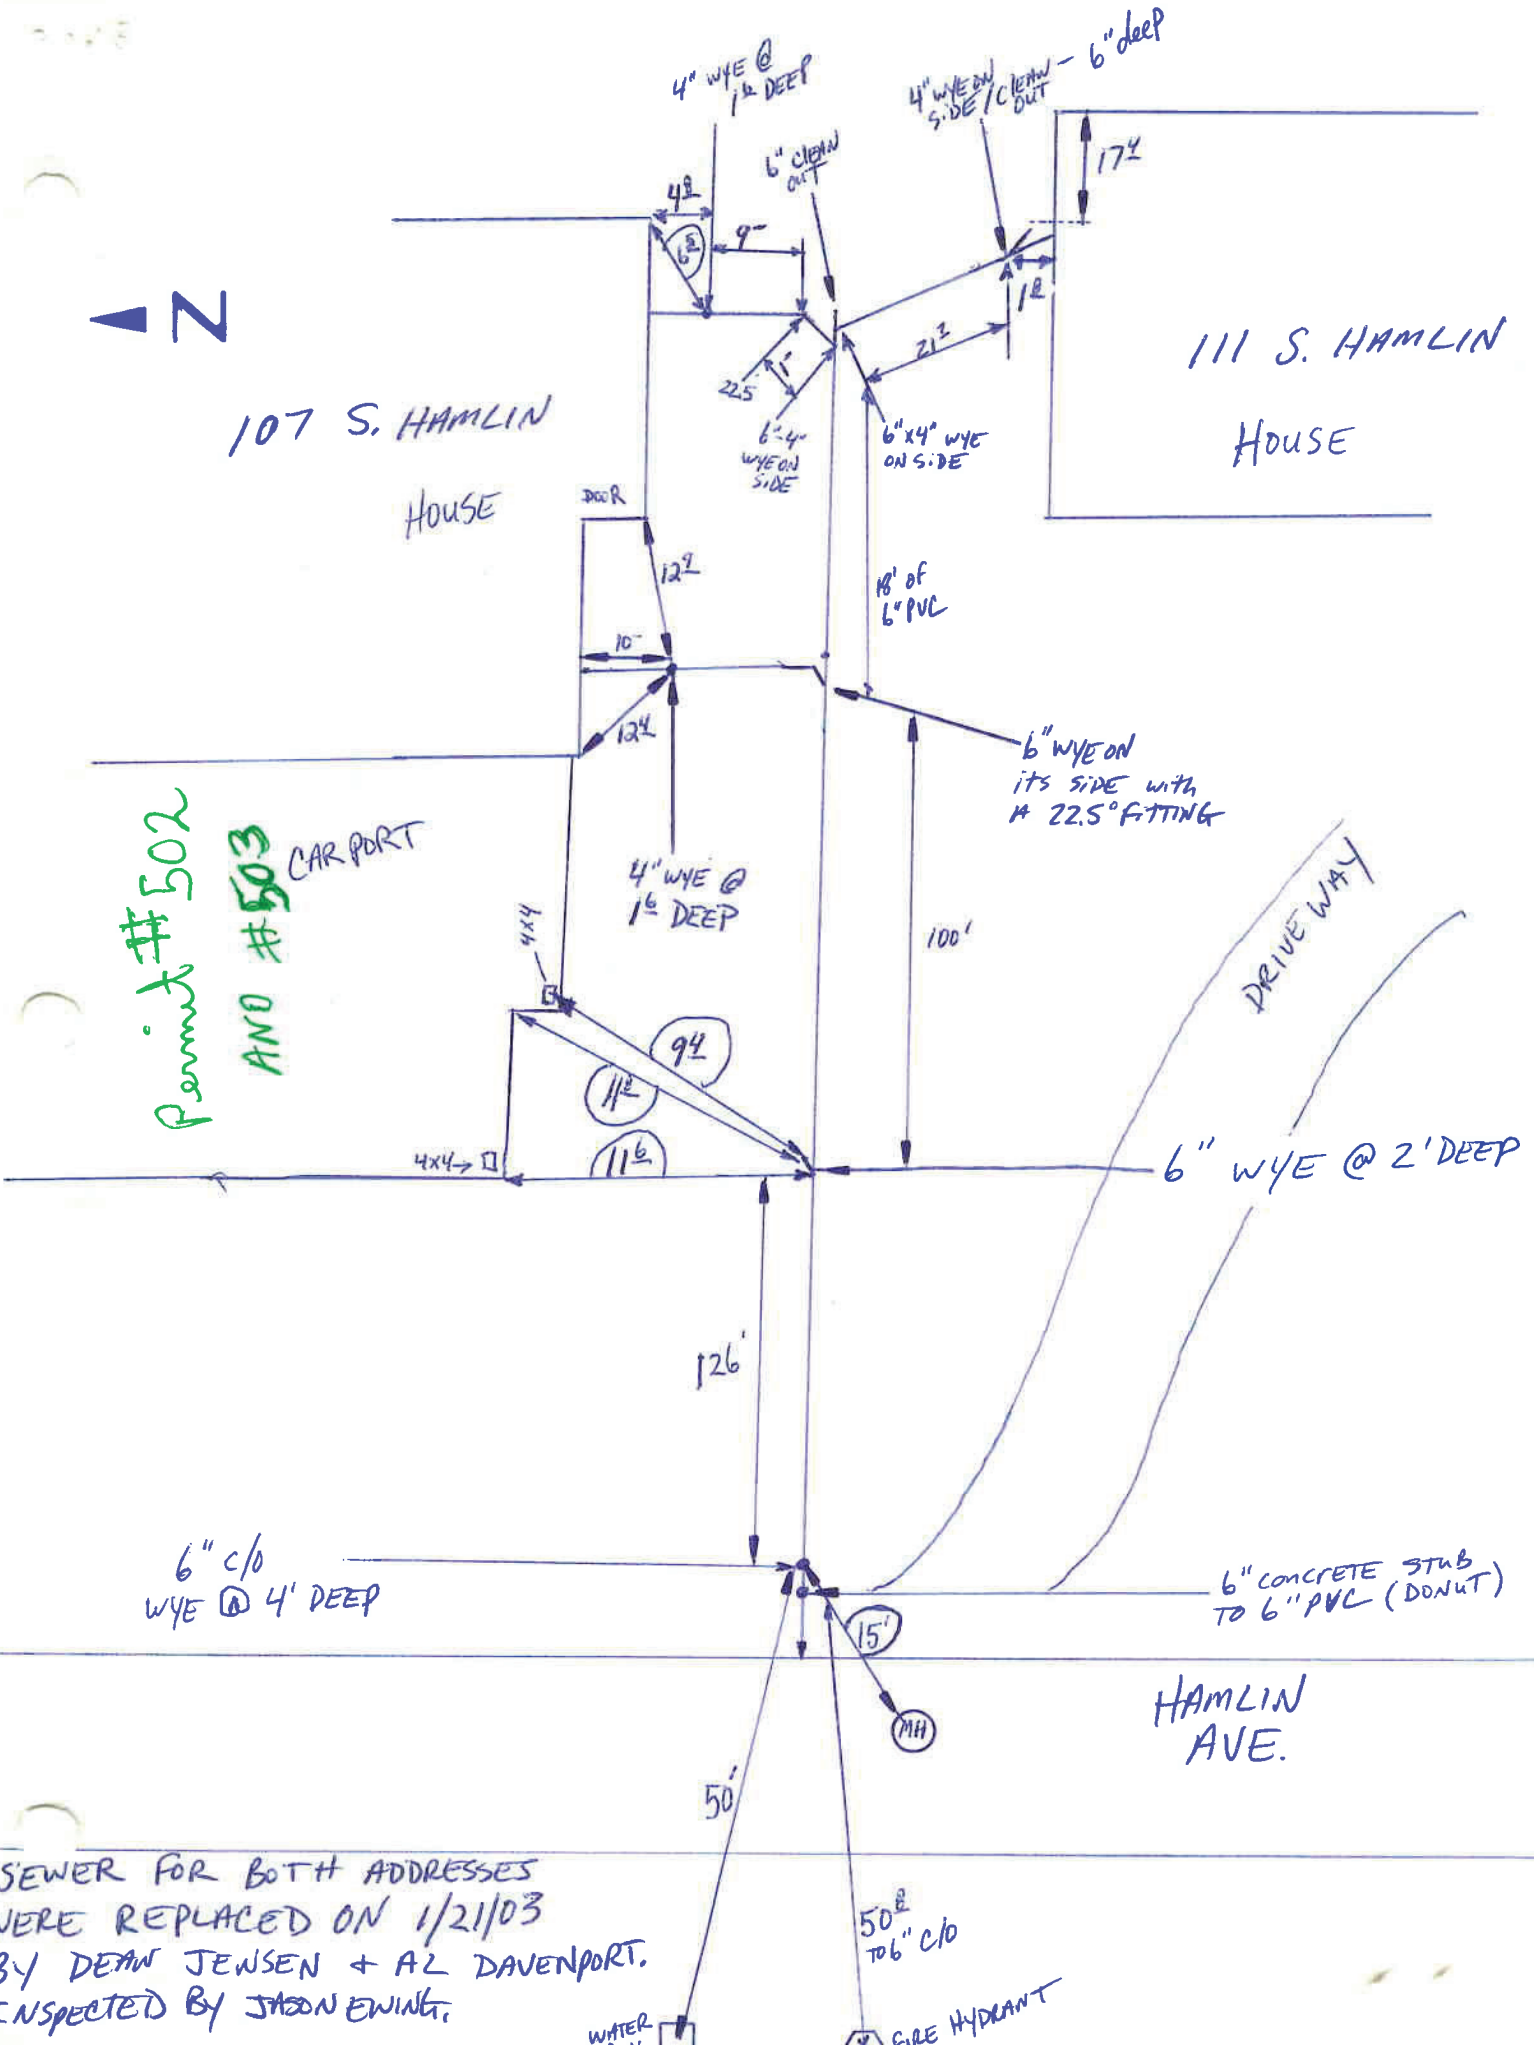

SEWER FOR BOTH ADDRESSES WERE REPLACED ON 1/21/03 BY DEAN JENSEN + AL DAVENPORT. INSPECTED BY JASON EWING.