


FILE COPY

Property Address:	114 E Maple
Permit Number:	08
Development Name:	NA
Lot Number:	NA
Date Inspected:	03/02/94
Inspected By:	R Bruce Schlegel
AutoCad As-built Drawn By:	Fred Rapelyea
AutoCad Drawing Date:	8/29/05



Alley

- * Clean out 10' deep, Distance from property line to the unit is 9'. Depth at the unit is 24'.
- * The service is 4" PVC, no other information provided.

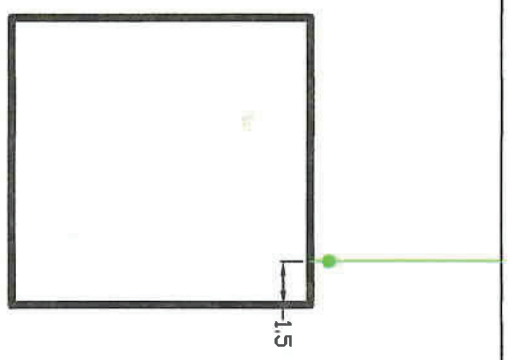

Maple Street