

THE TOWN OF ARLINGTON

SEWER DEPARTMENT


Side Street Plat
(PREPARE IN DUPLICATE)

Permit No. 201 590

Owner's Name John M. Blair
 Owner's Mailing Address 116 Alhambra Ave,
 Legal Description of Premises Lot 5 - Block 7 - Valley City Add

Address of Property 116 Alhambra
 Side Sewer Contractor Shubman and Sons Co.
 Mailing Address 4608 - 36th S.W. Seattle

Shubman Ave

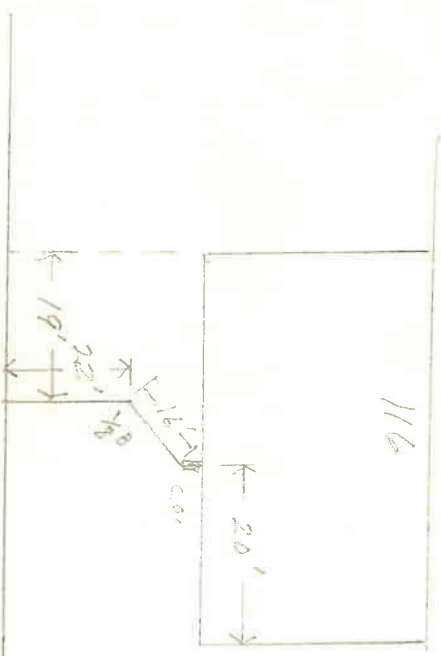

Alley

02-8100.0

1. Commercial Single Residence Multiple Dwelling Joint Use
2. Distance from property line to sewer line
3. Distance from house building line to property line From property line to bldg. 20'
4. Min. grade from main to property line
5. Distance from M. H. No.
6. Depth: Sewer main Basement connection (Reference to first floor)
7. Basement
8. Depth of pipe at house connection Verified Clay Asbestos-Cement Size 4"
9. Type of pipe: Concrete Verified Clay Asbestos-Cement Size 4"
10. Remarks:

COMMERCIAL ONLY

1. Name
2. Type
3. Sq. Ft. Floor Space
4. No. of Floors
5. Remarks:

SPECIAL AGREEMENTS

1. Grade Release
2. High Grade Release
3. Non-Protecting Agmt.
4. Easement
5. Permission to Connect
6. Special

I hereby certify that the above connection has been made as shown:
 Inspector Henry J. ... Date 11/9/68
 Date Permit Issued ... Permit No. 201