


# THE TOWN OF ARLINGTON SEWER DEPARTMENT

Side S  
(PREPARE IN DUPLICATE)

Permit No. 353

Owner's Name D. GIBBINS  
 Owner's Mailing Address 118 HALLER  
 Legal Description of Premises HALLER CITY BLOCK 30  
LOT 11 & 12

Address of Property 118 HALLER  
 Side Sewer Contractor SELF  
 Mailing Address SAME

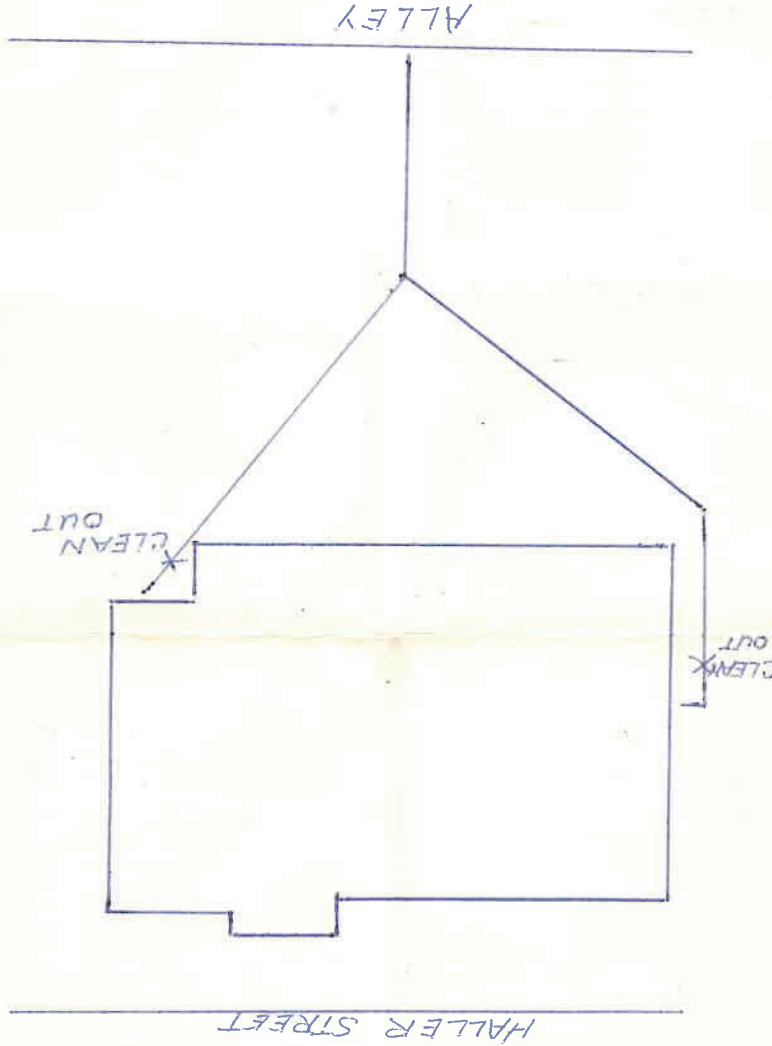

02-5700.0

COMMERCIAL ONLY		SPECIAL AGREEMENTS	
1. Name	.....	1. Grade Release	.....
2. Type	.....	2. High Grade Release	.....
3. Sq. Ft. Floor Space	.....	3. Non-Protecting Agmt.	.....
4. No. of Floors	.....	4. Easement	.....
5. Remarks:	.....	5. Permission to Connect	.....
	.....	6. Special	.....
I hereby certify that the above connection has been made as shown:			
Inspector	<u>[Signature]</u>	Date	<u>1/16/60</u>
Date Permit Issued		Permit No.	<u>353</u>

- Commercial..... Single Residence  Multiple Dwelling..... Joint Use.....
- Distance from property line to sewer line..... 40 FEET
- Distance from house building line to property line..... 35 FEET
- Min. grade from main to property line..... 2 1/2 TO From property line to bldg. 3 1/2
- Distance from M. H. No. .... 131 FEET
- Depth: Sewer main..... 5 FEET
- Easement..... NONE Easement connection..... NONE
- Depth of pipe at house connection..... 2 FEET (Reference to first floor)
- Type of pipe: Concrete....., Vitrified Clay....., Asbestos-Cement....., Size..... 4 IN
- Remarks: .....