


CITY OF ARLINGTON
SEWER DEPARTMENT

SIDE SEWER PLAT MAP

SS PERMIT # 236
BP# _____

Owner's Name _____ Side Sewer Contractor _____
 Mailing Address _____ Mailing Address _____
 Address of Property 120 NORTH LENORE
 Legal Description _____

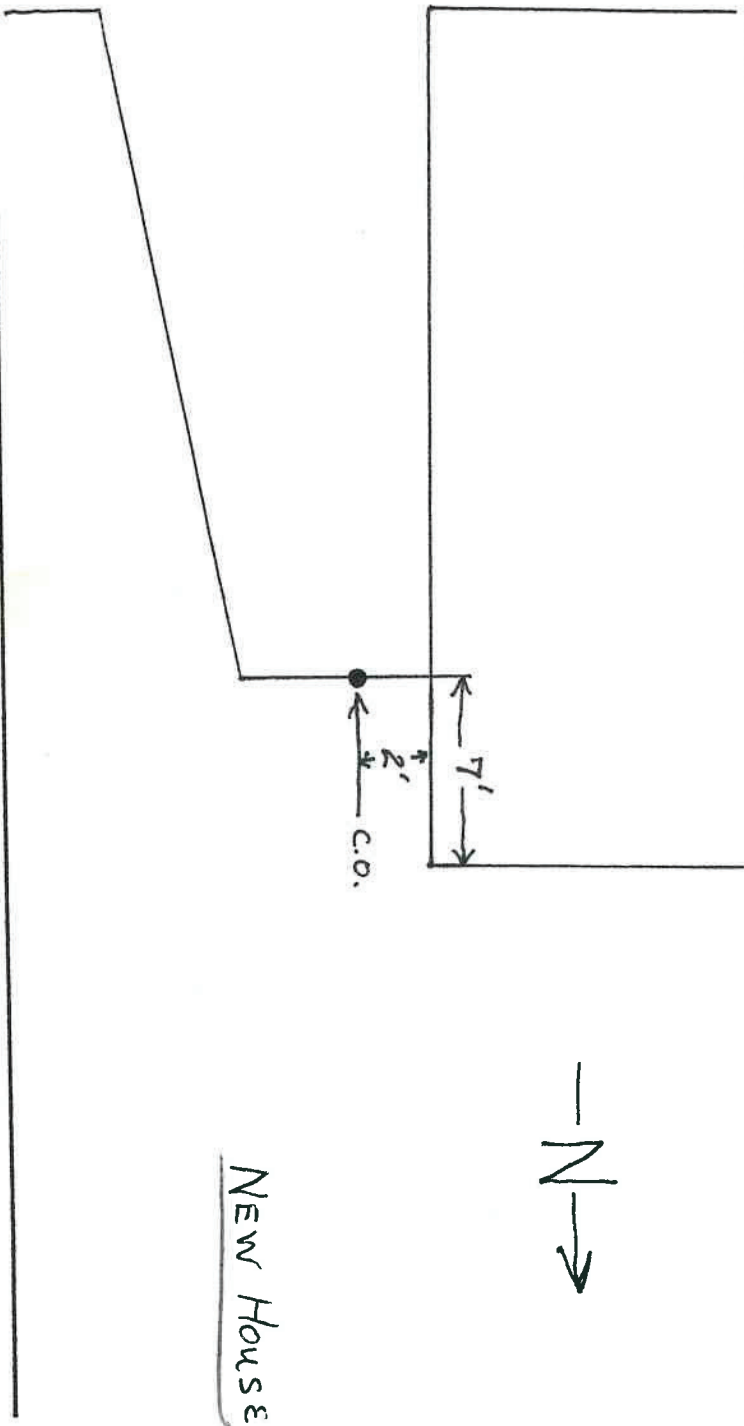

1. Commercial _____ Single Residence _____ Multiple Dwelling _____ Joint Use _____ # of ERU's _____
2. Distance from M.H. No. _____
3. Depth: Sewer Main _____ Basement _____ Basement Connections _____
4. Depth of pipe at house connection _____ (first floor) _____ Date 12-12-97
5. Inspected by _____ Pipe Size _____
6. Type of pipe _____