

THE TOWN OF ARLINGTON

SEWER DEPARTMENT


Side 5 of Plat
(PREPARE IN DUPLICATE)

Permit No. 491

Owner's Name Dean Field
 Owner's Mailing Address Highland Drive P.O.
 Legal Description of Premises Block 16, Lots 17 & 18

Address of Property 121 East G. L. Man
 Side Sewer Contractor Spencer & Van Horn
 Mailing Address Wahler City Wash
Arlington Wash.

FILE COPY

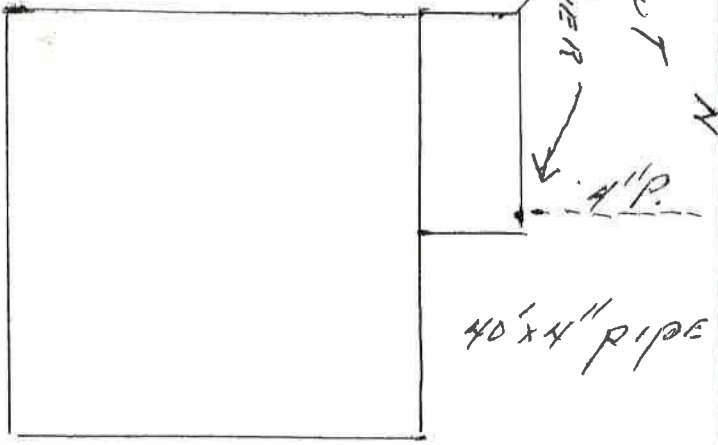

- 1. Commercial Single Residence Multiple Dwelling Joint Use
- 2. Distance from property line to sewer line 11' 1/2"
- 3. Distance from house building line to property line 11' 1/2" From property line to bldg. 8' 1/2"
- 4. Min. grade from main to property line 11' 1/2"
- 5. Distance from M. H. No. 11' 1/2"
- 6. Depth: Sewer main 11' 1/2"
- 7. Basement Basement connection
- 8. Depth of pipe at house connection 11' 1/2"
- 9. Type of pipe: Concrete Vitrified Clay, Asbestos-Cement Asbestos-Cement, Size 4"
- 10. Remarks: 11' 1/2"

- COMMERCIAL ONLY
- 1. Name 11' 1/2"
 - 2. Type 11' 1/2"
 - 3. Sq. Ft. Floor Space 11' 1/2"
 - 4. No. of Floors 11' 1/2"
 - 5. Remarks: 11' 1/2"

- SPECIAL AGREEMENTS
- 1. Grade Release 11' 1/2"
 - 2. High Grade Release 11' 1/2"
 - 3. Non-Protecting Agmt. 11' 1/2"
 - 4. Easement 11' 1/2"
 - 5. Permission to Connect 11' 1/2"
 - 6. Special 11' 1/2"

I hereby certify that the above connection has been made as shown:
 Inspector 11' 1/2" Date 11' 1/2"
 Date Permit Issued 11' 1/2" Permit No. 11' 1/2"

02-05000

490