


**FILE COPY**

Property Address: 121 Lenore St.
Permit Number: 07
Development Name: NA
Lot Number: NA
Date Inspected: 01/07/60
Inspected By: Henry Spencer
AutoCad As-built Drawn By: Fred Rapelyea
AutoCad Drawing Date: 8/29/05

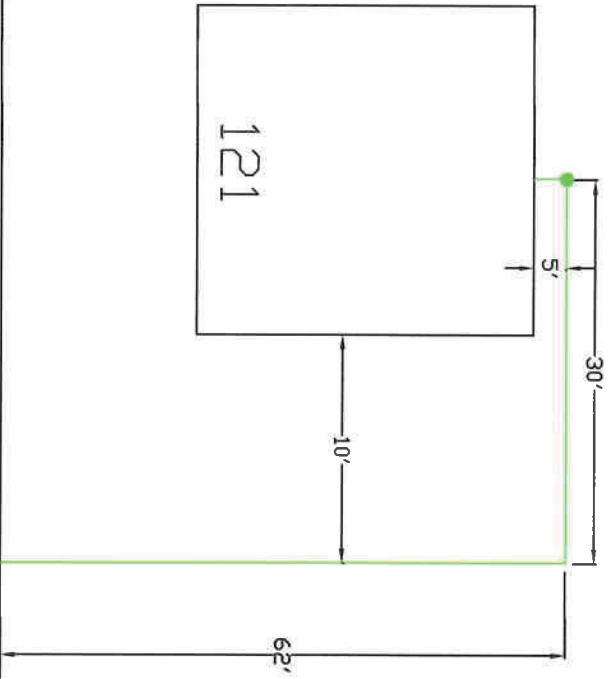

4" Concrete pipe installed at 2%  
\* No further information provided by inspector



Lenore Street