


THE CITY OF ARLINGTON
SEWER DEPARTMENT

Side Sewer Flat
(PREPARE IN DUPLICATE)

Permit No. 259

134A

Owner's Name Jacob Gilman Address of Property 121 West 17th
 Owner's Mailing Address 121 West Gilman Side Sewer Contractor CHARLES SMYTH
 Legal Description of Premises 13-14-17. Hall's City and LA CONNER, WASH. Mailing Address EXCAVATING & SEWER CONSTRUCTION
Box 414 PH. HO. 6-4365

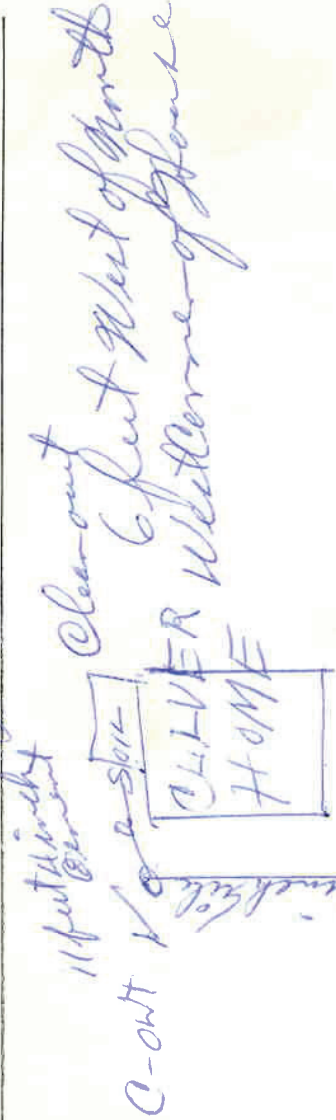

02-8400.0

COMMERCIAL ONLY		SPECIAL AGREEMENTS	
1. Name	1. Grade Release
2. Type	2. High Grade Release
3. Sq. Ft. Floor Space	3. Non-Protecting Agmt.
4. No. of Floors	4. Easement
5. Remarks:	5. Permission to Connect
	6. Special
I hereby certify that the above connection has been made as shown: Inspector <u>Henry P. Pinner</u> Date <u>1/6/69</u> Date Permit Issued <u>1/6/69</u> Permit No. <u>259</u>			