


THE TOWN OF ARLINGTON
SEWER DEPARTMENT

Permit No. 383

Side Sewer Plat
(PREPARE IN DUPLICATE)

Owner's Name A.E. Reed Address of Property 124 Highland Drive
 Owner's Mailing Address SELL Side Sewer Contractor _____
 Legal Description of Premises SAME Mailing Address _____
THENCE W. 72' TO P.O.B. SEC. 4, Twp 31, R. 5, E. 1. SEC. 170.5 THENCE E. 72' THENCE N. 170.5'

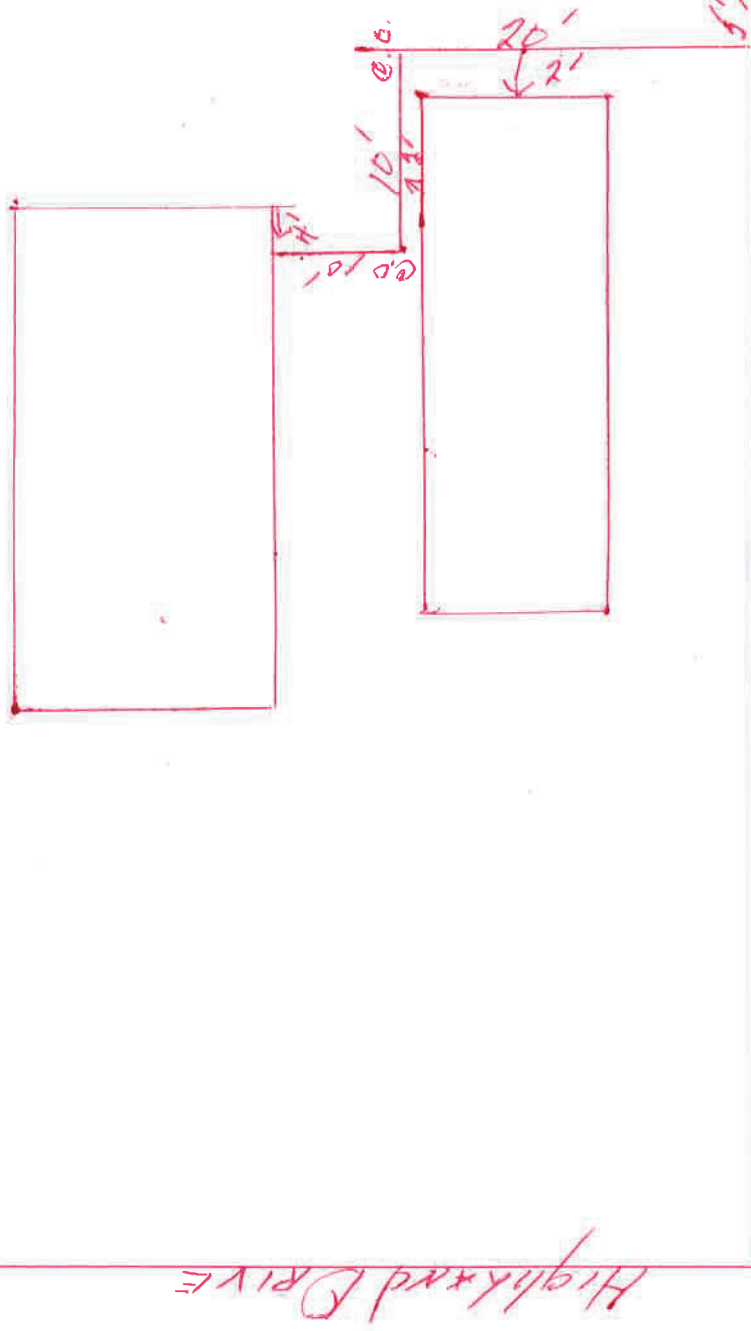

COMMERCIAL ONLY		SPECIAL AGREEMENTS	
1. Name	1. Grade Release	2. High Grade Release	3. Non-Protecting Agmt.
2. Type	2. Distance from property line to sewer line	4. Easement	5. Permission to Connect
3. Sq. Ft. Floor Space	3. Distance from house building line to property line	6. Special	
4. No. of Floors	4. Min. grade from main to property line		
5. Remarks:	5. Distance from M. H. No.		
	6. Depth: Sewer main		
	7. Basement		
	8. Depth of pipe at house connection		
	9. Type of pipe: Concrete		
	10. Remarks:		

I hereby certify that the above connection has been made as shown:
 Inspector [Signature] Date 11/16/60 Permit No. 383

No.