


Owner's Name Doug Schmidt Side Sewer Contractor OLSON BACKHOE
 Owner's Mailing Address 124 MARION Mailing Address _____
 Address of Property 126 MARION
 Legal Description _____

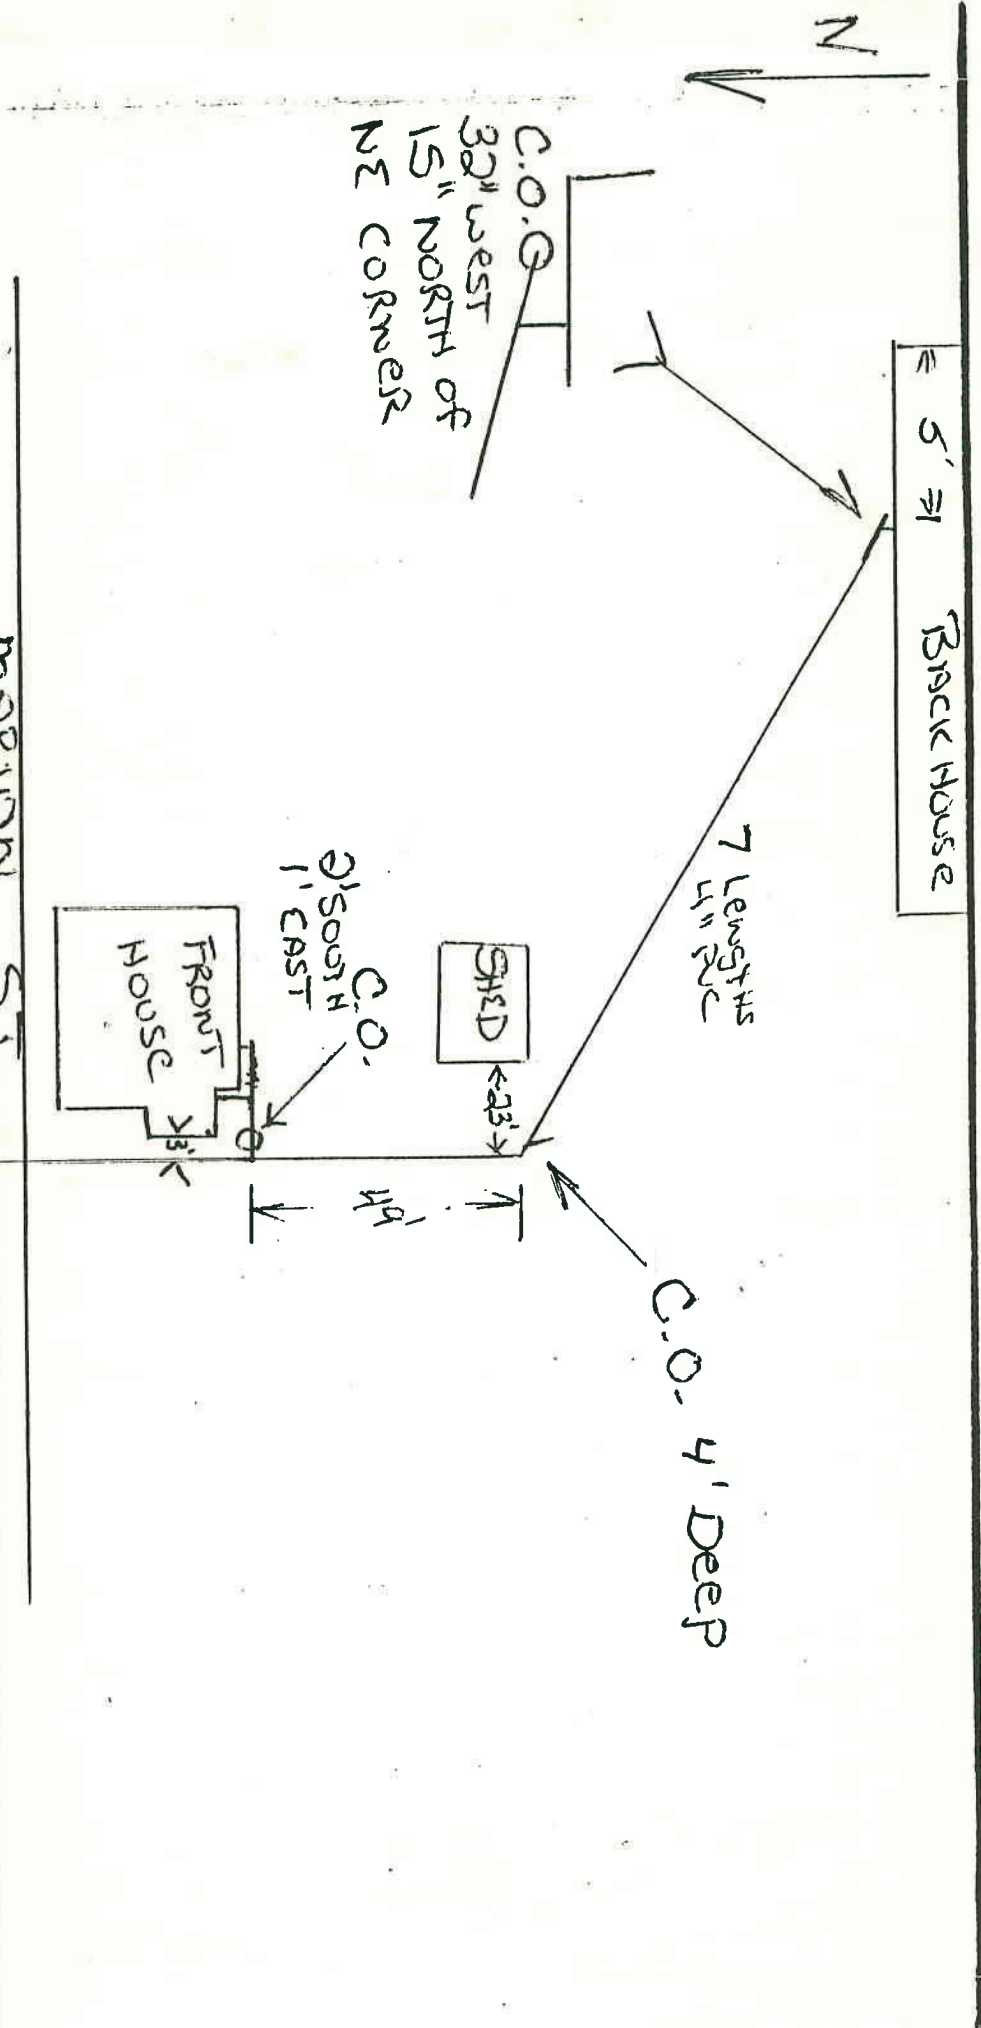

1. Commercial Single Residence Multiple Dwelling 2 Joint Use _____
2. Distance from property line to sewer unit _____
3. Distance from house building to property line _____
4. Min. grade from main to property line 1% From property line to building _____
5. Distance from M.H. No. 111 47' E Basement NO Basement Connections NO
6. Depth: Sewer Main _____ (re: first floor) _____
7. Depth of pipe at house connection _____ Asbestos cement _____ Size 4"

1-6-60