

THE TOWN OF ARLINGTON
ZONING DEPARTMENT


Application No. 2007-0001
Site No. 2007-0001

Project No. 0001-00

Project Name: 1850 West Ave
Project Address: 1850 West Ave
Project City: Arlington, VA
Project State: VA
Project Zip: 22204

Project Type: 2007-0001

Project Description: 1850 West Ave
Project Description: 1850 West Ave
Project Description: 1850 West Ave

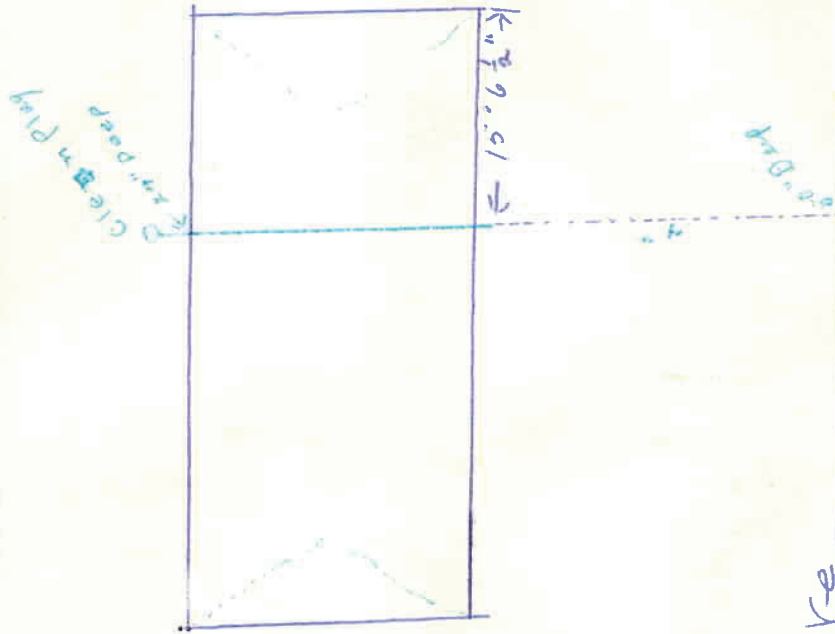

West Ave

0 200' 00"

APPLICANT: [Signature]

PROJECT ADDRESS: 1850 West Ave

CITY: Arlington, VA

STATE: VA

ZIP: 22204

PROJECT TYPE: 2007-0001

PROJECT DESCRIPTION: 1850 West Ave

PROJECT DESCRIPTION: 1850 West Ave

PROJECT DESCRIPTION: 1850 West Ave

PROJECT DESCRIPTION: 1850 West Ave