


**FILE COPY**

Property Address:	129 Durham Ave
Permit Number:	104
Development Name:	NA
Lot Number:	NA
Date Inspected:	11/16/50
Inspected By:	Henry Spencer
AutoCad As-built Drawn By:	Fred Rapelyea
AutoCad Drawing Date:	1/09/07

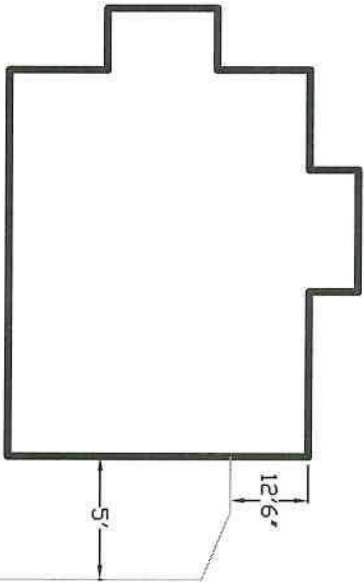

\* Inspector notes\*  
Cast iron pipe used from house to city connection  
with poured lead joints (4" pipe) installed @ 2% from  
property line to building. Depth of pipe at house connection is  
5'6" deep. Basement connection is present.

Sidewalk

Property Line



Durham Ave.