

THE TOWN OF ARLINGTON

SEWER DEPARTMENT


Side Street Plat
(PREPARE IN DUPLICATE)

Permit No. 1

#5410

Owner's Name John P. Weaver
 Owner's Mailing Address 139 Highland St.
 Legal Description of Premises Lot 8-9-10-Block 6 Highland St.

Address of Property 139 Highland St.
 Side Sewer Contractor Shoehorn and Sons Co.
 Mailing Address 46 08-36 St. Seattle

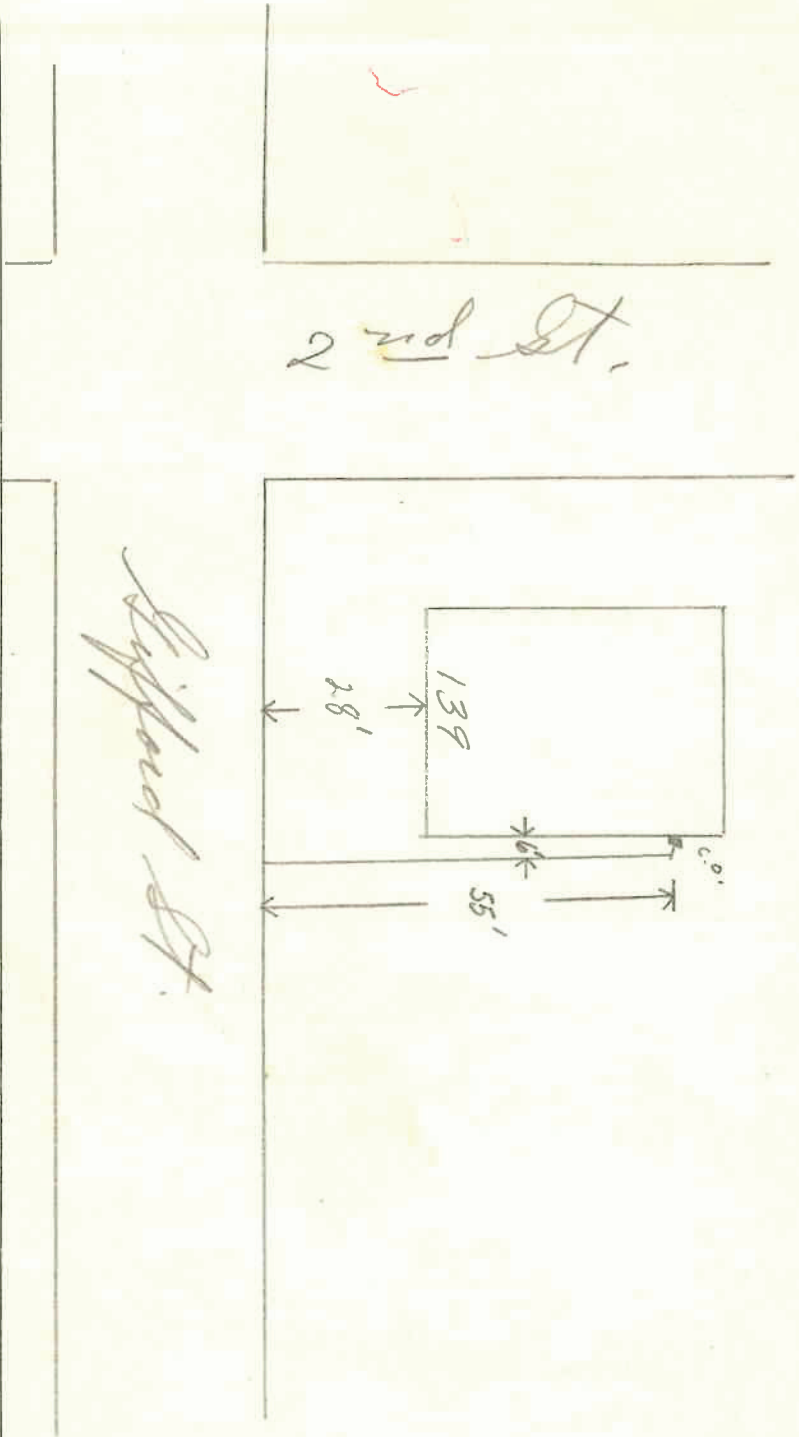

06-9500.0

- 1. Commercial..... Single Residence..... Multiple Dwelling..... Joint Use.....
- 2. Distance from property line to sewer line.....
- 3. Distance from house building line to property line..... From property line to bldg. 20'
- 4. Min. grade from main to property line.....
- 5. Distance from M. H. No.
- 6. Depth: Sewer main.....
- 7. Basement..... Basement connection..... (Reference to first floor)
- 8. Depth of pipe at house connection..... Vitrified Clay..... Asbestos-Cement..... Size.....
- 9. Type of pipe: Concrete.....
- 10. Remarks:

COMMERCIAL ONLY

- 1. Name
- 2. Type
- 3. Sq. Ft. Floor Space
- 4. No. of Floors
- 5. Remarks:

SPECIAL AGREEMENTS

- 1. Grade Release
- 2. High Grade Release
- 3. Non-Protecting Agmt.
- 4. Easement
- 5. Permission to Connect
- 6. Special

I hereby certify that the above connection has been made as shown:
 Inspector Jimmy Hansen Date 11/16/00
 Date Permit Issued..... Permit No. 1