


New Admin. Bldg.

154 WEST COX AVE

308

INSTALLED ON 9/8/11
BY FRED RAPELVA +
JAY LEMKE

COX AVE
6" ASPHALT
6" SERVICE

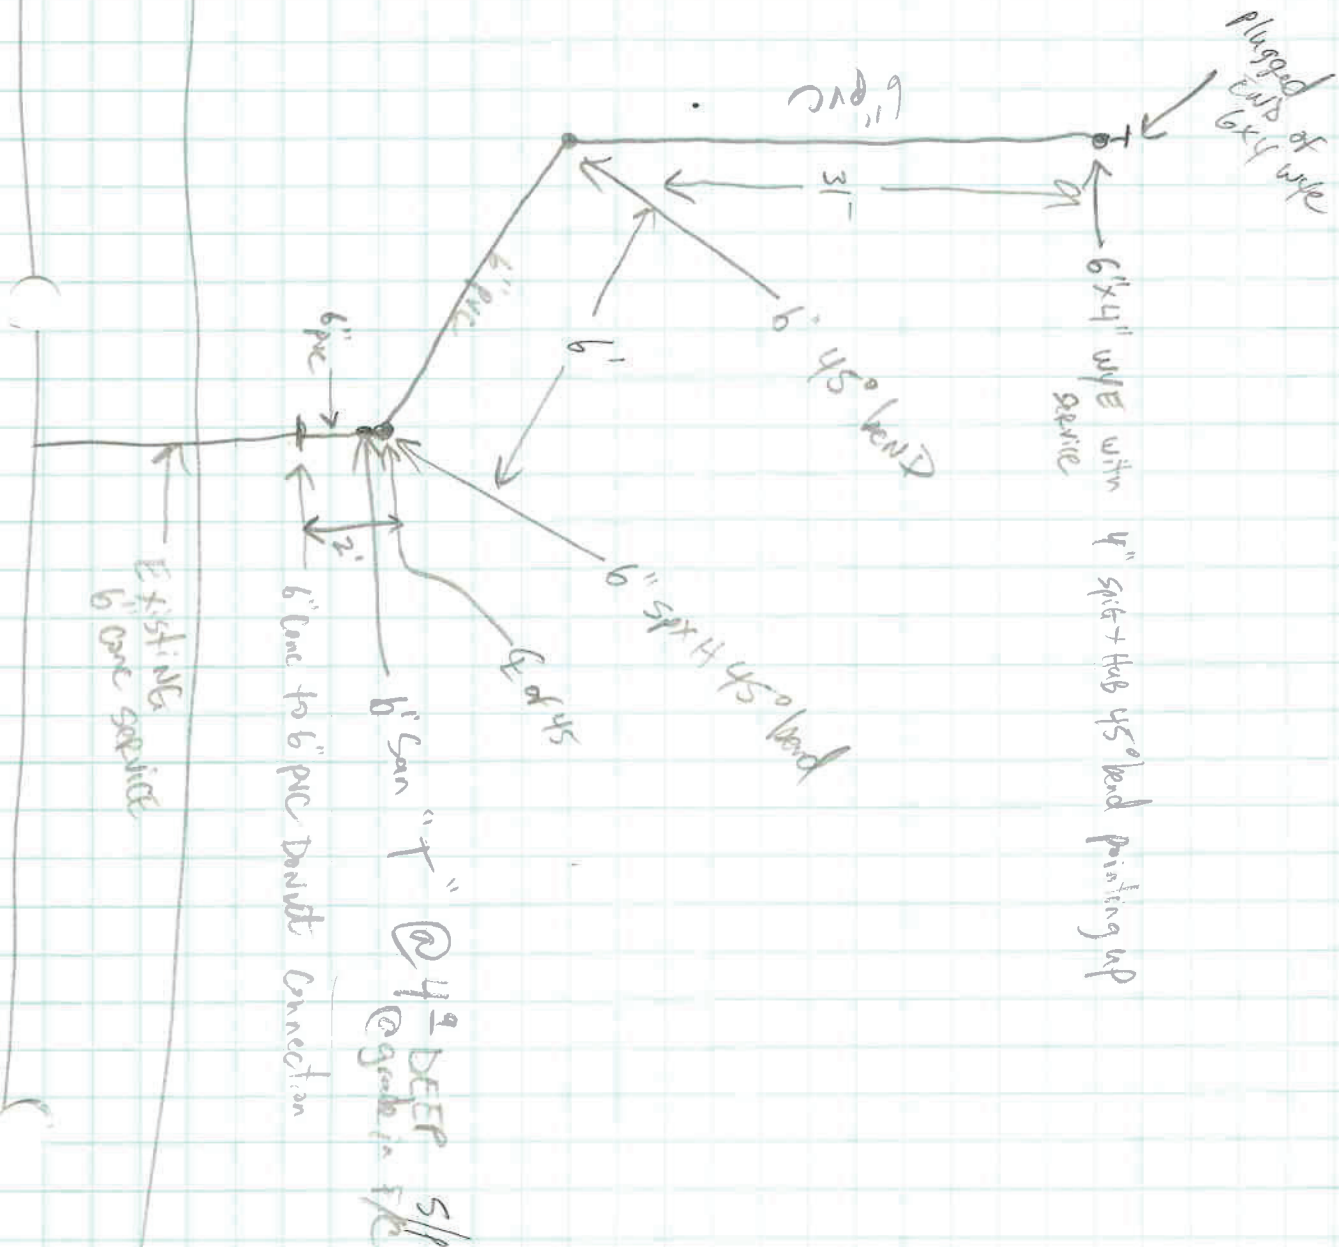

N ↓