


Inspection Form

Development	LotNo	Phase	Address	PermitNo	Completed
			202 S. FRENCH	544	8/13/08
Date of inspection	Time of inspection	Person making request	Phone number	Inspector	
8/13/08	3PM	EARL GROENDYKE		VLR	
Firm name			Contractor Information		
GARY SCHLAGEL			EED EXCAVATING		

4" c/p @ 2' DEEP
S/P CAPPED 4"
BELOW GRADE
(c/p WYE)

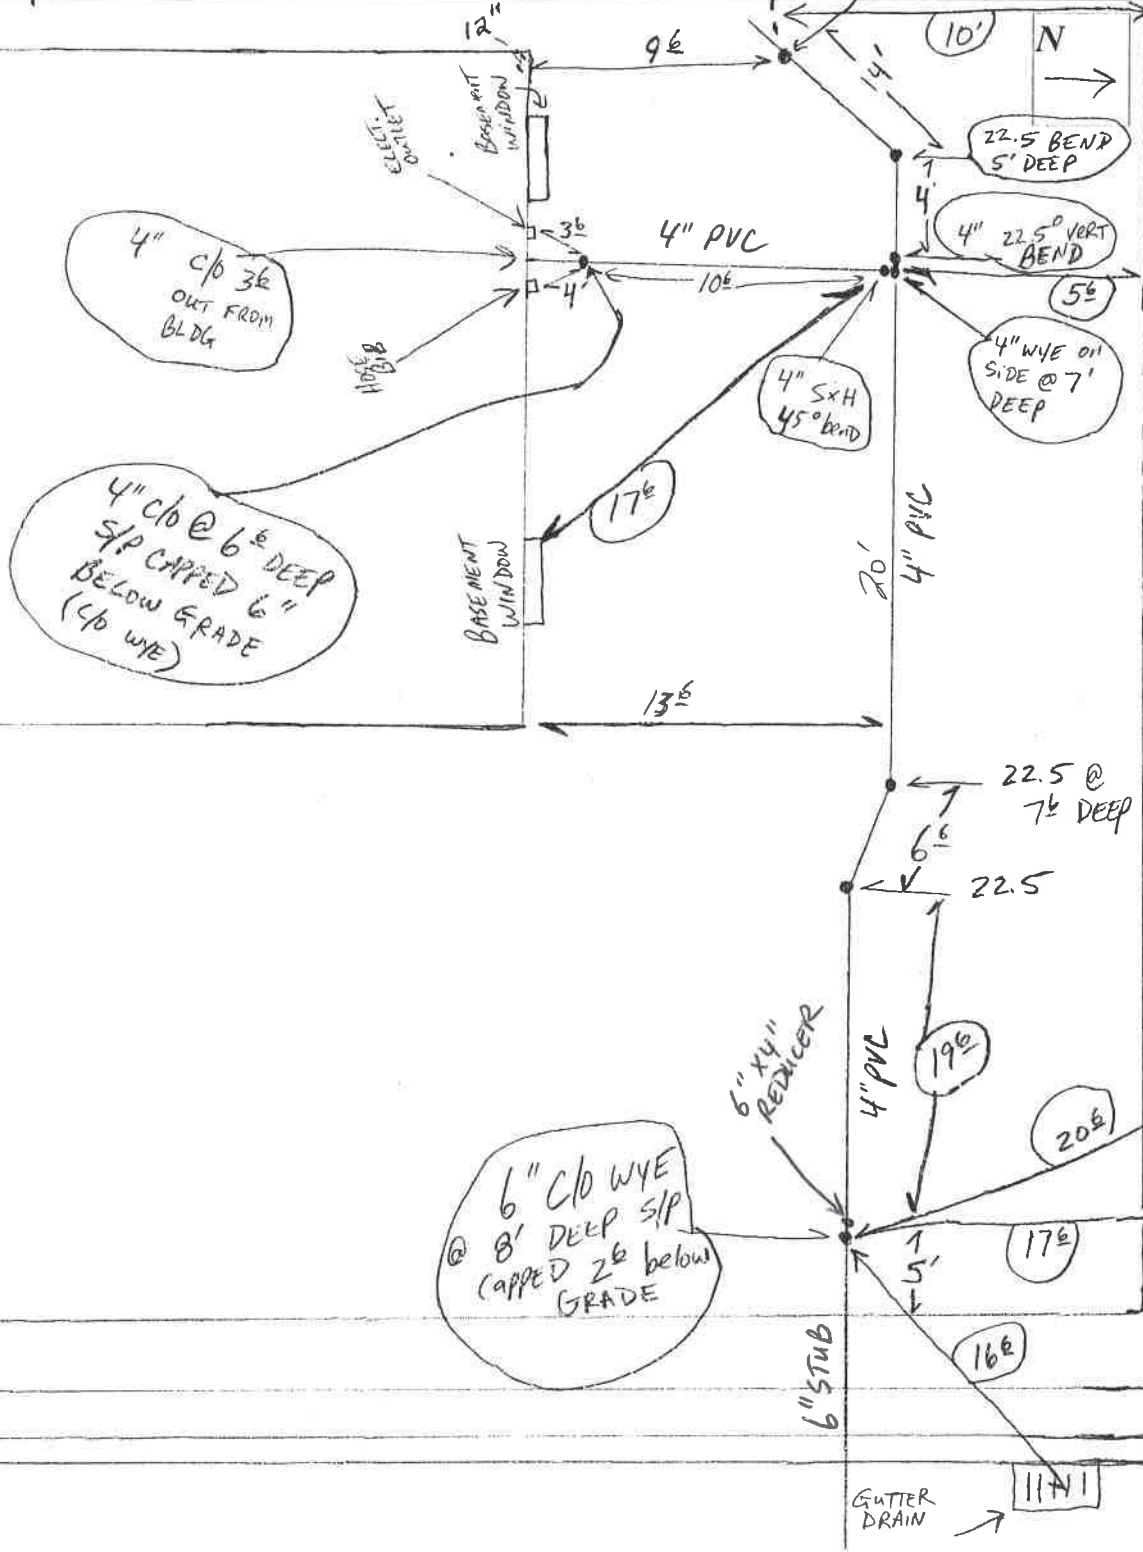

SIDEWALK
PLANTER
CURB

EWALK
ANTER
URB
FRENCH


MAPLE

Inspection Form

Development	LotNo	Phase	Address	PermitNo	Completed
			202 S. FRENCH	544	VLR
Date of inspection	Time of inspection	Person making request	Phone number	Inspector	
8/13/08	3PM	EARL GROENDYKE		VLR	
Firm name			Contractor Information		
GARY SCHLAGEL			EED EXCAVATING		

4" c/p @ 2' DEEP
S/P CAPPED 4"
BELOW GRADE
(c/p WYE)

SIDEWALK
PLANTER
CURB

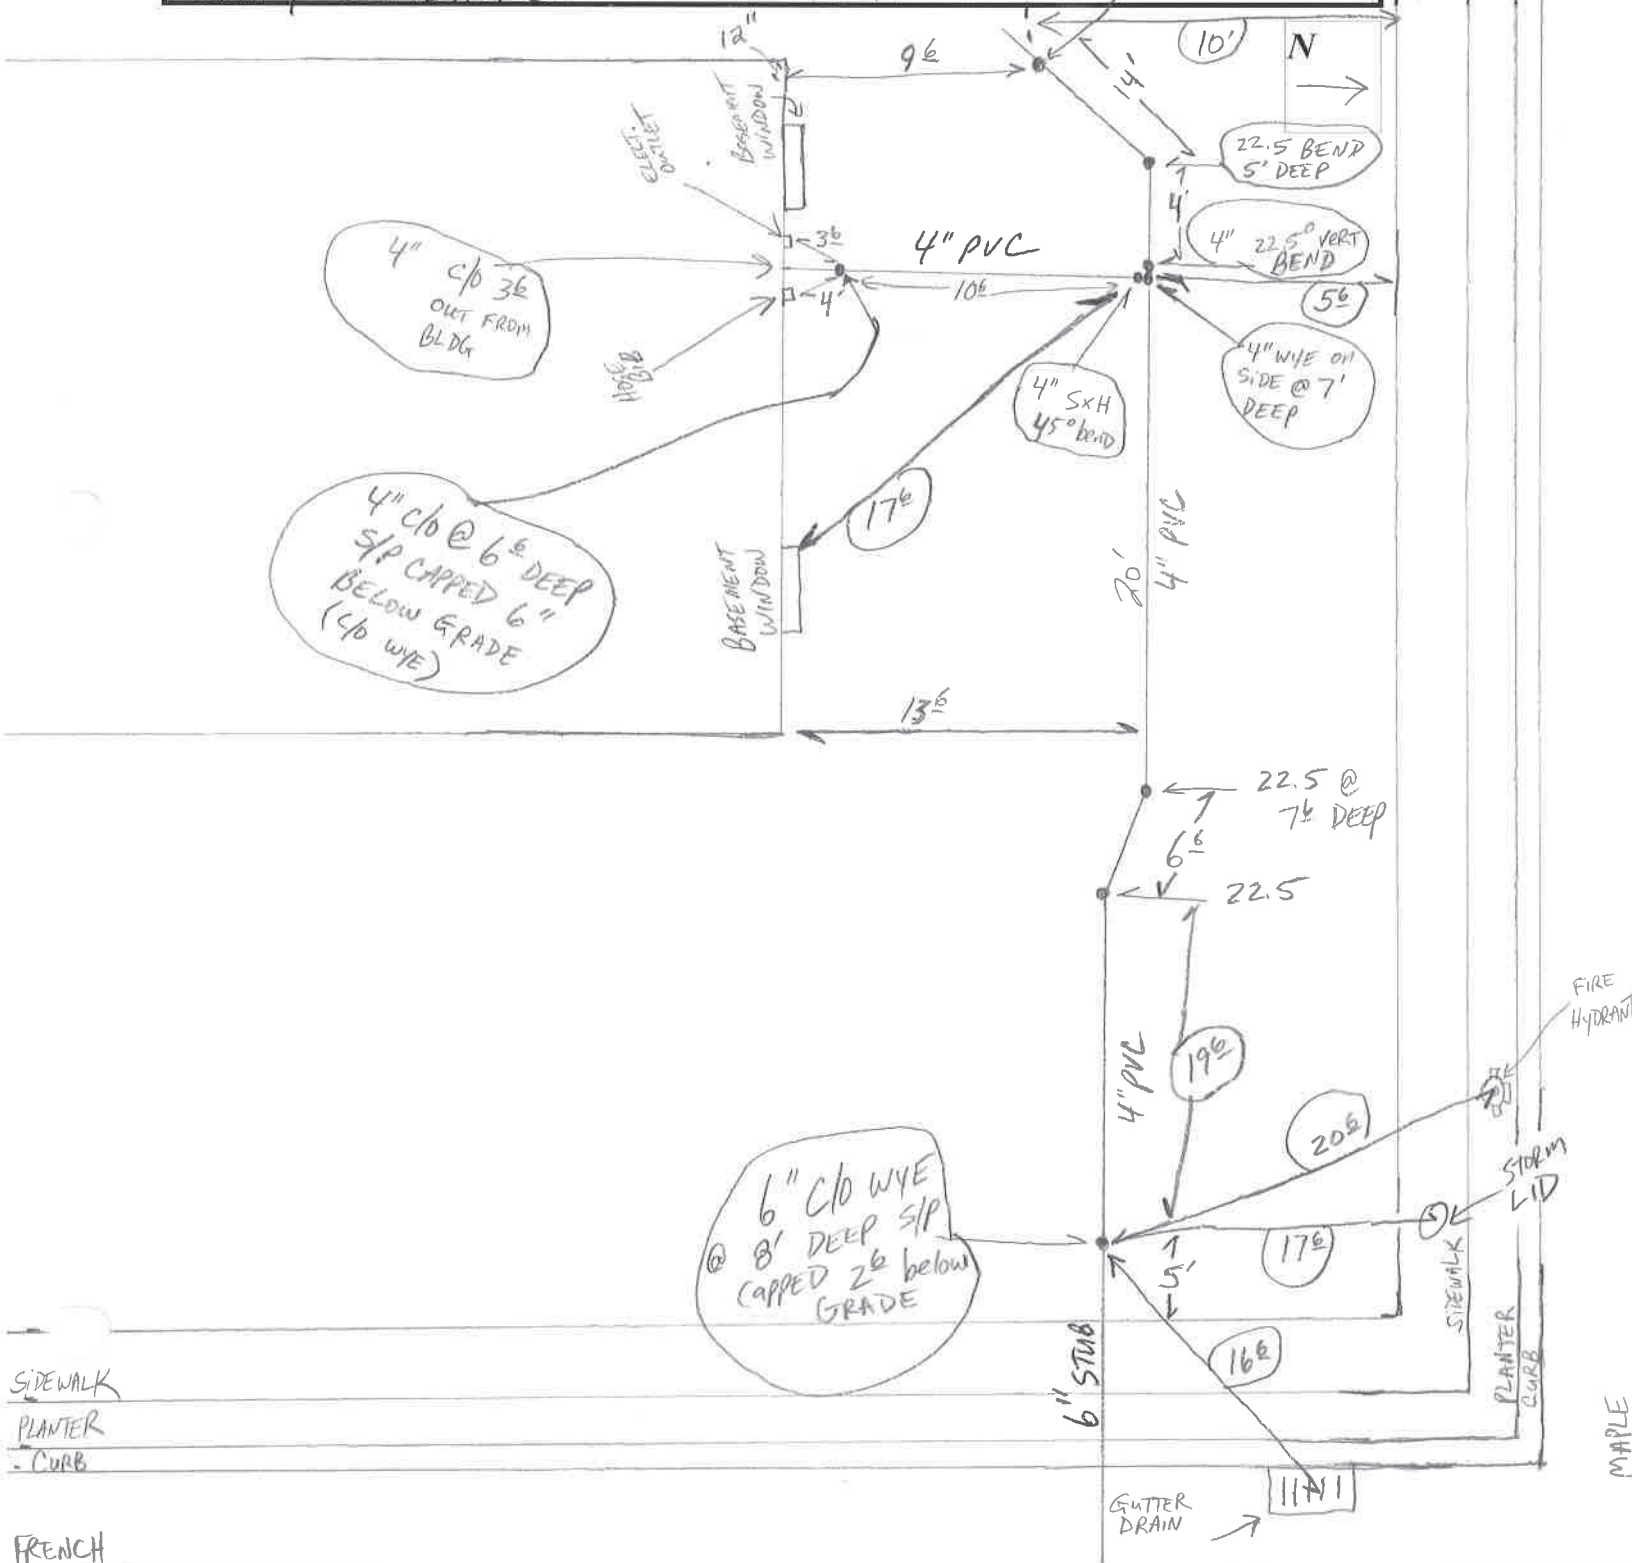

SIDEWALK
PLANTER
CURB

MAPLE

FRENCH