

**THE TOWN OF ARLINGTON**  
SEWER DEPARTMENT

Side Street Plat  
(PREPARE IN DUPLICATE)

Permit No. 5210

Owner's Name Allen R Remington


Owner's Mailing Address \_\_\_\_\_

Legal Description of Premises \_\_\_\_\_

Address of Property \_\_\_\_\_

Side Sewer Contractor SELF

Mailing Address \_\_\_\_\_

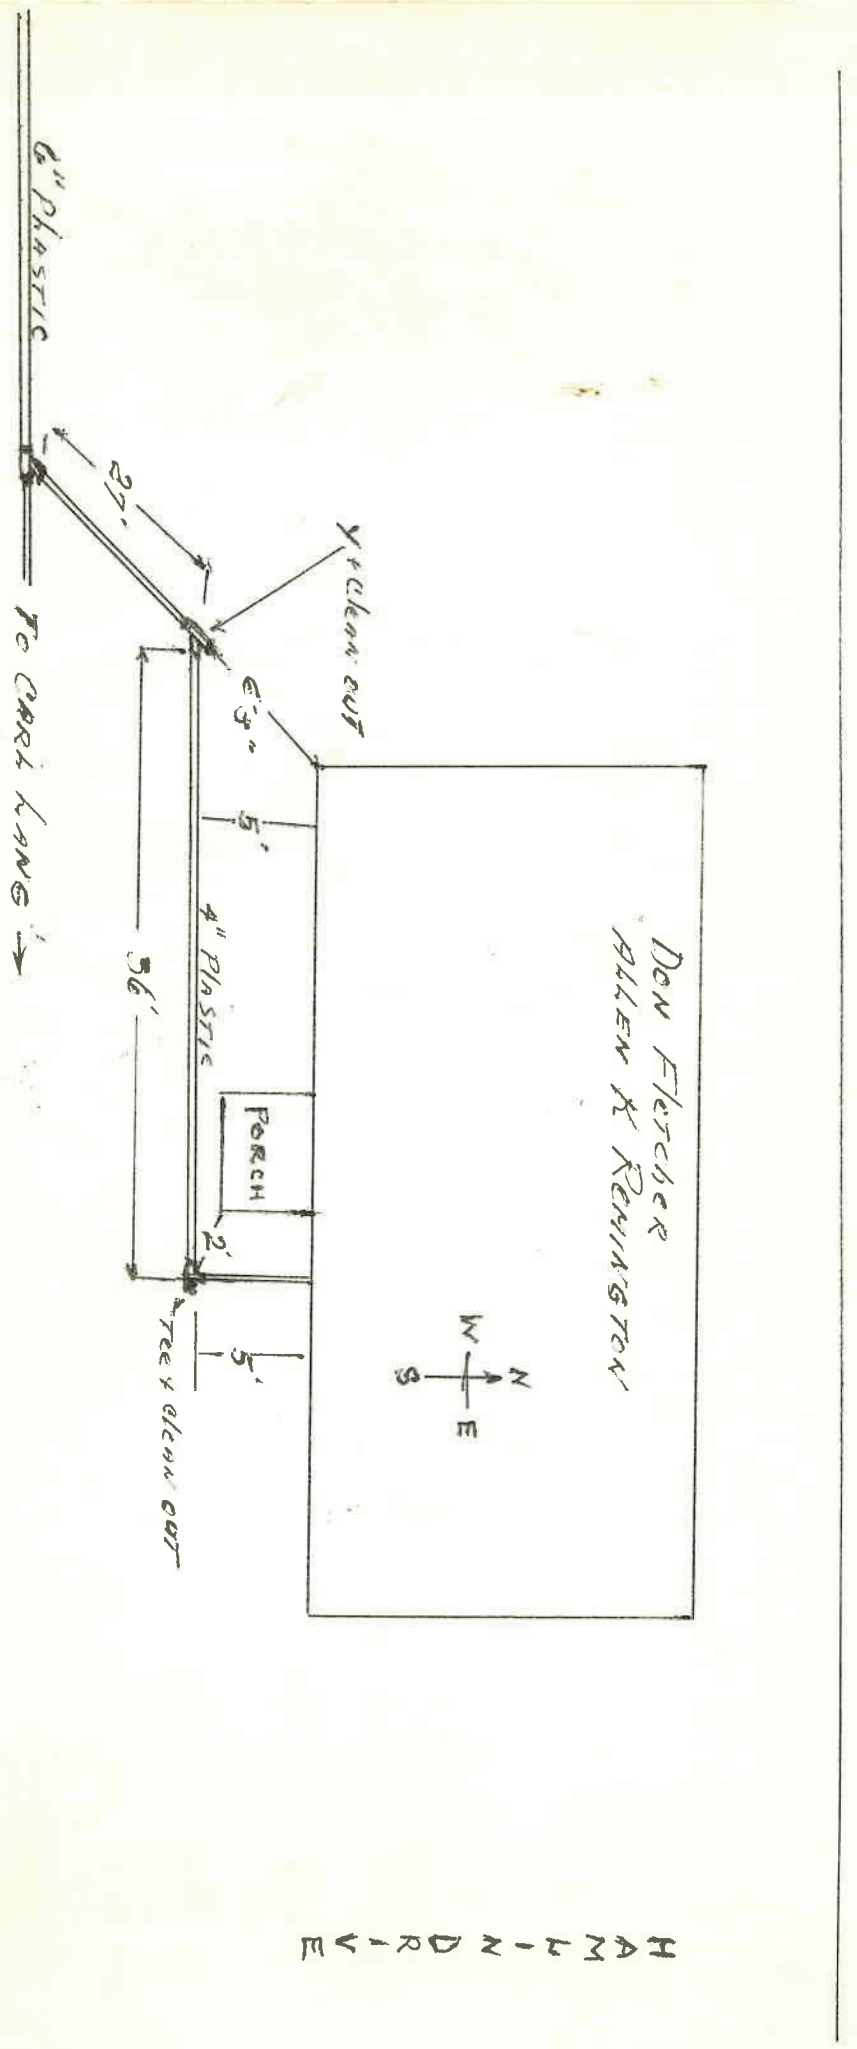

- 1. Commercial ..... Single Residence ..... Multiple Dwelling ..... Joint Use .....
- 2. Distance from property line to sewer line .....
- 3. Distance from house building line to property line ..... From property line to bldg .....
- 4. Min. grade from main to property line .....
- 5. Distance from M. H. No. ....
- 6. Depth: Sewer main .....
- 7. Basement: ..... Basement connection .....
- 8. Depth of pipe at house connection ..... (Reference to first floor)
- 9. Type of pipe: Concrete ..... Vitrified Clay ..... Asbestos-Cement ..... Size .....
- 10. Remarks: .....

- COMMERCIAL ONLY**
- 1. Name .....
  - 2. Type .....
  - 3. Sq. Ft. Floor Space .....
  - 4. No. of Floors .....
  - 5. Remarks: .....

- SPECIAL AGREEMENTS**
- 1. Grade Release .....
  - 2. High Grade Release .....
  - 3. Non-Protecting Agmt. ....
  - 4. Easement .....
  - 5. Permission to Connect .....
  - 6. Special .....
- I hereby certify that the above connection has been made as shown:  
Inspector \_\_\_\_\_ Date \_\_\_\_\_  
Date Permit Issued \_\_\_\_\_ Permit No. \_\_\_\_\_