


| | |
|----------------------------|---------------|
| Property Address: | 205 Gifford |
| Permit Number: | 03 |
| Development Name: | NA |
| Lot Number: | NA |
| Date Inspected: | 01/07/60 |
| Inspected By: | Henry Spencer |
| AutoCad As-built Drawn By: | Fred Rapelyea |
| AutoCad Drawing Date: | 3/29/05 |

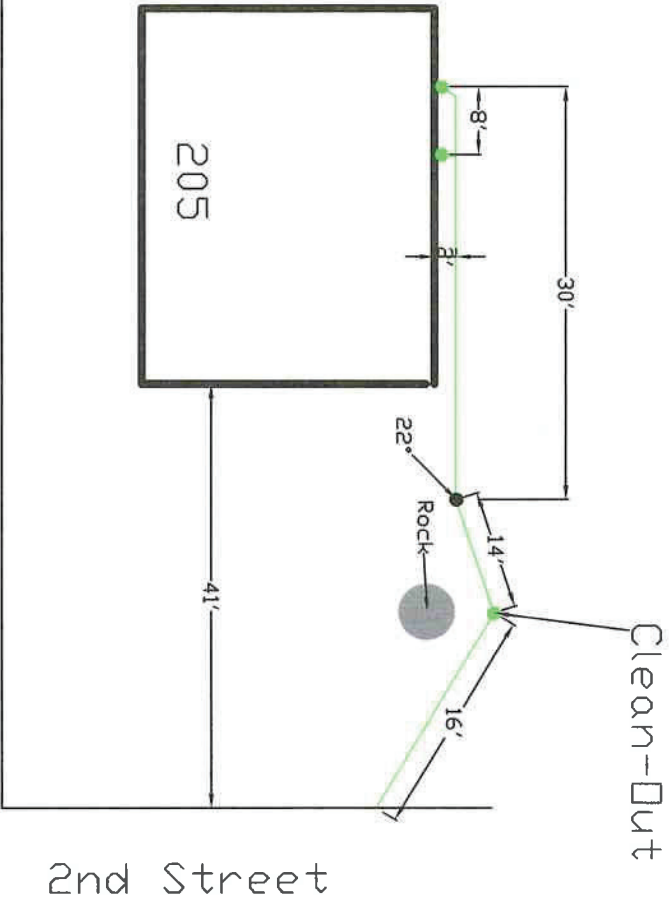

Gifford

2nd Street