

THE TOWN OF ARLINGTON

SEWER DEPARTMENT


Side Street Plat
(PREPARED IN DUPLICATE)

Permit No. 316

Owner's Name CONRAD C. HJORT
 Owner's Mailing Address Jensen ST Rt #5

Address of Property _____
 Side Sewer Contractor _____
 Mailing Address _____

Legal Description of Premises S 10.7 FT LOT 13 PLUS N 1/2 VZC REYNOLD ADJ THERETO E 208.7' of LOT 16 PLUS VAC REYNOLDS ST ADJ ROSE ARMSTRONG SUB 5 AC TRACTS

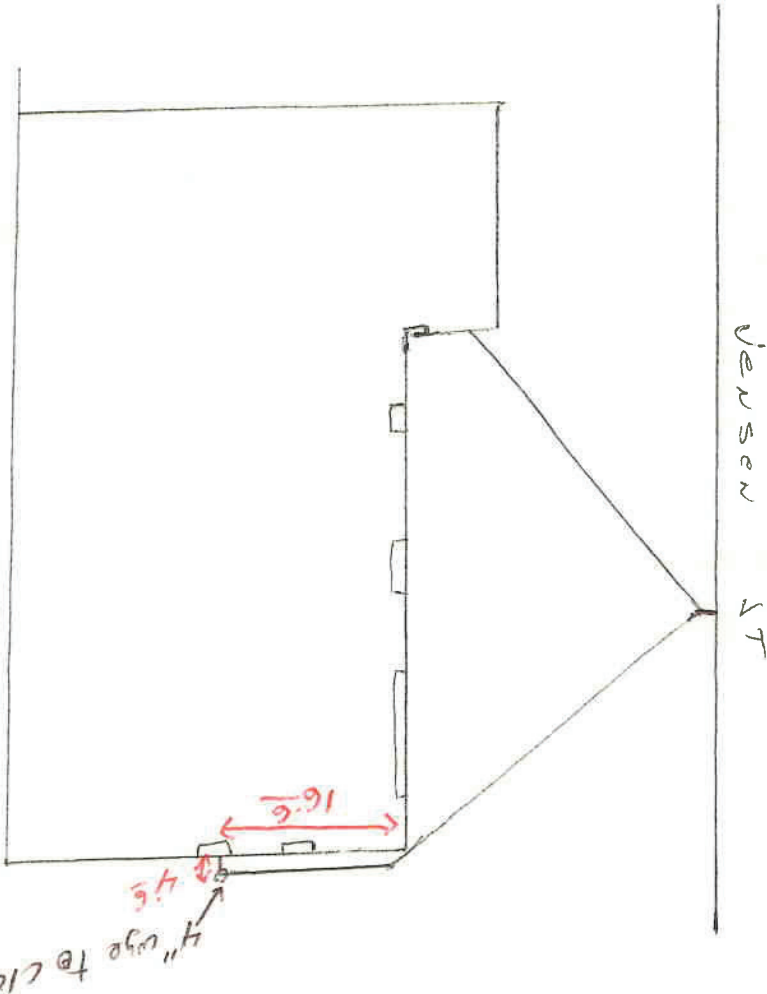

29-2600.0

- 1. Commercial..... Single Residence Multiple Dwelling..... Joint Use.....
- 2. Distance from property line to sewer line.....
- 3. Distance from house building line to property line..... From property line to bldg. 2 ft
- 4. Min. grade from main to property line.....
- 5. Distance from M. H. No.
- 6. Depth: Sewer main..... Basement connection..... (Reference to first floor)
- 7. Basement.....
- 8. Depth of pipe at house connection..... Vitrified Clay..... Asbestos-Cement..... Size 4"
- 9. Type of pipe: Concrete.....
- 10. Remarks:

COMMERCIAL ONLY

- 1. Name
- 2. Type
- 3. Sq. Ft. Floor Space
- 4. No. of Floors
- 5. Remarks:

SPECIAL AGREEMENTS

- 1. Grade Release
- 2. High Grade Release
- 3. Non-Protecting Agmt.
- 4. Easement
- 5. Permission to Connect
- 6. Special

I hereby certify that the above connection has been made as shown:
 Inspector [Signature] Date 9/27/65
 Date Permit Issued _____ Permit No. 316