

THE TOWN OF ARLINGTON

SEWER DEPARTMENT

Side Street Plat
(PREPARE IN DUPLICATE)

Permit No. 220

450

Owner's Name Walter L. Bray

Owner's Mailing Address 215 E. Gilman


Legal Description of Premises Lot 12, Block 15 Haller City

Address of Property 215 E. Gilman

Side Sewer Contractor self

Mailing Address

GILMAN

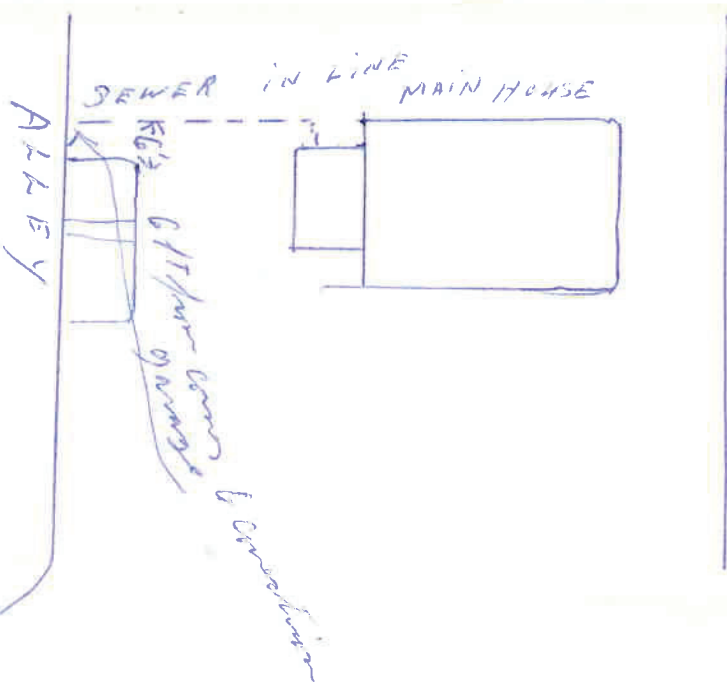

02-0900.0

1. Commercial..... Single Residence..... Multiple Dwelling..... Joint Use.....
2. Distance from property line to sewer line.....
3. Distance from house building line to property line.....
4. Min. grade from main to property line..... From property line to bldg..... 2 1/2'
5. Distance from M. H. No.....
6. Depth: Sewer main..... Basement connection.....
7. Basement.....
8. Depth of pipe at house connection..... (Reference to first floor)
9. Type of pipe: Concrete....., Vitrified Clay....., Asbestos-Cement....., Size 4"
10. Remarks:

COMMERCIAL ONLY

1. Name
2. Type
3. Sq. Ft. Floor Space
4. No. of Floors
5. Remarks:

SPECIAL AGREEMENTS

1. Grade Release
2. High Grade Release
3. Non-Protecting Agmt.
4. Easement
5. Permission to Connect
6. Special

I hereby certify that the above connection has been made as shown:

Inspector [Signature] Date 4/25/61
 Date Permit Issued 220 Permit No. 220