



FILE COPY

Property Address:	215 Jensen Street
Permit Number:	69
Development Name:	NA
Lot Number:	NA
Date Inspected:	1/07/60
Inspected By:	Henry Spencer
AutoCad As-built Drawn By:	Fred Rapelyea
AutoCad Drawing Date:	2/2/06

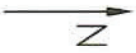

4" Concrete pipe installed at 2%. Depth of 18" at connection to house.
* No further information provided by inspector

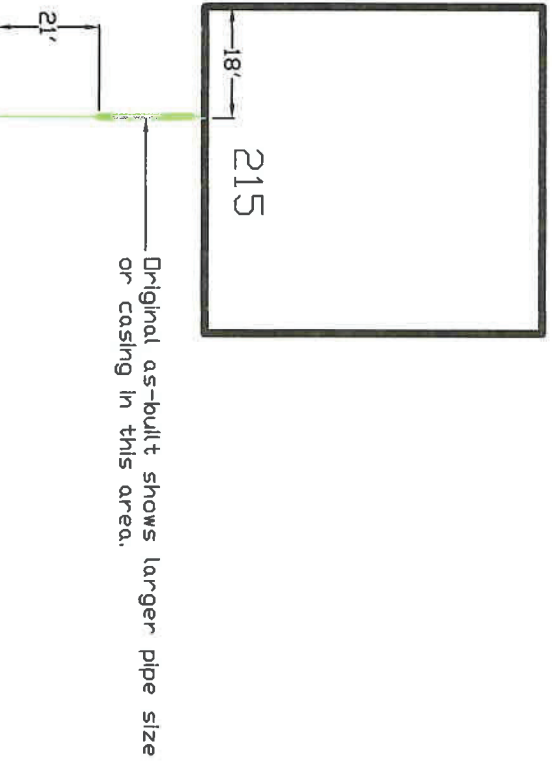

Jensen Street