

THE TO, JN OF ARLINGTON

SEWER DEPARTMENT


Side S, r Plat
(PREPARE IN DUPLICATE)

Permit No. 319

Owner's Name Charles Ed Smith
 Owner's Mailing Address 2115 1/2 St NW
 Legal Description of Premises Lot 11-13, 5 and 6

Address of Property 2115 1/2 St NW
 Side Sewer Contractor CHARLES ED SMYTH
 Mailing Address EXCAVATING & SEWER CONSTRUCTION
BOX 414 PH. HO. 6-4365
LA CONNER, WASH.

*Clear out 119 feet from
 southeast corner - about
 5 feet out*

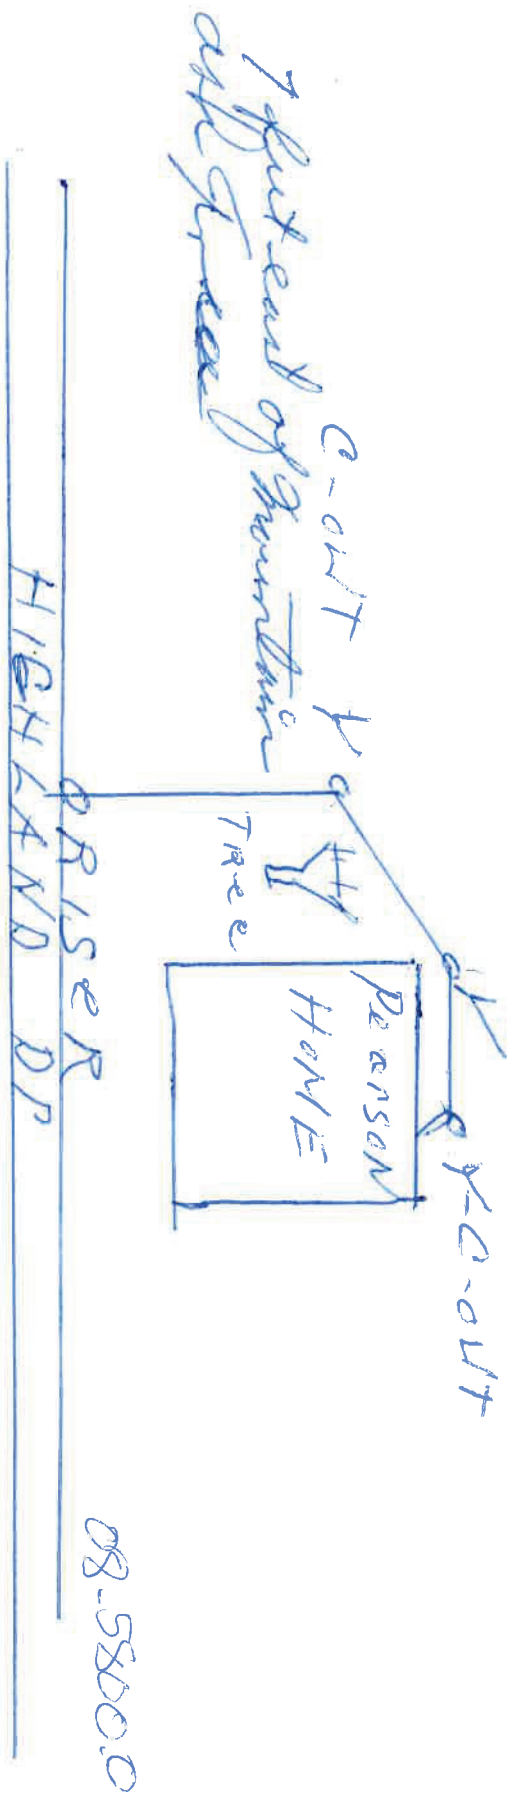

1. Commercial..... Single Residence Multiple Dwelling..... Joint Use.....
2. Distance from property line to sewer line.....
3. Distance from house building line to property line..... From property line to bldg. 205
4. Min. grade from main to property line.....
5. Distance from M. H. No.
6. Depth: Sewer main..... Basement connection 110 (Reference to first floor)
7. Basement.....
8. Depth of pipe at house connection..... Verified Clay..... Asbestos-Cement..... Size 12
9. Type of pipe: Concrete.....
10. Remarks:

COMMERCIAL ONLY		SPECIAL AGREEMENTS	
1. Name	1. Grade Release	1. Grade Release	1. Grade Release
2. Type	2. High Grade Release	2. High Grade Release	2. High Grade Release
3. Sq. Ft. Floor Space	3. Non-Protecting Agmt.	3. Non-Protecting Agmt.	3. Non-Protecting Agmt.
4. No. of Floors	4. Easement	4. Easement	4. Easement
5. Remarks:	5. Permission to Connect	5. Permission to Connect	5. Permission to Connect
6. Special	6. Special	6. Special	6. Special

I hereby certify that the above connection has been made as shown:
 Inspector George J. Miller Date 10/10/00
 Date Permit Issued 10/10/00 Permit No. 08-58000