


THE TOWN OF ARLINGTON
SEWER DEPARTMENT

Side Sewer Plat
(PREPARE IN DUPLICATE)

Permit No. 537 537

Owner's Name WALDO EVANS
 Owner's Mailing Address 221 JENSEN ST.
 Legal Description of Premises A PORTION OF LOT 15 TRACTS DISCRPTION (LOT "E")

Address of Property 221 JENSEN ST.
 Side Sewer Contractor PETE ROAL
 Mailing Address RT #5 ARLINGTON, WASH ROSE ARMSTRONGS SUB AREA

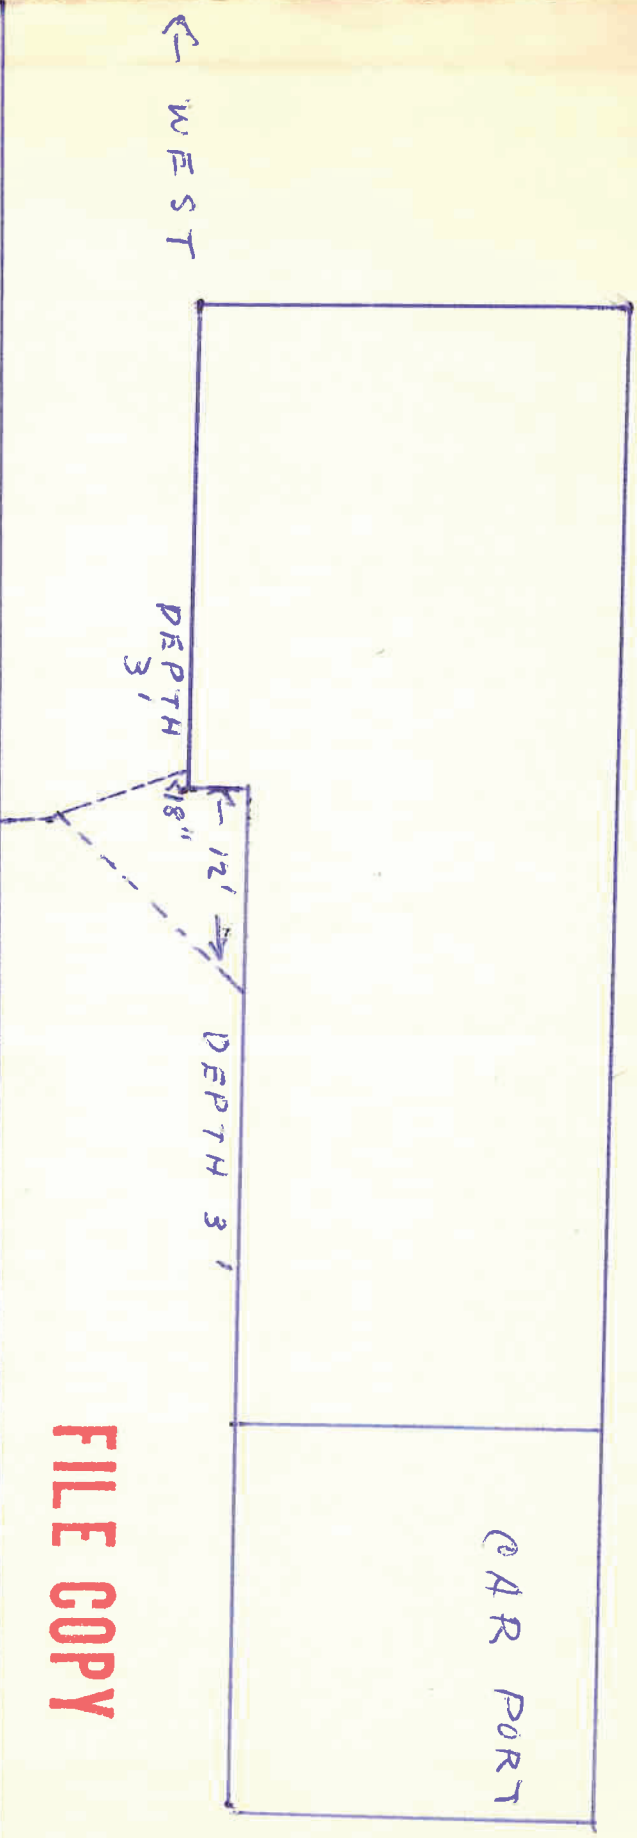

09-3300.0

- Commercial Single Residence Multiple Dwelling Joint Use
- Distance from property line to sewer line
- Distance from house building line to property line From property line to bldg.
- Min. grade from main to property line
- Distance from M. H. No.
- Depth: Sewer main
- Basement Basement connection (Reference to first floor)
- Depth of pipe at house connection Verified Clay Asbestos-Cement Size
- Type of pipe: Concrete
- Remarks:

COMMERCIAL ONLY

- Name
- Type
- Sq. Ft. Floor Space
- No. of Floors
- Remarks:

SPECIAL AGREEMENTS

- Grade Release
- High Grade Release
- Non-Protecting Agmt.
- Easement
- Permission to Connect
- Special

I hereby certify that the above connection has been made as shown:
 Inspector [Signature] Date 7/20/65
 Date Permit Issued 5/27/65 Permit No. 537