


CITY OF ARLINGTON
SEWER DEPARTMENT

SIDE SEWER PLAT MAP

SS PERMIT # 146
BP # 96-2084

Owner's Name Family Counseling Services Side Sewer Contractor _____
Mailing Address _____ Mailing Address _____
Address of Property 223 E. Burke
Legal Description Lot 28 Block 31 Heller City

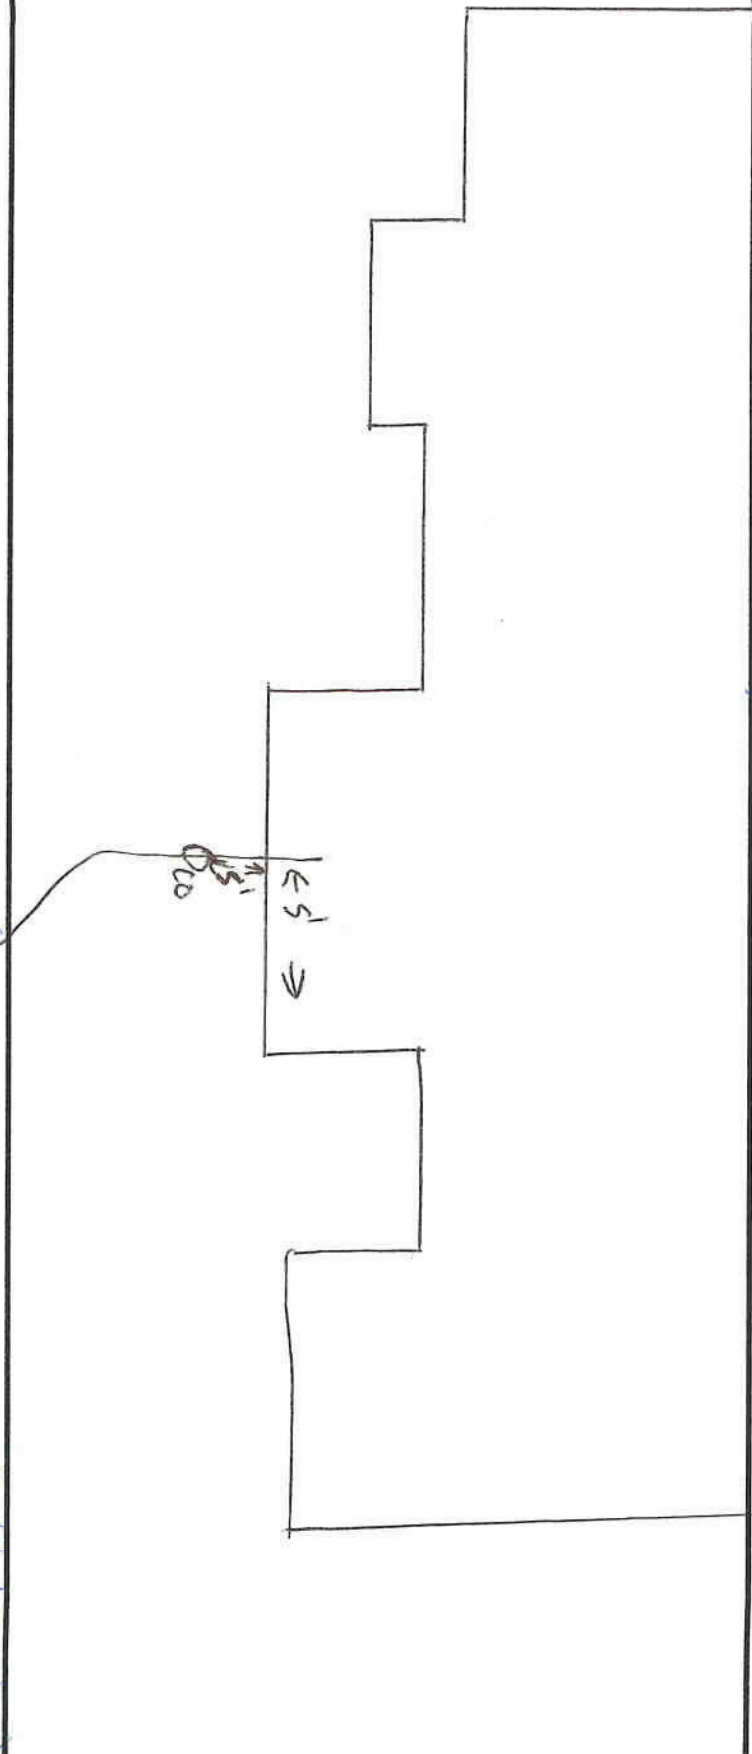

1. Commercial _____ Single Residence _____ Multiple Dwelling Joint Use _____ # of ERU's 3 (4-1 existing)
2. Distance from M.H. No. _____
3. Depth: Sewer Main _____ Basement _____ Basement Connections _____
4. Depth of pipe at house connection _____ (first floor)
5. Inspected by _____ Date 2-4-97
6. Type of pipe _____ Pipe Size _____