

**THE TOWN OF ARLINGTON**  
SEWER DEPARTMENT

Side Sewer Plat

(PREPARE IN DUPLICATE)

Permit No. 449

440

4790 George Tenbrink - 09/10/2003

Owner's Name PHIL BORN


Owner's Mailing Address 225 N DUNHAM

Legal Description of Premises BLK 3 LOT 16-17

Address of Property 225 N DUNHAM

Side Sewer Contractor CHARLES P SMYTH

Mailing Address Box 227 A Mt Vernon

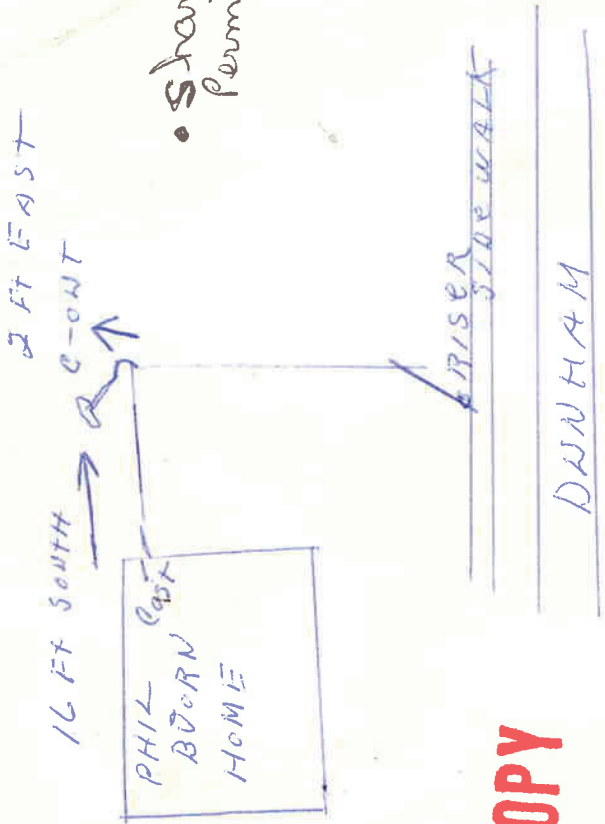

• Shared stub with 217 N. DUNHAM  
Permit # 439. VAR 9/10/2003

**FILE COPY**

04-7200.0

COMMERCIAL ONLY	SPECIAL AGREEMENTS
1. Name .....	1. Grade Release .....
2. Type .....	2. High Grade Release .....
3. Sq. Ft. Floor Space .....	3. Non-Protecting Agmt. ....
4. No. of Floors .....	4. Easement .....
5. Remarks: .....	5. Permission to Connect .....
	6. Special .....

I hereby certify that the above connection has been made as shown:  
 Inspector James Spurr Date 9/13/03  
 Permit Issued 440

- Commercial..... Single Residence..... Multiple Dwelling..... Joint Use.....
- Distance from property line to sewer line.....
- Distance from house building line to property line.....
- Min. grade from main to property line..... From property line to bldg. 2.0
- Distance from M. H. No. ....
- Depth: Sewer main.....
- Basement..... Basement connection NO (Reference to first floor)
- Depth of pipe at house connection..... (Reference to first floor)
- Type of pipe: Concrete 12, Vitrified Clay....., Asbestos-Cement....., Size 6
- Remarks: Shared with 217 N Dunham