

THE TOWN OF ARLINGTON

SEWER DEPARTMENT

Side 1 or Plat
(PREPARE IN DUPLICATE)


Permit No. 44

6870

Owner's Name C. Alice Ferguson
 Owner's Mailing Address 230-S. Dunham
 Legal Description of Premises Lot 374 B4 Palumbo Add

Address of Property 230-S. Dunham
 Side Sewer Contractor Thompson and Rogers Co.
 Mailing Address 4608-36th S.W., Des Moines, Wash.

S. Dunham

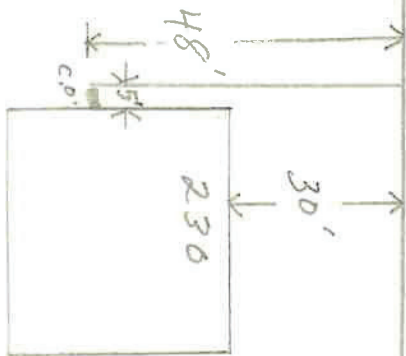

1D-0800.0

1. Commercial..... Single Residence..... Multiple Dwelling..... Joint Use.....
2. Distance from property line to sewer line.....
3. Distance from house building line to property line..... From property line to bldg. 296
4. Min. grade from main to property line.....
5. Distance from M. H. No.
6. Depth: Sewer main.....
7. Basement..... Basement connection..... (Reference to first floor)
8. Depth of pipe at house connection..... Vitrified Clay..... Asbestos-Cement..... Size.....
9. Type of pipe: Concrete..... Vitrified Clay..... Asbestos-Cement..... Size.....
10. Remarks:

COMMERCIAL ONLY

1. Name
2. Type
3. Sq. Ft. Floor Space
4. No. of Floors
5. Remarks:

SPECIAL AGREEMENTS

1. Grade Release
2. High Grade Release
3. Non-Protecting Agmt.
4. Easement
5. Permission to Connect
6. Special

I hereby certify that the above completion has been made as shown:

Inspector [Signature] Date 1/19/60
 Date Permit Issued [Signature] Permit No. 44