

THE TOWN OF ARLINGTON

SEWER DEPARTMENT


Side Street Plat
(PREPARE IN DUPLICATE)

Permit No. 150

5610

Owner's Name EVERETT F WINKES
 Owner's Mailing Address 227 Olympic Ave
 Legal Description of Premises Lots 17-18-19-20 Block 3 Highlands 1st Addl.

Side Sewer Contractor _____
 Mailing Address _____
 Address of Property 238 N. Wash.

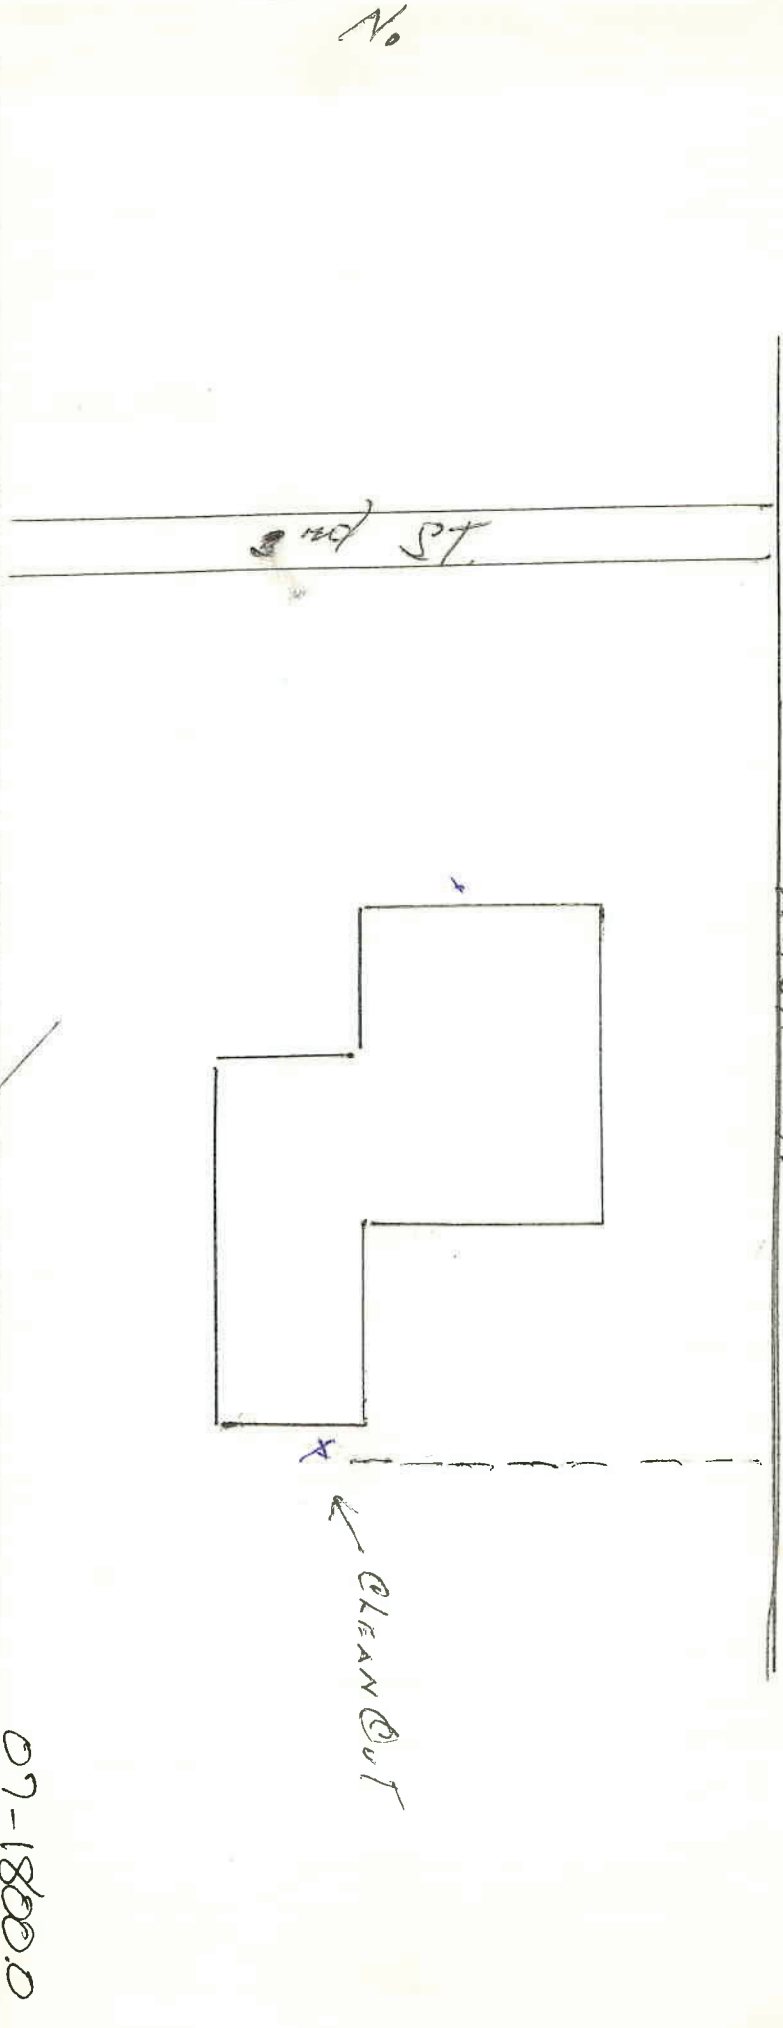

07-1800.0

- 1. Commercial Single Residence Multiple Dwelling Joint Use
- 2. Distance from property line to sewer line
- 3. Distance from house building line to property line
- 4. Min. grade from main to property line From property line to bldg. 2 1/2%
- 5. Distance from M. H. No.
- 6. Depth: Sewer main
- 7. Basement: Basement connection
- 8. Depth of pipe at house connection Verified Clay ✓, Asbestos-Cement (Reference to first floor)
- 9. Type of pipe: Concrete Asbestos-Cement Size 4"
- 10. Remarks:

COMMERCIAL ONLY

- 1. Name
- 2. Type
- 3. Sq. Ft. Floor Space
- 4. No. of Floors
- 5. Remarks:

SPECIAL AGREEMENTS

- 1. Grade Release
- 2. High Grade Release
- 3. Non-Protecting Agmt.
- 4. Easement
- 5. Permission to Connect
- 6. Special

I hereby certify that the above connection has been made as shown:

Inspector: Stanley Gammert Date: 3/29/60
 Date Permit Issued: _____ Permit No. 150