


Property Address:	302 South Dunham
Permit Number:	42
Development Name:	NA
Lot Number:	NA
Date Inspected:	01/07/60
Inspected By:	Henry Spencer
AutoCad As-built Drawn By:	Fred Rapelyea
AutoCad Drawing Date:	10/10/05

FILE COPY



*4" Concrete pipe installed at 2%.
No other information provided.

South Dunham

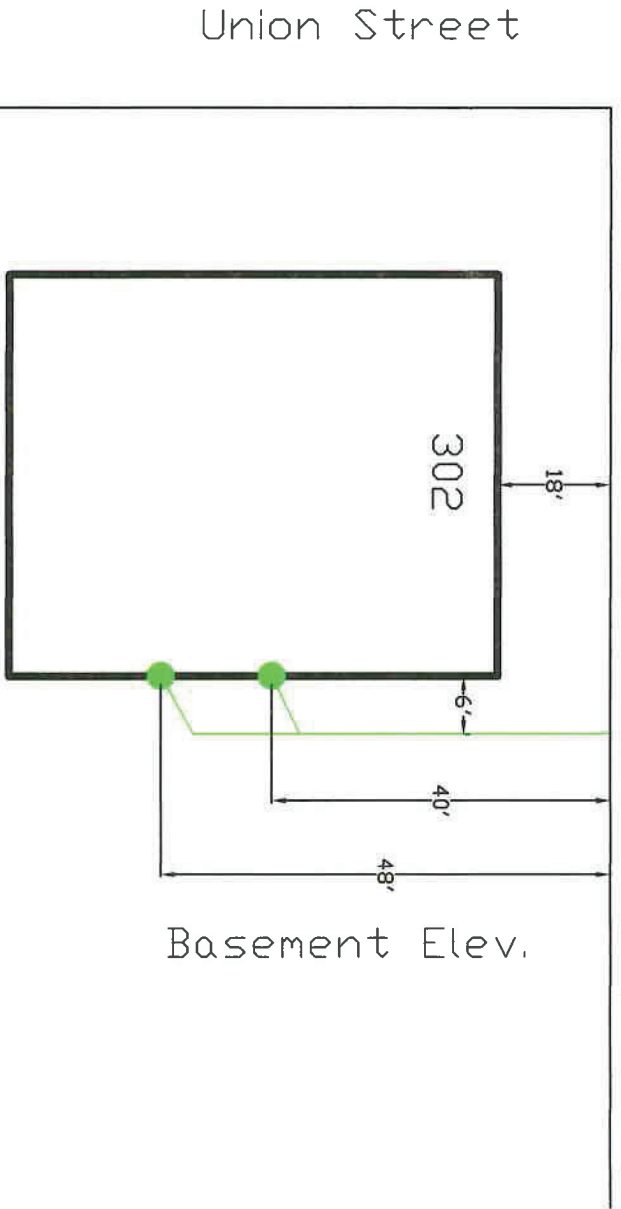

Union Street

Basement Elev.