

# THE TOWN OF ARLINGTON

## SEWER DEPARTMENT

Side Plat  
(PREPARE IN DUPLICATE)

Permit No. 4455

Owner's Name J.W. WIGGS


Owner's Mailing Address 304 5TH ST.

Legal Description of Premises LOTS 17 & 20 BLOCK 6 - McMAHON'S FIRST ADDITION

Address of Property 304 5TH STREET

Side Sewer Contractor - OWNER

Mailing Address 304 5TH STREET

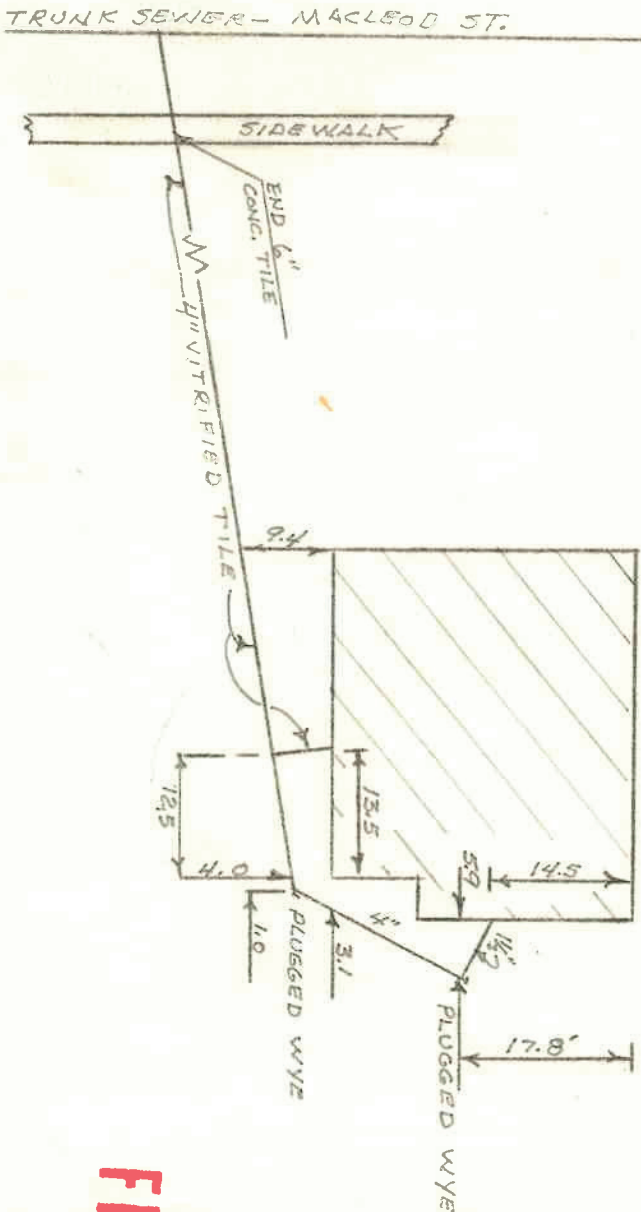

**FILE COPY**

04-34000.0

1. Commercial..... Single Residence..... Multiple Dwelling..... Joint Use.....
2. Distance from property line to sewer line.....
3. Distance from house building line to property line..... From property line to bldg. 18.0
4. Min. Grade from main to property line.....
5. Distance from M. H. No. ....
6. Depth: Sewer main.....
7. Basement..... Basement connection..... (Reference to first floor)
8. Depth of pipe at house connection.....
9. Type of pipe: Concrete....., Vitrified Clay....., Asbestos-Cement....., Size 4"
10. Remarks:.....

### COMMERCIAL ONLY

1. Name .....
2. Type .....
3. Sq. Ft. Floor Space .....
4. No. of Floors .....
5. Remarks: .....

### SPECIAL AGREEMENTS

1. Grade Release .....
2. High Grade Release .....
3. Non-Protecting Agmt. ....
4. Easement .....
5. Permission to Connect .....
6. Special .....

I hereby certify that the above connection has been made as shown:

Inspector [Signature] Date 1/31/65  
 Date Permit Issued [Signature] Permit No. 4455

2700