

THE TOWN OF ARLINGTON

SEWER DEPARTMENT


Side Street Plat
(PREPARE IN DUPLICATE)

Permit No. 279

2570

Owner's Name Walter E. Apperson
 Owner's Mailing Address 305-3rd Street
 Legal Description of Premises Lots 11 & 12 B.L.R. 3 - McLeod

Address of Property 305-3rd Street
 Side Sewer Contractor Shubert and Torgo Co.
 Mailing Address 4608-36th S.W. 1st St.

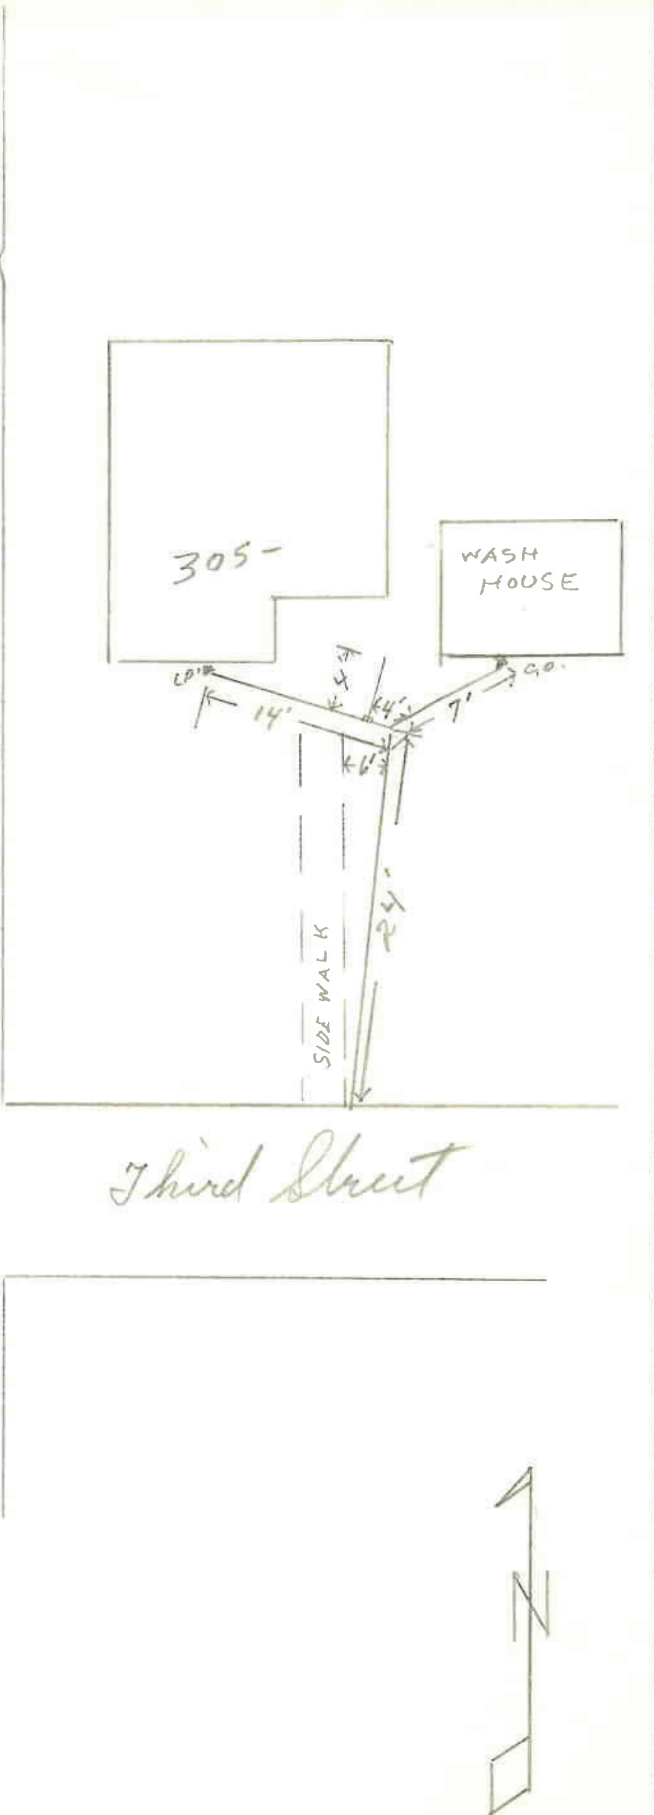

- Commercial..... Single Residence Multiple Dwelling..... Joint Use.....
- Distance from property line to sewer line.....
- Distance from house building line to property line..... From property line to bldg. 2' 4\"/>
- Min. grade from main to property line.....
- Distance from M. H. No.
- Depth: Sewer main.....
Basement connection.....
- Basement.....
- Depth of pipe at house connection.....
Vitrified Clay..... Asbestos-Cement..... (Reference to first floor)
- Type of pipe: Concrete.....
- Remarks:

- COMMERCIAL ONLY**
- Name
 - Type
 - Sq. Ft. Floor Space
 - No. of Floors
 - Remarks:

- SPECIAL AGREEMENTS**
- Grade Release
 - High Grade Release
 - Non-Protesting Agmt.
 - Easement
 - Permission to Connect
 - Special
- I hereby certify that the above connection has been made as shown:
 Inspector Walter E. Apperson Date 1/8/60
 Date Permit Issued..... Permit No. 279