

# THE TOWN OF ARLINGTON

## SEWER DEPARTMENT


Side Street Plat  
(PREPARE IN DUPLICATE)

Permit No. 354

Owner's Name William T. Dinger  
 Owner's Mailing Address 36 Block 9 Lot 5  
 Legal Description of Premises

Address of Property 308 Gilman Ave  
 Side Sewer Contractor Self  
 Mailing Address

N.

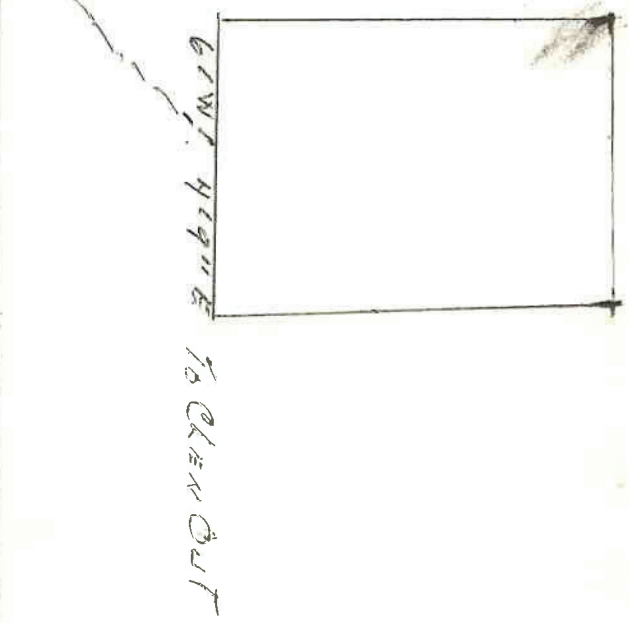

01-8800.0

- 1. Commercial  Single Residence  Multiple Dwelling  Joint Use
- 2. Distance from property line to sewer line 30'
- 3. Distance from house building line to property line 30'
- 4. Min. grade from main to property line From property line to blfg. 2.8%
- 5. Distance from M. H. No. 30'
- 6. Depth: Sewer main
- 7. Basement Basement connection (Reference to first floor)
- 8. Depth of pipe at house connection 18"
- 9. Type of pipe: Concrete Victified Clay, Asbestos-Cement Asbestos-Cement, Size 4"
- 10. Remarks:

COMMERCIAL ONLY		SPECIAL AGREEMENTS	
1. Name		1. Grade Release	
2. Type		2. High Grade Release	
3. Sq. Ft. Floor Space		3. Non-Protecting Agmt.	
4. No. of Floors		4. Easement	
5. Remarks:		5. Permission to Connect	
		6. Special	

I hereby certify that the above connection has been made as shown:  
 Inspector Henry Brown Date 3/19/60  
 Date Permit Issued 3/19/60 Permit No. 354