

← HIGHLAND DRIVE →

↑ N

5 WATER METERS


□□□□□ ← 27'

EDGE OF ASPHALT

— ROSS SHORT PLAT ENTRANCE —

Center Planter

Asphalt

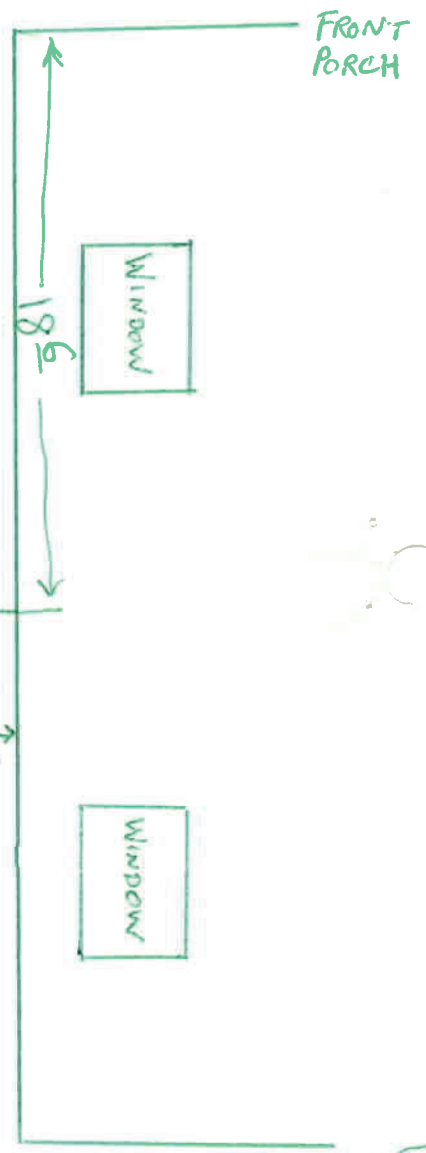

FRONT PORCH

WINDOW

WINDOW

18'

4" C.O. w/ 2' deep cap

22.5'

4" e.o. w/ 4' deep cap 2' below grade

ASPHALT

PERMIT # 513

→ 310 HIGHLAND DR
EXISTING HOUSE
w/ NEW SEWER
STUB.

05-11-2006
MRE

PERMIT # 513

⊗ See ROSS SHORT PLAT FOR
6" STUB AS-BUILTS