

# THE TOWN OF ARLINGTON

## SEWER DEPARTMENT


Side Street Plat  
(PREPARE IN DUPLICATE)

Permit No. 161

39

Owner's Name LOUIS H. MARY J. BRUNDELL  
 Owner's Mailing Address 311 E GILMAN AVE  
 Legal Description of Premises LOT 11 HARKER CITY ADD.

Address of Property 311 E GILMAN AVE  
 Side Sewer Contractor DELL FOSTER  
 Mailing Address PT 1 ARLINGTON MARK.

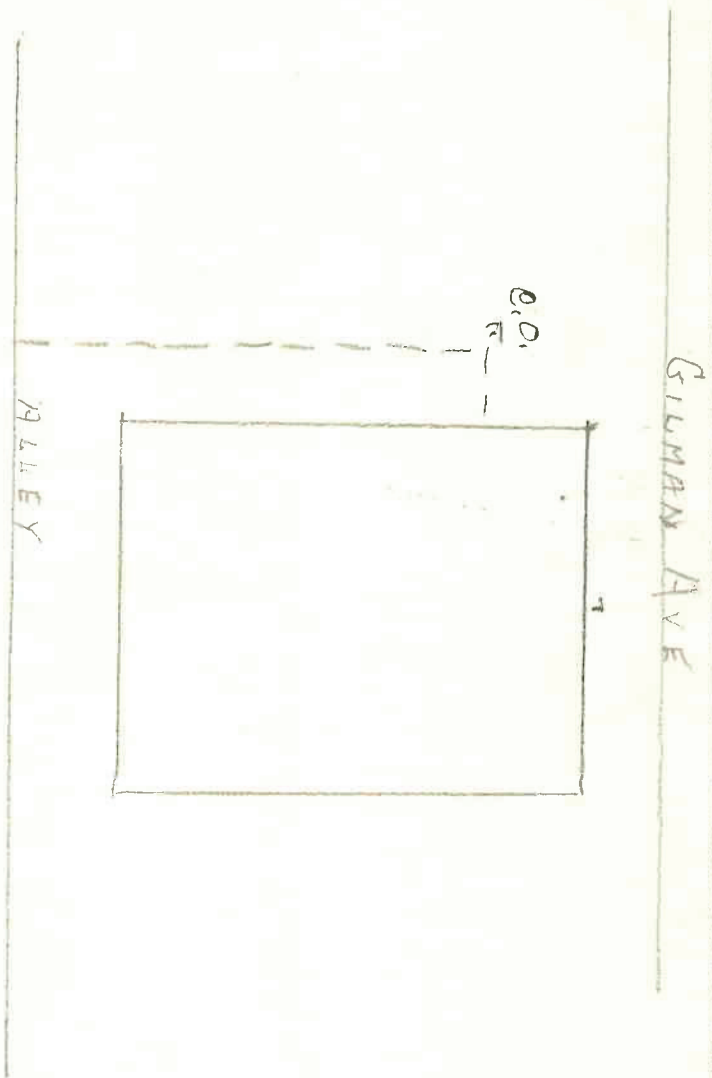

01-9000.0

- 1. Commercial  Single Residence  Multiple Dwelling  Joint Use
- 2. Distance from property line to sewer line 8'
- 3. Distance from house building line to property line 60'
- 4. Min. Grade from main to property line From property line to bldg. 2 1/2"
- 5. Distance from M. H. No. 81
- 6. Depth: Sewer main 8'
- 7. Basement Basement connection
- 8. Depth of pipe at house connection 20" Basement connection (Reference to first floor)
- 9. Type of pipe: Concrete  Vitrified Clay  Asbestos-Cement  Size 4"
- 10. Remarks:

### COMMERCIAL ONLY

- 1. Name
- 2. Type
- 3. Sq. Ft. Floor Space
- 4. No. of Floors
- 5. Remarks:

### SPECIAL AGREEMENTS

- 1. Grade Release
- 2. High Grade Release
- 3. Non-Protecting Agmt.
- 4. Easement
- 5. Permission to Connect
- 6. Special

I hereby certify that the above connection has been made as shown:  
 Inspector [Signature] Date 11/5/60  
 Date Permit Issued 11/5/60 Permit No. 161