

THE TOWN OF ARLINGTON
SEWER DEPARTMENT

Side Sewer Plat
(PREPARE IN DUPLICATE)

Permit No. 162

850

Owner's Name Ralph DeMance


Owner's Mailing Address 326 Burke St. Fair Hill

Legal Description of Premises Plots Lots 384 Harker City

Address of Property 724 Baybrook St. Fair Hill

Side Sewer Contractor Edward L. Smith

Mailing Address Box 414 Fairhope Ala

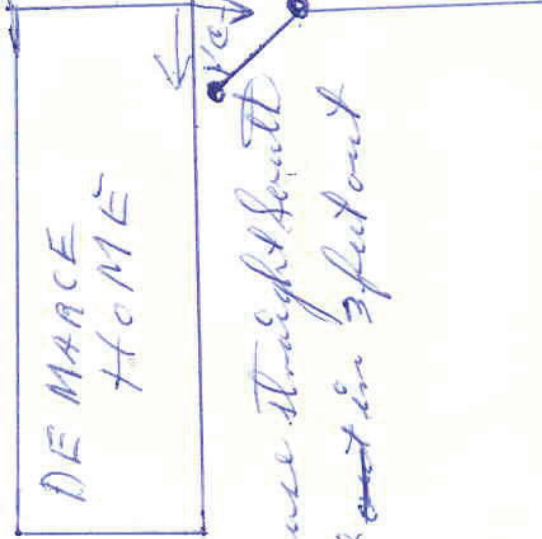

1. Commercial..... Single Residence..... Multiple Dwelling..... Joint Use.....
2. Distance from property line to sewer line.....
3. Distance from house building line to property line.....
4. Min. grade from main to property line..... From property line to bldg. 2%
5. Distance from M. H. No.....
6. Depth: Sewer main.....
7. Easement..... Easement connection..... (Reference to first floor)
8. Depth of pipe at house connection..... 12", Vitrified Clay..... Asbestos-Cement....., Size 4"
9. Type of pipe: Concrete.....
10. Remarks:

COMMERCIAL ONLY

1. Name
2. Type
3. Sq. Ft. Floor Space
4. No. of Floors
5. Remarks:

I hereby certify that the above connection has been made as shown:
Inspector Henry Spear Date 1/27/60
Date Permit Issued 1/27 Permit No. 162

SPECIAL AGREEMENTS

1. Grade Release
2. High Grade Release
3. Non-Protecting Agmt.
4. Easement
5. Permission to Connect
6. Special

02-2700.0