

THE TOWN OF ARLINGTON

SEWER DEPARTMENT

Side Street Plat
(PREPARE IN DUPLICATE)


Permit No. 37

09/10

Owner's Name J. R. Hammer
 Owner's Mailing Address 322-S-Dunham
 Legal Description of Premises Lot 576 Block 5 Colbo Cold.

Address of Property 322-S-Dunham
 Side Sewer Contractor Shuburn and Tracy Co.
 Mailing Address 4608-36th St. N. S.W. Seattle

S-Dunham

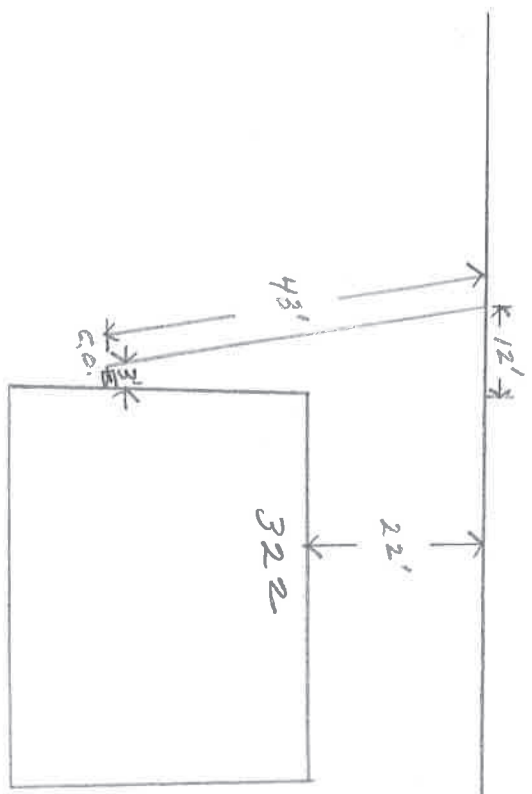

ID-1700.D

1. Commercial..... Single Residence..... Multiple Dwelling..... Joint Use.....
2. Distance from property line to sewer line.....
3. Distance from house building line to property line..... From property line to bldg. 10
4. Min. grade from main to property line.....
5. Distance from M. H. No.
6. Depth: Sewer main.....
7. Basement..... Basement connection..... (Reference to first floor).....
8. Depth of pipe at house connection.....
9. Type of pipe: Concrete....., Vitrified Clay....., Asbestos-Cement....., Size 4
10. Remarks:.....

COMMERCIAL ONLY

1. Name
2. Type
3. Sq. Ft. Floor Space
4. No. of Floors
5. Remarks:

SPECIAL AGREEMENTS

1. Grade Release
2. High Grade Release
3. Non-Protecting Agmt.
4. Easement
5. Permission to Connect
6. Special

I hereby certify that the above connection has been made as shown:
 Inspector J. R. Hammer Date 11/16/09
 Date Permit Issued..... Permit No. 37